Discretionary Review Analysis

Dwelling Unit Merger

HEARING DATE OCTOBER 20, 2011

1650 Mission St. Suite 400 San Francisco, CA 94103-2479

Reception: 415.558.6378

Fax:

415.558.6409

Planning Information: 415.558.6377

Date: October 13, 2011
Case No.: 2011.0497D

Project Address: 650 2nd STREET

Permit Application: 2011.01.14.8412 / 2011.01.14.8416

Zoning: MUO (Mixed Use, Office)

65-X Height and Bulk District

Block/Lot: 3788/059 & 060 Project Sponsor: Patrick Otellini

A.R. Sanchez-Corea & Associates 301 Junipero Serra Blvd, Suite 270

San Francisco, CA 94127

Staff Contact: Ben Fu – (415) 558-6613

Ben.fu@sfgov.org

Recommendation: Do not take Discretionary Review and approve the application

PROJECT DESCRIPTION

The proposal is to merge two live-work units into one unit within a 25-unit, six-story building. The proposal will involve interior renovations unrelated to the merger as the space has always been operated and owned as a single unit since the building conversion in 1996 from warehouse to live-work units.

SITE DESCRIPTION AND PRESENT USE

The subject site is located on the west side of 2nd Street between Brannan and Townsend Streets in the South of Market neighborhood. The site has approximately 64 feet of lot frontage with a lot depth of approximately 160 feet. The building is six stories and 72 feet tall and nearly full lot coverage.

The building is located within the South End Historic District and has a 2D National Register Status Code (contributor to a district determined eligible for National Register). The building is commonly known as the "B.F. Goodrich Rubber Company" building. It was constructed circa 1923 by Herman C. Bauman as an original office and warehouse building.

The building was converted to 25 live-work units in 1996. Previous owner in December 2008 filed Building Permit Application No. 2008.1211.8353 to merge the two units. The permit was withdrawn at applicant's request in January 2009. The current owner (project sponsor) purchased the already merged unit in 2009 and continued to occupy it as a single unit. The existing 2,950 square-foot unit will remain owner occupied.

SURROUNDING PROPERTIES AND NEIGHBORHOOD

The project site is located within the South of Market neighborhood and within the South End Historic District. The subject site is zoned MUO, which is described in the Planning Code as designed to encourage office uses and housing, as well as small-scale light industrial and arts activities. A pattern of mid-rise residential, industrial and office buildings exists in the neighborhood one block away from the AT&T Park. The overall density of dwelling units are high, buildings are larger scaled and units or groups of units have separate entrances.

HEARING NOTIFICATION

TYPE	REQUIRED PERIOD	REQUIRED NOTICE DATE	ACTUAL NOTICE DATE	ACTUAL PERIOD
Posted Notice	10 days	October 11, 2011	October 07, 2011	12 days
Mailed Notice	10 days	October 11, 2011	October 07, 2011	12 days

PUBLIC COMMENT

	SUPPORT	OPPOSED	NO POSITION
Adjacent neighbor(s)	NA	NA	
Other neighbors on the			
block or directly across	NA	NA	
the street			
Neighborhood groups	NA	NA	

The Department has received no public input on the project at the date of this report.

PROJECT ANALYSIS

DWELLING UNIT MERGER CRITERIA

Below are the five criteria to be considered by the Planning Commission in evaluating dwelling unit mergers, per Planning Code Section 317:

1. Removal of the unit(s) would only eliminate owner occupied housing, and if so, for how long the units proposed to be removed have been owner occupied;

Project Meets Criteria

According to Planning Department records, the subject property was purchased in 2009 by the project sponsor. The unit, since its conversion from warehouse to live-work, has always been occupied as a single unit without demising walls. The unit has been and will continue to be owner occupied.

2. Removal of the unit(s) and the merger with another is intended for owner occupancy.

Project Meets Criteria

The unit has been owner occupied by the project sponsor since it was purchased in 2009.

3. Removal of the unit(s) will bring the building closer into conformance with the prevailing density in its immediate area and the same zoning.

Project Does Not Meet Criteria

The prevailing density in the area is mixed. The density of the subject block ranges from high density apartment buildings to office and warehouse buildings. Within the same zoning district of MUO in the immediate area, the building across the street at 699 2^{nd} Street has one of the highest densities with 111 dwelling units constructed/added in 2006.

4. Removal of the unit(s) will bring the building closer into conformance with prescribed zoning.

Criteria Bot Applicable

The subject property is zoned MUO, which has no residential density limits.

5. Removal of the unit(s) is necessary to correct design or functional deficiencies that cannot be corrected through interior alterations.

Project Does Not Meet Criteria

While the existing units have been purchased and occupied as one single unit since the building's conversion to live-work in 1996, there are no "functional deficiencies".

GENERAL PLAN COMPLIANCE:

The Project is, on balance, consistent with the following Objectives and Policies of the General Plan:

HOUSING ELEMENT

Objectives and Policies

OBJECTIVE 2

RETAIN EXISTING HOUSING UNITS, AND PROMOTE SAFETY AND MAINTENANCE STANDARDS, WITHOUT JEOPARDIZING AFFORDABILITY.

Policy 2.4:

Promote improvements and continued maintenance to existing units to ensure long term habitation and safety.

OBJECTIVE 11

SUPPORT AND RESPECT THE DIVERSE AND DISTINCT CHARACTER OF SAN FRANCISCO'S NEIGHBORHOODS.

Policy 11.7:

Respect San Francisco's historic fabric, by preserving landmark buildings and ensuring consistency with historic districts.

While the subject property is authorized for two units, it has been used as a single-unit since the building's conversion from warehouse to live-work in 1996.

EAST SOMA AREA PLAN

Historic resources

Objectives and Policies

OBJECTIVE 8.2

PROTECT, PRESERVE, AND REUSE HISTORIC RESOURCES WITHIN THE EAST SOMA AREA PLAN

Policy 8.2.1:

Protect individually significant historic and cultural resources and historic districts in the East SoMa area plan from demolition or adverse alteration.

OBJECTIVE 8.3

ENSURE THAT HISTORIC PRESERVATION CONCERNS CONTINUE TO BE AN INTEGRAL PART OF THE ONGOING PLANNING PROCESSES FOR THE EAST SOMA PLAN AREA AS THEY EVOLVE OVER TIME

Policy 8.3.3:

Prevent destruction of historic and cultural resources resulting from owner neglect or inappropriate actions.

The project preserves the existing historic resource and the proposal will include internal upgrades.

SECTION 101.1 PRIORITY POLICIES

Planning Code Section 101.1 establishes eight priority policies and requires review of permits for consistency, on balance, with these policies. The Project complies with these policies as follows:

1. Existing neighborhood-serving retail uses be preserved and enhanced and future opportunities for resident employment in and ownership of such businesses enhanced.

This is not applicable since the property is a live/work use.

2. That existing housing and neighborhood character be conserved and protected in order to preserve the cultural and economic diversity of our neighborhoods.

While the subject property is authorized for two units, it has been used as a single-unit since the building's conversion from warehouse to live-work in 1996.

3. That the City's supply of affordable housing be preserved and enhanced.

This is not applicable since the existing unit has not been an affordable unit.

4. That commuter traffic not impede MUNI transit service or overburden our streets or neighborhood parking.

The proposal will not impede MUNI service or overburden streets or neighborhood parking. Public transit lines are available nearby on King, Mission and Market Streets.

5. A diverse economic base be maintained by protecting our industrial and service sectors from displacement due to commercial office development, and that future opportunities for resident employment and ownership in these sectors be enhanced.

This is not applicable since the property is a live/work use.

6. The City achieves the greatest possible preparedness to protect against injury and loss of life in an earthquake.

The proposal will comply with applicable code standards.

7. Landmarks and historic buildings be preserved.

The building is located within the South End Historic District and has a 2D National Register Status Code (contributor to a district determined eligible for national register). The building is also commonly known as the "B.F. Goodrich Rubber Company" building and constructed circa 1923 by Herman C. Bauman as an original office and warehouse building. The proposal does not involve any exterior improvements to the existing building.

8. Parks and open space and their access to sunlight and vistas be protected from development.

The proposal will not affect any existing parks or open spaces.

ENVIRONMENTAL REVIEW

The project is categorically exempt from the environmental review process under Section 15061(b)(3) of the State CEQA Guidelines, pursuant to Title 14 of the California Administrative Code.

BASIS FOR RECOMMENDATION

- The project complies with the applicable requirements of the Planning Code.
- The project is consistent with the objectives and policies of the General Plan.
- The project is in a mixed density area with no density limt; however, the proposal will bring the unit into conformance with the existing use.

RECOMMENDATION: Do not take Discretionary Review and approve the application

Attachments:

Parcel Map Sanborn Zoning Map Aerial Photographs Section 311Notice Reduced Plans


BF: G:\DOCUMENTS\DR\DU Removal\2nd_650_20110497D\DR Analysis for DUM.doc

Parcel Map






Sanborn Map*

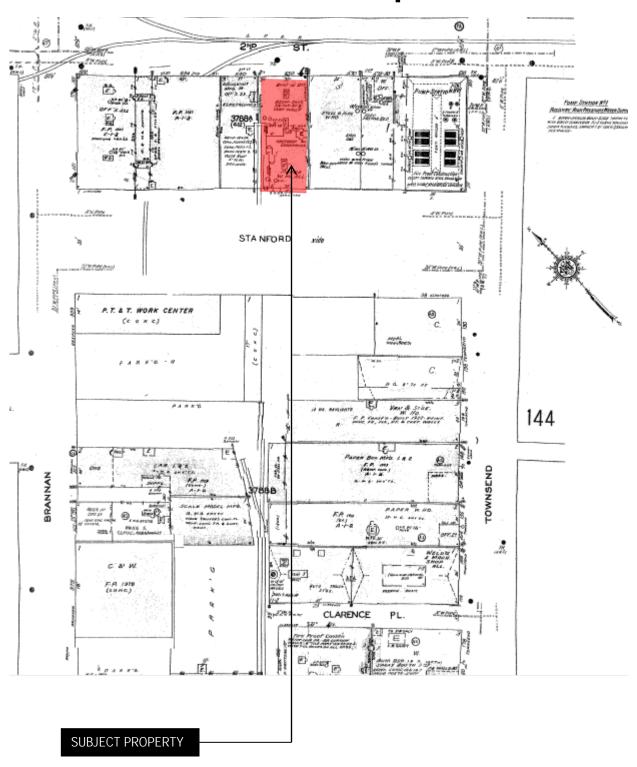


^{*}The Sanborn Maps in San Francisco have not been updated since 1998, and this map may not accurately reflect existing conditions.



Aerial Photo

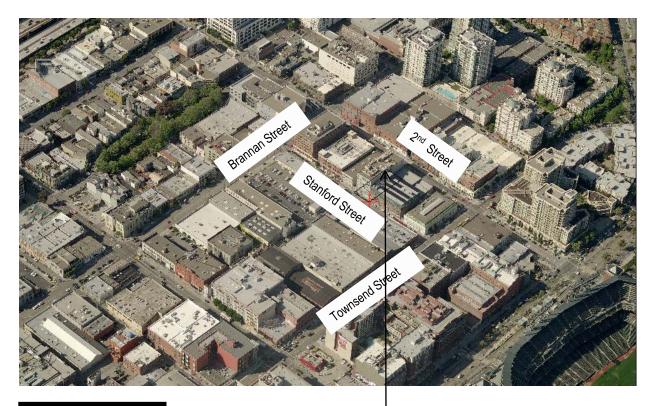


SUBJECT PROPERTY

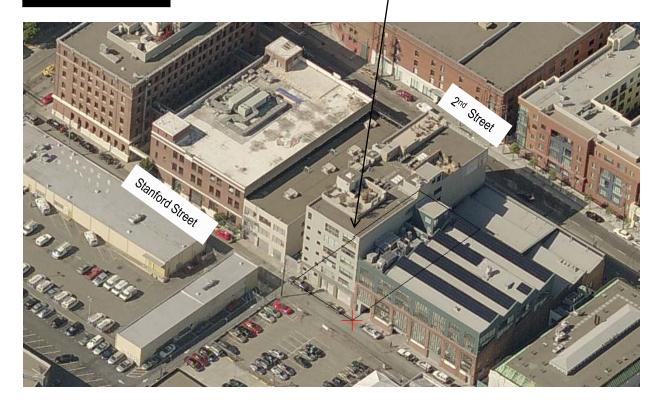

Planning Commission Hearing Case Number 2011.0497D 650 2nd Street

Zoning Map

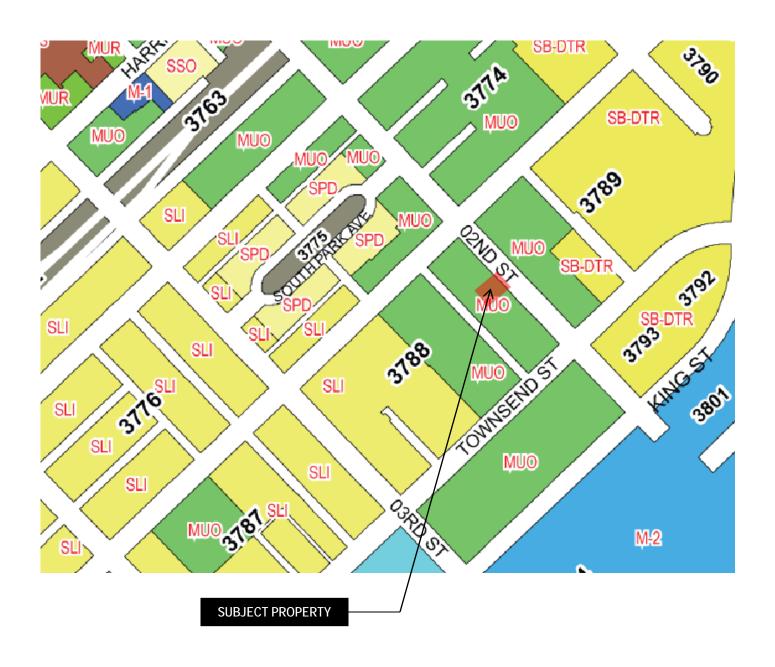



Planning Commission Hearing Case Number 2011.0497D 650 2nd Street





August 16, 2011

City of San Francisco Planning Department Zoning Administrator 1650 Mission Street, Ste 400 San Francisco, CA 94103

Bruce and Naomi Mann 650 2nd Street, Unit 401 and 402 San Francisco, CA

RE: Petition for Merging of Units - 650 - 2nd Street

Dear Planning Department,

CitiScape Property Management Group has been the managing agent for this homeowners association since 1999. This letter is to state that CitiScape Property Management supports approval of the petition on behalf of Bruce and Naomi Mann to merge units 401 and 402 at 650 2nd Street in San Francisco.

These two units have been a single unit with one kitchen and no demising wall since the original conversion of the building to live-work units in 1996. The two units were purchased by the Mann's as a joined single unit in June of 2009.

Please let me know if I can be of further assistance. I can be contacted a 415-920-2035 or by email at <u>jcarney@citiscapesf.com</u>.

Best regards.

John Carney Property Manager

650 2nd Street Homeowners Association

Ben A. Fu, City Planner Planning Department City and County of San Francisco 1650 Mission Street #400 San Francisco, CA 94103

Application to Merge Units 401 and 402, 650 2nd Street

Dear Mr. Fu:

In 1996 650 2nd Street was converted from a warehouse to live/work condominiums. Although the application to convert the building provided that 401 and 402 would be two separate units, they were sold to a single owner prior to build out and never occupied as separate units. There has never been a demising wall between the units, there has been only one kitchen, and the property has been continuously occupied by a single owner.

In 2008-9 the property was advertised and marketed by two successive real estate firms as "a 2 bedroom, 3 full bathroom live/work loft within 2,950 sq ft of living space." We bought the property in 2009. We relied on written representations by the prior owner (who has moved from San Francisco) that a single unit was being sold, that he was not aware of any alterations to the unit without necessary permits, that he had combined units 401 and 402 for single use, that he had complied with all building codes and that he had filed one or more permit applications for work on the Property and that "in each case" the permit(s) were issued and "an inspector approved the work in writing after completion."

Following purchase of the property, we obtained a building permit to renovate the property. The plans submitted to the City showed that the property had been and would continue to be a single unit. Our contractor then completed the renovation and received all necessary plumbing, electrical and other signoffs required from the City until the District Building Inspector, at the time of the final inspection, issued a Notice of Violation for a unit merger without a permit. This came as a complete surprise to our architect, contractor and us, and we would have never purchased or renovated the apartment if we had known that it was not legally a single residence.

Letters supporting our application have been written by owners of 17 of the 25 units. The merger would not remove any existing housing. Moreover, the fair market value of the units is in excess of \$3,100,000, well above the definition of affordable housing Section 317 was adopted to protect.

Photographs submitted with the application show that requiring us to create two units in a space that was a single residence for over 13 years before we purchased it is not economically feasible and would result in great economic loss to us.

Very truly yours,

Bruce and Naomi Mann

PLEASE NOTIFY FIRE INSPECTOR AT THE START OF HORK 558-3300 APR 1 3 2018

Vision 15: Lay.

WIND L DAY

INTERCTION CHARACTERS















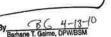

NO ALTERATION TO OR RECONSTRUCTION OF CITY RIGHT OF WAY UNDER THIS PERMIT.

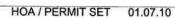

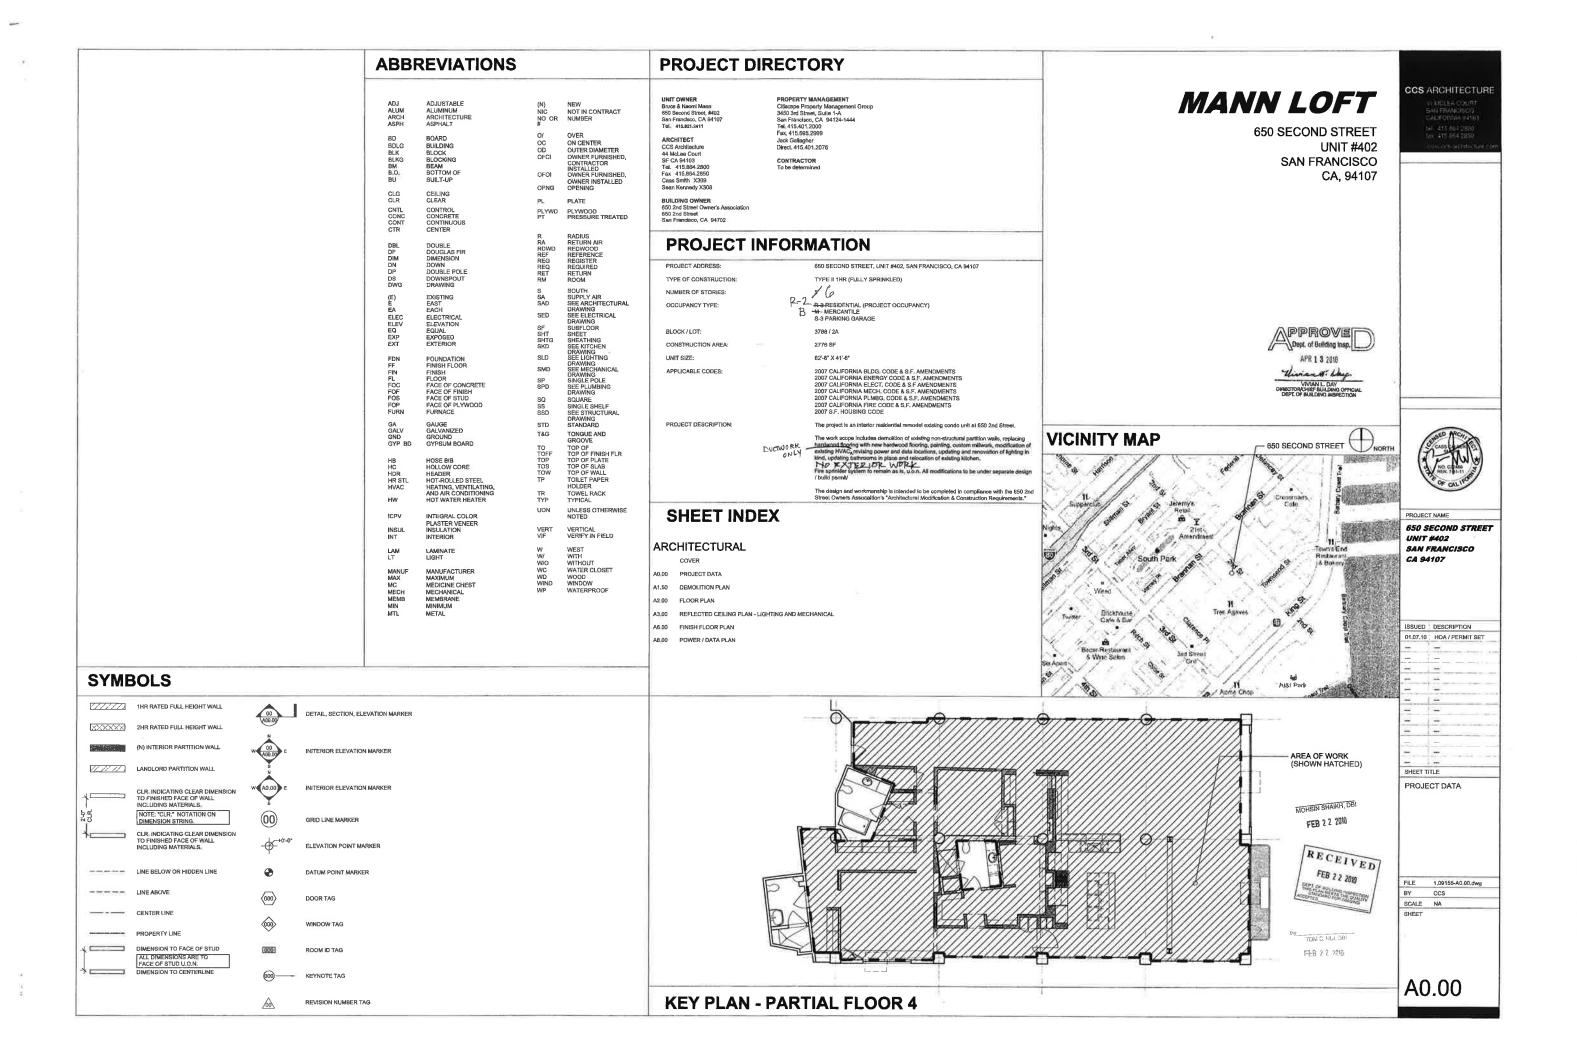

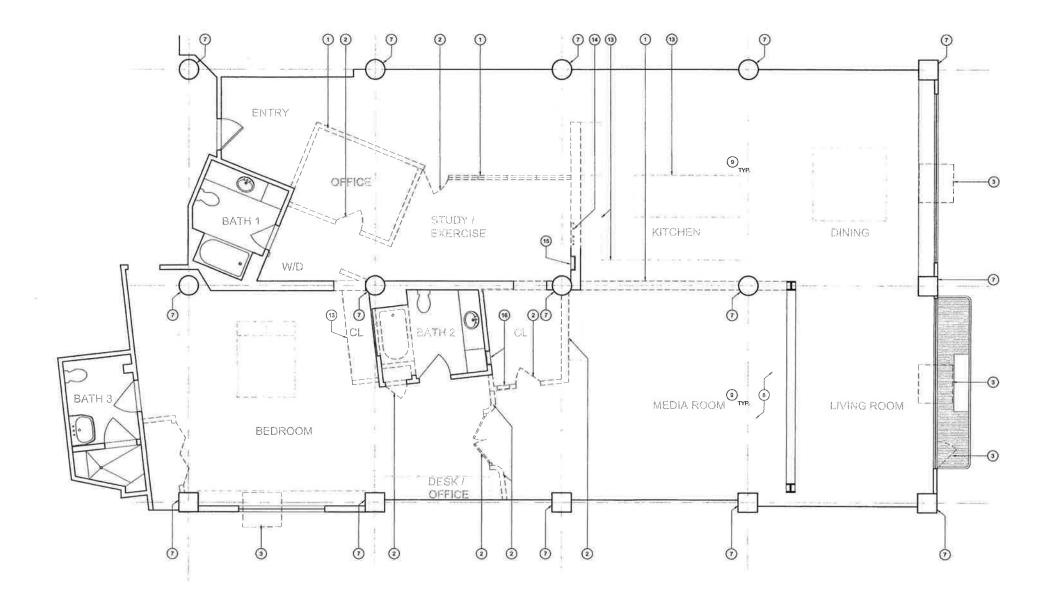





LEGEND

(E) WALL

DEMOLISHED WALL

DEMOLISHED MILLWORK / MISC,

CCS ARCHITECTURE

KEYNOTES
NOTE: NOT ALL NUMBERS WILL APPEAR ON THE SHEET

- 1 DEMO EXISTING PARTITION WALL
- 2 REMOVE (E) DOOR AND FRAME
- (E) OPERABLE WINDOW
- RELOCATE AND REMOVE (E) ELECTRICAL, REFER TO A3.00 FOR ADDITIONAL INFORMATION
- 5 DEMO EXISTING GLASS BLOCK PARTITION WALL
- RELOCATE CABLE / DATA. REFER TO A8 00 FOR ADDITIONAL INFORMATION
- (E) COLUMN TO REMAIN
- B (E) WOOD FLOOR TO BE REMOVED
- 9 REMOVE AND SALVAGE ALL LIGHT FIXTURES FOR OWNER
- (10) DEMOLISH (E) MILLWORK
- 11) REMOVE AND SALVAGE ALL FIXTURES FOR OWNER
- GAS LINE LATERAL RELOCATED TO (N) RANGE LOCATION.
- 13 DEMO (E) MILLWORK
- (E) PLUMBING RISER TO REMAIN
- (E) ELECTRICAL PANEL 1
- 18 RELOCATE (E) ELECTRICAL PANEL 2

GENERAL NOTES

- 1 SEE SHEET A0.01 FOR SYMBOL DEFINITIONS
- 2 COMPLETELY REMOVE ALL ABANDONED OR UNUSED UTILITY PIPING, CONDUIT, ETC.
- PREPARE EXISTING WALLS TO REMAIN TO RECEIVE NEW FINISHES, U.O.N.
- 4 VERIFY UTILITY PIPING (E) LAYOUT WITH NEW PARTITION WALLS



650 SECOND STREET UNIT #402 SAN FRANCISCO CA 94107

	4.5
-	-
=	-
-	-
=	-
	-
-	-
-	-
-	1 -
-	-
-	-
-	_
SHEET	TITLE

ISSUED DESCRIPTION 01.07.10 HOA / PERMIT SET

DEMOLITION PLAN

RECEIVED FEB 2 2 2010 THE PLAN ARETS THE CLASH STANDARD FOR HARDEN

PPROVE Dept. of Building Insp.

APR 1 3 2010

TONI C. HUI, DBI

FEB 7 2 2010

FILE 1,09155-A1,50,dwg SCALE 1/4" = 1'

A1.50


DOOR MARK	OPENING W X H	THICKNESS	TYPE	MATERIAL/ FINISH	FRAME/ FINISH	FIRE RATING	HARDWARE GROUP	REMARKS
1	2'-4" x 6'-0"	13"	SWING	WD PTD	SC WD PTD	-	1	-
2	3'-0" x B'-0"	1 3*	POCKET	WD PTD	SC WD PTD	-	2	-
3	3'-0" x 8'-0"	1 2	POCKET	WD PTD	SC WD PTD	E	2	
4	3'-0" x B'-0"	18	POCKET	WD PTD	SC WD PTD	-	2	-
5	4'-4" x 8'-0"	18	POCKET	WD PTD	SC WD PTD	-	2	*
6	4'-4" x 8'-0"	1 3	OFFSET PIVOT	WD PTD	SC WD PTD	#	2	H:
7	5'-11" x 7'-0"	1 है	DOUBLE FOLD, PAIR	WD PTD	SC WD PTD	-	æ.	LOO SO INCH MAKE UP
. 8	3'-0" x 8'-0"	18	POCKET	WD PTD	SC WD PTD	-	2	-
9	3'-0" x 7'-0"	1 1	DOUBLE SWING, PAIR	WD PTD	SC WD PTD	-	n n	*
10	3-0-× 2-0-	13	POCKET	WD PTD	SC WD PTD	-	2	
11	3'-6" × 6'-0"	1 है"	POCKET	WD PTD	SC WD PTD		2	w ·
12	5'-0" x 8'-0"	1 🚡	DOUBLE SWING, PAIR	WD PTD	SC WD PTD	-	3	-

ABBREVIATIONS

SCHEDULE NOTES

ALUM	ALUMINUM
(E)	EXISTING
SC	SOLID CORE
WD	WOOD
PTD	PAINTED

- ALL GYP, BD. TO BE SMOOTH TAPED UNLESS OTHERWISE NOTED SEE SPECS, FOR QUALITY REQ'S.
- 2. SEE PROJECT MANUAL FOR SPECIFIC MANUFACTURERS AND FINISHES.
- 3. PROVIDE SHOP DRAWINGS FOR ALL METAL DOORS, WINDOWS, SKYLIGHTS.

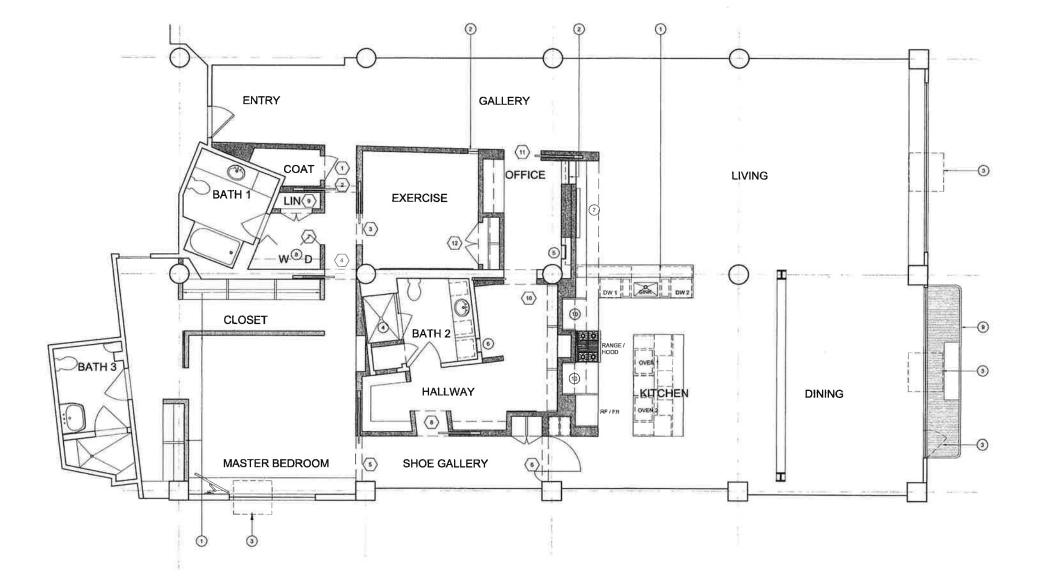





(E) WALL

(N) PARTITION WALL -PARTIAL HEIGHT



(N) WALL - FULL HEIGHT

CCS ARCHITECTURE

KEYNOTES

- 1 PARTIAL HEIGHT WALL
- 2 INTERIOR TEMPERED GLAZING
- 3 (E) OPERABLE WINDOW
- NEW SHOWER TO REPLACE (E) SHOWER / TUB, NEW SHOWER WALLS TO BE CERAMIC TILE WITH MOISTURE RESISTANT UNDERLAYMENT FULL HEIGHT TO CEILING.
- 6 (E) ELECTRICAL PANEL 1
- 8 RELOCATED (E) ELECTRICAL PANEL 2
- 7 AV EQUIPMENT
- (E) WASHER AND DRYER
- (E) EXTERIOR FIRE ESCAPE
- 10 APPLIANCE STORAGE
- (1)

GENERAL NOTES

- INT DIMENSIONS ARE TO FACE OF FINISH MATERIAL
- MOKE DETECTORS SHALL BE PROVIDED AT ALL BEDROOMS AND IN AREAS LEADING TO BEDROOMS SMOKE DETECTORS AT HEW WORK MUST BE HAROWIRED WI BATTERY BACK UP & MUST BE INTER-CONNECTED, SMOKE DETECTORS MUST BE NOTALLED PER MANUTS SPECS, PER C06 007-10.1.
- NO DOMESTIC DISHWASHING MACHINE SHALL BE DIRECTLY CONNECTED TO A DRAINAGE SYSTEM OR FOOD WASTE DISPOSER WITHOUT THE USE OF AN APPROVED DISHWASHER AIR GAP FITTING ON THE DISCHARGE SIDE OF THE DISHWASHING MACHINE, PER CPC 807.4
- GLAZING WITHIN A 24" ARC OF EITHER VERTICAL EDGE OF DOORWAY (INCLUDING SUDELIGHTS) OR GLAZING IN SHOWER AND BATHTUS ENCLOSURES OR GLAZING IN SHOWER AND BATHTUS ENCLOSURES OR GLAZING IN DOORS OR GLAZING IN RAILINGS OR GLAZING REPET WHEN THE BOTTOM EDGE IS LESS THAN 16" ABOVE THE FLOOR SHALL BE TEMPERED PER CBC 2406.3.5, 6, 7 & 6 AND 2407.
- FIXED PANELS OF TEMPERED GLASS SHOWER ENCLOSURE MUST BE ATTACHED TO FRAMING W/ CLIPS, TRACK OR CHANNEL ON AT LEAST 2 SIDES.
- ALL SHOWER VALVES MUST BE TEMPERATURE BALANCING OR THERMOSTATIC MIXING, VALVES SHALL BE ADJUSTED PER THE MANUF'S INSTRUCTIONS TO DELIVER A MAX. OF 120° F, PER CPC 418.0.
- PROVIDE SMOOTH, HARD, NONABSORBENT SURFACE OVER MOISTURE RESISTANT UNDERLAYMENT TO A HEIGHT OF 70° ABOVE DRAIN INLET IN ALL SHOWER-/TUB WALLS AND FLOORS,
- CEMENT, FIBER-CEMENT OR GLASS MAT GYP BACKERS SHALL BE USED AS A BASE FOR WALL TILE IN TUB & SHOWER AREAS & WALL AND CLG PANELS IN SHOWER AREAS, PER CBC 2509,2



Wivian W. Lay





TOM C. HUL DBI FEB 72 2000



PROJECT NAME

ISSUED DESCRIPTION

650 SECOND STREET UNIT #402 SAN FRANCISCO CA 94107


01.07.10 HOA / PERMIT SET SHEET TITLE

FLOOR PLAN AND DEMOLITION PLAN

FILE 1.09155-A2.00.dwg BY BJS SCALE 1/4" = 1"

1 FLOOR PLAN A2.00 1/4" = 1'

A2.00

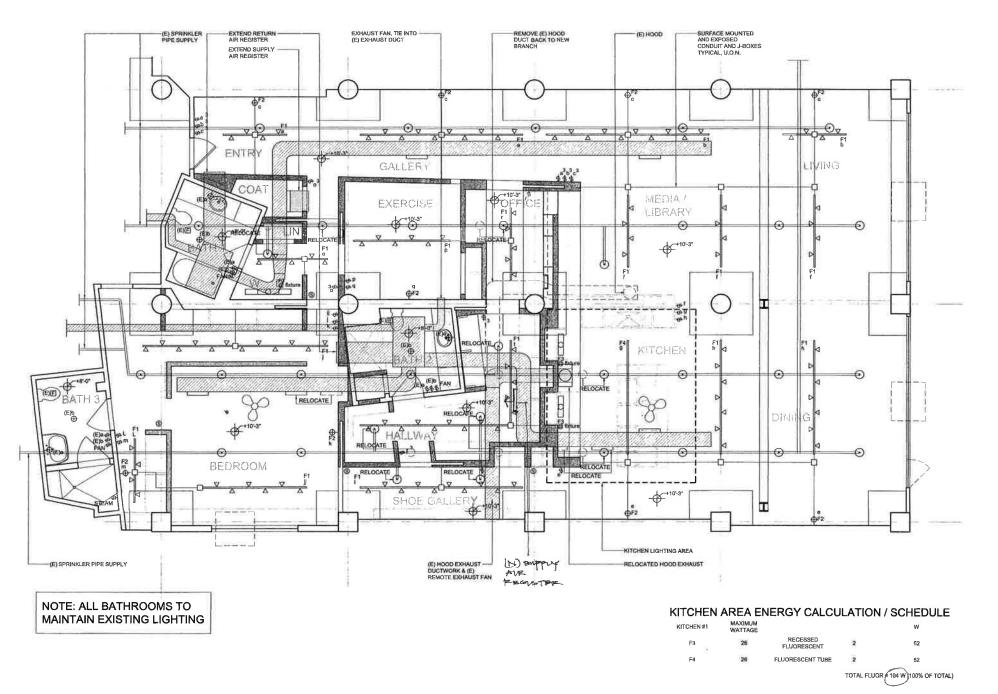

LEGEND



(E) FIRE SPRINKLER

REMOVED (E) DUCT

CCS ARCHITECTURE

GENERAL NOTES

- 1 (E) CEILING IN BATHROOMS TO REMAIN, U.O.N.
- (E) BATHROOM LIGHTING AND SWITCHING TO REMAIN OR UPDATED IN PLACE, U.O.N.
- (E) HOOD EXHAUST DUCT AND REMOTE FAN TO REMAIN / RELOCATED WHERE NOTED.
- 4 CENTER LIGHT ON WALL OR CEILING U.O.N. 5 ALL DIMENSIONS FROM FACE OF WALL TO CENTERLINE OF FIXTURE
- ALL SWITCHES TO BE MTD +38" AFF AND 8" OFF DR OPENING OR CORNER, U.O.N.
- CONTRACTOR TO INSTALL ALL RECESSED EXTURES, GET ARCHITECT APPROVAL ON LOCATIONS, THEN DO WIRING.
- 8 SAME FOR ALL RECEPTACLE BOXES,
- ALL LIGHT SWITCHES TO BE DIMMERS, U.O.N. CA TITLE 24 LIGHTING REQUIREMENTS FOR RESIDENTIAL PROJECTS:
- A. KITCHEN: AT LEAST HALF OF THE INSTALLED WATTAGE OF LIGHT FIXTURES SHALL BE HIGH EFFICACY AND THE ONES THAT ARE NOT MUST BE SWITCHED SEPARATELY,
- 10 B. LIGHTING IN BATHROOMS, GARAGES, LAUNDRY ROOMS AND UTILITY ROOMS: ALL LIGHT FIXTURES SHALL BE ETHER HIGH EFFICACY OR SHALL BE CONTROLLED BY AN OCCUPANT SENSOR.
 - C. OTHER ROOMS: ALL LIGHT FIXTURES SHALL BE CONTROLLED BY A DIMMER, EXCEPT IN CLOSETS LESS THAN 70 SQUARE FEET.
- 11 SWITCH CODE ON FIXTURES DESIGNATE CIRCUIT.
- 12 ALL SMOKE DETECTORS TO BE 110V (HARDWIRED) W/ BATTERY BACKUP.
- 13 LIGHT FIXTURES IN TUB/SHOWER ENCLOSURE TO BE SUITABLE FOR DAMP LOCATIONS.

- 17 EXISTING HVAC SYSTEM TO REMAIN WITH MINOR DUCT AND REGISTER MODIFICATIONS.

RCP	LEGEND
0	CEILING FIXTURE
0	RECESSED DOWNLIGHT
•	WALLWASHER
	RECESSED WALLWASHER
•	SPOTLIGHT
Ф	WALL FIXTURE
	RECESSED WALL FIXTURE
a	STEP LIGHT
•	LANDSCAPE FIXTURE
0	GROUND MOUNTED LANDSCAPE FIXTURE
Н	UNDER COUNTER/SHELF STRIP FIXTURE



PENDANT FIXTURE

- EXHAUST FANS IN POWDER ROOM AND BATHROOMS TO BE CAPABLE TO PROVIDE FIVE (5) AIR CHANGES PER HOUR (PER CBC 1203 3).
- 15 SPRINKLER LAYOUT TO BE A DEFERRED SUBMITTAL,
- SUBMITTAL,

 SMOKE DETECTORS SHALL BE PROVIDED AT ALL
 BEDROOMS AND IN AREAS LEADING TO BEDROOMS
 SMOKE DETECTORS AT NEW WORK MUST BE
 HARDWIRED W BATTERY BACK UP AND MUST BE
 INTER-CONNECTED, SMOKE DETECTORS MUST BE
 INSTALLED PER MANUFS SPECS, PER CBC
 907.2.10.1.

FLUORESCENT FIXTURE	
SURFACE MOUNTED FLUORESCENT	PROJECT NAME
WALL MOUNTED FLUORESCENT FIXTURE	650 SECOND STREET UNIT #402
SWITCH	SAN FRANCISCO
SWITCH, 3-POLE	CA 94107
SWITCH, 4-POLE	
SPRINKLER	1



AND GRID EXHAUST FAN

PPROVE

APR 1 3 _13

		-
	-	-
	-	
	-	-
	-	1-
1)		-
)	-	-
	-	-
	-	_

ISSUED DESCRIPTION

01,07.10 HOA / PERMIT SET

SHEET TITLE REFLECTED CEILING PLAN - LIGHTING AND MECHANICAL



RECEIVED FEB 2 2 2010


TOM C. HUI, DBI FEB 2.2 and

FILE 1.09155-A3.00 dwg BY BJS SCALE 1/4" = 1"


A3.00



NOTE: ALL ACOUSTICAL ENGINEERING ON NEW FLOORS TO BE MINIMUM 59 STC RATING PER HOMEOWNERS ASSOCIATION REQUIREMENTS.

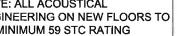

LEGEND 1/1// (E) TILE FLOOR (N) TILE FLOOR (N) WOOD FLOOR (N) CARPET

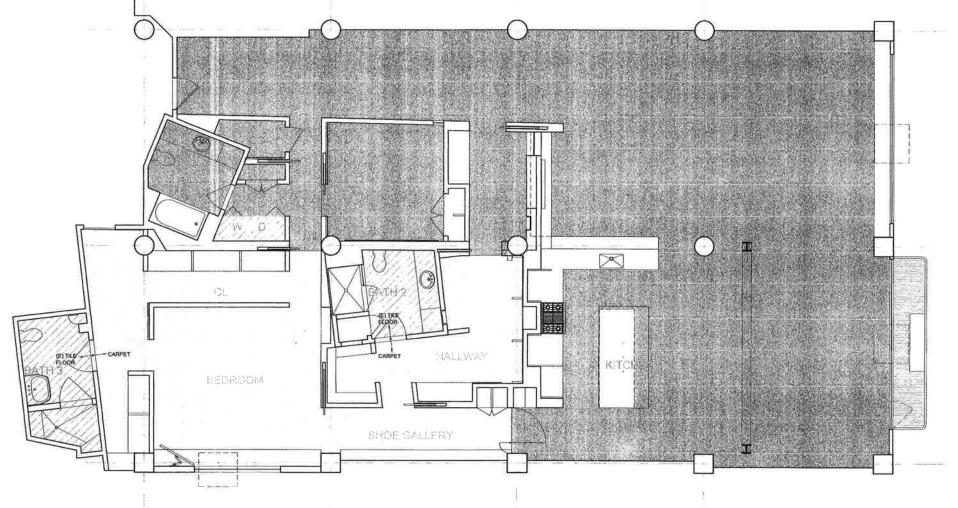



CCS ARCHITECTURE

PROJECT NAME

650 SECOND STREET UNIT #402 SAN FRANCISCO CA 94107

DESCRIPTION
HOA / PERMIT SET
-
-
TLE

FILE	1,09155-A6.00.dwg
BY	BJS
SCALE	1/4" = 1"


A6.00



RECEIVED FEB 2 2 2010 DEFT, OF BUILDING SEPECTALS THE CHARLES AND SEPECTALS AND






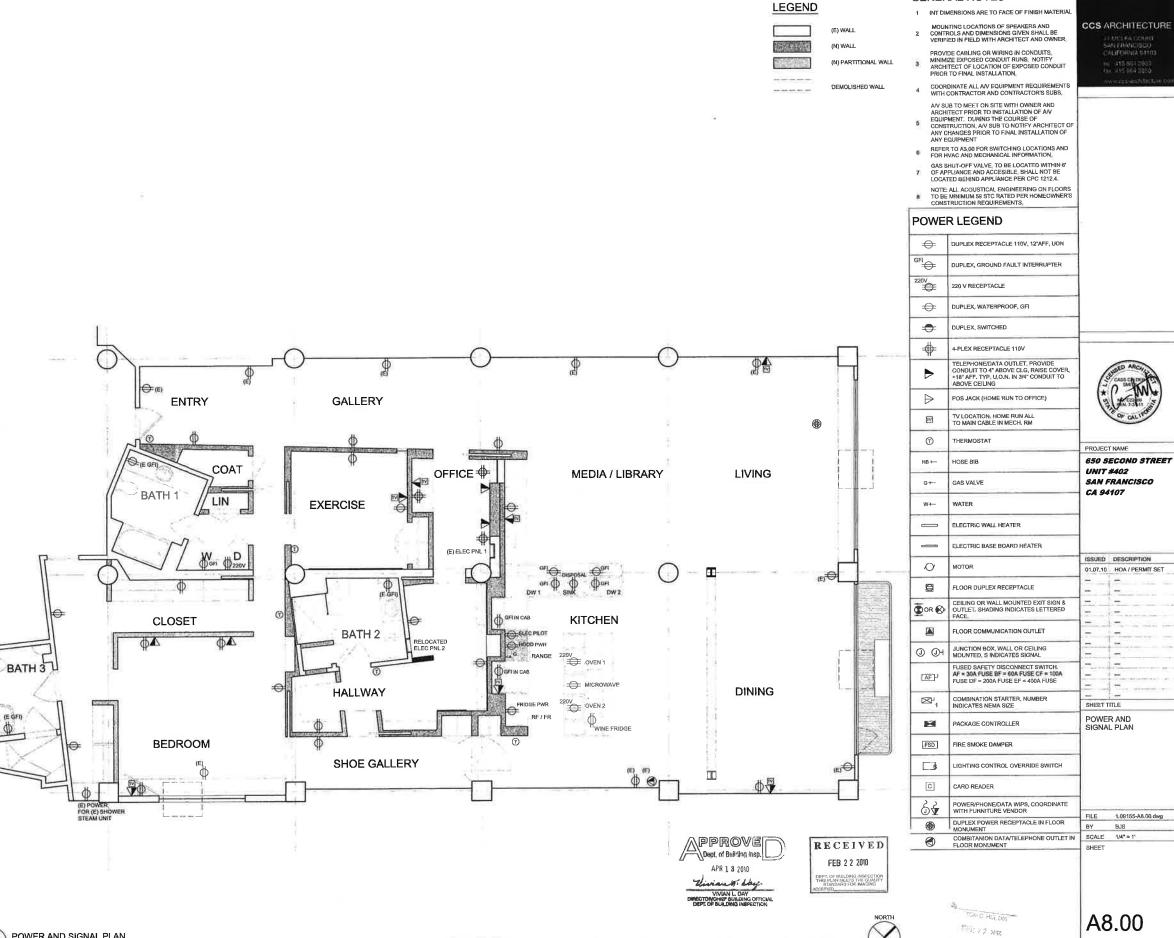


GENERAL NOTES


1 POWER AND SIGNAL PLAN
1/4" = 1"

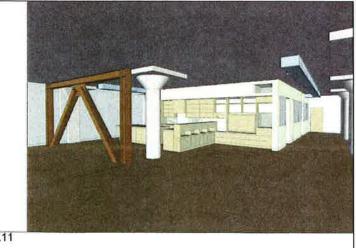

CCS ARCHITECTURE

AS-BUILT SET 01.11.11

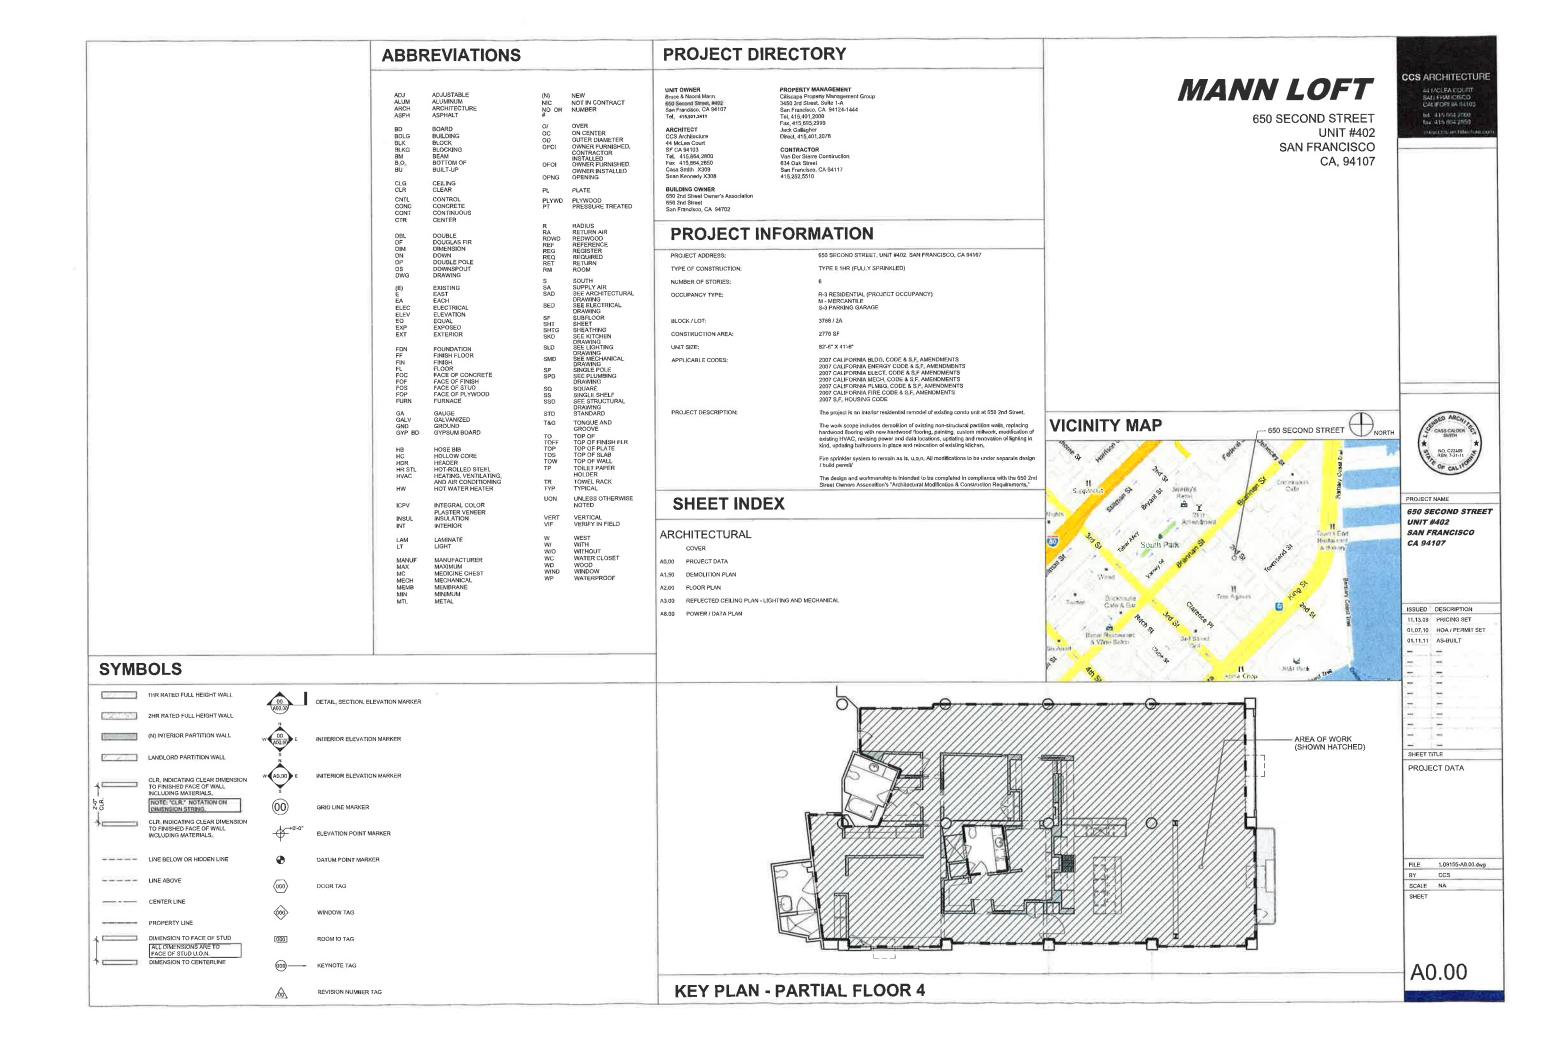

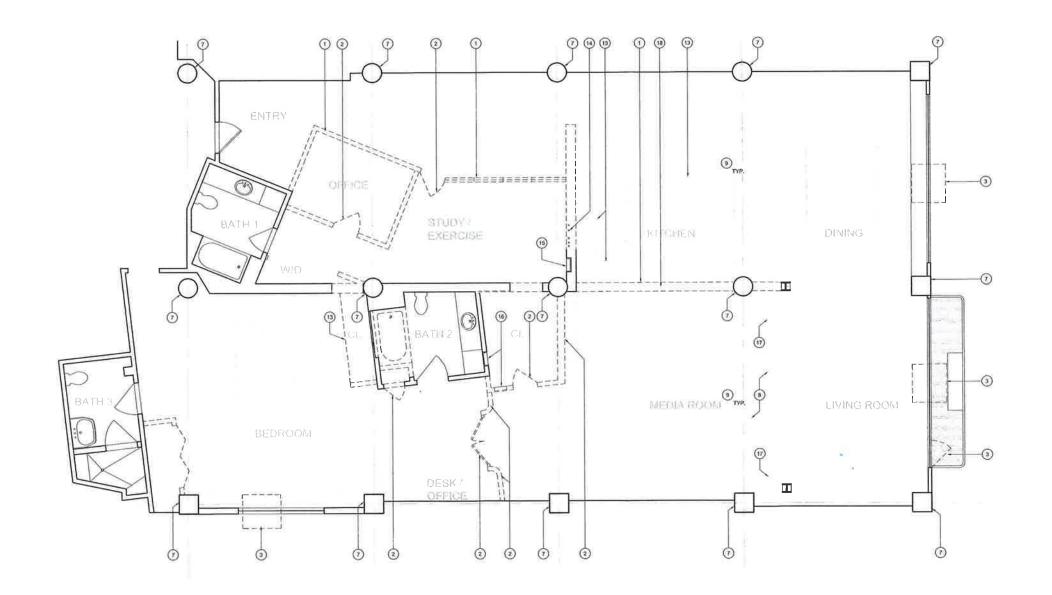

1 DEMOLITION PLAN A1.50 1/4" = 1"



LEGEND

DEMOLISHED WALL

DEMOLISHED MILLWORK / MISC.

CCS ARCHITECTURE
44 MCLEA COURT
SALLEMA MATERIA
CALEDRIA MATERIA
961 415 164 2/200

KEYNOTES

NOTE: NOT ALL NUMBERS WILL APPEAR ON THE S

- DEMO EXISTING PARTITION WALL
- 2 REMOVE (E) DOOR AND FRAME
- (E) OPERABLE WINDOW
- RELOCATE AND REMOVE (E) ELECTRICAL, REFER TO A3,00 FOR ADDITIONAL INFORMATION
- DEMO EXISTING GLASS BLOCK PARTITION WALL
- RELOCATE CABLE / DATA. REFER TO A8.00 FOR ADDITIONAL INFORMATION
- (E) COLUMN TO REMAIN
- (E) WOOD FLOOR TO BE REMOVED
- REMOVE AND SALVAGE ALL LIGHT FIXTURES FOR OWNER
- DEMOLISH (E) MILLWORK
- REMOVE AND SALVAGE ALL FIXTURES FOR OWNER
- GAS LINE LATERAL RELOCATED TO (N) RANGE LOCATION.
- (1) DEMO (E) MILLWORK
- (E) PLUMBING RISER TO REMAIN
- (E) ELECTRICAL PANEL 1
- (II) RELOCATE (E) ELECTRICAL PANEL 2
- (r) REMOVE (E) FLOOR OUTLETS
- RELOCATE (E) GAS LINE PER DRAWINGS

GENERAL NOTES

- 1 SEE SHEET A0.01 FOR SYMBOL DEFINITIONS
- 2 COMPLETELY REMOVE ALL ABANDONED OR UNUSED UTILITY PIPING, CONDUIT, ETC.
- 3 PREPARE EXISTING WALLS TO REMAIN TO RECEIVE NEW FINISHES, U.O.N.
- 4 VERIFY UTILITY PIPING (E) LAYOUT WITH NEW PARTITION WALLS

PROJECT NAME

650 SECOND STREET

UNIT #402

SAN FRANCISCO

CA 94107

01.07.16 HOA/ PERMIT SET
01.13.10 DESIGN MEETING
01.22.10 DESIGN MEETING
02.01,10 BID SET
04.06.10 CONSTRUCTION SET
04.70.11.11.10 AS-BUILT SET

ISSUED DESCRIPTION

SHEET TITLE
DEMOLITION PLAN


FILE 1,09155-A1.50.dwg
BY BJS
SCALE 1/4" = 1"

A1.50

DOOR MARK	OPENING W X H	THICKNESS	TYPE	MATERIAL/ FINISH	FRAME/ FINISH	FIRE RATING	HARDWARE GROUP	REMARKS
1	2'-4" x 8'-0"	1 30	SWING	WD PTD	SC WD PTD	2.	1	М
2	3-0. × 8-0.	1 3"	POCKET	WD PTD	SC WD PTD	-	2	
3	3'-0" x 8'-0"	1 3*	POCKET	WD PTD	SC WD PTD	90	2	9.
4	3'-0" x 8'-0"	1 %	POCKET	WD PTD	SC WD PTD	27	2	22
5	4'-4" x 8'-0"	1 3"	POCKET	WD PTD	SC WD PTD		2	=
6	4'-4" x 8'-0"	1 3	OFFSET PIVOT	WD PTD	SC WD PTD		2	
7	5'-11" x 7'-0"	1 %	DOUBLE FOLD, PAIR	WO PTD	SC WD PTD	200	===	-
8	3,-0, × g0,	1 है'	POCKET	WD PTD	SC WD PTD	-	2	
9	3'-0" x 7'-0"	1 है"	DOUBLE SWING, PAIR	WD PTD	SC WD PTD	127	-	-
10	3'+0" × 8'+0"	1 3"	POCKET	WD PTD	SC WD PTD	(#).	2	-
11	3'-6" x 8'-0"	1 3"	POCKET	WO PTD	SC WD PTD	- A-1	2	-
12	5'-0" × 8'-0"	13	DOUBLE SWING, PAIR	WD PTD	SC WD PTD		3	201

ALUM	ALUMINUM
(E)	EXISTING
SC	SOLID COR
WD	WOOD
PTD	PAINTED

- 1, ALL GYP, BD, TO BE SMOOTH TAPED UNLESS OTHERWISE NOTED SEE SPECS, FOR QUALITY REQ'S,
- 2, SEE PROJECT MANUAL FOR SPECIFIC MANUFACTURERS AND FINISHES,
- 3. PROVIDE SHOP DRAWINGS FOR ALL METAL DOORS, WINDOWS, SKYLIGHTS,

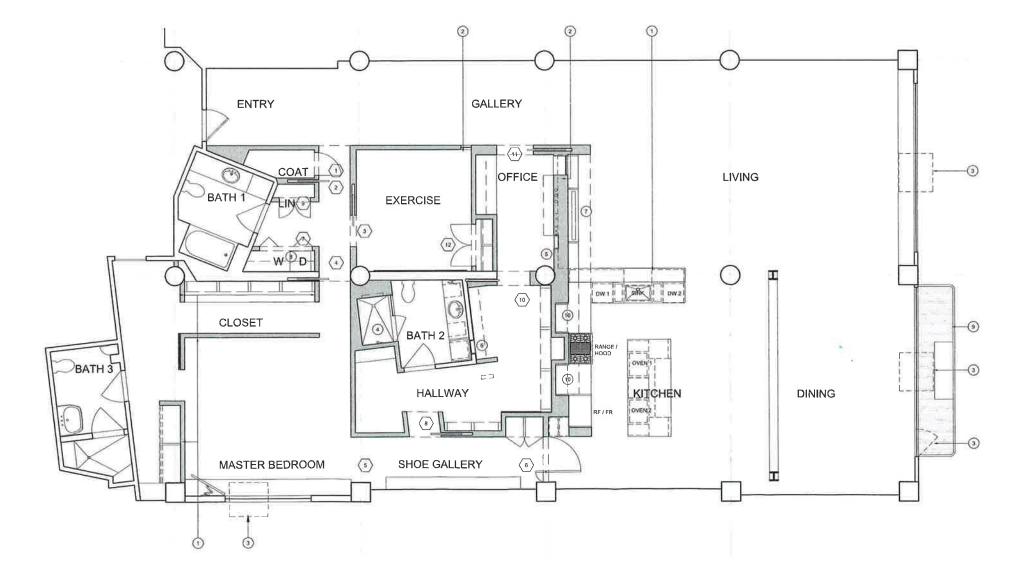

1 FLOOR PLAN A2.00 1/4" = 1"



LEGEND

(N) PARTITION WALL .. PARTIAL HEIGHT

CCS ARCHITECTURE CALIFORNIA DI SCO 164 415 104 2000 CC 215 104 2005)

KEYNOTES

- PARTIAL HEIGHT WALL
- 2 INTERIOR TEMPERED GLAZING
- (E) OPERABLE WINDOW
- NEW SHOWER TO REPLACE (E) SHOWER / TUB, NEW SHOWER WALLS TO BE CERAMIC TILE WITH MOSTURE RESISTANT UNDERLAYMENT FULL HEIGHT TO CEILING.
- (E) ELECTRICAL PANEL 1
- RELOCATED (E) ELECTRICAL PANEL 2
- 7 AV EQUIPMENT
- (E) WASHER AND DRYER
- 9 (E) EXTERIOR FIRE ESCAPE
- 10 APPLIANCE STORAGE
- (1) ROLL-OUT DRAWER IN EXISTING CABINET
- (E) ELECTRICAL PANEL 2

GENERAL NOTES

- INT DIMENSIONS ARE TO FACE OF FINISH MATERIAL
- SMOKE DETECTORS SHALL BE PROVIDED AT ALL BEDROOMS AND IN AREAS LEADING TO BEDROOMS SMOKE DETECTORS AT NEW WORK MUST BE HARDWIRED WIS BENTERY BACK UP & MUST BE INTER-CONDECTED, SMOKE DETECTORS MUST BE INSTALLED PER MANUFS SPECS, PER CBC 907,10.1,
- NO DOMESTIC DISHWASHING MACHINE SHALL BE DIRECTLY CONNECTED TO A DRAINAGE SYSTEM OR FOOD WASTE DISPOSER WITHOUT THE USE OF AN APPROVED DISHWASHER AIR GAP FITTING ON THE DISCHARGE SIDE OF THE DISHWASHING MACHINE, PER CPC 807.4.
- GLAZING WITHIN A 24" ARC OF EITHER VERTICAL EDGE OF DOORWAY (INCLUDING SIDELICHTS) OR GLAZING IN SHOWER AND BATHTUS ENCLOSURES OR GLAZING IN DOORS OR GLAZING IN RAILINGS OR GLAZING GREATER THAN 9 SQUARE FEET WHEN THE BOTTOM EDGE IS LESS THAN 16" ABOVE THE FLOOR SHALL BE TEMPERED PER CBC 2406.3.5, 6, 7 & 8 AND 2407.
- FIXED PANELS OF TEMPERED GLASS SHOWER ENCLOSURE MUST BE ATTACHED TO FRAMING W/ CLIPS, TRACK OR CHANNEL ON AT LEAST 2 SIDES.
- ALL SHOWER VALVES MUST BE TEMPERATURE BALANCING OR THERMOSTATIC MIXING, VALVES SHALL BE ADJUSTED PER THE MANUP'S INSTRUCTIONS TO DELIVER A MAX, OF 120° F, PER CPC 418.0.
- PROVIDE SMOOTH, HARD, NONABSORBENT SURFACE OVER MOISTURE RESISTANT UNDERLAYMENT TO A HEIGHT OF 70 ABOVE ORAIN INLET IN ALL SHOWER-/TUB WALLS AND FLOORS.
- CEMENT, FIBER-CEMENT OR GLASS MAT GYP BACKERS SHALL BE USED AS A BASE FOR WALL TILE IN TUB & SHOWER AREAS & WALL AND CLG PANELS IN SHOWER AREAS, PER CBC 2509 2,



PROJECT NAME


650 SECOND STREET UNIT #402 SAN FRANCISCO CA 94107

ISSUED	DESCRIPTION HOA / PERMIT SET		
01.07.10			
01.11.11	AS-BUILT		
-			
=	7		
-	=		
-	-		
5	= -		
***	5		
***	-		
-	-		
-	-		
-	-:		

FLOOR PLAN AND DEMOLITION PLAN

FILE 1.09155-A2.00.dwg BY BJS SCALE 1/4" = 1" SHEET

A2.00

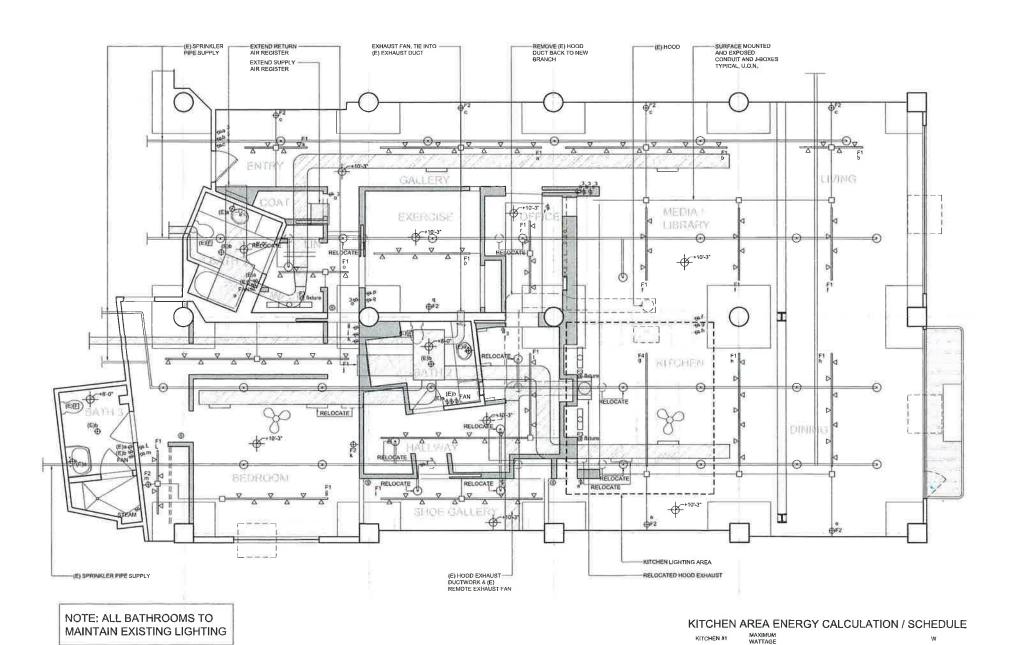

F3

FLUORESCENT TUBE

TOTAL FLUOR = 104 W (100% OF TOTAL)

LEGEND



(E) FIRE SPRINKLER

REMOVED (E) DUCT

CCS ARCHITECTURE 441/CLEA COURT SALEHALOISCO CAUFORNIA 94100

GENERAL NOTES

- (E) CEILING IN BATHROOMS TO REMAIN, U.O.N. (E) BATHROOM LIGHTING AND SWITCHING TO REMAIN OR UPDATED IN PLACE, U.O.N.
- (E) HOOD EXHAUST DUCT AND REMOTE FAN TO REMAIN / RELOCATED WHERE NOTED.
- 4 CENTER LIGHT ON WALL OR CEILING U.O.N.
- ALL DIMENSIONS FROM FACE OF WALL TO CENTERLINE OF FIXTURE
- ALL SWITCHES TO BE MTD +35° AFF AND 8° OFF DR OPENING OR CORNER, U.O.N.
 CONTRACTOR TO INSTALL ALL RECESSED
 FIXTURES, GET ARCHITECT APPROVAL ON LOCATIONS, THEN DO WIRING,
- SAME FOR ALL RECEPTACLE BOXES.
- ALL LIGHT SWITCHES TO BE DIMMERS, U.O.N. CA TITLE 24 LIGHTING REQUIREMENTS FOR RESIDENTIAL PROJECTS;
- A, KITCHEN: AT LEAST HALF OF THE INSTALLED WATTAGE OF LIGHT FIXTURES SHALL BE HIGH EFFICACY AND THE ONES THAT ARE NOT MUST BE SWITCHED SEPARATELY,
- 10 B. LIGHTING IN BATHROOMS, GARAGES, LAUNDRY ROOMS AND UTILITY ROOMS: ALL LIGHT FIXTURES SHALL BE EITHER HIGH EFFICACY OR SHALL BE CONTROLLED BY AN OCCUPANT SENSOR. C. OTHER ROOMS: ALL LIGHT FIXTURES SHALL BE CONTROLLED BY A DIMMER, EXCEPT IN CLOSETS LESS THAN 70 SQUARE FEET,
- 11 SWITCH CODE ON FIXTURES DESIGNATE CIRCUIT,
- 12 ALL SMOKE DETECTORS TO BE 110V (HARDWIRED) W/ BATTERY BACKUP.
- 13 LIGHT FIXTURES IN TUB/SHOWER ENCLOSURE TO BE SUITABLE FOR DAMP LOCATIONS.
- EXHAUST FANS IN POWDER ROOM AND 14 BATHROOMS TO BE CAPABLE TO PROVIDE FIVE (5) AIR CHANGES PER HOUR (PER CBC 1203.3).
- 15 SPRINKLER LAYOUT TO BE A DEFERRED SUBMITTAL
- SUBMITTAL
 SMOKE DETECTORS SHALL BE PROVIDED AT ALL
 BEDROOMS AND IN AREAS LEADING TO BEDROOMS,
 SMOKE DETECTORS AT NEW WORK MUST BE
 HARDWIRED W BATTERY BACK UP AND MUST BE
 INTER-CONNECTED. SMOKE DETECTORS MUST BE
 INSTALLED PER MANUFS SPECS, PER CBC
 907.2.10.1.
- 17 EXISTING HVAC SYSTEM TO REMAIN WITH MINOR DUCT AND REGISTER MODIFICATIONS.

RCP LI	EGEND	
	CEILING FIXTURE	ľ
0	RECESSED DOWNLIGHT	
	WALLWASHER	
	RECESSED WALLWASHER	
•	SPOTLIGHT	
₩	WALL FIXTURE	
•	RECESSED WALL FIXTURE	
d	STEP LIGHT	
•	LANDSCAPE FIXTURE	
0	GROUND MOUNTED LANDSCAPE FIXTURE	
Н	UNDER COUNTER/SHELF STRIP FIXTURE	
	STRIP TUBE LIGHT	
Ж	MONOPOINT FIXTURE	
Se €	CEILING FAN	
®	SMOKE DETECTOR	
∇	TRACK LIGHT	
•	CONCEALED TRACK LIGHT	
	PENDANT FIXTURE	
	FLUORESCENT FIXTURE	
0	SURFACE MOUNTED FLUORESCENT	

\neg	
	PROJECT NAME
-	650 SECOND STREE
	UNIT #402
	SAN FRANCISCO
-	CA 94107

	SWITCH_4-POLE		
	SPRINKLER		
	RETURN AIR/ TRANSFER GRILLE		
SUPPLY AIR DIFFUSER	SUPPLY AIR DIFFUSER	ISSUED	DESCRIPTION
-	-	01,07.10	HOA / PERMIT SET
-	ACOUSTICAL CEILING	01,11,11	AS-BUILT
-	AND GRID		-

WALL MOUNTED FLUORESCENT FIXTURE

SWITCH SWITCH, 3-POLE

EXHAUST FAN

__Q__


SHEET TITLE

REFLECTED CEILING PLAN - LIGHTING AND MECHANICAL

FILE 1.09155-A3.00 dwg BY BJS SCALE 1/4" = 1"

A3.00



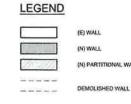


GENERAL NOTES

- 1 INT DIMENSIONS ARE TO FACE OF FINISH MATERIAL
- MOUNTING LOCATIONS OF SPEAKERS AND CONTROLS AND DIMENSIONS GIVEN SHALL BE VERIFIED IN FIELD WITH ARCHITECT AND OWNER
- PROVIDE CABLING OR WIRING IN CONDUITS. MINIMIZE EXPOSED CONDUIT RUNS. NOTIFY ARCHITECT OF LOCATION OF EXPOSED CONDUIT PRIOR TO FINAL INSTALLATION.
- 4 COORDINATE ALL AV EQUIPMENT REQUIREMENTS WITH CONTRACTOR AND CONTRACTOR'S SUBS.

CCS ARCHITECTURE 44 MCLEA COURT SAN FRANCISCO CALIFORNIA 94103

- AV SUB TO MEET ON SITE WITH OWNER AND ARCHITECT PRIOR TO INSTALLATION OF AV EQUIPMENT. DURING THE COURSE OF CONSTRUCTION, AV SUB TO NOTIFY ARCHITECT OF ANY COURMENT OF FINAL INSTALLATION OF ANY EQUIPMENT.
- REFER TO A3,00 FOR SWITCHING LOCATIONS AND FOR HVAC AND MECHANICAL INFORMATION.
- GAS SHUT-OFF VALVE. TO BE LOCATED WITHIN 6' OF APPLIANCE AND ACCESIBLE, SHALL NOT BE LOCATED BEHIND APPLIANCE PER CPC 1212.4.
- NOTE: ALL ACQUSTICAL ENGINEERING ON FLOORS TO BE MINIMUM 59 STC RATED PER HOMEOWNER'S CONSTRUCTION REQUIREMENTS.

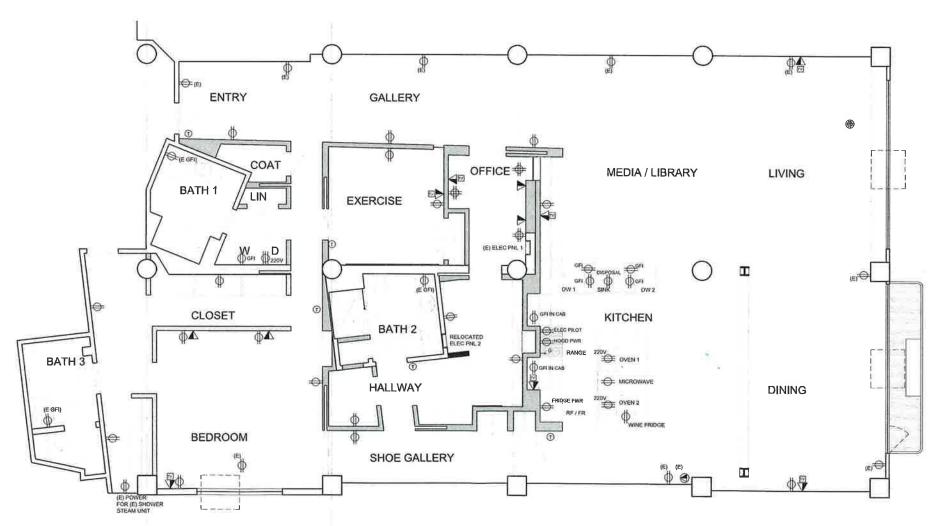

POWER LEGEND

 \Rightarrow DUPLEX RECEPTACLE 110V, 12"AFF, UON GFI ⊕ DUPLEX, GROUND FAULT INTERRUPTER 220V 220 V RECEPTACLE -DUPLEX, WATERPROOF, GFI DUPLEX, SWITCHED

4-PLEX RECEPTACLE 110V

TELEPHONE/DATA OUTLET, PROVIDE CONDUIT TO 4" ABOVE CLG, RAISE COVER, +18" AFF. TYP, U.O.N, IN 3/4" CONDUIT TO ABOVE CEILING D POS JACK (HOME RUN TO OFFICE)

TV LOCATION, HOME RUN ALL TO MAIN CABLE IN MECH, RM W 1

WATER

THERMOSTAT PROJECT NAME HB+-HOSE BIB 650 SECOND STREET UNIT #402 G+ GAS VALVE SAN FRANCISCO CA 94107

ELECTRIC WALL HEATER ELECTRIC BASE BOARD HEATER ISSUED DESCRIPTION 0

01.11.11 AS-BUILT FLOOR DUPLEX RECEPTACLE © OR SO CEILING OR WALL MOUNTED EXIT SIGN & OUTLET, SHADING INDICATES LETTERED FACE. FLOOR COMMUNICATION OUTLET

⊠r, COMBINATION STARTER, NUMBER INDICATES NEMA SIZE SHEET TITLE

POWER AND SIGNAL PLAN PACKAGE CONTROLLER FSD FIRE SMOKE DAMPER

\$ LIGHTING CONTROL OVERRIDE SWITCH C CARD READER

POWER/PHONE/DATA WIPS, COORDINATE WITH FURNITURE VENDOR &₹ DUPLEX POWER RECEPTACLE IN PLOOR MONUMENT •

COMBITANION DATA-TELEPHONE OUTLET IN FLOOR MONUMENT

A8.00

FILE 1.09155-A8.00.dwg

BY BJS

SCALE 1/4" = 1" SHEET

01.07.10 HOA / PERMIT SET