



EXECUTIVE SUMMARY

INCLUSIONARY AFFORDABLE HOUSING RESOLUTION

HEARING DATE: March 25, 2021

Record No.: 2021-001410CRV
Project Address: 42 Otis Street
Zoning: Moderate-Scale Neighborhood Commercial Transit (NCT-3) Zoning District
50-X Height and Bulk District
Block/Lot: 3505/020
Project Sponsor: Eduardo Sagues-Castillo
3456 Sacramento Street
San Francisco, CA 94118
Property Owner: Costanoan LLC
San Francisco, CA 94118
Staff Contact: Esmeralda Jardines – (628) 652-7531
esmeralda.jardines@sfgov.org

Recommendation: Approve

Project Description

The proposal is for a change to the inclusionary affordable housing compliance method from on-site to the Affordable Housing Fee, pursuant to Planning Code Section 415, for the Project involving demolition of the existing two-story industrial building and construction of a new five-story, 55-foot tall mixed-use building containing 24 Single-Room Occupancy (SRO) dwelling unit, and 3,458 square feet of commercial uses. There are three private second-floor decks that would provide 849 square feet of open space for second-floor residents, and a fifth-floor roof deck that would provide an additional 730 square feet of open space for all residents.

Required Commission Action

In order for the Project to proceed, the Commission must adopt a resolution related to the requested inclusionary compliance method, pursuant to Planning Code Section 415, and findings of consistency with the General Plan and Planning Code Section 101.1 to allow the inclusionary housing compliance method via the Affordable Housing Fee within the NCT-3 Zoning District.

Issues and Other Considerations

- **Public Comment & Outreach.**

- **Support/Opposition:** The Department has received one letter in opposition to the proposal because of the loss of on-site inclusionary units.

- **Planning Code Section 415.** Pursuant to Planning Code Section 415.5(g), a project sponsor must pay the Affordable Housing Fee unless it chooses to meet the requirements of the Program through an Alternative provided subsection(g)(1):

- **Alternative #1: On-Site Units.** Project sponsors may elect to construct units affordable to qualifying households on-site of the principal project pursuant to the requirements of Section [415.6](#).
- **Alternative #2: Off-Site Units.** Project sponsors may elect to construct units affordable to qualifying households at an alternative site within the City and County of San Francisco pursuant to the requirements of Section [415.7](#).
- **Alternative #3: Small Sites.** Qualifying project sponsors may elect to fund buildings as set forth in Section [415.7-1](#).
- **Alternative #4: Combination.** Project sponsors may elect any combination of payment of the Affordable Housing Fee as provided in Section [415.5](#), construction of on-site units as provided in Section [415.6](#), or construction of off-site units as provided in Section [415.7](#), provided that the project applicant constructs or pays the fee at the appropriate percentage or fee level required for that option. Development Projects that are providing on-site units under Section [415.6](#) and that qualify for and receive additional density under California Government Code Sections 65915 *et seq.* shall use Alternative #4 to pay the Affordable Housing Fee on any additional units or square footage authorized under Section 65915.

On May 7, 2017 the project team elected to satisfy the inclusionary housing requirement with three (3) on-site units. On October 28, 2021 the project team submitted a revised inclusionary housing affidavit electing the Affordable Housing Fee method instead. Because the Project will satisfy the inclusionary requirement via the Affordable Housing Fee, no on-site units are required.

- **Inclusionary Affordable Housing Program Selected Alternative:** The Planning Commission or the Department may not require a project sponsor to select a specific Alternative. If a project sponsor elects to meet the Program requirements through one of the Alternatives described in subsection (g)(1), they must choose it 30 days prior to any project approvals from the Planning Commission or Department. The Alternative will be a condition of project approval and recorded against the property in an NSR. Any subsequent change by a project sponsor that results in the reduction in the number of on-site units shall require public notice for a hearing and approval from the Planning Commission.

On October 28, 2020 the project team submitted a revised inclusionary housing affidavit electing the Affordable Housing Fee method. Thus, the project team has satisfied the 30-day requirement. The Project is before the Planning Commission because of the subsequent change that results in the reduction in the number of on-site units; thus, requiring a public notice for a hearing and approval from the Planning

Commission. In addition, because the first construction document for Building Permit Application no. 2017.0330.2802 was already issued on December 31, 2019, the project is subject to interest on the Affordable Housing Fee.

Pursuant to Section 415 et seq., the Planning Commission shall be limited to considering issues related to Section 415 et seq. in considering the request for modification. The Project was previously reviewed by the Planning Commission per record no. 2016-005406DRP. Per DRA-0069, the Planning Commission did not take DR on September 13, 2018 because there were no extraordinary or exceptional circumstances and found that the Project complied with the Planning, the General Plan, and found that it conformed with the Urban Design Guidelines. The Project was approved without any modifications and the inclusionary requirement was being satisfied on-site with three inclusionary units. The Project's design and massing has not changed; however, an approximately 650-square foot community room on the second floor was converted to allow four new retail professional service uses on the second floor. The current proposal is to now satisfy the inclusionary housing program with the affordable housing fee that will be assessed at 20% of the gross residential floor area.

- **Discretionary Review (DR).** Per DRA-0069, the Planning Commission did not take DR on September 13, 2018 because there were no extraordinary or exceptional circumstances and found that the Project complied with the Planning, the General Plan, and found that it conformed with the Urban Design Guidelines.
- **Notice of Special Restrictions (NSR).** Per NSR no. 2018K706189 conformed on December 14, 2018, three (3) on-site units (203, 302, 407) were proposed at 42 Otis Street. A subsequent draft NSR will supersede the aforementioned.
- **Project Updates:** Since the public hearing on September 13, 2018, the Project Sponsor has updated the Project as follows:
 - Retail Professional Uses: The Project Sponsor previously converted an approximately 650-square foot community room on the second floor to allow four new retail professional service uses on the second floor. This change was previously administratively approved by the Planning Department.
 - Usable Open Space: The Project previously converted an approximately 850-square foot common second floor deck to allow three new private decks; the area remains as usable open space. Further, the Project remains code-complying with common usable open space at the roof level that is available to all 24 SRO dwelling units. This change was previously administratively approved by the Planning Department.
 - Inclusionary Housing: The Project Sponsor has reduced the amount of on-site inclusionary units from 3 to 0 and instead, will pursue the Affordable Housing Fee to demonstrate compliance with Planning Code Section 415. The Affordable Housing Fee is being pursued with Building Permit Application no. 2020.1028.7601.

Environmental Review

The proposal to change the inclusionary housing compliance method is not a project under the California Environmental Quality Act ("CEQA").

Basis for Recommendation

The Department finds that the Project is, on balance, consistent with the Market & Octavia Plan and the Objectives and Policies of the General Plan. Although the Project results in a loss of on-site inclusionary units, the Project will be paying the Affordable Housing Fee, which will help fund the production of affordable housing. The Department also finds the project to be necessary, desirable, and compatible with the surrounding neighborhood, and not to be detrimental to persons or adjacent properties in the vicinity.

Attachments:

Draft Resolution – Resolution (Exhibit A)
Exhibit B – Plans and Renderings (for reference only)
Exhibit C – Inclusionary Affordable Housing Affidavit
Exhibit D - Public Correspondence



PLANNING COMMISSION DRAFT RESOLUTION

HEARING DATE: MARCH 25, 2021

Record No.: 2021-001410CRV
Project Address: 42 OTIS STREET
Zoning: NCT-3 (Moderate Scale Neighborhood Commercial - Transit) Zoning District
50-X Height and Bulk District
Block/Lot: 3505/020
Project Sponsor: Eduardo Sagues-Castillo
March Capital Management
3456 Sacramento Street
San Francisco, CA 94118
Property Owner: Costanoan LLC
Staff Contact: Esmeralda Jardines – (628) 652-7531
esmeralda.jardines@sfgov.org

RESOLUTION ADOPTING FINDINGS RELATED TO THE CHANGE IN THE METHOD OF COMPLIANCE FOR ADDRESSING THE INCLUSIONARY AFFORDABLE HOUSING REQUIREMENTS IN PLANNING CODE SECTION 415 FROM ON-SITE UNITS TO THE AFFORDABLE HOUSING FEE FOR THE PROJECT AT 42 OTIS STREET, LOCATED ON ASSESSOR'S BLOCK 3505, LOT 020, IN THE NCT-3 ZONING DISTRICT AND A 50-X HEIGHT AND BULK DISTRICT, AND ADOPT FINDINGS OF CONSISTENCY WITH THE GENERAL PLAN AND PLANNING CODE SECTION 101.1.

PREAMBLE

WHEREAS, on October 28, 2020, Eduardo Sagues-Castillo (hereafter “Project Sponsor”) submitted, among other materials, a project application (“PRJ”) for the proposed project.

WHEREAS, the Department has concluded that the proposed project presented in the plan set attached hereto as Exhibit B conforms with applicable Planning Code provisions and applicable design guidelines.

WHEREAS, the Planning Commission (hereinafter “Commission”) conducted a duly noticed public hearing at a regularly scheduled meeting to consider the proposed project on March 25, 2021 and make findings required by the General Plan; and,

WHEREAS, on October 28, 2020, the Department determined that the proposal of changing the inclusionary housing compliance method is not a project under CEQA.

WHEREAS, the Commission has heard and considered the testimony presented to it at the public hearing and has further considered written materials and oral testimony presented on behalf of Department staff and other interested parties; and

WHEREAS, all pertinent documents may be found in the files of the Department, as the custodian of records, at 49 South Van Ness Avenue, Suite 1400, San Francisco; and

MOVED, that the Commission hereby finds that the Inclusionary Affordable Housing Compliance Method is necessary for the Project, and makes the following findings.

FINDINGS

Having reviewed the materials identified in the preamble above, and having heard all testimony and arguments, this Commission finds, concludes, and determines as follows:

- 1. The above recitals are accurate and constitute findings of this Commission.**
- 2. Project Description.** The proposal is for a change to the inclusionary affordable housing compliance method from on-site to the Affordable Housing Fee, pursuant to Planning Code Section 415, for the Project involving demolition of the existing two-story industrial building and construction of a new five-story, 55-foot tall mixed-use building containing 24 Single-Room Occupancy (SRO) dwelling unit, and 3,458 square feet of commercial uses. There are three private second-floor decks that would provide 849 square feet of open space for second-floor residents, and a fifth-floor roof deck that would provide an additional 730 square feet of open space for all residents.
- 3. Site Description and Present Use.** The Project is located on the north side of Otis Street, on the block surrounded by Brady Street, Market Street, and 12th Street in the South of Market neighborhood in the Market & Octavia Neighborhood Plan Area. The Project is located on Lot 020 in Assessor's Block 3505 (with a lot area of approximately 4,100 square feet), which has approximately 50 feet of frontage along Otis Street. The Project site contains a two-story industrial building, currently used as a commercial space for a pest management business.
- 4. Surrounding Properties and Neighborhood.** The Project Site is located within the NCT-3 Zoning District in the Market & Octavia Area Plan. The immediate context is mixed in character with industrial, residential, and institutional uses. The immediate neighborhood includes one-to-two story industrial buildings to the east and west, 1650 and 1660 Mission Street, which is an office building to the south of the project site, and an undeveloped surface parking lot, to the north. Other zoning districts in the vicinity of the project site include: P (Public), C-3-G (Downtown General), and the RED (Residential Enclave) Zoning District.
- 5. Background.** The Project was previously reviewed by the Planning Commission per record no. 2016-005406DRP. Per DRA-0069, the Planning Commission did not take DR on September 13, 2018 because there were no extraordinary or exceptional circumstances and found that the Project complied with the Planning, the General Plan, and found that it conformed with the Urban Design Guidelines. The Project was approved without any modifications and the inclusionary requirement was being satisfied on-site with three inclusionary units. The Project's design and massing has not changed; however, an approximately 650-square foot community room on the second floor was previously converted to allow four new retail professional service uses on the second floor. Further, the common second floor deck was previously converted to three private decks while remaining as usable open space; all 24 SRO dwelling units have access to the common roof deck. The current proposal is to now satisfy the inclusionary housing program with the Affordable Housing Fee that will be assessed at 20% of the gross residential floor area.
- 6. Public Outreach and Comments.** The Department received one comment. The member of the public expressed concern over the project sponsor pursuing the Affordable Housing Fee instead of providing on-site inclusionary units.

- 7. Inclusionary Affordable Housing Program.** Planning Code Section 415 sets forth the requirements and procedures for the Inclusionary Affordable Housing Program. Under Planning Code Section 415.3, the current percentage requirements apply to projects that consist of ten or more units. Pursuant to Planning Code Section 415.5, the Project must pay the Affordable Housing Fee (“Fee”). This Fee is made payable to the Department of Building Inspection (“DBI”) for use by the Mayor’s Office of Housing and Community Development for the purpose of increasing affordable housing citywide. The applicable percentage is dependent on the number of units in the project, the zoning of the property, and the date that the project submitted a complete Project Application.

The Project Sponsor has submitted an ‘Affidavit of Compliance with the Inclusionary Affordable Housing Program: Planning Code Section 415,’ to satisfy the requirements of the Inclusionary Affordable Housing Program through payment of the Fee, in an amount to be established by the Mayor’s Office of Housing and Community Development. The applicable percentage is dependent on the total number of units in the project, the zoning of the property, and the date that the project submitted a complete Project Application. A complete Project Application was submitted on October 28, 2020; therefore, pursuant to Planning Code Section 415.3 the Inclusionary Affordable Housing Program requirement for the Affordable Housing Fee is at a rate equivalent to an off-site requirement of 20%, subject to interest due because the first construction document has already been issued.

- 8. Inclusionary Affordable Housing Program Selected Alternative:** The Planning Commission or the Department may not require a project sponsor to select a specific Alternative. If a project sponsor elects to meet the Program requirements through one of the Alternatives described in subsection (g)(1), they must choose it 30 days prior to any project approvals from the Planning Commission or Department. The Alternative will be a condition of project approval and recorded against the property in an NSR. Any subsequent change by a project sponsor that results in the reduction in the number of on-site units shall require public notice for a hearing and approval from the Planning Commission.

Upon initial approval, the project sponsor previously selected to provide three on-site units. Per NSR no. 2018K706189 conformed on December 14, 2018, three (3) on-site units (203, 302, 407) were proposed at 42 Otis Street. A subsequent draft NSR will supersede the aforementioned. A subsequent NSR is needed to supersede the previous NSR because the project sponsor is now selecting the Affordable Housing Fee alternative. Because of the proposed change, the project was duly noticed, and the inclusionary housing compliance method is before the Planning Commission. In addition, because the first construction document for Building Permit Application no. 2017.0330.2802 was already issued on December 31, 2019, the project is subject to interest on the Affordable Housing Fee.

If a project sponsor requests a modification to its conditions of approval for the sole purpose of complying with this Section, the Planning Commission shall be limited to considering issues related to Section [415 et seq.](#) in considering the request for modification.

The Planning Commission reviewed the 42 Otis Street Project on September 13, 2018 during a Discretionary Review hearing. The Planning Commission did not take DR, nor did it request modifications. The item before the Planning Commission is regarding the inclusionary housing compliance method. The Affordable Housing Fee is being pursued with Building Permit Application no. 2020.1028.7601.

9. **General Plan Compliance.** The Project is, on balance, consistent with the following Objectives and Policies of the General Plan:

HOUSING ELEMENT

Objectives and Policies

OBJECTIVE 1

IDENTIFY AND MAKE AVAILABLE FOR DEVELOPMENT ADEQUATE SITES TO MEET THE CITY'S HOUSING NEEDS, ESPECIALLY PERMANENTLY AFFORDABLE HOUSING.

Policy 1.1

Plan for the full range of housing needs in the City and County of San Francisco, especially affordable housing.

Policy 1.10

Support new housing projects, especially affordable housing, where households can easily rely on public transportation, walking and bicycling for the majority of daily trips.

OBJECTIVE 4

FOSTER A HOUSING STOCK THAT MEETS THE NEEDS OF ALL RESIDENTS ACROSS LIFECYCLES.

Policy 4.4

Encourage sufficient and suitable rental housing opportunities, emphasizing permanently affordable rental units wherever possible.

Policy 4.5

Ensure that new permanently affordable housing is located in all of the City's neighborhoods, and encourage integrated neighborhoods, with a diversity of unit types provided at a range of income levels.

OBJECTIVE 11

SUPPORT AND RESPECT THE DIVERSE AND DISTINCT CHARACTER OF SAN FRANCISCO'S NEIGHBORHOODS.

Policy 11.1

Promote the construction and rehabilitation of well-designed housing that emphasizes beauty, flexibility, and innovative design, and respects existing neighborhood character.

Policy 11.2

Ensure implementation of accepted design standards in project approvals.

Policy 11.3

Ensure growth is accommodated without substantially and adversely impacting existing residential neighborhood character.

Policy 11.4

Continue to utilize zoning districts which conform to a generalized residential land use and density plan and the General Plan.

OBJECTIVE 12

BALANCE HOUSING GROWTH WITH ADEQUATE INFRASTRUCTURE THAT SERVES THE CITY'S GROWING POPULATION.

Policy 12.2

Consider the proximity of quality of life elements such as open space, child-care, and neighborhood services, when developing new housing units.

MARKET & OCTAVIA AREA PLAN

Land Use and Urban Form
Objectives and Policies

OBJECTIVE 1.2

ENCOURAGE URBAN FORM THAT REINFORCES THE PLAN AREA'S UNIQUE PLACE IN THE CITY'S LARGER URBAN FORM AND STRENGTHENS ITS PHYSICAL FABRIC AND CHARACTER.

Policy 1.2.2

Maximize housing opportunities and encourage high-quality commercial spaces on the ground floor.

Housing
Objectives and Policies

OBJECTIVE 2.2

ENCOURAGE CONSTRUCTION OF RESIDENTIAL INFILL THROUGHOUT THE PLAN AREA.

Policy 2.2.4

Encourage new housing above ground-floor commercial uses in new development and in expansion of existing commercial buildings.

Policy 2.2.7

Without rendering new projects infeasible, increase affordable housing or other requirements on market rate residential and commercial development projects to provide additional affordable housing.

OBJECTIVE 2.4

PROVIDE INCREASED HOUSING OPPORTUNITIES AFFORDABLE TO HOUSEHOLDS AT VARYING INCOME LEVELS.

Policy 2.4.3

Encourage new innovative programs to increase housing rental and ownership opportunities and housing affordability.

Policy 2.4.4

Housing stock is monitored for changes in character.

The Project is consistent with the Market & Octavia Plan and the Objectives and Policies of the General Plan, in that the project would provide 24 SRO dwelling units helping alleviate San Francisco's severe housing crisis. Additionally, the project is proposing to alter its inclusionary method of compliance from on-site to the Affordable Housing Fee; thus, it proposes to pay the Affordable Housing Fee of 20% of the residential gross floor area. The proposed residential gross floor area is 11,395 square feet. The Project provides a modern architectural design that is compatible with the mixed-use nature of the South of Market neighborhood. The Project adds housing to a transit rich neighborhood, supporting the City's Transit First Policy and housing goals. Overall, the Project provides new housing opportunities and an Affordable Housing Fee that will fund affordable housing.

10. Planning Code Section 101.1(b) establishes eight priority-planning policies and requires review of permits for consistency with said policies. On balance, the project complies with said policies in that:

- A. That existing neighborhood-serving retail uses be preserved and enhanced and future opportunities for resident employment in and ownership of such businesses be enhanced.

The project site does not possess any existing neighborhood-serving retail uses. The Project provides 24 new SRO dwelling units, which will enhance the nearby retail uses by providing new residents, who may patron and/or own these businesses as well as one retail sales and service use at the ground floor and four retail professional services at the second floor fronting Otis Street.

- B. That existing housing and neighborhood character be conserved and protected in order to preserve the cultural and economic diversity of our neighborhoods.

The project site does possess any existing housing. The Project would provide 24 new SRO dwelling units, thus resulting in an overall increase in the neighborhood housing stock. The Project is expressive in design and relates well to the scale and form of the surrounding neighborhood. For these reasons, the Project would protect and preserve the cultural and economic diversity of the neighborhood.

- C. That the City's supply of affordable housing be preserved and enhanced,

The Project does not currently possess any existing affordable housing. The Project will comply with the City's Inclusionary Housing Program by paying the Affordable Housing Fee at 20% of the residential gross floor area. Therefore, the Project will increase the stock of affordable housing units in the City.

- D. That commuter traffic does not impede MUNI transit service or overburden our streets or neighborhood parking.

The Project Site is well served by transit service, including MUNI lines F, J, J BUS, KT, KT BUS, L, L BUS, M, N, N BUS, 6, 7, 7X, 14, 14R, 47, 49 and all BART destinations at the Van Ness BART Station. As such,

it will not impede transit service or overburden streets or neighborhood parking.

- E. That a diverse economic base be maintained by protecting our industrial and service sectors from displacement due to commercial office development, and that future opportunities for resident employment and ownership in these sectors be enhanced.

The Project does not include commercial office development. Although the Project would remove an industrial building, the Project does provide new housing, which is a top priority for the City.

- F. That the City achieve the greatest possible preparedness to protect against injury and loss of life in an earthquake.

The Project will be designed and will be constructed to conform to the structural and seismic safety requirements of the Building Code. This proposal will not impact the property's ability to withstand an earthquake.

- G. That landmarks and historic buildings be preserved.

Currently, the Project Site does not contain any City Landmarks or historic buildings. The existing structure was evaluated as part of the Project and was found to not be a historic resource.

- H. That our parks and open space and their access to sunlight and vistas be protected from development.

The Project does not cast shadow on any parks or open space areas.

NOW THEREFORE BE IT RESOLVED that the Commission hereby ADOPTS the findings for the requested inclusionary housing compliance method as described in this Resolution.

I hereby certify that the foregoing Resolution was adopted by the Commission at its meeting on March 25, 2021.

Jonas P. Ionin
Commission Secretary

AYES:


NAYS:

ABSENT:

RECUSE:

ADOPTED: March 25, 2021

42 OTIS STREET SAN FRANCISCO, CA 94103

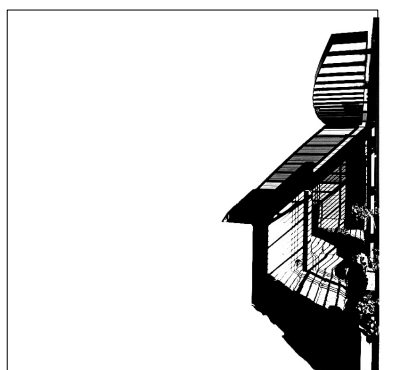

ELEVATIONarchitects

1159 Green Street, Suite 4
San Francisco, CA 94109

415.537.1125 :w
www.elevationarchitects.com :w



agency stamps:

GENERAL NOTES

- THESE DRAWINGS CONSTITUTE A PORTION OF THE CONTRACT DOCUMENTS AS DEFINED IN AIA DOCUMENT A201, THE GENERAL CONDITIONS OF THE CONTRACT FOR CONSTRUCTION. REFER TO PROJECT MANUAL.
- IN BEGINNING WORK, CONTRACTOR ACKNOWLEDGES THOROUGH FAMILIARITY WITH THE BUILDING SITE CONDITIONS, WITH THE DRAWINGS AND SPECIFICATIONS, WITH THE DELIVERY FACILITIES AND ALL OTHER MATTERS AND CONDITIONS WHICH MAY AFFECT THE OPERATIONS AND COMPLETION OF THE WORK AND ASSUMES ALL RISK. CONTRACTOR TO VERIFY SURVEY DIMENSIONS BEFORE COMMENCING WORK. CONTRACTOR SHALL REPORT, AT ONCE, TO THE ARCHITECT ANY ERROR, INCONSISTENCY OR OMISSION THAT MAY BE DISCOVERED AND CORRECT AS DIRECTED, IN WRITING, BY THE ARCHITECT.
- BY ACCEPTING AND USING THESE DRAWINGS, CONTRACTOR AGREES TO ASSUME SOLE AND COMPLETE RESPONSIBILITY FOR JOB SITE SAFETY CONDITIONS DURING THE COURSE OF CONSTRUCTION OF THIS PROJECT, INCLUDING SAFETY OF ALL PERSONS AND PROPERTY, THAT THIS REQUIREMENT SHALL APPLY CONTINUOUSLY AND NOT BE LIMITED TO NORMAL WORKING HOURS AND THAT THE CONTRACTOR SHALL DEFEND, INDEMNIFY AND HOLD THE OWNER AND THE ARCHITECT HARMLESS FROM ANY AND ALL LIABILITY, REAL OR ALLEGED, IN CONNECTION WITH THE PERFORMANCE OF THE WORK ON THIS PROJECT, EXCEPTING LIABILITY ARISING FROM THE SOLE NEGLIGENCE OF THE OWNER, THE ARCHITECT OR ANY UNAUTHORIZED PERSON ON THE SITE WITHOUT PERMISSION OF THE CONTRACTOR.
- ARCHITECT AND OWNER WILL NOT BE RESPONSIBLE FOR ANY CHANGES IN PLANS, DETAILS OR SPECIFICATIONS UNLESS APPROVED IN WRITING IN ADVANCE OF CONSTRUCTION.

GENERAL NOTES CONTINUED

- DO NOT SCALE DRAWINGS. WRITTEN DIMENSIONS SHALL HAVE PRECEDENCE OVER SCALED DIMENSIONS. CONTRACTOR SHALL VERIFY AND BE MADE COMPLETELY RESPONSIBLE FOR ALL DIMENSIONS AND CONDITIONS SHOWN AND A WRITTEN CHANGE ORDER REQUEST SHALL BE ISSUED BEFORE MAKING ANY CHANGES AT THE JOB SITE.
- CONTRACTOR SHALL BE RESPONSIBLE FOR LOCATING ANY AND ALL EXISTING UNDERGROUND UTILITIES. ALL DAMAGE TO SUCH SHALL BE REPAIRED AT CONTRACTOR EXPENSE.
- CONTRACTOR TO PROVIDE BRACING AND SUPPORT AS REQUIRED TO MAINTAIN THE INTEGRITY AND SAFETY OF THE EXISTING STRUCTURE AND ADJACENT STRUCTURE(S) AS NECESSARY.
- ALL DIMENSIONS ARE TO FACE OF STUD, FACE OF CMU OR CENTERLINE OF STEEL, UNLESS OTHERWISE NOTED.
- ALL EXISTING WALLS, FLOORS AND CEILING AT REMOVED, NEW OR MODIFIED CONSTRUCTION SHALL BE PATCHED AS REQUIRED TO MAKE SURFACES WHOLE, SOUND AND TO MATCH EXISTING ADJACENT CONSTRUCTION, EXCEPT AS OTHERWISE NOTED.
- ALL WORK SHALL BE IN ACCORDANCE WITH ALL FEDERAL, STATE AND LOCAL BUILDING CODES AND SAFETY ORDINANCES IN EFFECT AT THE PLACE OF BUILDING.
- ALL DRAWINGS, SPECIFICATIONS AND COPIES THEREOF FURNISHED BY THE ARCHITECT ARE COPYRIGHTED DOCUMENTS AND SHALL REMAIN THE PROPERTY OF ELEVATION ARCHITECTS. THESE DOCUMENTS ARE THE INSTRUMENTS OF SERVICE AND AS SUCH, SHALL REMAIN THE PROPERTY OF ELEVATION ARCHITECTS WHETHER THE PROJECT FOR WHICH THEY ARE INTENDED IS EXECUTED OR NOT. THESE DOCUMENTS SHALL NOT BE USED BY ANYONE FOR OTHER PROJECTS, ADDITIONS TO THIS PROJECT OR FOR COMPLETION OF THIS PROJECT BY OTHERS EXCEPT AS AGREED IN WRITING BY ELEVATION ARCHITECTS AND WITH APPROPRIATE COMPENSATION.

GENERAL NOTES CONTINUED

- SUBMISSION OR DISTRIBUTION TO MEET OFFICIAL REGULATORY REQUIREMENTS OR FOR OTHER PURPOSES IN CONNECTION WITH THE PROJECT IS NOT TO BE CONSTRUED AS PUBLICATION IN DEROGATION OF THE ARCHITECT'S COMMON LAW COPYRIGHT OR OTHER RESERVED RIGHTS.
- THE CONTRACTOR SHALL TAKE APPROPRIATE STEPS THROUGHOUT THE EXECUTION OF THE PROJECT TO PREVENT AIRBORNE DUST DUE TO THE WORK. MAINTAIN WORK AREAS CLEAN AND FREE FROM UNDUE ENCUMBRANCES AND REMOVE SURPLUS MATERIALS AND WASTE AS THE WORK PROGRESSES.
- IT IS THE INTENT OF THESE DOCUMENTS TO FULLY COMPLY WITH THE AMERICANS WITH DISABILITIES ACT (ADA) AND TITLE 24 OF THE CALIFORNIA CODE OF REGULATIONS, WHERE A REQUIREMENT IS IN CONFLICT, THE MORE STRINGENT REQUIREMENT SHALL GOVERN. WHERE DIMENSIONS, SLOPE GRADIENTS AND OTHER CRITICAL CRITERIA ARE NOTED, THEY ARE TO BE ADHERED TO EXACTLY, UNLESS NOTED AS APPROXIMATE. CONTRACTOR'S FAILURE TO COMPLY WITH ANY PROVISION DESCRIBED IN THE DRAWINGS AND SPECIFICATIONS RELATED TO THESE ACCESSIBILITY LAWS AND CODES WILL REQUIRE CORRECTION, AT CONTRACTOR'S EXPENSE. WHERE MAXIMUM DIMENSIONS AND SLOPE GRADIENTS ARE NOTED, NO EXCEPTION WILL BE MADE FOR EXCEEDING THESE REQUIREMENTS.

GLOSSARY

ABV.	ABOVE	FA	FIRE ALARM	MAX.	MAXIMUM	SC	SOLID CORE
A.D.	AREA DRAIN	FD	FLOOR DRAIN	MED.	MEDICINE CABINET	SHTG	SHEETING
ADJ	ADJACENT	FF	FINISH FLOOR	MECH	MECHANICAL	SHT	SHEET
ACT	ACOUSTIC CEILING TILE	FLR	FLOOR	MIN.	MINIMUM	SIM	SIMILAR
AFF	ABOVE FINISH FLOOR	F.O.S.	FACE OF STUD	MTL	METAL	SQ	SQUARE
ALUM	ALUMINUM	F.O.M.	FACE OF MASONRY	MV	MICROWAVE	S.S.D.	SEE STRUCTURAL DWGS
						STL	STEEL
BLKG	BLOCKING	GA	GAUGE	(N)	NEW	ST. STL	STAINLESS STEEL
BLDG	BUILDING	GALV	GALVANIZED	N.I.C.	NOT IN CONTRACT	STOR	STORAGE
BD	BOARD	GL	GLASS	NTS	NOT TO SCALE	STR	STRUCTURAL
		GND	GROUND			STV	SHEET VINYL
C	CENTERLINE	GSM	GALVANIZED SHEET METAL	O.C.	ON CENTER	T&G	TONGUE AND GROOVE
CLR	CLEAR	GYP	GYPSPUM BOARD	O/	OVER	T.C.	TOP OF CURB
CONC	CONCRETE	BD.	GYPSPUM WALLBOARD	OD	OVERFLOW DRAIN	TEL	TELEPHONE
CONT	CONTINUOUS	GW		O.H.	OPPOSITE HAND	T.O.S.	TOP OF STEEL
CPT	CARPET					T.O.W.	TOP OF WALL
CT	CERAMIC TILE	HB	HOSE BIB	PLAM	PLASTIC LAMINATE	TYP.	TYPICAL
		HC	HANDICAPPED	PLY.	PLYWOOD	U.O.N.	UNLESS OTHERWISE NOTED
DIA	DIAMETER	HM	HOLLOW METAL	PTD	PAINTED		
DIM.	DIMENSION	H.P.	HOUSE PANEL			VCT	VINYL COMPOSITION TILE
DIMS.	DIMENSIONS	HT	HEIGHT			REF	REQUIRED
DN	DOWN	INS.	INSULATION			REQ.	REQUIRED
DWG	DRAWING	INSUL.	INSULATION			RB	RUBBER BASE
		INT	INTERIOR			R.D.	ROUGH OPENING
(E), EX.	EXISTING	JAN	JANITOR CLOSET			RM	ROOM
EA.	EACH	KIT	KITCHEN			RO	ROUGH OPENING
EJ	EXPANSION JOINT	LAV	LAVATORY			RDWD	REDWOOD
ELEC	ELECTRIC	LT	LIGHT				
EL., ELEV.	ELEVATION						
EMB.	EMBEDDED						
EQ	EQUAL						
EXT	EXTERIOR						

PERMITS

- SITE PERMIT
- ADDENDUM #1: STRUCTURAL BUILDING PERMIT
- ADDENDUM #2: ARCHITECTURAL PERMIT
- ADDENDUM #3: ELECTRICAL, MECHANICAL AND PLUMBING PERMIT
- ADDENDUM #4: FIRE SPRINKLERS AS PER SFDBI FS-05, SFFD AB 2.04 FIRE ALARM AS PER SFFD AB 2.01, STANDPIPES
- ADDENDUM #5: ERRCS

APPLICABLE CODES

- BUILDING: 2016 CBC AND 2016 SFBBC, UNLESS OTHERWISE NOTED
- MECHANICAL: 2016 CMC WITH 2016 SFFC AMENDMENTS
- PLUMBING: 2016 CPC WITH 2016 SFFC AMENDMENTS
- ELECTRICAL: 2016 CEC WITH 2016 SFFC AMENDMENTS
- FIRE: 2016 CFC WITH 2016 SFFC AMENDMENTS
- ENERGY: 2016 CEC
- GREEN: 2016 CGBB WITH 2016 SFFC AMENDMENTS

SCOPE OF WORK

NEW 5-STORY MIXED-USE BUILDING WITH 3 STORIES OF RESIDENTIAL OCCUPANCY WITH 21 SRO UNITS OVER ONE STORY OF MIXED USE WITH 3 SRO UNITS AND 4 COMMERCIAL UNIT OVER FIRST FLOOR COMMERCIAL USE.

PLANNING DEPARTMENT NOTES

PROJECT LOCATION: 42 OTIS STREET
BLOCK/LOT: 3505/020
TOTAL LOT AREA: 4,063 SQ.FT.
ZONING: NCT-3
HEIGHT AND BULK: 50-X

PROPOSED BUILDING USE:
1ST FLOOR: 2,105 SQ.FT. COMMERCIAL PLUS COMMON AREA
2ND FLOOR: 1,402 SQ. FT. COMMERCIAL (4 UNITS) PLUS RESIDENTIAL (3 SRO UNITS)
3RD FLOOR: RESIDENTIAL (7 SRO UNITS)
4TH FLOOR: RESIDENTIAL (7 SRO UNITS)
5TH FLOOR: RESIDENTIAL (7 SRO UNITS)
ROOF: SOLAR PANELS ARRAY AREA APPROX. 500 GROSS SQ.FT. > 443 GROSS SQ.FT. (15% OF 2,954 GROSS SQ.FT. ROOF)

PROPOSED BUILDING AREA:
1ST FLOOR: 3,892 GROSS SQ.FT.
2ND FLOOR: 3,047 GROSS SQ.FT.
3RD FLOOR: 3,031 GROSS SQ.FT.
4TH FLOOR: 3,012 GROSS SQ.FT.
5TH FLOOR: 3,031 GROSS SQ.FT.
TOTAL: 16,013 GROSS SQ.FT.

PROPOSED PARKING: NONE
BICYCLE PARKING (SEC. 155.2.1/UNIT) REQUIRED: 24 CLASS 1 FOR RESIDENTIAL UNITS, 2 CLASS 2 FOR COMMERCIAL USE
PROVIDED: 24 CLASS 1 FOR RESIDENTIAL UNITS, 2 CLASS 2 FOR COMMERCIAL USE

OPEN SPACE REQUIRED:
TABLE 135B: 80 SQ.FT. PER UNIT
SEC. 135(G)2: 1/3 X 80 SQ.FT. = 26.7 SQ.FT./UNIT
24 UNITS X 26.7 SQ.FT.: 641 SQ.FT. REQUIRED
ROOF DECK: 730 SQ.FT. PROVIDED

BELOW MARKET RATE UNITS:
BMR UNITS: 24 UNITS X 12% = 2.88 > 3 UNITS
302, 407 AND 506

SETBACKS:
FRONT: REQUIRED: NONE
SIDE: REQUIRED: NONE
REAR: REQUIRED: 25% OF LOT: 50' 3.5" X 20' 4" = 1,024 SQ.FT.
PROVIDED: 2ND FLOOR: 1,024 SQ.FT.

ROOF:
ROOF AREA: 2,954 SQ.FT. 20% X 2,954 SQ.FT. = 591 SQ.FT.
TOTAL PENTHOUSE AREA: 412 SQ.FT. < 591 SQ.FT.

RESIDENTIAL UNIT SUMMARY

FLOOR	UNIT	TYPE	AV. SIZE	TOTAL (NET SF)
1ST				
2ND	205 - 207	SRO	343 SF	1,029 SF
3RD	301 - 307	SRO	343 SF	2,401 SF
4TH	401 - 407	SRO	343 SF	2,401 SF
5TH	501 - 507	SRO	343 SF	2,401 SF
TOTAL	24 UNITS			8,232 SF

FIRE DEPARTMENT NOTES:

- PROJECT TO COMPLY WITH SFDBI FS-04 FOR FIRE SAFETY DURING CONSTRUCTION. (CFC CH 33 AND 35)
- PROJECT WILL BE REQUIRED TO HAVE A FULL MANUAL FIRE ALARM SYSTEM AS PER SFBBC 907.2.9. WHICH WILL BE SUBMITTED UNDER ADDENDUM 4.

SAN FRANCISCO FIRE DEPARTMENT
BUREAU OF FIRE PREVENTION
PLAN CHECK DIVISION/WATER FLOW
1460 MISSION STREET, 4TH FLOOR
SAN FRANCISCO, CA 94103
FAX # 415-575-6933
Email: WaterFlowSFFD@sfgov.org

REQUEST FOR WATER FLOW INFORMATION

DATE: 09/18/17 REQUEST IS FOR: FIRE FLOW SPRINKLER DESIGN

CONTACT PERSON: JONATHAN PEARLMAN ADDRESS: 1159 GREEN ST #4 SF, CA 94109

PHONE NO. (415) 537-1125 FAX NO. ()

EMAIL: jonathan@elevationarchitects.com

OWNER'S NAME: COSTANEO LLC PHONE # (917) 620-8829

ADDRESS FOR WATER FLOW INFORMATION: PROVIDE SKETCH HERE:
42 OTIS STREET

CROSS STREETS (BOTH ARE REQUIRED): BRADY (WEST), VAN NESS ST (EAST)

SPECIFY STREET FOR POINT OF CONNECTION: OTIS ST

OCCUPANCY (CIRCLE ONE): R3 (R) LIVE/WORK COMMERCIAL OTHER

HAZARD CLASSIFICATION: (LIGHT) ORD1 ORD2 EXT1 EXT2 OTHER

CAR-STACKER: YES (NO)


NUMBER OF STORIES: 5 HEIGHT OF BLDG.: 155 FT.

Field Flow Test required. Payment by check only, made payable to SFFD for \$ 250.00

Flow data provided by: Deen Date Forwarded: 10-20-17

Flow data: FIELD FLOW TEST X STATIC 86 PSI
RESIDUAL 84 PSI
FLOW 920 GPM
Gate Page 94 8" MAIN on Otis

*****Official use only*****
IF YOU HAVE ANY QUESTIONS PLEASE CONTACT INSPECTOR DEEN @ 415-558-6361 Rev. 09/01/2017

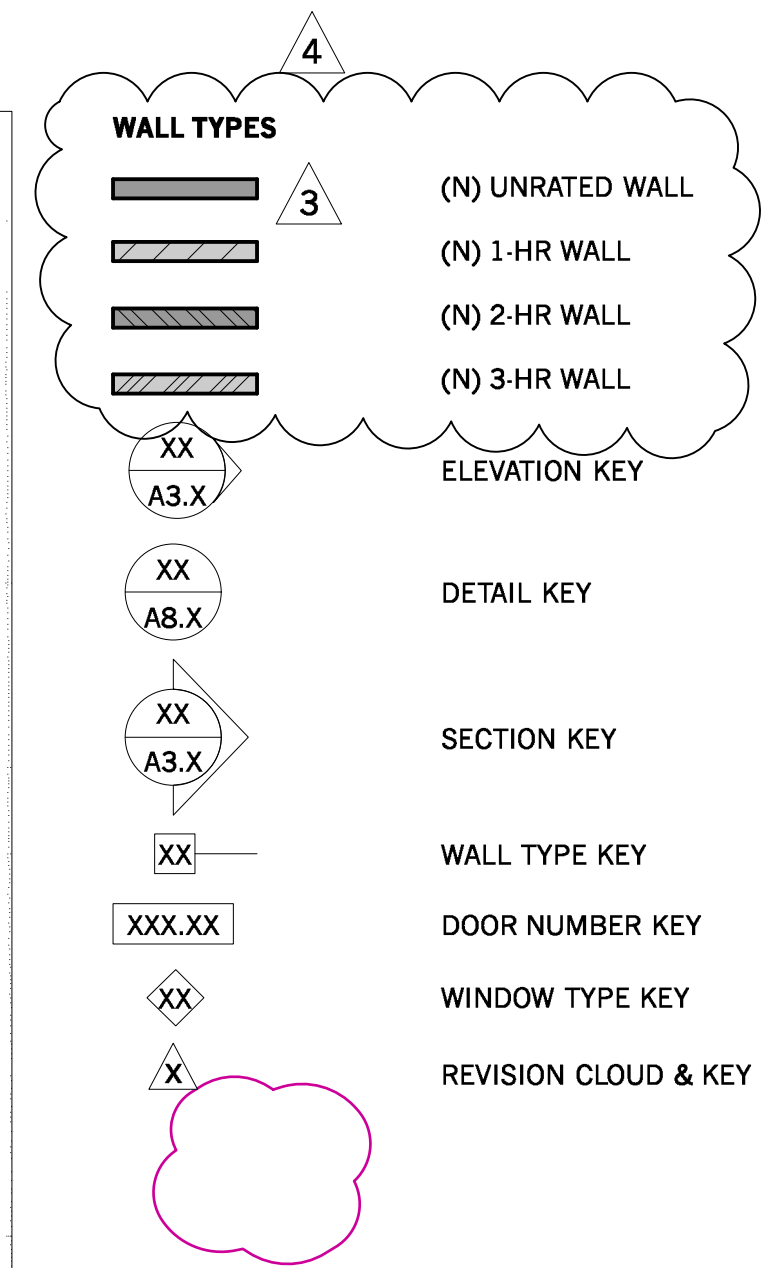

BUILDING DEPARTMENT NOTES

ENTIRE BUILDING TO BE EQUIPPED WITH APPROVED AUTOMATIC SPRINKLER SYSTEM PER NFPA 13

510.2 HORIZONTAL BUILDING ALLOWANCE:
1ST FLOOR TYPE IA
3-HR RATED SEPARATION BETWEEN 1ST FLOOR AND SECOND FLOOR
1ST FLOOR SPRINKLERED AS PER 903.3.1.1

SEPARATE BUILDINGS:

BUILDING 1 - 1ST FLOOR:
TYPE OF CONSTRUCTION: TYPE I-A
OCCUPANCY CLASSIFICATION: M, S & R-2
TABLE 504.3 MAX. ALLOWABLE HEIGHT: M & S - UNLIMITED
R-2 - UNLIMITED
PROPOSED HEIGHT: 14'-6"
TABLE 504.4 MAX. ALLOWABLE NUMBER OF STORIES: M & S - UNLIMITED
R-2 - UNLIMITED

PROPOSED NUMBER OF STORIES:
TABLE 506.2 ALLOWABLE AREA:
M & S - UNLIMITED
R-2 - UNLIMITED
PROPOSED AREA:
TABLE 508.4 OCCUPANCY SEPARATION:
1-HOUR BETWEEN M & R-2

BUILDING 2 - 2ND-5TH FLOOR:

TYPE OF CONSTRUCTION: TYPE VA
OCCUPANCY CLASSIFICATION: R-2 & B PARTIAL 2ND FLOOR & ACCESSORY B AT COMMON ROOF DECK
TABLE 504.3 MAX. ALLOWABLE HEIGHT: R-2 - 70' W/ SPRINKLER
B - 70' W/ SPRINKLER AS PER SECTION 903.3.1.1
40'-6" ABOVE TYPE I-A
55'-0" OVERALL BLDG HEIGHT

PROPOSED HEIGHT:
TABLE 504.4 MAX. ALLOWABLE NUMBER OF STORIES:
R-2 - 4 STORIES WITHOUT AREA INCREASE
B - 4 STORIES WITHOUT AREA INCREASE
4

PROPOSED NUMBER OF STORIES:
TABLE 506.2 ALLOWABLE AREA PER FLOOR:
R-2 - 36,000 SQ.FT. W/ SPRINKLER AS PER SECTION 903.3.1.1
B - 54,000 SQ.FT. W/ SPRINKLER AS PER SECTION 903.3.1.1

PROPOSED AREA:
2ND FLOOR 3,047 SQ.FT.
3RD FLOOR 3,031 SQ.FT.
4TH FLOOR 3,012 SQ.FT.
5TH FLOOR 3,031 SQ.FT.

COMBINED BUILDING

BUILDING AREA:
1ST FLOOR: 3,892 GROSS SQ.FT.
2ND FLOOR: 3,047 GROSS SQ.FT.
3RD FLOOR: 3,031 GROSS SQ.FT.
4TH FLOOR: 3,012 GROSS SQ.FT.
5TH FLOOR: 3,031 GROSS SQ.FT.
TOTAL: 16,013 GROSS SQ.FT.

HEIGHT OF BUILDING FROM LOWEST POINT OF FIRE DEPT. ACCESS: 55'-0" TOP OF ROOF
70'-0" TOP OF ELEVATOR PENTHOUSE ROOF M, B, R-2

OCCUPANCY CLASS: CONSTRUCTION TYPE:
1ST FLOOR: I-A
2ND-5TH FLOOR: VA
(N) NUMBER OF FLOORS: 5 STORIES (2013 CBC 504.2)
PROPOSED HEIGHT: 55'-0"
HORIZ. SEPARATION: 1ST/2ND: 3-HOUR (SECTION 510.2)
1-HOUR BETWEEN M&S, M&R-2 OCCUPANCIES, B&R-2 OCCUPANCIES
1-HOUR BETWEEN DWELLING UNITS.

VERTICAL SHAFTS: 2-HOUR
EXIT PASSAGEWAY: 2-HOUR
EXITING REQUIREMENTS:
2 MEANS OF EGRESS FROM GROUND FLOOR RETAIL
2 MEANS OF EGRESS FROM GROUND FLOOR RESIDENTIAL
2 MEANS OF EGRESS FROM 2ND-5TH FLOOR RESIDENTIAL UNITS
1 MEANS OF EGRESS FROM REAR DECK
2 MEANS OF EGRESS FROM COMMON ROOF DECK

TABLES 601 & 602 FIRE RESISTANCE RATING REQUIREMENTS
TYPE IA:
PRIMARY STRUCTURAL FRAME: 3-HOURS
BEARING WALLS EXTERIOR: 3-HOURS
BEARING WALLS INTERIOR: 3-HOURS
NON-BEARING WALLS EXTERIOR:
X < 5': 2-HOURS TYPE M, 1-HOUR TYPE R-2
5' ≤ X < 10': 2-HOURS TYPE M, 1-HOUR TYPE R-2
10' ≤ X < 30': 2-HOURS TYPE M, 1-HOUR TYPE R-2
X ≥ 30': 0-HOURS TYPE M, 0-HOUR TYPE R-2
NON-BEARING WALLS INTERIOR: NON-RATED

TYPE VA:
PRIMARY STRUCTURAL FRAME: 1-HOUR
BEARING WALLS EXTERIOR: 1-HOUR
BEARING WALLS INTERIOR: 1-HOUR
NON-BEARING WALLS EXTERIOR:
X < 5': 1-HOUR TYPE R-2
5' ≤ X < 10': 1-HOUR TYPE R-2
10' ≤ X < 30': 1-HOUR TYPE R-2
X ≥ 30': 0-HOUR TYPE R-2
NON-BEARING WALLS INTERIOR: NON-RATED
FLOOR CONSTRUCTION: 1-HOUR
ROOF CONSTRUCTION: 1-HOUR

SUPPLY 2-WAY COMMUNICATION AND 2-HOUR STAND-BY POWER FOR THE ELEVATOR AS REQ. BY CODE SEC. 1009.4 LOCATED IN ELECTRICAL ROOM AT FIRST FLOOR SEE: A-2.1

PROJECT TEAM

Building Owner:
Costanoan LLC
80 Rossi Avenue
San Francisco, CA 94118
Contact: Nihil Gera
(917) 620-8829
nihil_gera@yahoo.com

Structural Engineer:
Dolmen Consulting Engineers, Inc.
2595 Mission Street, #200
San Francisco, CA 94110
Contact: David Radke
415.409.9200 x103
david@dolmen-engineers.net

Architect:
Elevation Architects
1159 Green Street, Suite 4
San Francisco, CA 94109
Contact: Jonathan Pearlman
415.537.1125
jonathan@elevationarchitects.com

MEP:
MHC Engineers
150 8th Street
San Francisco, CA 94103
Contact: Robert LaBare
415.512.7141 x18
robertlabare@mhcengr.com

GreenPoint Rater:
FOSCO
763 8th Avenue, Suite #4
San Francisco, CA 94118
Contact: Fergus O'Sullivan
415.754.8064
fergus@fosco.biz

Acoustic Engineer:
Walsh, Norris & Associates, Inc.
22 Battery Street, Suite 808
San Francisco, CA 94111
Contact: David Walsh
415.391.2166
wnacous@pacbell.net

TABLE OF CONTENTS


A.0.0	COVER SHEET	
A.0.1	ARTICLE 38 COMPLIANCE LETTER	4 3
A.0.2.0	GREEN BUILDING - GS2	
A.0.2.1	GREEN BUILDING - GS3	
A.0.2.2	GREEN POINT RATED SCORECARD	
A.0.3	TDM REQUIREMENTS	
A.0.4	TDM REQUIREMENTS	
A.0.5	TDM REQUIREMENTS	3
A.0.6	ACCESSIBILITY DETAILS	
A.0.7	ACCESSIBILITY DETAILS	
A.0.8	ACOUSTICAL REPORT	
A.0.9	ACOUSTICAL REPORT	
A.0.10	ACOUSTICAL REPORT - LETTER OF COMPLIANCE	
T-24.0	TITLE 24 DOCUMENTS	
T-24.1	TITLE 24 DOCUMENTS	
T-24.2	TITLE 24 DOCUMENTS	
T-24.3	TITLE 24 DOCUMENTS	3
C-2	SIDEWALK IMPROVEMENT PLAN	
A.1.1	(E) SITE PLAN & (P) SITE PLAN	
A.2.1	1ST FLOOR PLAN	
A.2.2	2ND FLOOR PLAN	
A.2.3	3RD FLOOR PLAN	
A.2.4	4TH FLOOR PLAN	
A.2.5	5TH FLOOR PLAN	
A.2.6	ROOF PLAN	
A.2.7	PENTHOUSE ROOF PLAN	
A.3.1	SOUTH ELEVATION	
A.3.2	WEST ELEVATION	
A.3.3	NORTH ELEVATION	
A.3.4	EAST ELEVATION	
A.3.5	BUILDING SECTION A-A	
A.3.6	BUILDING SECTION B-B	
A.3.7	BUILDING SECTION C-C	
A.6.1	1ST FLOOR REFLECTED CEILING/ELECTRICAL PLAN	
A.6.2	2ND FLOOR REFLECTED CEILING/ELECTRICAL PLAN	
A.6.3	3RD FLOOR REFLECTED CEILING/ELECTRICAL PLAN	
A.6.4	4TH FLOOR REFLECTED CEILING/ELECTRICAL PLAN	
A.6.5	5TH FLOOR REFLECTED CEILING/ELECTRICAL PLAN	
A.6.6	ROOF REFLECTED CEILING/ELECTRICAL PLAN	
A.8.1	WALL ASSEMBLIES	
A.8.2	FLOOR CEILING ASSEMBLIES & DETAILS	
A.8.3	DETAILS	
A.8.4	DETAILS	
A.8.5	DETAILS	
A.8.6	DETAILS	
A.8.7	DETAILS	
A.8.8	DETAILS	
A.10.1	WINDOW SCHEDULE & SECURITY REQUIREMENTS	
A.10.2	DOOR SCHEDULE	

1ST FLOOR REFLECTED CEILING/ELECTRICAL PLAN
2ND FLOOR REFLECTED CEILING/ELECTRICAL PLAN
3RD FLOOR REFLECTED CEILING/ELECTRICAL PLAN
4TH FLOOR REFLECTED CEILING/ELECTRICAL PLAN
5TH FLOOR REFLECTED CEILING/ELECTRICAL PLAN
ROOF REFLECTED CEILING/ELECTRICAL PLAN

WALL ASSEMBLIES
FLOOR CEILING ASSEMBLIES & DETAILS
DETAILS
DETAILS
WINDOW SCHEDULE & SECURITY REQUIREMENTS
DOOR SCHEDULE

VICINITY MAP

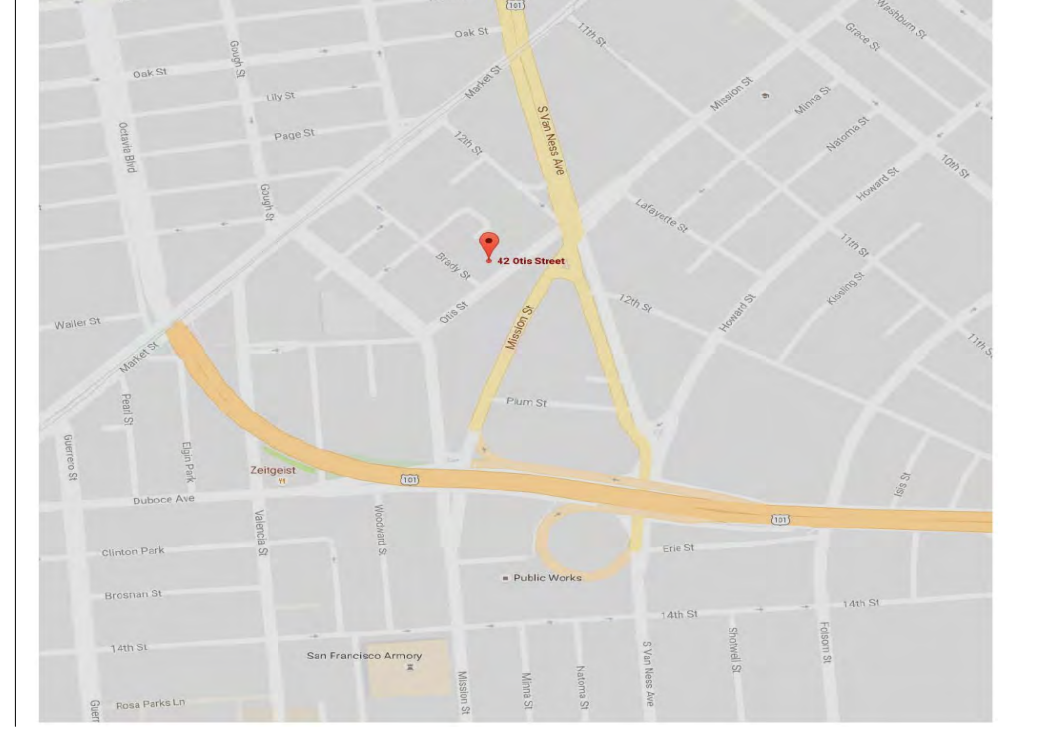

Condominiums
 42 Otis Street
 San Francisco, CA 94103
 Block / Lot : 3505 / 020
APP #2017-0330-2802-S2


#	date	issue
	10.01.19	Addendum #2
1	1.28.20	Plan Check Response 1
2	4.15.20	Project Revision 2
3	4.27.20	Plan Check Response 2
4	8.17.20	Plan Check Response 3
sheet count		1/49
Cover Sheet		
project:	16.15	
drawn by:	MKA	
checked by:	JP	
date:	03.23.17	
scale:		
A-0.0		

MHC ENGINEERING CONSULTANTS, INC.
 152 8th Street, San Francisco, CA 94103
 Tel. (415)512-7141 / Fax. (415) 512-7120

42 Otis
 Permit # 2017/03/30/2802
 Article 38 Compliance Letter
 5/18/2020

To Whom it May Concern,

Please see below for the Article 38 Enhanced Ventilation design summary for the subject project. The building consists of 4 stories with residential studio apartment units of 350 square foot each over a ground floor consisting of corridors and bike storage. Per ASHRAE 62.2 requirements, the residential units require 30 CFM of continuous ventilation (see chart on M0.0). All areas are provided with outside air at a positive pressure supplied from a rooftop air handler which is provided with a MERV-13 filter (see M0.0 fan schedule notes and M1.6 roof plan). It is the opinion of this engineer that the mechanical ventilation system as designed meets all requirements of Article 38 and any accompanying guidance or Rules and Regulations in effect at this time. Please contact MHC Engineers with any questions or concerns. Thank you.

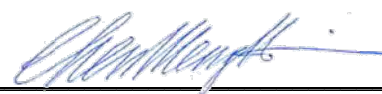
 Meng Hsiu-Chen, P.E.
 License M19582
 MHC Engineers



- 1) Air change for residential units: **30 cfm outside air.**
- 2) Air change for common areas:
 Floor 1: 100 cfm at Lobby, 225 CFM at Bike Storage Room.
 Floor 2-5: 50 cfm at Corridor.
- 3) Filter type for residential units (e.g. MERV 13) **MERV-13 for all outside air supplied into the residential units.**

4) Filter type for common areas When positive pressure is maintained in units and habitable spaces, enhanced filtration is not required for adjacent common areas such as hallways. Projects where positive pressure will be maintained only in units and habitable spaces must submit a list of the common areas, such as hallways, that are not served by the enhanced ventilation in 7(a) below. **Positive pressure provided in residential unit outside air supply fan provides air into each residence.**

When positive pressure is not maintained in units and habitable spaces, then enhanced filtration is required for all adjacent common areas as well as for the units/habitable spaces. **All areas of building are provided outside air through air handler on roof with MERV-13 filter.**

5) Location of air intakes (e.g. Roof) **OSA-1 located on Roof.**

6) Positive Pressure in residential units and other habitable spaces? (Yes/No) **Yes.**

7) Positive Pressure in common areas such as corridors? (Yes/No) **Yes.**

If Positive Pressure will be maintained only in units and habitable spaces:

a. Areas not served by enhanced ventilation? (e.g. common areas such as corridors) **NA**

8) Floors of building with habitable spaces: **[SPECIFY] _____ 5 stories.**

9) If applicable, location of Z-ducts, trickle vents, or similar unfiltered air system used for residential units **[SPECIFY] _____ NA**



City and County of San Francisco
DEPARTMENT OF PUBLIC HEALTH
 ENVIRONMENTAL HEALTH

London N. Breed, Mayor
 Grant Colfax, MD, Director of Health
 Stephanie K.J. Cushing, MSPH, CHMM, REHS
 Environmental Health Director

May 26, 2020

To: Mechanical/Energy Plan Review
 Department of Building Inspection

Cc: Sheeva Hamidieh, March Capital Management
 Melanie Stein, March Capital Management
 Robert LaBare, MHC Engineers Inc.

Re: Article 38 Enhanced Ventilation System Approval
 42 Otis Street (Block 3505, Lot 020)

We have reviewed the Enhanced Ventilation Proposal for the 42 Otis Street project to assess compliance with the requirements of Article 38 of the San Francisco Health Code. The Enhanced Ventilation Proposal we reviewed is dated May 18, 2020 and is signed and stamped by mechanical engineer Meng Hsiu-Chen of MHC Engineers, Inc. The proposal letter is attached and describes a ventilation system with the following characteristics:


- | | |
|--|------------|
| 1) Air change for residential units: | 30 cfm |
| 2) Air change for common areas: | 50-225 cfm |
| 3) Filter type for residential units: | MERV 13 |
| 4) Filter type for common areas: | MERV 13 |
| 5) Location of air intakes: | Roof |
| 6) Positive Pressure in residential units and other habitable spaces? | Yes |
| 7) Positive Pressure in common areas such as corridors? | Yes |
| Areas not served by enhanced ventilation? | N/A |
| 8) Floors of building with habitable spaces: | Floors 1-5 |
| 9) If applicable, location of Z-ducts, trickle vents, or similar unfiltered air system used for residential units: | N/A |

We also understand that this system will be in compliance with all applicable standards, including the smoke control requirements of this building.


We recommend that the San Francisco Department of Building Inspection consider the ventilation system as described in this letter to be compliant with the requirements of Article 38.

Prior to issuing any mechanical approvals, please ensure that the proposal as described is reflected in the building plans submitted for your mechanical review.

Sincerely,



 Patrick Tadahi, MS, REHS
 SFPDH Environmental Health Branch Assistant Director

ARTICLE 38 PROGRAM
 1390 Market Street, Suite 210 San Francisco, CA 94102
 Phone 415-252-3911, Fax 415-252-3894

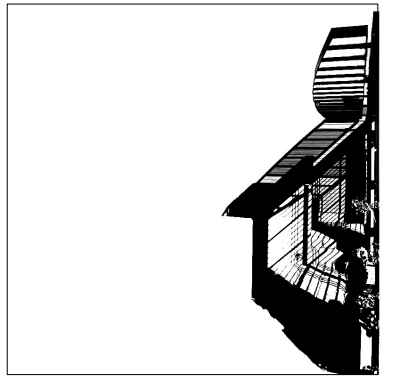

ELEVATIONarchitects
 1159 Green Street, Suite 4
 San Francisco, CA 94109

415.537.1125 :v
 www.elevationarchitects.com :w

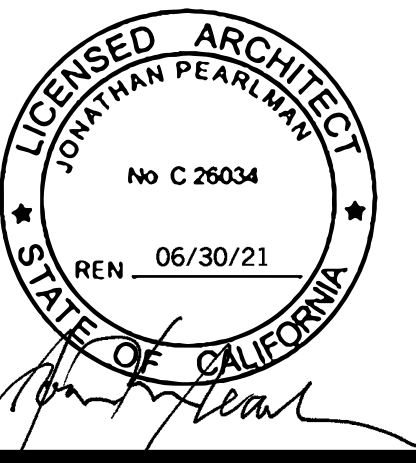

agency stamps:


Condominiums
 42 Otis Street
 San Francisco, CA 94103
 Block / Lot : 3505 / 020

#	date	issue
	10.01.19	Addendum #2
1	1.28.20	Plan Check Response 1
2	4.15.20	Project Revision 2
3	4.27.20	Plan Check Response 2
4	8.17.20	Plan Check Response 3

sheet count 2/49

**Article 38
 Compliance Letter**

project: 16.15
 drawn by: MKA
 checked by: JP
 date: 03.23.17
 scale:

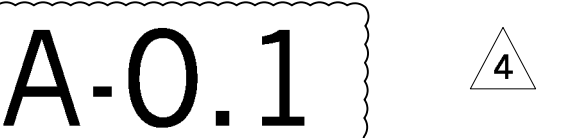

GS2: San Francisco Green Building Submittal Form for LEED or GreenPoint Rated Projects

Form version: February 1, 2018 (For permit applications January 2017 - December 2019)

INSTRUCTIONS:				NEW CONSTRUCTION			ALTERATIONS + ADDITIONS			REFERENCES	VERIFICATION			
1. Select one (1) column to the right. For each applicable requirement in the column, indicate evidence of fulfillment in the References column. For items that are not applicable, indicate "N/A". 2. Provide project information in the Verification box at the right. 3. Attach LEED or GreenPoint Rated Scorecard on separate sheet. 4. Submittal must be a minimum of 24" x 36". 5. This form is for permit applications submitted January 2017 through December 2019. The prior version may be submitted until January 1, 2018.				CHECK THE ONE COLUMN THAT BEST DESCRIBES YOUR PROJECT →			<input type="checkbox"/> LOW-RISE RESIDENTIAL R 1-3 Floors	<input checked="" type="checkbox"/> HIGH-RISE RESIDENTIAL R 4+ Floors	<input type="checkbox"/> LARGE NON-RESIDENTIAL A,B,E,I,M 25,000 sq.ft. or greater	<input type="checkbox"/> RESIDENTIAL MAJOR ALTERATIONS + ADDITIONS R 25,000 sq.ft. or greater	<input type="checkbox"/> NON-RESIDENTIAL MAJOR ALTERATIONS + ADDITIONS B,M 25,000 sq.ft. or greater	<input type="checkbox"/> 1ST TIME NON-RESIDENTIAL INTERIORS B,M 25,000 sq.ft. or greater	DRAWING OR SPECIFICATION # (if not applicable, indicate "N/A")	42 OTIS ST. PROJECT NAME 42 OTIS ST. ADDRESS 16,013 SQ. FT. GROSS BUILDING AREA 3505/020 BLOCK/LOT R-2 PRIMARY OCCUPANCY
TITLE	SOURCE OF REQUIREMENT	FOR REFERENCE LEED v4 GPR v7	DESCRIPTION OF REQUIREMENT	LEED SILVER (50+) or GPR (75+) CERTIFIED	LEED SILVER (50+) or GPR (75+) CERTIFIED	LEED GOLD (60+) CERTIFIED	LEED SILVER (50+) or GPR (75+) CERTIFIED	LEED GOLD (60+) CERTIFIED	LEED GOLD (60+) CERTIFIED					
LEED/GPR	Required LEED or GPR Certification Level	SFGBC 4.103.1.1, 4.103.2.1, 4.103.3.1, 5.103.1.1, 5.103.3.1 & 5.103.4.1	Project is required to achieve sustainability certification listed at right.	LEED SILVER (50+) or GPR (75+) CERTIFIED	LEED SILVER (50+) or GPR (75+) CERTIFIED	LEED GOLD (60+) CERTIFIED	LEED SILVER (50+) or GPR (75+) CERTIFIED	LEED GOLD (60+) CERTIFIED	LEED GOLD (60+) CERTIFIED					
	LEED/GPR Point Adjustment for Retention/Demolition of Historic Features/Building	SFGBC 4.104, 4.105, 5.104 & 5.105	Enter any applicable point adjustments in box at right.		75									
	Points on Current Scorecard		Enter current expected score in box at right as appropriate.		99	n/r		n/r	n/r					
MATERIALS	LOW-EMITTING MATERIALS	CALGreen 4.504.2.1-5 & 5.504.4.1-6, SFGBC 4.103.3.2, 5.103.1.9, 5.103.3.2 & 5.103.4.2	Use products that comply with the emission limit requirements of 4.504.2.1-5, 5.504.4.1-6 for adhesives, sealants, paints, coatings, carpet systems including cushions and adhesives, resilient flooring (80% of area), and composite wood products. Major alterations to existing residential buildings must use low-emitting coatings, adhesives and sealants, and carpet systems that meet the requirements for GPR measures K2, K3 and L2 or LEED EQc2, as applicable. New large non-residential interiors and major alterations to existing residential and non-residential buildings must also use interior paints, coatings, sealants, and adhesives when applied on-site, flooring and composite wood that meet the requirements of LEED credit Low-Emitting Materials (EQc2).	4.504.2.1-5	4.504.2.1-5	LEED EQc2	LEED EQc2 or GPR K2, K3 & L2	LEED EQc2	LEED EQc2	A1.0				
WATER	INDOOR WATER USE REDUCTION	CALGreen 4.303.1 & 5.303.3, SFGBC 5.103.1.2, SF Housing Code sec.12A10, SF Building Code ch.13A	Meet flush/flow requirements for: toilets (1.28gpf); urinals (0.125gpf wall, 0.5gpf floor); showerheads (2.0gpm); lavatories (1.2gpm private, 0.5gpm public/common); kitchen faucets (1.8gpm); wash fountains (1.8gpm); metering faucets (0.2gpc); food waste disposers (1gpm/8gpm). Residential projects must upgrade all non-compliant fixtures per SF Housing Code sec.12A10. Large non-residential interiors, alterations & additions must upgrade all non-compliant fixtures per SF Building Code ch.13A. New large non-residential buildings must also achieve minimum 30% indoor potable water use reduction as calculated to meet LEED credit Indoor Water Use Reduction (WEC2).	4.303.1	4.303.1	LEED WEC2 (2 pts)	SF Housing Code sec.12A10	SF Building Code ch.13A if applicable	SF Building Code ch.13A if applicable	A1.0				
	NON-POTABLE WATER REUSE	Health Code art.12C	New buildings ≥400,000 sq.ft. must calculate a water budget. New buildings ≥250,000 sq.ft. must treat and use available rainwater, graywater, and foundation drainage for toilet and urinal flushing and irrigation.	n/r	•	•	n/r	n/r	n/r	A1.0				
	WATER-EFFICIENT IRRIGATION	Administrative Code ch.63	New construction projects with aggregated landscape area ≥500 sq.ft., or existing projects with modified landscape area ≥1,000 sq.ft., shall use low water use plants or climate appropriate plants, restrict turf areas and comply with Model Water Efficient Landscape Ordinance restrictions by calculated ETAF (.55 for residential, .45 for non-residential or less) or by prescriptive compliance for projects with ≥2,500 sq.ft. of landscape area.	n/r	•	•	•	•	•	A1.0				
	WATER METERING	CALGreen 5.303.1	Provide submeters for spaces projected to consume >1,000gal/day (or >100gal/day in buildings >50,000 sq.ft).	n/r	n/r	•	n/r	•	•	A1.0				
ENERGY	ENERGY EFFICIENCY	CA Energy Code	Comply with all provisions of the CA Energy Code.	•	•	•	•	•	•					
	BETTER ROOFS	SFGBC 4.201.2 & 5.201.1.2	New non-residential buildings >2,000 sq.ft. and ≤10 occupied floors, and new residential buildings of any size and ≤10 occupied floors, must designate 15% of roof Solar Ready, per Title 24 rules. Install photovoltaics or solar hot water systems in this area. With Planning Department approval, projects subject to SFPUC Stormwater Requirements may substitute living roof for solar energy systems.	•	≤10 floors	•	n/r	n/r	n/r	A1.0				
	RENEWABLE ENERGY	SFGBC 5.201.1.3	Non-residential buildings ≥11 floors must acquire at least 1% of energy from on-site renewable sources, purchase green energy credits, or achieve 5 points under LEED credit Optimize Energy Performance (EAc2).	n/r	n/r	•	n/r	n/r	n/r	A1.0				
	COMMISSIONING (Cx)	CALGreen 5.410.2-5.410.4.5.1	For projects ≥10,000 sq.ft. include OPR, BOD, and commissioning plan in design & construction. Commission to comply. Alterations & additions with new HVAC equipment must test and adjust all equipment.	n/r	n/r	LEED EAc1 opt. 1	n/r	•	•	A1.0				
PARKING	BICYCLE PARKING	CALGreen 5.106.4, Planning Code sec.155.1-2	Provide short- and long-term bike parking equal to 5% of motorized vehicle parking, or meet SF Planning Code sec.155.1-2, whichever is greater.	Planning Code 155.1-2	Planning Code 155.1-2	•	Planning Code 155.1-2	•	•	A1.0				
	DESIGNATED PARKING	CALGreen 5.106.5.2	Mark 8% of total parking stalls for low-emitting, fuel efficient, and carpool/van pool vehicles.	n/r	n/r	•	n/r	•	•	A1.0				
	WIRING FOR EV CHARGERS	SFGBC 4.106.4 & 5.106.5.3	Permit application January 2018 or after: Construct all off-street parking spaces for passenger vehicles and trucks with dimensions capable of installing EVSE. Install service capacity and panelboards sufficient to provide ≥40A 208 or 240V to EV chargers at 20% of spaces. Install ≥40A 208 or 240V branch circuits to ≥10% of spaces, terminating close to the proposed EV charger location. Permit applications prior to January 2018 only: Install infrastructure to provide electricity for EV chargers at 6% of spaces for non-residential (CALGreen 5.106.5.3), 3% of spaces for multifamily with ≥17 units (CALGreen 4.106.4.2), and each space in 1-2 unit dwellings (CALGreen 4.106.4.1). All permit application dates: Installation of chargers is not required. Projects with zero off-street parking exempt.	•	•	•	applicable for permit application January 2018 or after	applicable for permit application January 2018 or after	n/r	A1.0				
WASTE DIVERSION	RECYCLING BY OCCUPANTS	SF Building Code AB-086	Provide adequate space and equal access for storage, collection, and loading of compostable, recyclable and landfill materials.	•	•	•	•	•	•	A1.0				
	CONSTRUCTION & DEMOLITION (C&D) WASTE MANAGEMENT	SFGBC 4.103.2.3 & 5.103.1.3.1, Environment Code ch.14, SF Building Code ch.13B	For 100% of mixed C&D debris use registered transporters and registered processing facilities with a minimum of 65% diversion rate. Divert a minimum of 75% of total C&D debris if noted.	•	75% diversion	75% diversion	•	•	75% diversion	A1.0				
HVAC	HVAC INSTALLER QUALS	CALGreen 702.1	Installers must be trained and certified in best practices.	•	•	n/r	•	n/r	n/r	A1.0				
	HVAC DESIGN	CALGreen 4.507.2	HVAC shall be designed to ACCA Manual J, D, and S.	•	•	n/r	•	n/r	n/r	A1.0				
	REFRIGERANT MANAGEMENT	CALGreen 5.508.1	Use no halons or CFCs in HVAC.	n/r	n/r	•	n/r	•	•	A1.0				
GOOD NEIGHBOR	LIGHT POLLUTION	CA Energy Code, CALGreen 5.106.8	Comply with CA Energy Code for Lighting Zones 1-4. Comply with 5.106.8 for Backlight/Uplight/Glare.	n/r	n/r	•	n/r	•	•	A1.0				
	BIRD-SAFE BUILDINGS	Planning Code sec.139	Glass facades and bird hazards facing and/or near Urban Bird Refuges may need to treat their glass for opacity.	•	•	•	•	•	•	A1.0				
	TOBACCO SMOKE CONTROL	CALGreen 5.504.7, Health Code art.19F	For non-residential projects, prohibit smoking within 25 feet of building entries, air intakes, and operable windows. For residential projects, prohibit smoking within 10 feet of building entries, air intakes, and operable windows and enclosed common areas.	•	•	•	•	•	•	A1.0				
POLLUTION PREVENTION	STORMWATER CONTROL PLAN	Public Works Code art.4.2 sec.147	Projects disturbing ≥5,000 sq.ft. in combined or separate sewer areas, or replacing ≥2,500 impervious sq.ft. in separate sewer area, must implement a Stormwater Control Plan meeting SFPUC Stormwater Management Requirements.	•	•	•	if project extends outside envelope	if project extends outside envelope	if project extends outside envelope	A1.0				
	CONSTRUCTION SITE RUNOFF CONTROLS	Public Works Code art.4.2 sec.146	Provide a construction site Stormwater Pollution Prevention Plan and implement SFPUC Best Management Practices. A Stormwater Pollution Prevention Plan is optional for GPR projects that disturb <5,000 sq.ft.	if disturbing ≥5,000 sq.ft.	•	if disturbing ≥5,000 sq.ft.	if project extends outside envelope	if project extends outside envelope	if project extends outside envelope	A1.0				
INDOOR ENVIRONMENTAL QUALITY	ACOUSTICAL CONTROL	CALGreen 5.507.4.1-3, SF Building Code sec.1207	Non-residential projects must comply with sound transmission limits (STC-50 exteriors near freeways/airports; STC-45 exteriors if 65db Leq at any time; STC-40 interior walls/floor-ceiling between tenants). New residential projects' interior noise due to exterior sources shall not exceed 45dB.	•	•	•	n/r	•	•	A1.0				
	AIR FILTRATION (CONSTRUCTION)	CALGreen 4.504.1 & 5.504.1.3	Seal permanent HVAC ducts/equipment stored onsite before installation.	•	•	•	•	•	•	A1.0				
	AIR FILTRATION (OPERATIONS)	CALGreen 5.504.5.3, Health Code art.38	Non-residential projects must provide MERV-8 filters on HVAC for regularly occupied, actively ventilated spaces. Residential new construction and major alteration & addition projects in Air Pollutant Exposure Zones per SF Health Code art.38 must provide MERV-13 filters on HVAC.	if applicable	if applicable	•	if applicable	•	•	A1.0				
	CONSTRUCTION IAQ MANAGEMENT PLAN	SFGBC 5.103.1.8	During construction, meet SMACNA IAQ guidelines; provide MERV-8 filters on all HVAC.	n/r	n/r	LEED EQc3	n/r	n/r	n/r	A1.0				
RESIDENTIAL-ONLY	GRADING & PAVING	CALGreen 4.106.3	Show how surface drainage (grading, swales, drains, retention areas) will keep surface water from entering the building.	•	•	n/r	if applicable	n/r	n/r	A1.0				
	RODENT PROOFING	CALGreen 4.406.1	Seal around pipe, cable, conduit, and other openings in exterior walls with cement mortar or DBI-approved similar method.	•	•	n/r	•	n/r	n/r	A1.0				
	FIREPLACES & WOODSTOVES	CALGreen 4.503.1	Install only direct-vent or sealed-combustion, EPA Phase II-compliant appliances.	•	•	n/r	•	n/r	n/r	A1.0				
	CAPILLARY BREAK, SLAB ON GRADE	CALGreen 4.505.2	Slab on grade foundation requiring vapor retarder also requires a capillary break such as: 4 inches of base 1/2-inch aggregate under retarder; slab design specified by licensed professional.	•	•	n/r	•	n/r	n/r	A1.0				
	MOISTURE CONTENT	CALGreen 4.505.3	Wall and floor wood framing must have <19% moisture content before enclosure.	•	•	n/r	•	n/r	n/r	A1.0				
	BATHROOM EXHAUST	CALGreen 4.506.1	Must be ENERGY STAR compliant, ducted to building exterior, and its humidistat shall be capable of adjusting between <50% to >80% (humidistat may be separate component).	•	•	n/r	•	n/r	n/r	A1.0				

Option 1:
Verification of compliance for this project will be provided via USGBC/GBCI certification under the LEED rating system, or Build It Green under the GreenPoint Rated system. Green Building Compliance Professional of Record is not required.

PERMIT APPLICANT (sign & date)

Option 2: LEED GBCPR
Green Building Compliance Professional of Record will verify compliance.

NAME: _____ FIRM: _____
ARCHITECTURAL OR ENGINEERING LICENSE: _____
 I am a LEED Accredited Professional
 I have completed one or more LEED projects


I have been retained by the project sponsor to review all submittal documents and verify that all approved construction documents and construction fulfill the requirements of the San Francisco Green Building Code. It is my professional opinion that the requirements of the San Francisco Green Building Code will be met for the above referenced project. I will notify the Department of Building Inspection if the project will, for any reason, not substantially comply with these requirements, or if I am no longer the Green Building Compliance Professional of Record for the project.

LICENSED PROFESSIONAL (sign & date) **AFFIX STAMP BELOW:**

Option 3: GreenPoint Rated GBPCR
Green Building Compliance Professional of Record will verify compliance.


FERGUS O'SULLIVAN FOSCO ENVIRONMENTAL
NAME: _____ FIRM: _____
ARCHITECTURAL OR ENGINEERING LICENSE: _____
 I am a GreenPoint Rater I am not a GreenPoint Rater
 I have completed one or more GreenPoint Rated projects

If the above licensed professional is not a Certified GreenPoint Rater, additional signature by a Certified GreenPoint Rater is required:

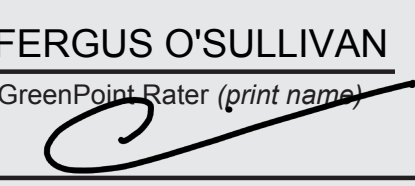
FERGUS O'SULLIVAN 415.240.5588
GreenPoint Rater (print name) (contact phone #)
 8/17/2020
(sign & date)

I have been retained by the project sponsor to review all submittal documents and verify that all approved construction documents and construction fulfill the requirements of the San Francisco Green Building Code. It is my professional opinion that the requirements of the San Francisco Green Building Code will be met for the above referenced project. I will notify the Department of Building Inspection if the project will, for any reason, not substantially comply with these requirements, or if I am no longer the Green Building Compliance Professional of Record for the project.

LICENSED PROFESSIONAL (sign & date) **AFFIX STAMP BELOW:**

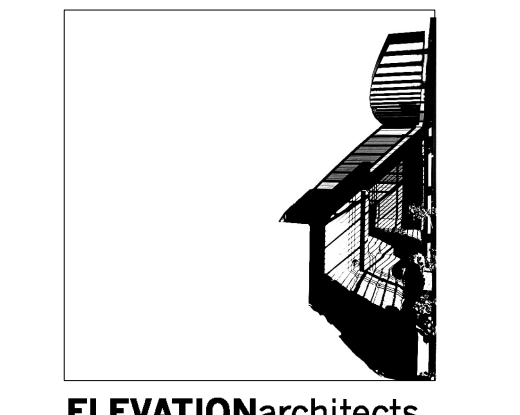

ELEVATIONarchitects
1159 Green Street, Suite 4
San Francisco, CA 94109
415.537.1125 :w
www.elevationarchitects.com :w

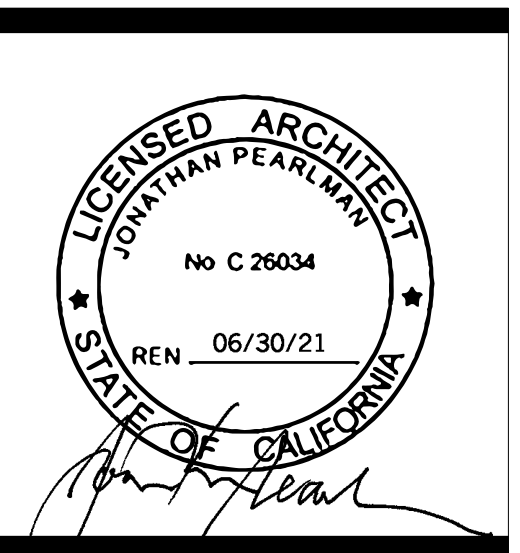

agency stamps:

Condominiums
42 Otis Street
San Francisco, CA 94103
Block / Lot : 3505 / 020

#	date	issue
	10.01.19	Addendum #2
1	1.28.20	Plan Check Response 1
2	4.15.20	Project Revision 2
3	4.27.20	Plan Check Response 2
4	8.17.20	Plan Check Response 3

sheet count: 3/49
GS2 Form
Green Bldg Submittal
project: 16.15
drawn by: MKA
checked by: JP
date: 03.23.17
scale:

A-0.2.0

GS3: San Francisco Green Building Submittal Form for Other Non-Residential Alterations, Additions & New Construction

Form version: February 1, 2018 (For permit applications January 2017 - December 2019)


INSTRUCTIONS:
 1. Select one (1) column to the right. For each applicable requirement in the column, indicate evidence of fulfillment in the References column. For items that are not applicable, indicate "N/A".
 2. Provide project information in the Verification box at the right.
 3. Submittal must be a minimum of 24" x 36".
 4. This form is for permit applications submitted January 2017 through December 2019. The prior version may be submitted until January 1, 2018.

CHECK THE ONE COLUMN THAT BEST DESCRIBES YOUR PROJECT →

	TITLE	SOURCE OF REQUIREMENT	DESCRIPTION OF REQUIREMENT	NEW CONSTRUCTION	ALTERATIONS + ADDITIONS	REFERENCES	VERIFICATION
				<input checked="" type="checkbox"/> OTHER NON-RESIDENTIAL F,H,L,S,U or A,B,E,I,M less than 25,000 sq.ft.	<input type="checkbox"/> OTHER NON-RESIDENTIAL ALTERATIONS + ADDITIONS A,B,E,F,H,L,I,M,S,U more than 1,000 sq.ft. or \$200,000	DRAWING OR SPECIFICATION # (If not applicable, indicate "N/A".)	42 OTIS STREET PROJECT NAME 3525/020 BLOCK/LOT 42 OTIS STREET ADDRESS R2, M, S PRIMARY OCCUPANCY 16,013 SQ.FT. GROSS BUILDING AREA
MATERIALS	LOW-EMITTING MATERIALS	CALGreen 5.504.4.1-6	Use products that comply with the emission limit requirements of 4.504.2.1-5, 5.504.4.1-6 for adhesives, sealants, paints, coatings, carpet systems including cushions and adhesives, resilient flooring (80% of area), and composite wood products.	•	•	REFER TO GREEN BUILDING GENERAL NOTES ON A-0.1A	
WATER	INDOOR WATER USE REDUCTION	CALGreen 5.303.3, SF Building Code ch.13A	Meet flush/flow requirements for: toilets (1.28gpf); urinals (0.125gpf wall, 0.5gpf floor); showerheads (2.0gpm); lavatories (1.2gpm private, 0.5gpm public/common); kitchen faucets (1.8gpm); wash fountains (1.8gpm); metering faucets (0.2gpc); food waste disposers (1gpm/8gpm). Large non-residential alteration & addition projects must upgrade all non-compliant fixtures per SF Building Code ch.13A.	•	•	REFER TO GREEN BUILDING GENERAL NOTES ON A-0.1A	
	WATER-EFFICIENT IRRIGATION	Administrative Code ch.63	New construction projects with aggregated landscape area ≥500 sq.ft., or existing projects with modified landscape area ≥1,000 sq.ft., shall use low water use plants or climate appropriate plants, restrict turf areas and comply with Model Water Efficient Landscape Ordinance restrictions by calculated ETAF ≤.45 or by prescriptive compliance for projects with ≤2,500 sq.ft. of landscape area.	•	if applicable	N/A	
	WATER METERING	CALGreen 5.303.1	Provide submeters for spaces projected to consume >1,000gal/day (or >100gal/day in buildings >50,000 sq.ft).	•	•	N/A	
ENERGY	ENERGY EFFICIENCY	CA Energy Code	Comply with all provisions of the CA Energy Code.	•	•	REFER TO TITLE 24 CALCULATIONS	
	BETTER ROOFS	SFGBC 5.201.1.2	New buildings with ≤10 floors and ≥2,000 sq.ft. must designate 15% of roof Solar Ready, per Title 24 rules. Install photovoltaics or solar hot water systems in this area. With Planning Department approval, projects subject to SFPUC Stormwater Requirements may substitute living roof for solar energy systems.	•	n/r	REFER TO TITLE 24 CALCULATIONS	
	RENEWABLE ENERGY	SFGBC 5.201.1.3	New buildings of ≥11 floors must acquire renewable on-site energy, purchase green energy credits or achieve 10% reduction below 2016 CA Energy Code.	•	n/r	N/A	
	COMMISSIONING (Cx)	CALGreen 5.410.2-5.410.4.5.1	For projects ≥10,000 sq.ft, include OPR, BOD, and commissioning plan in design & construction. Commission to comply. Alterations & additions with new HVAC equipment must test and adjust all equipment.	•	•	N/A	
PARKING	BICYCLE PARKING	CALGreen 5.106.4, Planning Code sec.155.1-2	Provide short- and long-term bike parking equal to 5% of motorized vehicle parking, or meet SF Planning Code sec.155.1-2, whichever is greater.	•	if >10 stalls added	REFER TO GREEN BUILDING GENERAL NOTES ON A-0.1A	
	DESIGNATED PARKING	CALGreen 5.106.5.2	Comply with Table 5.106.5.2 (approx. 8% of total spaces).	•	if >10 stalls added	REFER TO GREEN BUILDING GENERAL NOTES ON A-0.1A	
	WIRING FOR EV CHARGING	SFGBC 5.106.5.3	Permit application January 2018 or after: Construct all off-street parking spaces for passenger vehicles and trucks with dimensions capable of installing EVSE. Install service capacity and panelboards sufficient to provide ≥40A 208 or 240V to EV chargers at 20% of spaces. Install ≥40A 208 or 240V branch circuits to ≥10% of spaces, terminating close to the proposed EV charger location. Installation of chargers is not required. Projects with zero off-street parking exempt. See SFGBC 4.106.4, or SFGBC 5.106.5.3 for details. Permit applications prior to January 2018 only: Install infrastructure to provide electricity for EV chargers at 6% of spaces (CalGreen 5.106.5.3). Installation of chargers is not required. All permit application dates: Installation of chargers is not required. Projects with zero off-street parking exempt.	•	n/r	REFER TO GREEN BUILDING GENERAL NOTES ON A-0.1A	
WASTE DIVERSION	RECYCLING BY OCCUPANTS	SF Building Code AB-088	Provide adequate space and equal access for storage, collection, and loading of compostable, recyclable and landfill materials.	•	•	REFER TO GREEN BUILDING GENERAL NOTES ON A-0.1A	
	CONSTRUCTION & DEMOLITION (C&D) WASTE MANAGEMENT	Environment Code ch.14, SF Building Code ch.13B	For 100% of mixed C&D debris use registered transporters and registered processing facilities with a minimum of 65% diversion rate.	•	•	REFER TO GREEN BUILDING GENERAL NOTES ON A-0.1A	
HVAC	REFRIGERANT MANAGEMENT	CALGreen 5.508.1	Use no halons or CFCs in HVAC.	•	•	REFER TO GREEN BUILDING GENERAL NOTES ON A-0.1A	
GOOD NEIGHBOR	LIGHT POLLUTION REDUCTION	CA Energy Code, CALGreen 5.106.8	Comply with CA Energy Code for Lighting Zones 1-4. Comply with 5.106.8 for Backlight/Uplight/Glare.	•	•	REFER TO GREEN BUILDING GENERAL NOTES ON A-0.1A REFER TO TITLE 24 CALCULATIONS	
	BIRD-SAFE BUILDINGS	Planning Code sec.139	Glass facades and bird hazards facing and/or near Urban Bird Refuges may need to treat their glass for opacity.	•	•	REFER TO GREEN BUILDING GENERAL NOTES ON A-0.1A	
	TOBACCO SMOKE CONTROL	CALGreen 5.504.7	Prohibit smoking within 25 feet of building entries, air intakes, and operable windows.	•	•	REFER TO GREEN BUILDING GENERAL NOTES ON A-0.1A	
POLLUTION PREVENTION	STORMWATER CONTROL PLAN	Public Works Code art.4.2 sec.147	Projects disturbing ≥5,000 sq.ft. in combined or separate sewer areas, or replacing ≥2,500 impervious sq.ft. in separate sewer area, must implement a Stormwater Control Plan meeting SFPUC Stormwater Management Requirements.	•	if project extends outside envelope	REFER TO GREEN BUILDING GENERAL NOTES ON A-0.1A	
	CONSTRUCTION SITE RUNOFF	Public Works Code art.4.2 sec.146	Provide a construction site Stormwater Pollution Prevention Plan and implement SFPUC Best Management Practices.	if disturbing ≥5,000 sq.ft.	if project extends outside envelope	REFER TO GREEN BUILDING GENERAL NOTES ON A-0.1A	
INDOOR ENVIRONMENTAL QUALITY	ACOUSTICAL CONTROL	CALGreen 5.507.4.1-3	Comply with sound transmission limits (STC-50 exteriors near freeways/airports; STC-45 exteriors if 65db Leq at any time; STC-40 interior walls/floor-ceilings between tenants).	•	•	REFER TO GREEN BUILDING GENERAL NOTES ON A-0.1A	
	AIR FILTRATION (CONSTRUCTION)	CALGreen 5.504.1-3	Seal permanent HVAC ducts/equipment stored onsite before installation.	•	•	REFER TO GREEN BUILDING GENERAL NOTES ON A-0.1A	
	AIR FILTRATION (OPERATIONS)	CALGreen 5.504.5.3	Provide MERV-8 filters on HVAC for regularly occupied, actively ventilated spaces.	•	•	REFER TO GREEN BUILDING GENERAL NOTES ON A-0.1A	

I am a LEED Accredited Professional
 I am a GreenPoint Rater
 I am an ICC Certified CALGreen Inspector

To the best of my knowledge, it is my professional opinion the green building requirements of the City of San Francisco will be met for the above referenced project. I have been retained by the project sponsor to review all submittal documents and verify that approved construction documents and construction properly reflect the requirements of the San Francisco Green Building Code. I will notify the Department of Building Inspection if I believe to the best of my knowledge that the project will, for any reason, not substantially comply with these green building requirements, or if I am no longer the Green Building Compliance Professional of Record for this project.

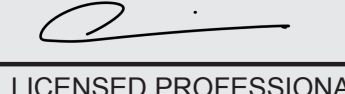
 8/17/2020
 LICENSED PROFESSIONAL (sign & date)

AFFIX STAMP BELOW:



ELEVATIONarchitects
 1159 Green Street, Suite 4
 San Francisco, CA 94109

 415.537.1125 :v
 www.elevationarchitects.com :w

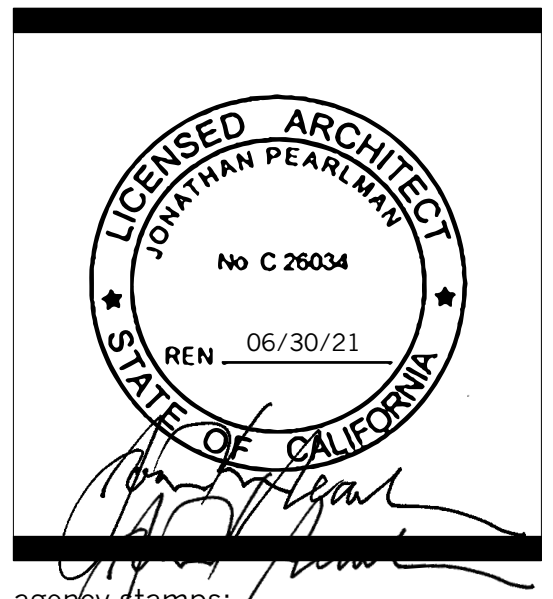

agency stamps:

Green Building Compliance Professional of Record will verify compliance.

 FERGUS O'SULLIVAN
 NAME

 FOSCO Environmental
 FIRM

ARCHITECTURAL OR ENGINEERING LICENSE

Condominiums
 42 Otis Street
 San Francisco, CA 94103
 Block / Lot : 3505 / 020

#	date	issue
	10.01.19	Addendum #2
1	1.28.20	Plan Check Response 1
2	4.15.20	Project Revision 2
3	4.27.20	Plan Check Response 2
4	8.17.20	Plan Check Response 3
sheet count		4/49

GS3 Form Green Bldg Submittal

project: 16.15
 drawn by: MKA
 checked by: JP
 date: 03.23.17
 scale:

A-0.2.1




NEW HOME RATING SYSTEM, VERSION 7.0

MULTIFAMILY

The GreenPoint Rated certified checks green building requirements into the home. GreenPoint Rated is administered by Built In Green, a nonprofit green building...

Points Target: 99.0
Certification Level: Silver

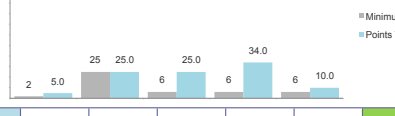

New Home Multifamily Version 7.0


Table with columns: Measures, Points Target, Compliance, Energy, Water, Materials, and Notes. Rows include categories like CALGreen, AIR, A1, A2, A3, A99, A100.

Table for 42 OTIS STREET SAN FRANCISCO. Columns: Measure, Points Target, Compliance, Energy, Water, Materials, and Notes. Rows include categories like CALGreen, AIR, A1, A2, A3, A99, A100.

Table for 42 OTIS STREET SAN FRANCISCO. Columns: Measure, Points Target, Compliance, Energy, Water, Materials, and Notes. Rows include categories like CALGreen, AIR, A1, A2, A3, A99, A100.

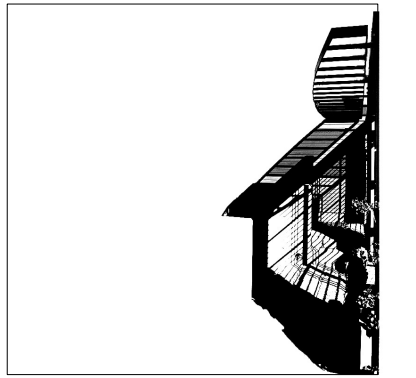

ELEVATIONarchitects
1159 Green Street, Suite 4
San Francisco, CA 94109

415.537.1125 :v
www.elevationarchitects.com :w



agency stamps:

Condominiums
42 Otis Street
San Francisco, CA 94103
Block / Lot : 3505 / 020

Table with columns: #, date, issue. Rows: 10.01.19 Addendum #2, 1.28.20 Plan Check Response 1, 4.15.20 Project Revision 2, 4.27.20 Plan Check Response 2, 8.17.20 Plan Check Response 3

sheet count 5/49

GreenPoint
Rated Scorecard

project: 16.15
drawn by: MKA
checked by: JP
date: 03.23.17
scale:

A-0.2.2

NOTICE OF SPECIAL RESTRICTIONS UNDER THE PLANNING CODE

RECORDING REQUESTED BY:)
)
 And When Recorded Mail To:)
)
 Name:) 10/11/2018, 20186631919
) CONFIRMED COPY of documents recorded
) with document no.
 Address:) SAN FRANCISCO ASSESSOR-RECORDER
) The document has not been compared with the original
 City:)
)
 State: California) Space Above this Line For Recorder's
 Use)

I (We) Costanoan LLC the owner(s) of that certain real property situated in the City and County of San Francisco, State of California more particularly described as follows:

(PLEASE ATTACH THE LEGAL DESCRIPTION AS ON DEED)
 BEING ASSESSOR'S BLOCK: 3505; LOT: 020
 COMMONLY KNOWN AS: 42 OTIS STREET;

hereby give notice that there are special restrictions on the use of said property under the San Francisco Planning Code.

Pursuant to Planning Code Section 169 and the TDM Program Standards (as amended on February 17, 2017), the Development Project authorized by Building Permit No. 201703302811 (See Case No. 2016-005406TDM) shall be subject to the following:

- Prior to the issuance of a first certificate of occupancy, the property owner shall facilitate a site inspection by Planning Department staff to confirm that all approved physical improvement measures in the Development Project's TDM Plan have been implemented and/or installed. The property owner shall also provide documentation that all approved programmatic measures in the Development Project's TDM Plan will be implemented. The process and standards for determining compliance shall be specified in the Planning Commission's TDM Program Standards.
- Throughout the life of the Development Project, the property owner, and all successors, shall:

NOTICE OF SPECIAL RESTRICTIONS UNDER THE PLANNING CODE

- Maintain a TDM coordinator, as defined in the TDM Program Standards, who shall coordinate with the City on the Development Project's compliance with its approved TDM Plan.
- Allow City staff access to relevant portions of the property to conduct site visits, surveys, inspection of physical improvements, and/or other empirical data collection, and facilitate in-person, phone, and/or e-mail or web-based interviews with residents, tenants, employees, and/or visitors. City staff shall provide advance notice of any request for access and shall use all reasonable efforts to protect personal privacy during visits and in the use of any data collected during this process.
- Submit periodic compliance reports to the Planning Department, as required by the TDM Program Standards.

(3) The following constitutes the TDM Plan for this Development Project:

TDM Measures, Land Use Category Residential	Points
ACTIVE-2: Bicycle Parking - Option B	2
LU-2: On-Site Affordable Housing - Option B	2
PKG-4: Parking Supply - Option K	11
Required Target Points	5
Points Achieved	15

(4) Details for each TDM measure included in the plan above are attached as Exhibit A of this notice.

The use of said property contrary to these special restrictions shall constitute a violation of the Planning Code, and no release, modification or elimination of these restrictions shall be valid unless notice thereof is recorded on the Land Records by the Zoning Administrator of the City and County of San Francisco.

Dated: OCTOBER 10, 2018 at San Francisco, California.

(Owner's Signature)

 (Agent's Signature)

This signature(s) must be acknowledged by a notary public before recordation; add Notary Public Certification and Official Notarial Seal.

CALIFORNIA ALL-PURPOSE ACKNOWLEDGMENT CIVIL CODE § 1189

A notary public or other officer completing this certificate verifies only the identity of the individual who signed the document to which this certificate is attached, and not the truthfulness, accuracy, or validity of that document.

State of California)
 County of SAN FRANCISCO)
 On OCTOBER 10, 2018 before me, OUJ SAPPRASERT O'BRIEN, NOTARY PUBLIC,
 Date Here Insert Name and Title of the Officer
 personally appeared BORA OZTURK
 Name(s) of Signer(s)

who proved to me on the basis of satisfactory evidence to be the person(s) whose name(s) is/are subscribed to the within instrument and acknowledged to me that he/she/they executed the same in his/her/their authorized capacity(ies), and that by his/her/their signature(s) on the instrument the person(s), or the entity upon behalf of which the person(s) acted, executed the instrument.

I certify under PENALTY OF PERJURY under the laws of the State of California that the foregoing paragraph is true and correct.

WITNESS my hand and official seal.
 Signature OUJ SAPPRASERT O'BRIEN
 Signature of Notary Public



Place Notary Seal Above
 OPTIONAL
 Though this section is optional, completing this information can deter alteration of the document or fraudulent reattachment of this form to an unintended document.

Description of Attached Document
 Title or Type of Document: _____
 Document Date: _____ Number of Pages: _____
 Signer(s) Other Than Named Above: _____


Capacity(ies) Claimed by Signer(s)
 Signer's Name: _____
 Corporate Officer - Title(s): _____
 Partner - Limited General
 Individual Attorney in Fact
 Trustee Guardian or Conservator
 Other: _____
 Signer Is Representing: _____

Signer's Name: _____
 Corporate Officer - Title(s): _____
 Partner - Limited General
 Individual Attorney in Fact
 Trustee Guardian or Conservator
 Other: _____
 Signer Is Representing: _____

©2015 National Notary Association • www.NationalNotary.org • 1-800-US NOTARY (1-800-876-6827) Item #5907



ELEVATIONarchitects
 1159 Green Street, Suite 4
 San Francisco, CA 94109
 415.537.1125 :v
 www.elevationarchitects.com :w

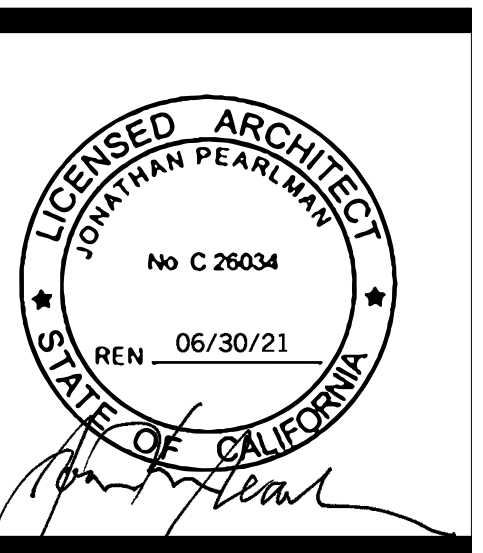

agency stamps:

NOTICE OF SPECIAL RESTRICTIONS UNDER THE PLANNING CODE

EXHIBIT A - TDM MEASURE DETAILS

TRANSPORTATION DEMAND MANAGEMENT MEASURES: ACTIVE TRANSPORTATION
Bicycle Parking



TDM MEASURE:
 The property owner may choose ONE of the following options to provide Class 1 and/or Class 2 Bicycle Parking spaces as defined by the Planning Code:

OPTION A POINTS: **1**
Residential: Class 1 and 2 bicycle parking spaces as required by the Planning Code.
Office: Class 1 and 2 bicycle parking spaces as required by the Planning Code.
Retail: Class 1 and 2 bicycle parking spaces as required by the Planning Code.

OPTION B POINTS: **2**
Residential: One Class 1 Bicycle Parking space for each Dwelling Unit, and two Class 2 Bicycle Parking spaces for every 20 Dwelling Units.
Office: One Class 1 Bicycle Parking space for every 2,500 square feet of Occupied Floor Area, and two Class 2 Bicycle Parking spaces for every 25,000 square feet of Occupied Floor Area.
Retail: One Class 1 Bicycle Parking space for every 3,750 square feet of Occupied Floor Area, and one Class 2 Bicycle Parking space for every 750 square feet of Occupied Floor Area; or five percent of the maximum number of visitors which the project is designed to accommodate, whichever is less.

APPLICABILITY: This measure is required for some projects under Planning Code Section 155.2, and is applicable to Development Projects in any land use category. POINTS: **1-4** ○○○○

CALIFORNIA ALL-PURPOSE ACKNOWLEDGMENT CIVIL CODE § 1189

A notary public or other officer completing this certificate verifies only the identity of the individual who signed the document to which this certificate is attached, and not the truthfulness, accuracy, or validity of that document.

State of California)
 County of SAN FRANCISCO)
 On OCTOBER 10, 2018 before me, OUJ SAPPRASERT O'BRIEN, NOTARY PUBLIC,
 Date Here Insert Name and Title of the Officer
 personally appeared JONATHAN PEARLMAN
 Name(s) of Signer(s)

who proved to me on the basis of satisfactory evidence to be the person(s) whose name(s) is/are subscribed to the within instrument and acknowledged to me that he/she/they executed the same in his/her/their authorized capacity(ies), and that by his/her/their signature(s) on the instrument the person(s), or the entity upon behalf of which the person(s) acted, executed the instrument.

I certify under PENALTY OF PERJURY under the laws of the State of California that the foregoing paragraph is true and correct.

WITNESS my hand and official seal.
 Signature OUJ SAPPRASERT O'BRIEN
 Signature of Notary Public



Place Notary Seal Above
 OPTIONAL
 Though this section is optional, completing this information can deter alteration of the document or fraudulent reattachment of this form to an unintended document.

Description of Attached Document
 Title or Type of Document: _____
 Document Date: _____ Number of Pages: _____
 Signer(s) Other Than Named Above: _____

Capacity(ies) Claimed by Signer(s)
 Signer's Name: _____
 Corporate Officer - Title(s): _____
 Partner - Limited General
 Individual Attorney in Fact
 Trustee Guardian or Conservator
 Other: _____
 Signer Is Representing: _____

Signer's Name: _____
 Corporate Officer - Title(s): _____
 Partner - Limited General
 Individual Attorney in Fact
 Trustee Guardian or Conservator
 Other: _____
 Signer Is Representing: _____

Condominiums
 42 Otis Street
 San Francisco, CA 94103
 Block / Lot : 3505 / 020

#	date	issue
	10.01.19	Addendum #2
1	1.28.20	Plan Check Response 1
2	4.15.20	Project Revision 2
3	4.27.20	Plan Check Response 2
4	8.17.20	Plan Check Response 3

sheet count 6/49
TDM Requirements

project: 16.15
 drawn by: MKA
 checked by: JP
 date: 03.23.17
 scale:

A-0.3

Bicycle Parking

ACTIVE-2

OPTION D	POINTS:
<p>Residential: One and a half Class 1 Bicycle Parking spaces for each Dwelling Unit, and three Class 2 Bicycle Parking spaces for every 20 Dwelling Units.</p> <p>Office: One Class 1 Bicycle Parking space for every 1,667 square feet of Occupied Floor Area, and three Class 2 Bicycle Parking spaces for every 25,000 square feet of Occupied Floor Area.</p> <p>Retail: One Class 1 Bicycle Parking space for every 2,500 square feet of Occupied Floor Area, and two Class 2 Bicycle Parking spaces for every 750 square feet of Occupied Floor Area or 10 percent of the maximum number of visitors which the project is designed to accommodate, whichever is less.</p>	3
OPTION C	POINTS:
<p>Residential: For each Dwelling Unit, one and half Class 1 Bicycle Parking spaces or one Class 1 Bicycle Parking space for each bedroom, whichever is greater, and four Class 2 Bicycle Parking spaces for every 20 Dwelling Units.</p> <p>Office: One Class 1 Bicycle Parking space for every 1,250 square feet of Occupied Floor Area, and four Class 2 Bicycle Parking spaces for every 25,000 square feet of Occupied Floor Area.</p> <p>Retail: One Class 1 Bicycle Parking space for every 1,875 square feet of Occupied Floor Area, and three Class 2 Bicycle Parking spaces for every 750 square feet of Occupied Floor Area or 20 percent of the maximum number of visitors which the project is designed to accommodate, whichever is less.</p>	4

Bicycle Parking

ACTIVE-2

DEVELOPMENT REVIEW:	The property owner shall submit plans that identify the amount, type (Class 1 or Class 2), and location of bicycle parking. City staff shall review the plans to ensure that the bicycle parking spaces provided meet the standards and minimums identified in the Planning Code, Zoning Administrator Bulletin No. 9, and/or those specified in this measure. City staff shall assign points based on the level of implementation. Class 1 Bicycle Parking spaces provided in excess of Planning Code requirements may vary from Planning Code standards as to location and spacing, provided that the intent of the standards regarding convenience and security is preserved.
PRE-OCCUPANCY MONITORING AND REPORTING:	The TDM coordinator shall facilitate a site inspection by Planning Department staff to verify that the bicycle parking meets the standards specified in the project approvals. Additionally, City staff shall provide the TDM coordinator with a copy of the approved TDM Plan. The TDM coordinator will provide City staff with a signed letter agreeing to distribute the TDM Plan via new employee packets, tenant lease documents, and/or deeds.
ONGOING MONITORING AND REPORTING:	The property owner shall provide photographs of the bicycle parking. City staff will verify that the standards specified in the project approvals are met. City staff will perform one site visit every three years to verify that the project continues to meet the standards specified in the project approvals.
RELEVANT MUNICIPAL CODES:	San Francisco Planning Code Sections 155.1, 155.2, 155.3 and 430.

NOTES:
1 At least ten percent of all Class 1 Bicycle Parking spaces provided in excess of Planning Code requirements shall be designed to accommodate cargo bicycles. The number of Class 2 Bicycle Parking spaces in excess of Planning Code requirements may be reduced by up to 80 percent provided all Class 2 spaces provided are free to patrons of the project, located in one or more on-site facilities, easily accessible, monitored, protected from vandalism, weather, and designed and opened to reasonably allow patrons the ability to retrieve their bicycle.

TRANSPORTATION DEMAND MANAGEMENT MEASURES:
LAND USE



On-site Affordable Housing

TDM MEASURE:
The Development Project shall include on-site Affordable Housing, as defined in Planning Code Section 415, as research indicates that Affordable Housing units generate fewer vehicle trips than market-rate housing units. This measure is in recognition of the amount of on-site affordable housing a Development Project may provide as permitted by City law, as opposed to a requirement.

Option	PERCENTAGE OF UNITS BY INCOME RANGE		Points
	Low Income (Income > 55 ≤ 80%)	Low Income (Income ≤ 55%)	
OPTION A	≥ 5 ≤ 10%	≥ 3 ≤ 7%	● 1
OPTION B	> 10 ≤ 20%	> 7 ≤ 14%	●● 2
OPTION C	> 20 ≤ 25%	> 14 ≤ 20%	●●● 3
OPTION D	—	> 20 ≤ 25%	●●●● 4

APPLICABILITY: This measure is applicable to residential Development Projects (land use category C).

POINTS: **1-4** ○○○○

On-site Affordable Housing

LU-2

OPTION A	POINTS:
<p>One point if providing greater than or equal to five percent and less than or equal to 10 percent on-site Affordable Housing where total household income does not exceed 80 percent of Area Median Income; OR</p> <p>One point if providing greater than or equal to three percent and less than or equal to seven percent on-site Affordable Housing where total household income does not exceed 55 percent of Area Median Income; OR</p>	1
OPTION B	POINTS:
<p>Two points if providing greater than 10 percent and less than or equal to 20 percent on-site Affordable Housing where total household income does not exceed 80 percent of Area Median Income; OR</p> <p>Two points if providing greater than 7 percent and less than or equal to 14 percent on-site Affordable Housing where total household income does not exceed 55 percent of Area Median Income; OR</p>	2
OPTION C	POINTS:
<p>Three points if providing greater than 20 percent and less than or equal to 25 percent on-site Affordable Housing where total household income does not exceed 80 percent of Area Median Income; OR</p> <p>Three points if providing greater than 14 percent and less than or equal to 20 percent on-site Affordable Housing where total household income does not exceed 55 percent of Area Median Income; OR</p>	3
OPTION D	POINTS:
<p>Four points if providing greater than 20 percent and less than or equal to 25 percent on-site Affordable Housing where total household income does not exceed 55 percent of Area Median Income.</p>	4

On-site Affordable Housing

LU-2

DEVELOPMENT REVIEW:	The property owner shall submit a project description that specifies the number of affordable units and income levels to which they are affordable. City staff will assign points based on the level of implementation.
PRE-OCCUPANCY MONITORING AND REPORTING:	The property owner shall submit a copy of the Notice of Special Restrictions specifying the affordability restrictions for the project, including the number, location, and sizes for all affordable units. City staff shall confirm that affordable units are offered as described in the project approvals. Additionally, City staff shall provide the TDM coordinator with a copy of the approved TDM Plan. The TDM coordinator will provide City staff with a signed letter agreeing to distribute the TDM Plan via new employee packets, tenant lease documents, and/or deeds.
ONGOING MONITORING AND REPORTING:	The Mayor's Office of Housing and Community Development (MOHCD) shall monitor and require occupancy certification for affordable ownership and rental units on an annual or bi-annual basis, as outlined in the Procedures Manual ¹ . The MOHCD may also require the owner of an affordable rental unit, the owner's designated representative, or the tenant in an affordable unit to verify the income levels of the tenant on an annual or bi-annual basis, as outlined in the Procedures Manual.
RELEVANT MUNICIPAL CODES:	San Francisco Planning Code Section 415.

NOTES:
1 City and County of San Francisco Inclusionary Affordable Housing Program Monitoring and Procedures manual, effective May 2013.

TRANSPORTATION DEMAND MANAGEMENT MEASURES:
PARKING MANAGEMENT




Parking Supply

TDM MEASURE:
The Development Project shall provide off-street private vehicular parking (Accessory Parking) in an amount no greater than the off-street parking rate for the neighborhood (neighborhood parking rate), based on the transportation analysis zone for the project site. For non-residential uses (land use categories A, B, and D), the neighborhood parking rate is shown in the non-residential neighborhood parking rate map and spreadsheet. For residential uses (land use category C), the neighborhood parking rate is shown in the residential neighborhood parking rate map and spreadsheet. The neighborhood parking rates may be updated over time to reflect refined estimates, but shall not be higher than the rates established at the time of TDM Ordinance adoption. The property owner shall be subject to the neighborhood parking rates established at the time of project approval.

OPTION A	POINTS:
<p>One point for providing less than or equal to 100 percent and greater than 90 percent of the neighborhood parking rate; OR</p>	1
OPTION B	POINTS:
<p>Two points for providing less than or equal to 90 percent and greater than 80 percent of the neighborhood parking rate; OR</p>	2
OPTION C	POINTS:
<p>Three points for providing less than or equal to 80 percent and greater than 70 percent of the neighborhood parking rate; OR</p>	3


APPLICABILITY: This measure is applicable to Development Projects in any land use category.

POINTS: **1-11** ○○○○○○○○○○

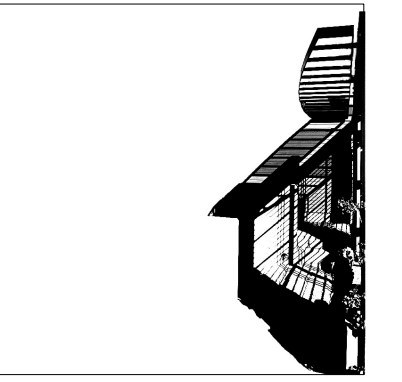

ELEVATIONarchitects
1159 Green Street, Suite 4
San Francisco, CA 94109

415.537.1125 :v
www.elevationarchitects.com :w

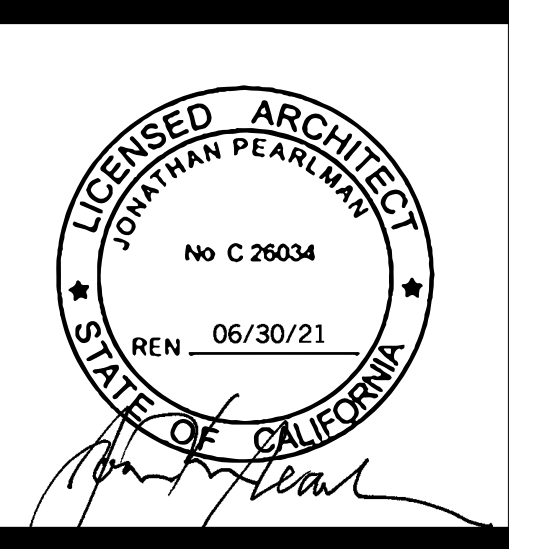

agency stamps:

Condominiums
42 Otis Street
San Francisco, CA 94103
Block / Lot : 3505 / 020

#	date	issue
	10.01.19	Addendum #2
1	1.28.20	Plan Check Response 1
2	4.15.20	Project Revision 2
3	4.27.20	Plan Check Response 2
4	8.17.20	Plan Check Response 3

sheet count 7/49

TDM Requirements

project: 16.15
drawn by: MKA
checked by: JP
date: 03.23.17
scale:

A-0.4

Parking Supply Management

PKG-4

OPTION D: Four points for providing less than or equal to 70 percent and greater than 60 percent of the neighborhood parking rate; OR	POINTS: 4
OPTION E: Five points for providing less than or equal to 60 percent and greater than 50 percent of the neighborhood parking rate; OR	POINTS: 5
OPTION F: Six points for providing less than or equal to 50 percent and greater than 40 percent of the neighborhood parking rate; OR	POINTS: 6
OPTION G: Seven points for providing less than or equal to 40 percent and greater than 30 percent of the neighborhood parking rate; OR	POINTS: 7
OPTION H: Eight points for providing less than or equal to 30 percent and greater than 20 percent of the neighborhood parking rate; OR	POINTS: 8
OPTION I: Nine points for providing less than or equal to 20 percent and greater than 10 percent of the neighborhood parking rate; OR	POINTS: 9
OPTION J: Ten points for providing less than or equal to 10 percent of the neighborhood parking rate but at least one parking space; OR	POINTS: 10
OPTION K: Eleven points for providing no parking.	POINTS: 11

Parking Supply Management

PKG-4

DEVELOPMENT REVIEW:	The property owner shall submit plans showing the proposed number of parking spaces and the spatial layout of the parking, including means of ingress/egress. In the project description, the property owner shall describe any planned components that may increase the capacity of the parking facility (e.g., by providing valet parking or installing mechanical parking systems). City staff will compare the amount of proposed parking to the parking rate in that neighborhood to confirm the Development Project's point allocation under this measure. City staff will also review the parking facilities to confirm that use of the facility would not create hazards for persons using other modes of transportation.
PRE-OCCUPANCY MONITORING AND REPORTING:	The TDM coordinator shall facilitate a site inspection by Planning Department staff to verify that the project meets the standards specified in the project approvals, and that the configuration of the vehicular parking (including ingress/egress) does not create hazards. Additionally, City staff shall provide the TDM coordinator with a copy of the approved TDM Plan. The TDM coordinator will provide City staff with a signed letter agreeing to distribute the TDM Plan via new employee packets, tenant lease documents, and/or deeds.
ONGOING MONITORING AND REPORTING:	The property owner shall submit photographs of the parking facilities. City Staff shall verify that the project continues to meet the standards specified in the Development Project's approvals, and that the configuration of the vehicular parking (including ingress/egress) does not create hazards. City staff will perform one site visit every three years to verify that the project continues to meet the standards specified in the project approvals.
RELEVANT MUNICIPAL CODE(S):	San Francisco Planning Code Sections 150, 151, 151.1, and 161.


EXHIBIT "A"
Legal Description

For APN/Parcel ID(s): Lot 020, Block 3505

THE LAND REFERRED TO HEREIN BELOW IS SITUATED IN THE CITY OF SAN FRANCISCO, COUNTY OF SAN FRANCISCO, STATE OF CALIFORNIA AND IS DESCRIBED AS FOLLOWS:
BEGINNING AT A POINT ON THE NORTHWESTERLY LINE OF OTIS STREET, DISTANT THEREON 251 FEET AND 0-1/2 INCH SOUTHWESTERLY FROM THE SOUTHWESTERLY LINE OF TWELFTH STREET; RUNNING THENCE SOUTHWESTERLY AND ALONG SAID LINE OF OTIS STREET 50 FEET AND 3 INCHES; THENCE AT A RIGHT ANGLE NORTHWESTERLY 81 FEET AND 2-3/8 INCHES; THENCE AT A RIGHT ANGLE NORTHEASTERLY 50 FEET AND 3 INCHES; THENCE AT A RIGHT ANGLE SOUTHEASTERLY 81 FEET AND 2-3/8 INCHES TO THE POINT OF BEGINNING.
BEING PART OF MISSION BLOCK NO. 13.

Grant Deed
SCA0000129.doc / Updated: 05.24.16


Printed: 07.12.16 @ 10:35 PM
CA-CT-FWPN-02180.052355-FWPN-351600447

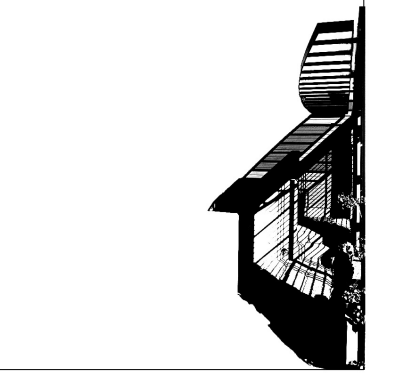

ELEVATIONarchitects

1159 Green Street, Suite 4
San Francisco, CA 94109

415.537.1125 :v
www.elevationarchitects.com :w

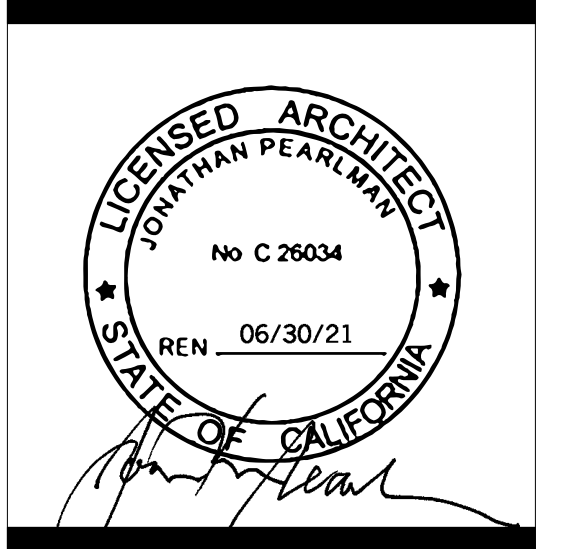

agency stamps:

Condominiums
42 Otis Street
San Francisco, CA 94103
Block / Lot : 3505 / 020


#	date	issue
	10.01.19	Addendum #2
1	1.28.20	Plan Check Response 1
2	4.15.20	Project Revision 2
3	4.27.20	Plan Check Response 2
4	8.17.20	Plan Check Response 3

sheet count 8/49


TDM Requirements

project: 16.15
drawn by: MKA
checked by: JP
date: 03.23.17
scale:

A-0.5

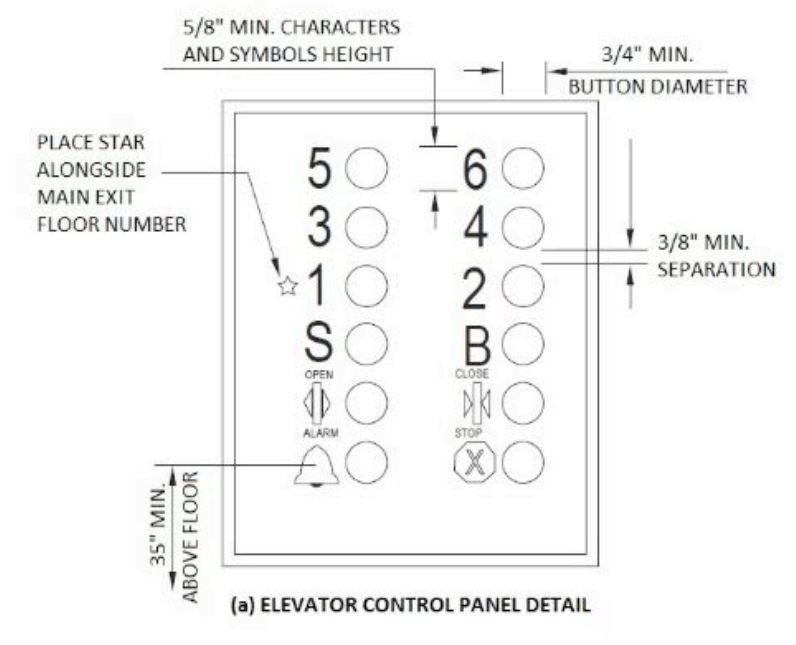


(a) ELEVATOR CONTROL PANEL DETAIL

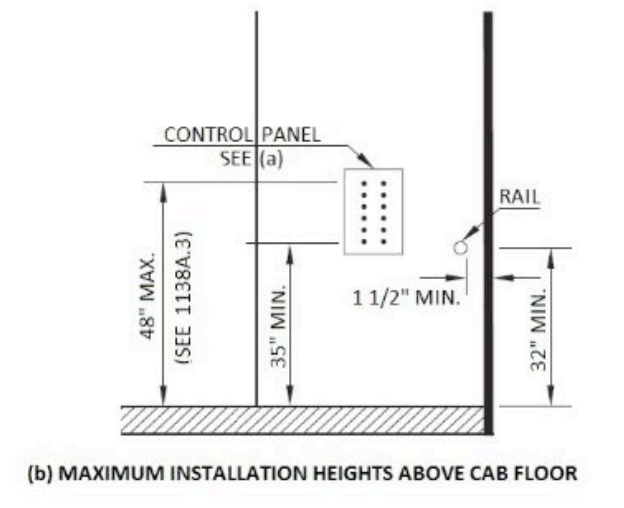


(b) MAXIMUM INSTALLATION HEIGHTS ABOVE CAB FLOOR

FIGURE 11A-7B
ELEVATOR CONTROL PANEL

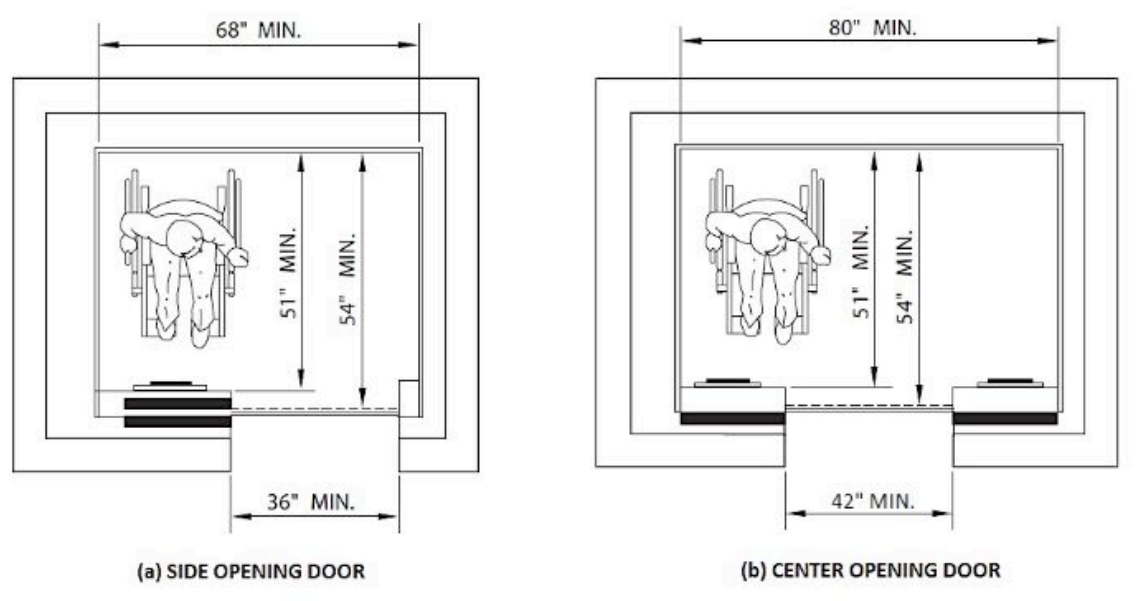

(a) SIDE OPENING DOOR

(b) CENTER OPENING DOOR

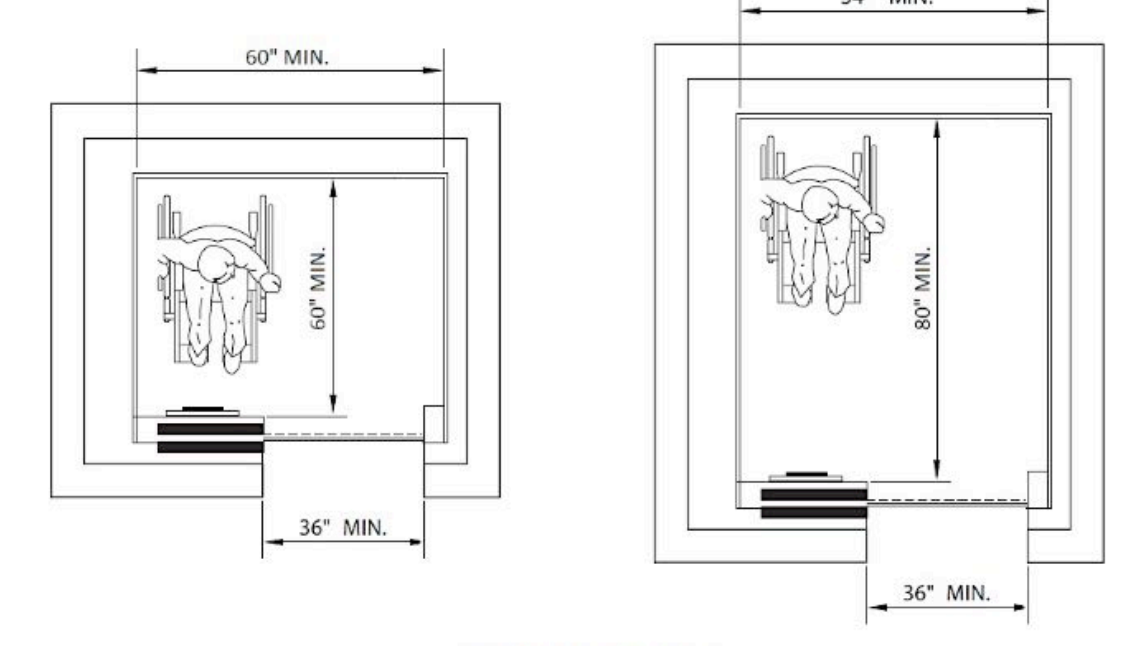

(c) DOOR AT ANY LOCATION

FIGURE 11A-7A
MINIMUM DIMENSIONS OF ELEVATOR CARS


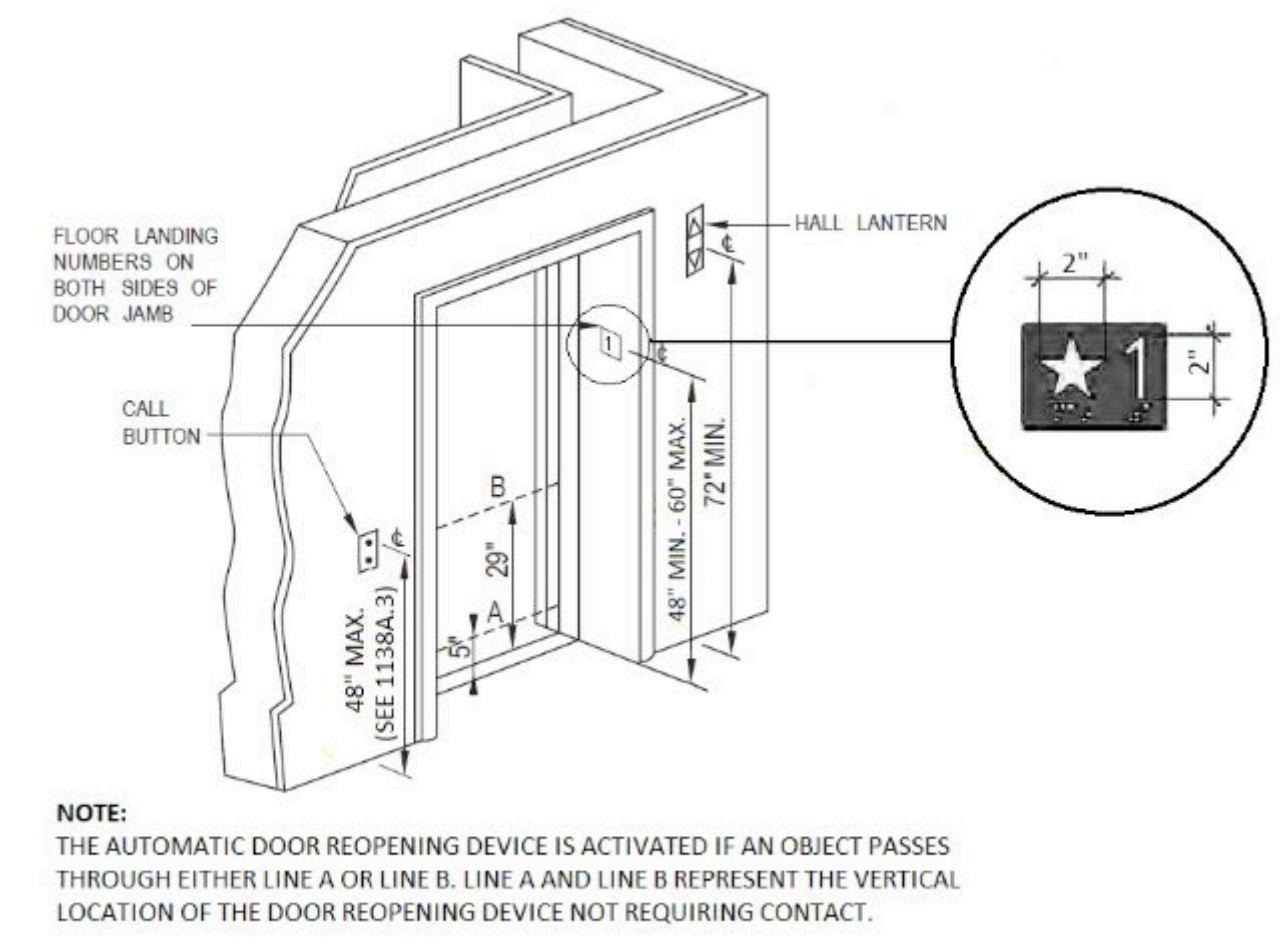



FIGURE 11A-7C
HOISTWAY AND ELEVATOR ENTRANCES

9 SEC. 1124A: ELEVATOR
N.T.S.

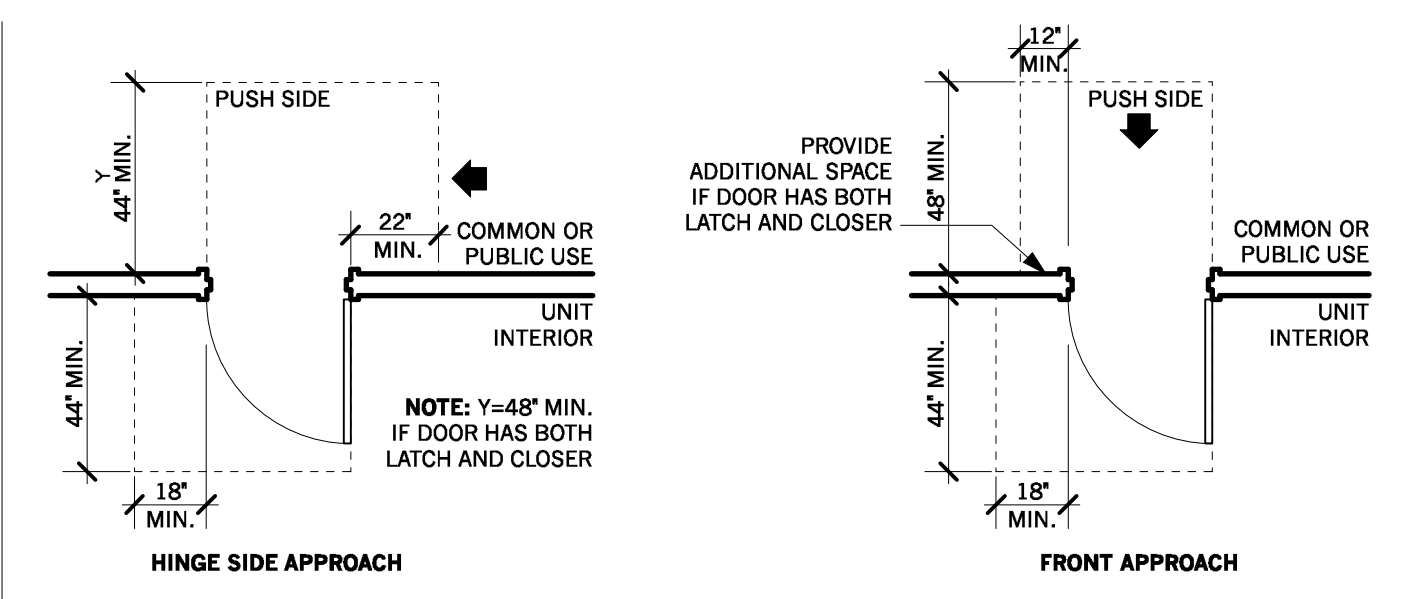


HINGE SIDE APPROACH

FRONT APPROACH

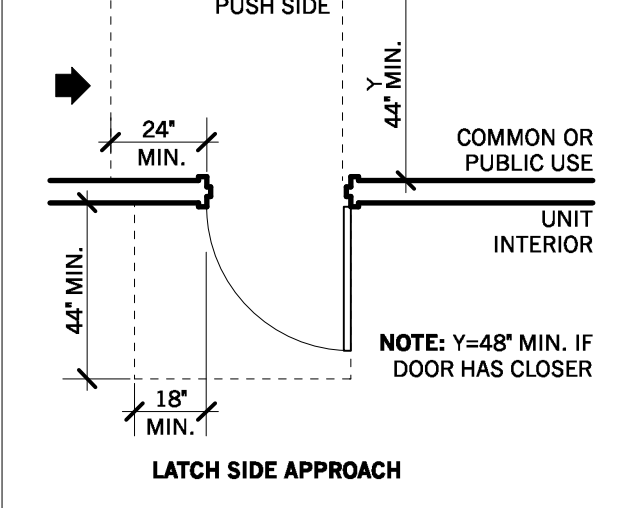

LATCH SIDE APPROACH

6 MANEUVERING CLEARANCE AT SWINGING DOORS
AT PRIMARY DWELLING UNIT ENTRY DOOR

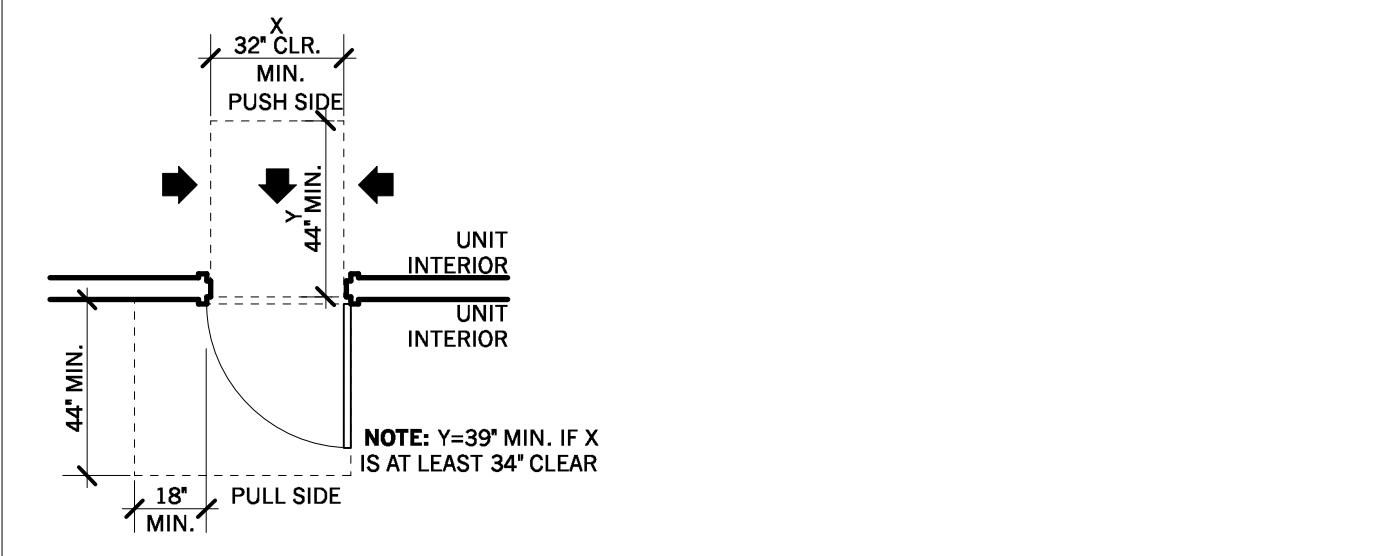

(a) SIDE APPROACH

(b) LATCH SIDE APPROACH

7 MANEUVERING CLEARANCE AT SWINGING DOORS
AT INTERIOR DOORS WITHIN INDIVIDUAL DWELLING UNIT

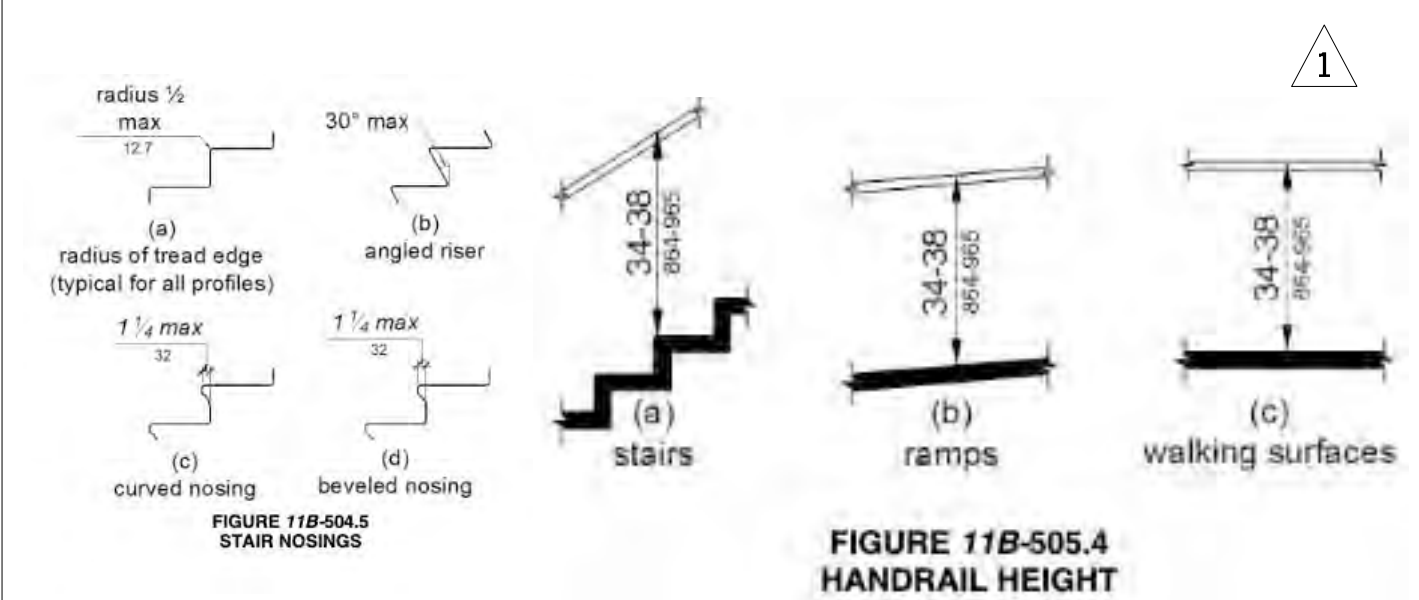


FIGURE 11B-504.5
STAIR NOSINGS

FIGURE 11B-505.4
HANDRAIL HEIGHT

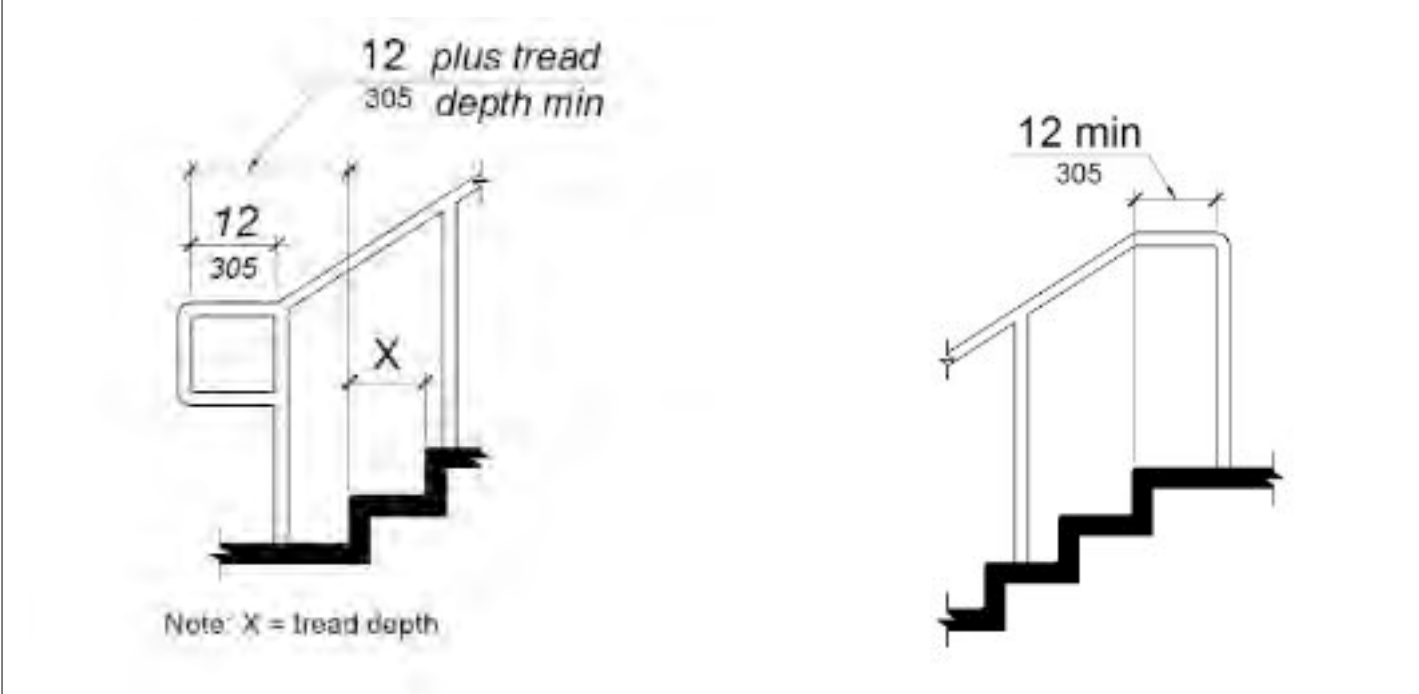


FIGURE 11B-505.10.3
BOTTOM HANDRAIL EXTENSION AT STAIRS

FIGURE 11B-505.10.2
TOP HANDRAIL EXTENSION AT STAIRS

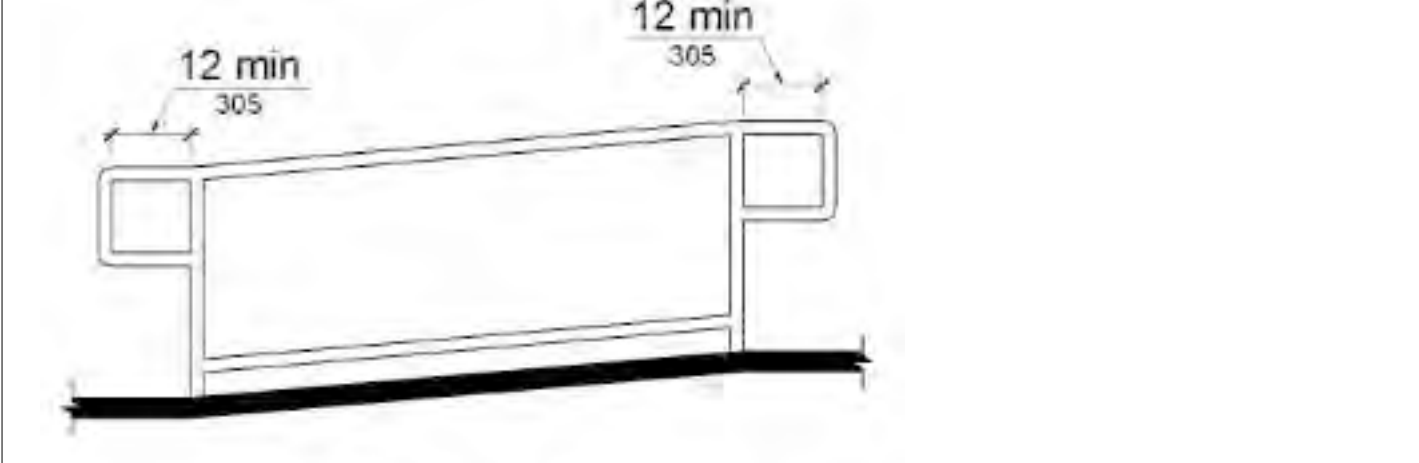


FIGURE 11B-505.10.1
TOP AND BOTTOM HANDRAIL EXTENSION AT RAMPS

8 STAIR AND RAMP REQUIREMENTS
N.T.S.

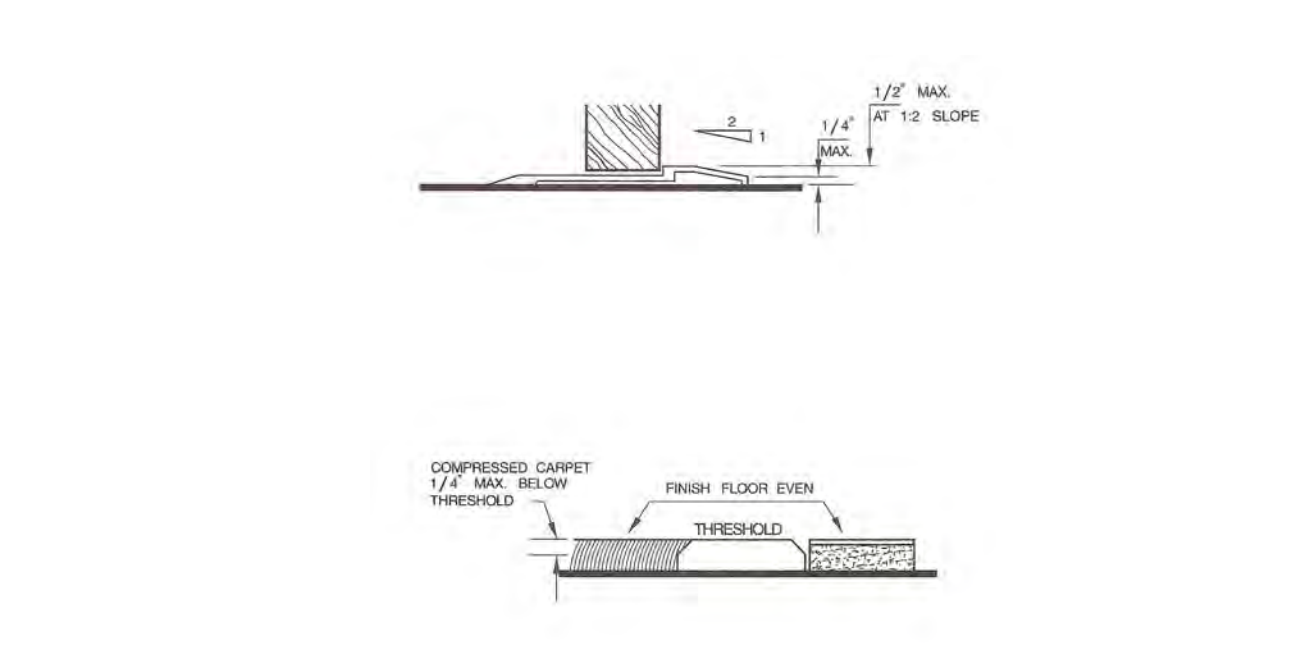


FIGURE 11B-503-THRESHOLDS

(a) VERTICAL CHANGE IN LEVEL

(b) BEVELED CHANGE IN LEVEL


FIGURE 11A-1F
CHANGE IN LEVEL

3 THRESHOLD STANDARDS
N.T.S.




FIGURE 11B-506-INTERNATIONAL ACCESSIBILITY SYMBOLS


4 ACCESSIBILITY SYMBOL
N.T.S.

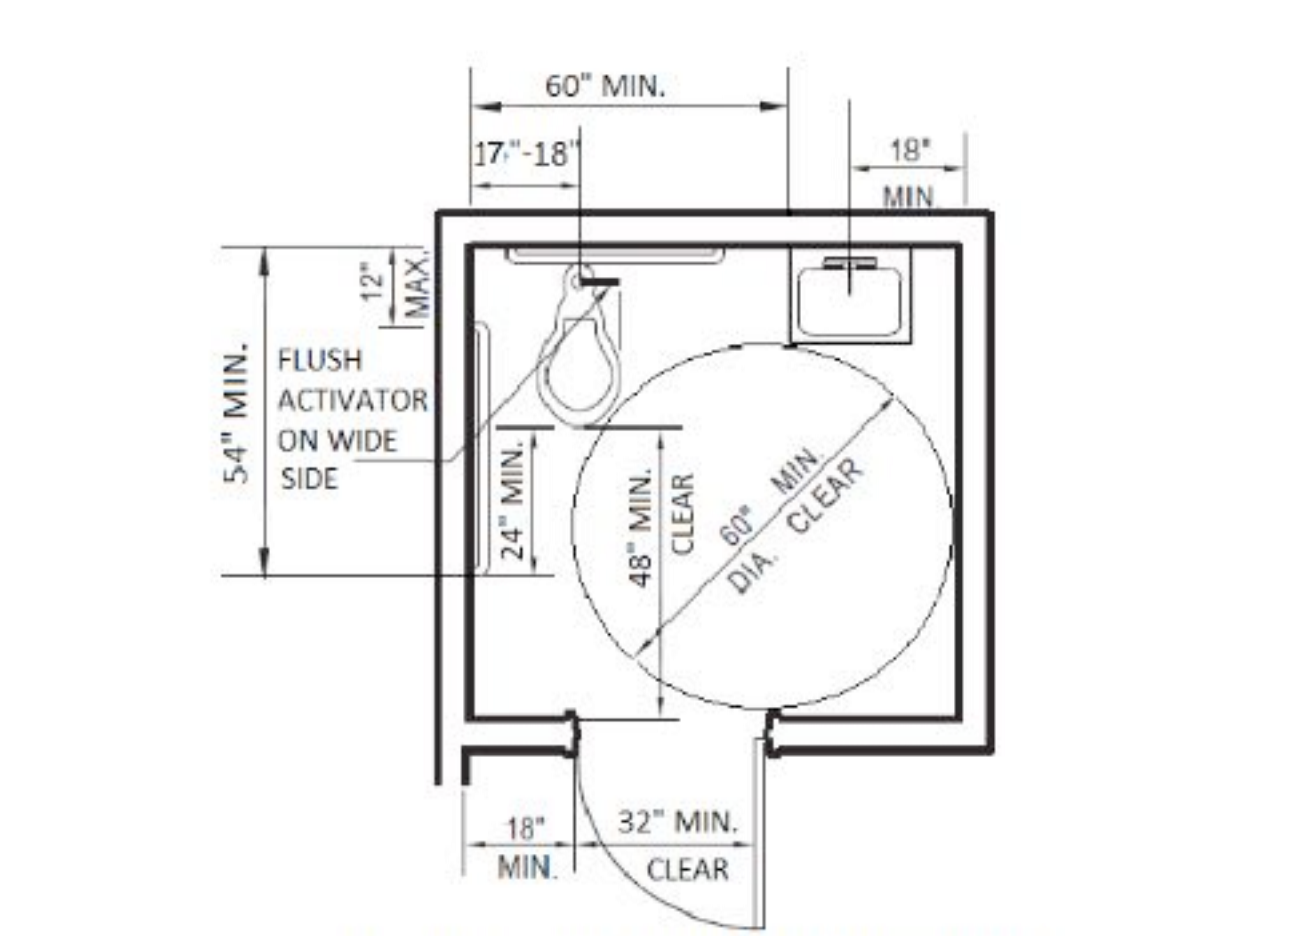


5 SINGLE ACCOMMODATION TOILET FACILITY
COMMON USE TOILET ROOM IN RESIDENTIAL PORTION OF BUILDING

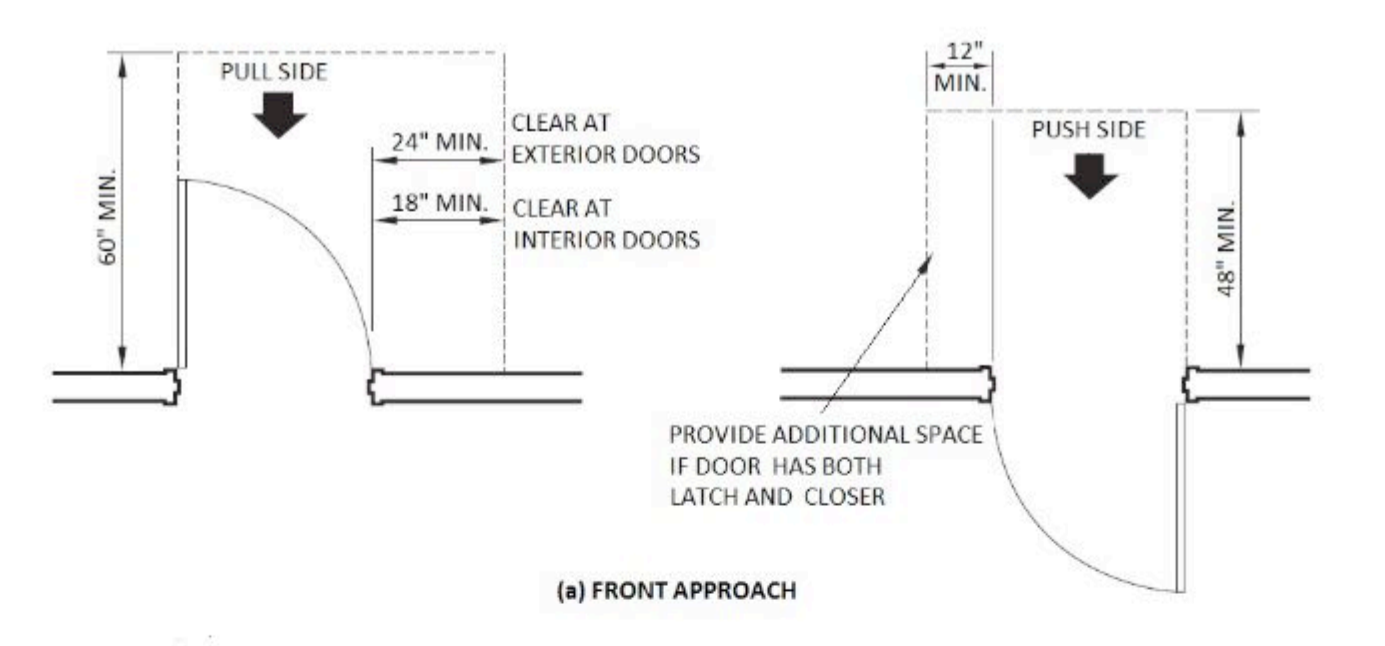

(a) FRONT APPROACH

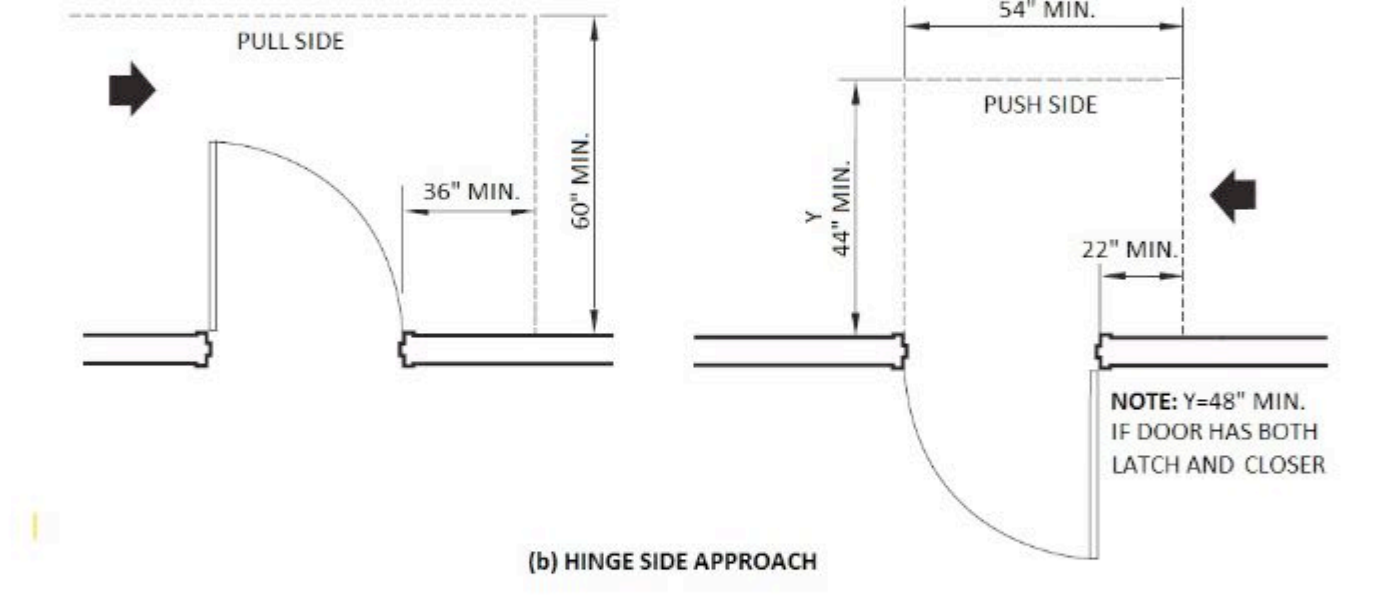


(b) HINGE SIDE APPROACH

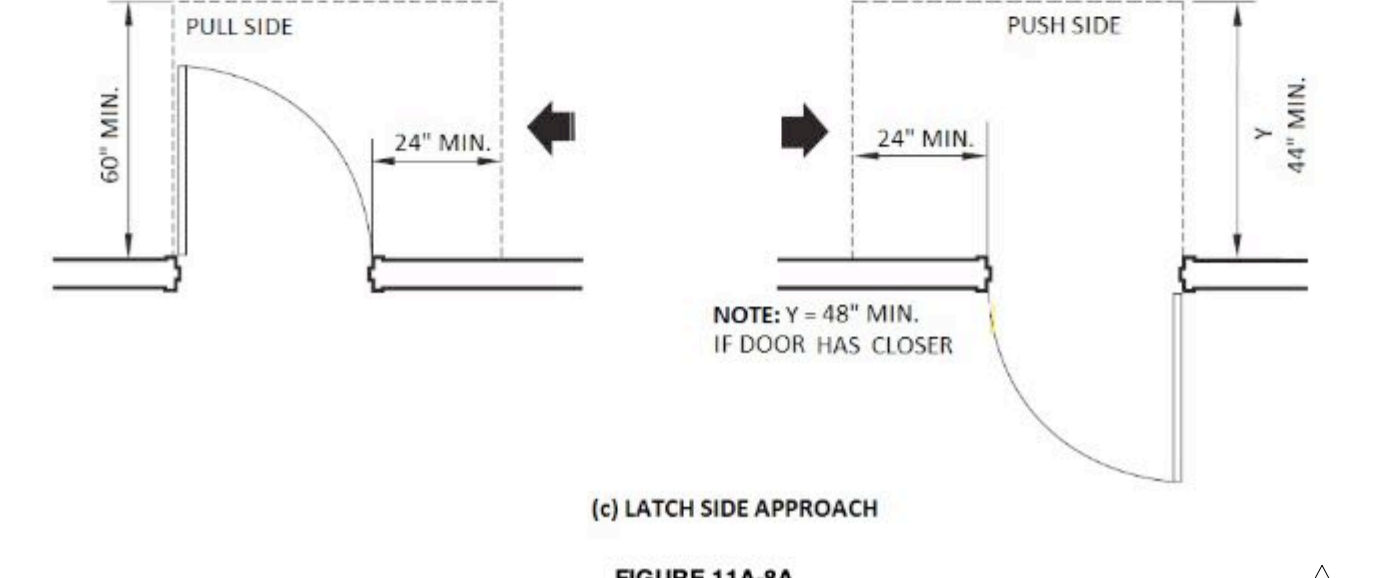

(c) LATCH SIDE APPROACH

FIGURE 11A-8A
MANEUVERING CLEARANCE AT SWINGING DOORS


1 MANEUVERING CLEARANCE AT SWINGING DOORS
AT COMMON USE AREAS OR COVERED MULTIFAMILY DWELLINGS

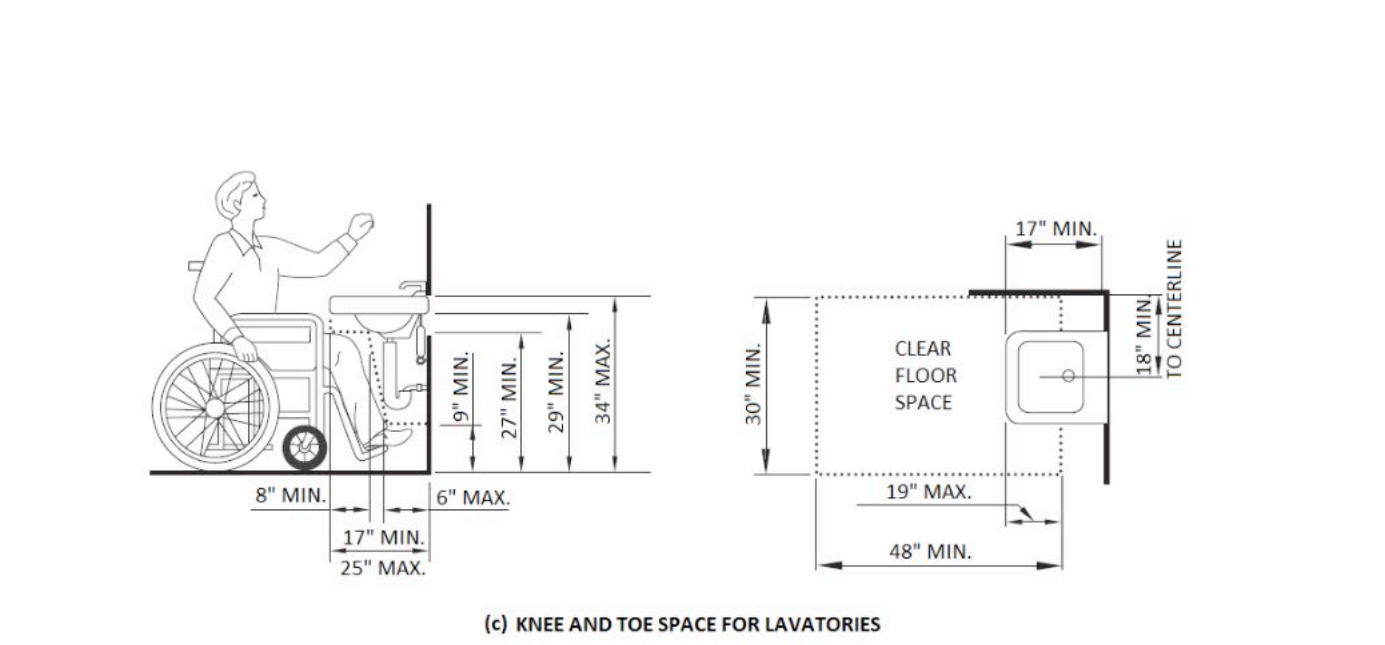


(c) KNEE AND TOE SPACE FOR LAVATORIES

FIGURE 11A-4D
KNEE AND TOE SPACE

2 KNEE AND TOE SPACE
N.T.S.

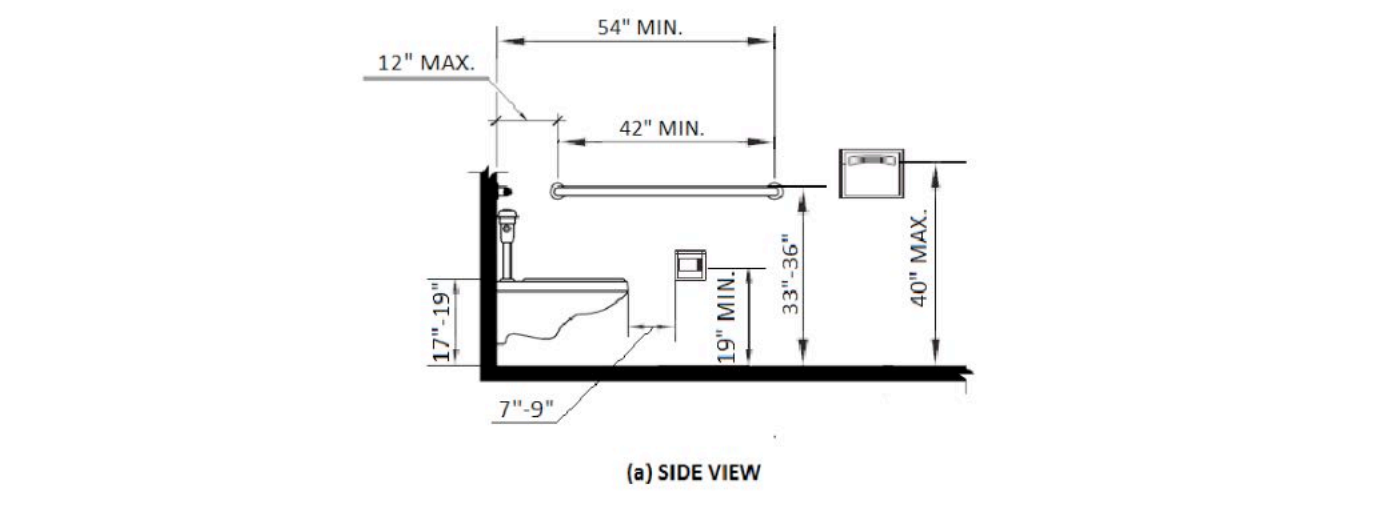

(a) SIDE VIEW

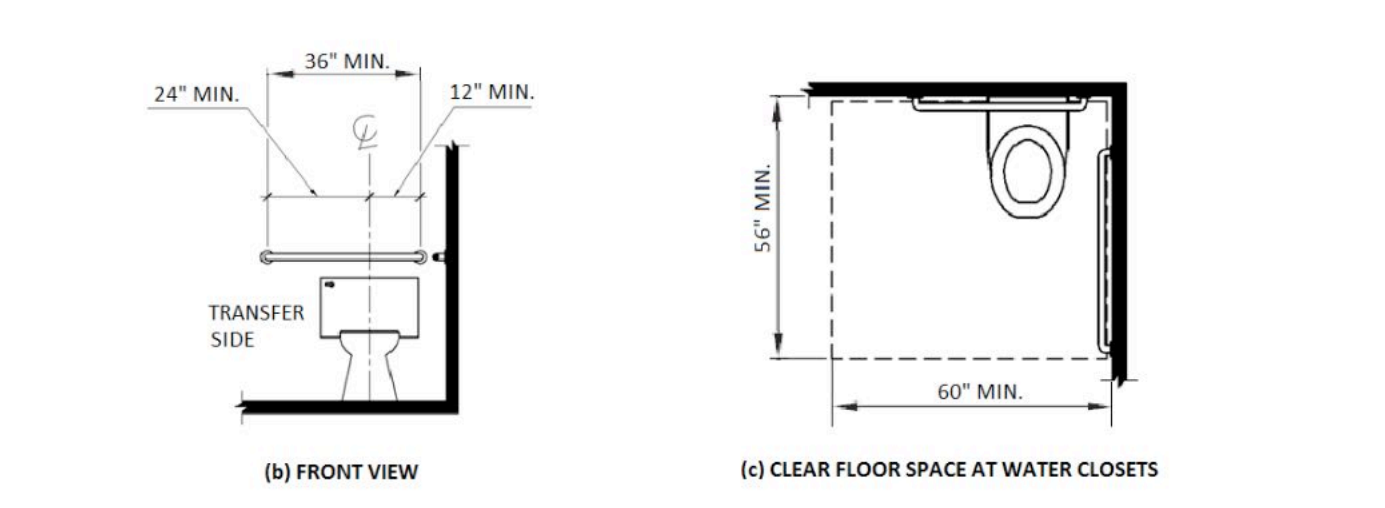

(b) FRONT VIEW

(c) CLEAR FLOOR SPACE AT WATER CLOSETS


3



ELEVATIONarchitects

1159 Green Street, Suite 4
San Francisco, CA 94109

415.537.1125 :v
www.elevationarchitects.com :w

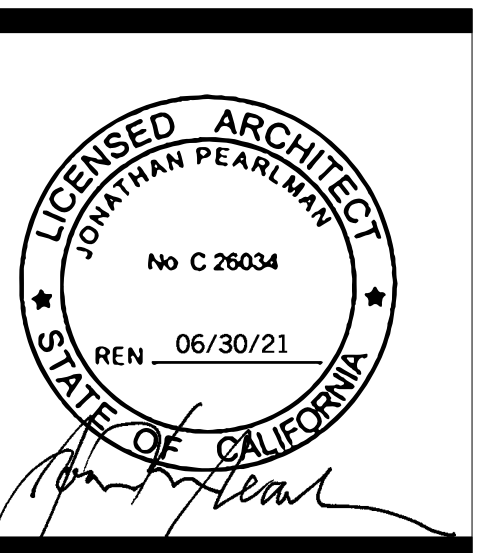

agency stamps:

Condominiums
42 Otis Street
San Francisco, CA 94103
Block / Lot : 3505 / 020

#	date	issue
	10.01.19	Addendum #2
1	1.28.20	Plan Check Response 1
2	4.15.20	Project Revision 2
3	4.27.20	Plan Check Response 2
4	8.17.20	Plan Check Response 3
sheet count		9/49


Accessibility Details

project: 16.15
drawn by: MKA
checked by: JP
date: 03.23.17
scale:


A-0.6



(a) GRAB BAR REINFORCEMENT FOR ADAPTABLE WATER CLOSETS

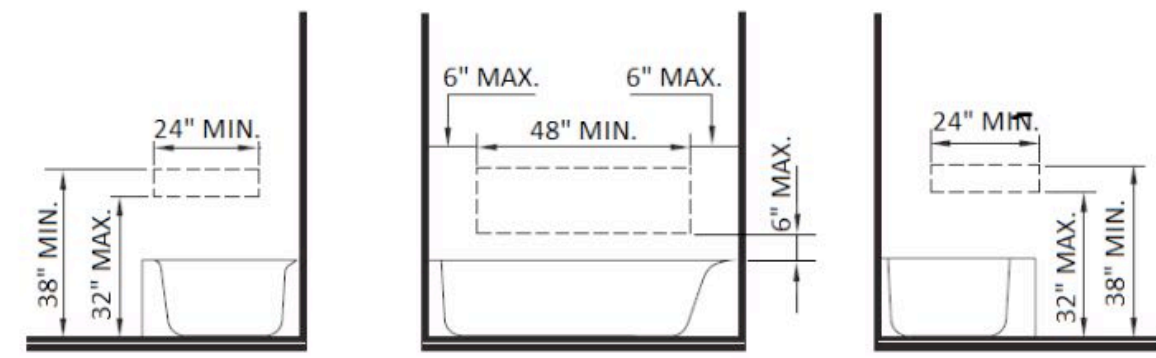

(b) GRAB BAR REINFORCEMENT FOR ADAPTABLE BATHTUBS

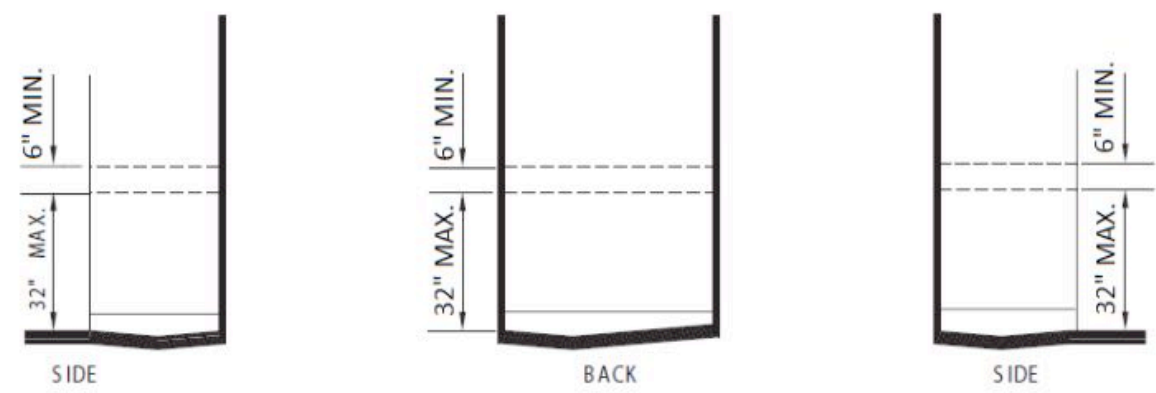


(c) GRAB BAR REINFORCEMENT FOR ADAPTABLE SHOWERS


AREAS OUTLINED IN DASHED LINES REPRESENT LOCATION FOR FUTURE INSTALLATION OF GRAB BARS

FIGURE 11A-9G
REINFORCEMENT FOR GRAB BARS


3 6 GRAB BAR REINFORCEMENT LOCATION
N.T.S.

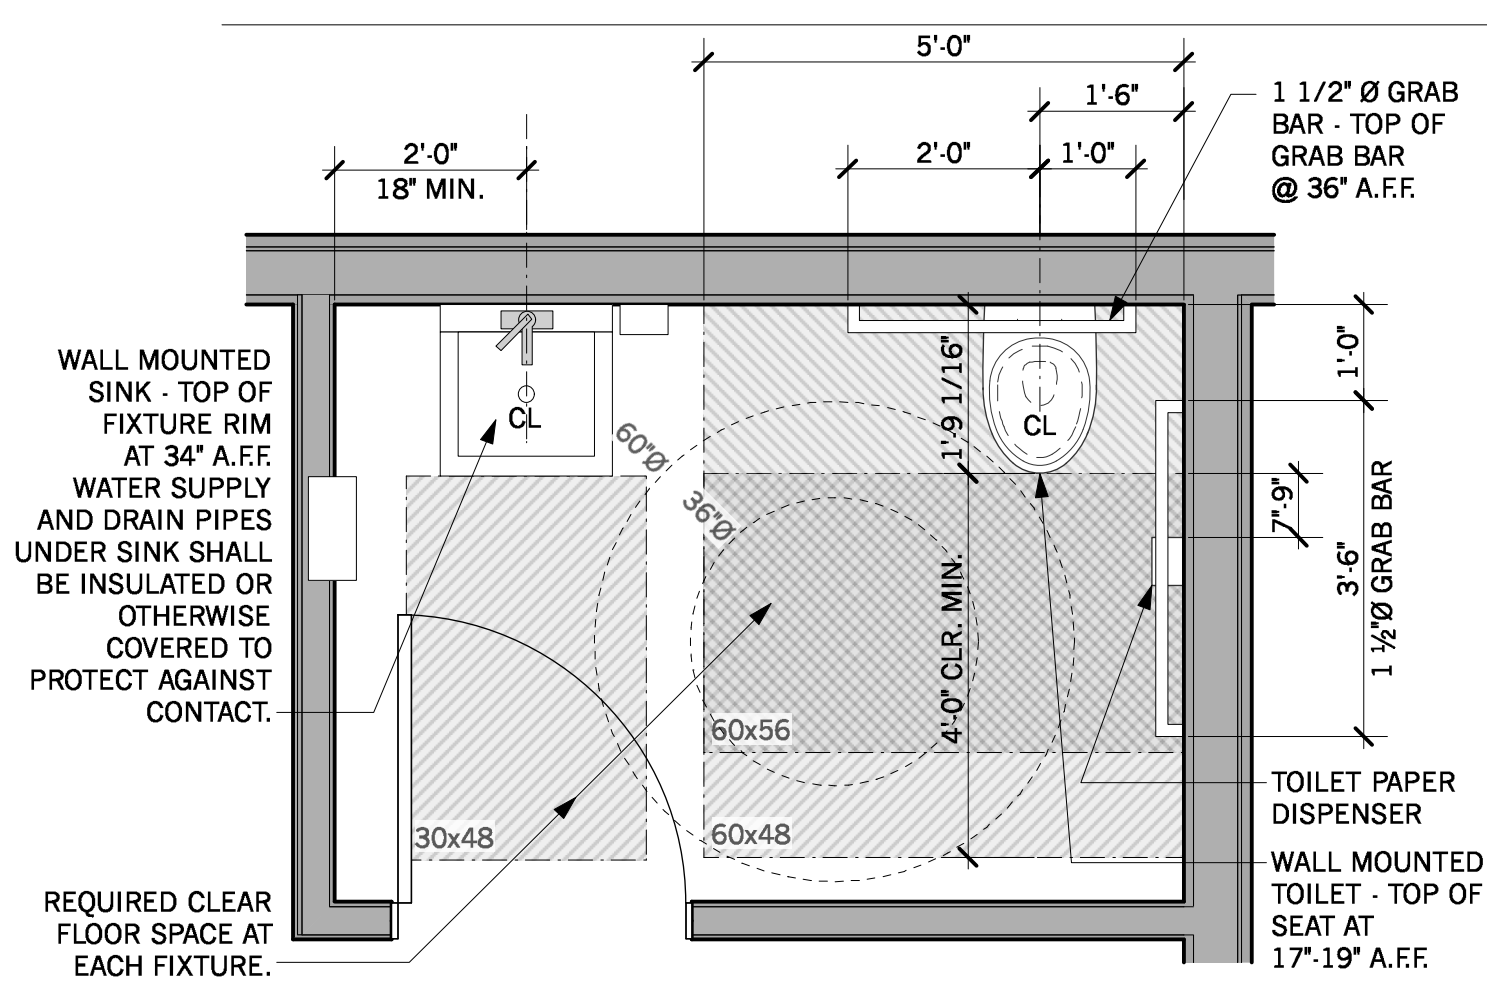

7 SINGLE-ACCOMMODATION TOILET FACILITY
Scale: 1/2" = 1'-0"

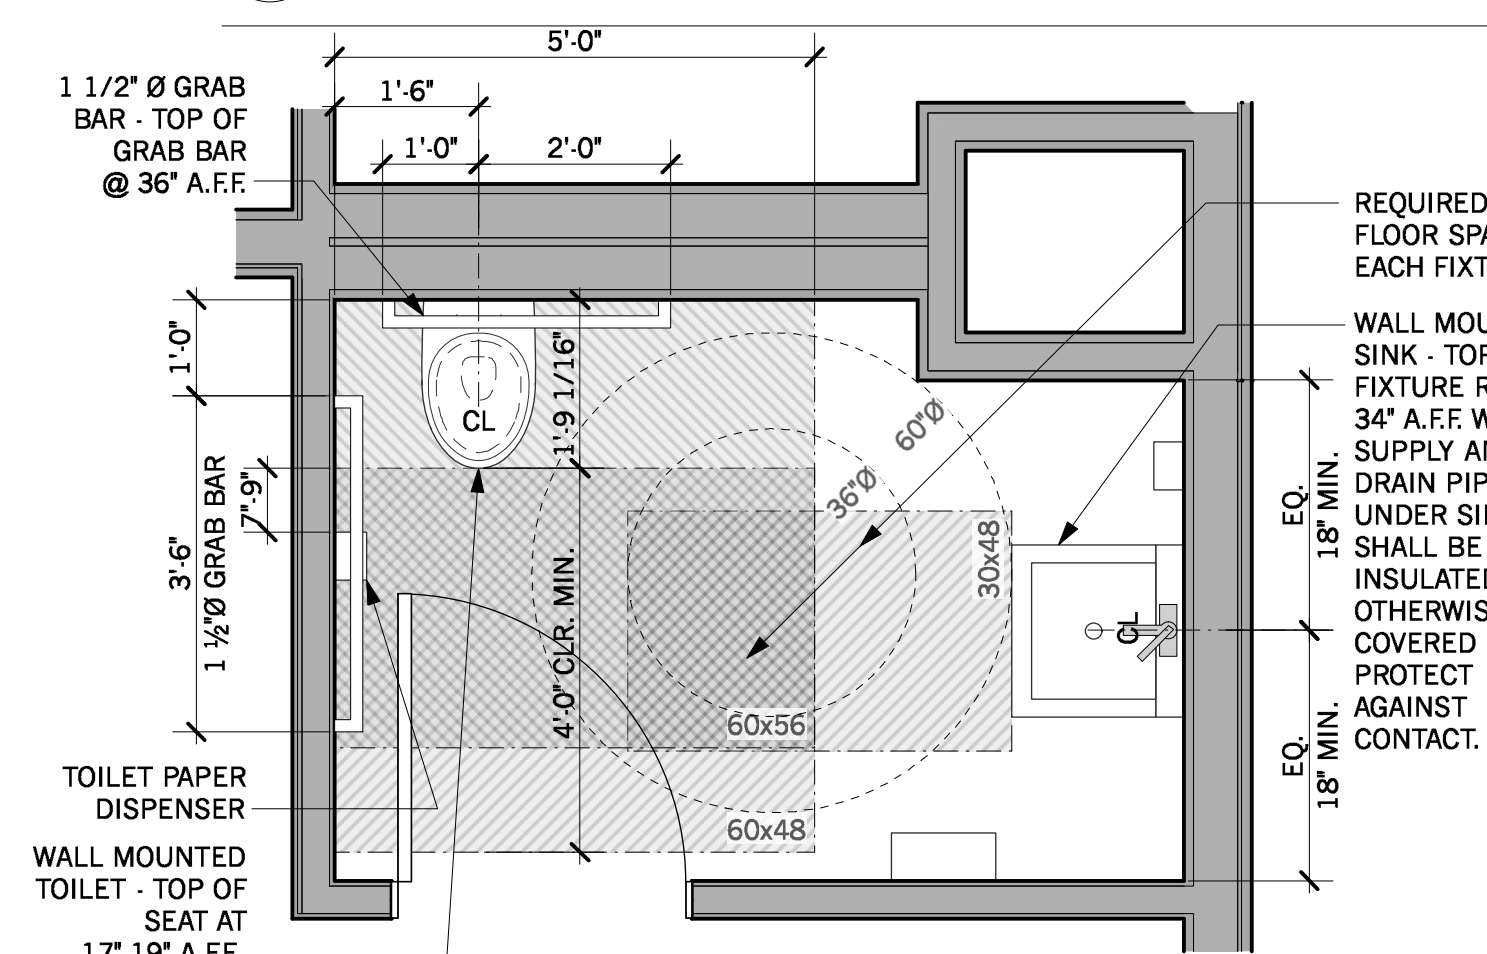


8 SINGLE-ACCOMMODATION TOILET FACILITY
Scale: 1/2" = 1'-0"

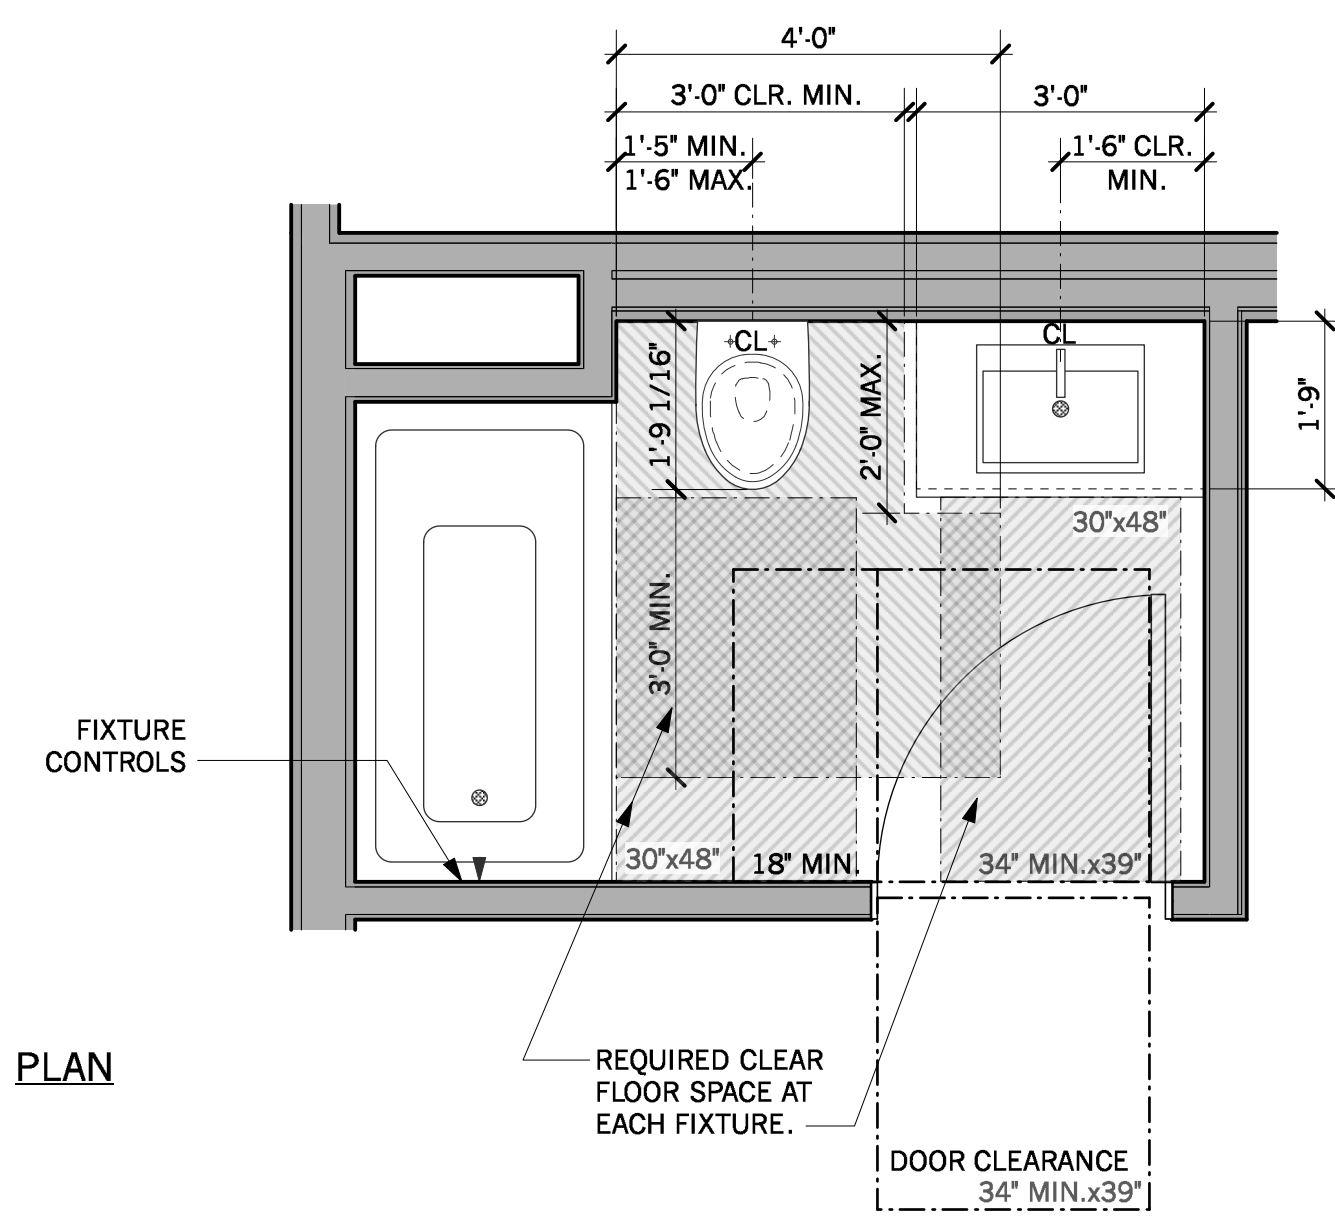

PLAN

NOTE: - SEE 6/A-Q.7 FOR BLOCKING FOR FUTURE GRAB BAR INSTALLATION.
- KNEE AND TOE SPACE AT THE LAVATORY SHALL BE PROVIDED BY ONE OF THE FOLLOWING:
1. THE SPACE BENEATH THE LAVATORY SHALL BE LEFT CLEAR AND UNOBSTRUCTED.
2. ANY CABINET BENEATH THE LAVATORY SHALL BE REMOVABLE WITHOUT THE USE OF SPECIALIZED KNOWLEDGE OR SPECIALIZED TOOLS; OR
3. DOORS TO THE CABINET BENEATH THE LAVATORY SHALL BE REMOVABLE OR OPENABLE TO PROVIDE THE REQUIRED UNOBSTRUCTED KNEE AND TOE SPACE.
- THE FINISHED FLOOR BENEATH THE LAVATORY SHALL EXTEND TO THE WALL.
- WATER SUPPLY AND DRAIN PIPES UNDER LAVATORIES SHALL BE INSULATED OR OTHERWISE COVERED TO PROTECT AGAINST CONTACT. THERE SHALL BE NO SHARP OR ABRASIVE SURFACES UNDER LAVATORIES.


4 TYPICAL UNIT BATHROOM
Scale: 1/2" = 1'-0"

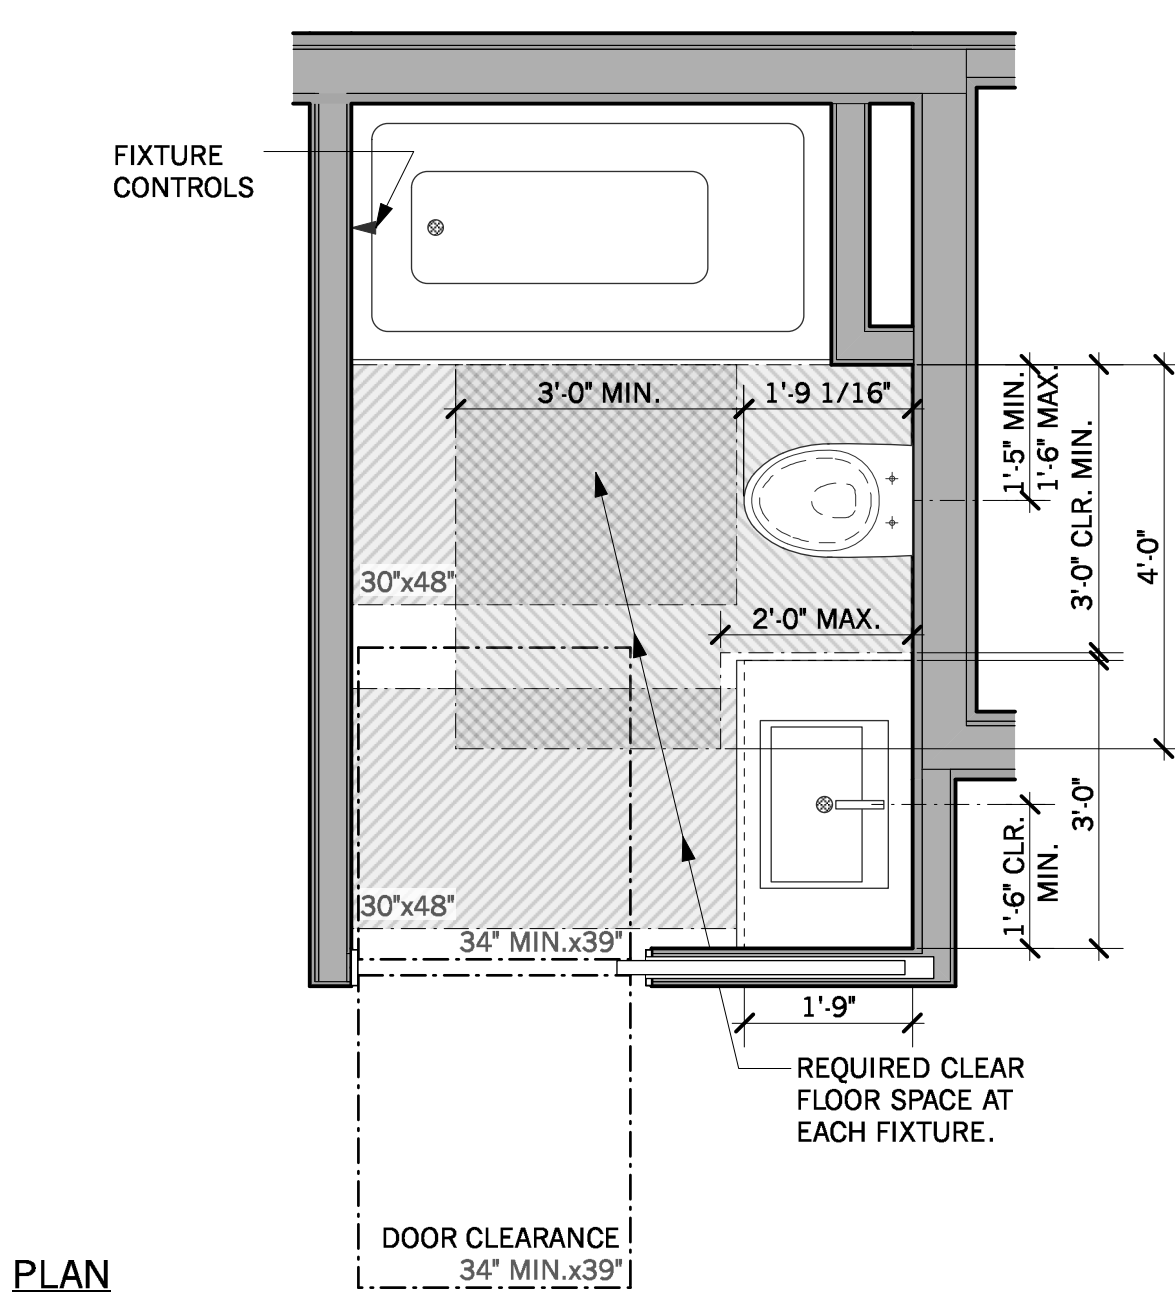

PLAN


NOTE: - SEE 6/A-Q.7 FOR BLOCKING FOR FUTURE GRAB BAR INSTALLATION.
- KNEE AND TOE SPACE AT THE LAVATORY SHALL BE PROVIDED BY ONE OF THE FOLLOWING:
1. THE SPACE BENEATH THE LAVATORY SHALL BE LEFT CLEAR AND UNOBSTRUCTED.
2. ANY CABINET BENEATH THE LAVATORY SHALL BE REMOVABLE WITHOUT THE USE OF SPECIALIZED KNOWLEDGE OR SPECIALIZED TOOLS; OR
3. DOORS TO THE CABINET BENEATH THE LAVATORY SHALL BE REMOVABLE OR OPENABLE TO PROVIDE THE REQUIRED UNOBSTRUCTED KNEE AND TOE SPACE.
- THE FINISHED FLOOR BENEATH THE LAVATORY SHALL EXTEND TO THE WALL.
- WATER SUPPLY AND DRAIN PIPES UNDER LAVATORIES SHALL BE INSULATED OR OTHERWISE COVERED TO PROTECT AGAINST CONTACT. THERE SHALL BE NO SHARP OR ABRASIVE SURFACES UNDER LAVATORIES.

5 TYPICAL UNIT BATHROOM
Scale: 1/2" = 1'-0"

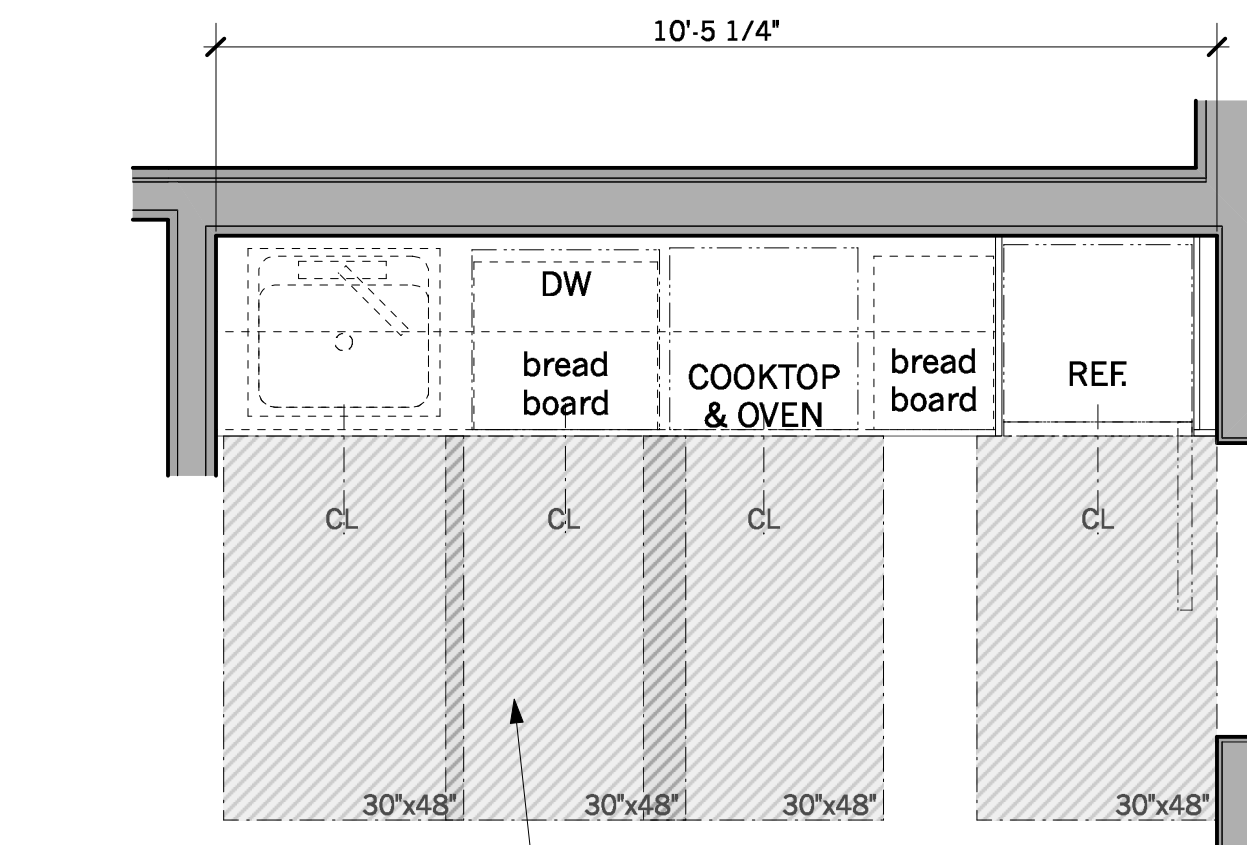

PLAN


30"x48" CLEAR FLOOR SPACE CENTERED ON EACH APPLIANCE AND FIXTURE.

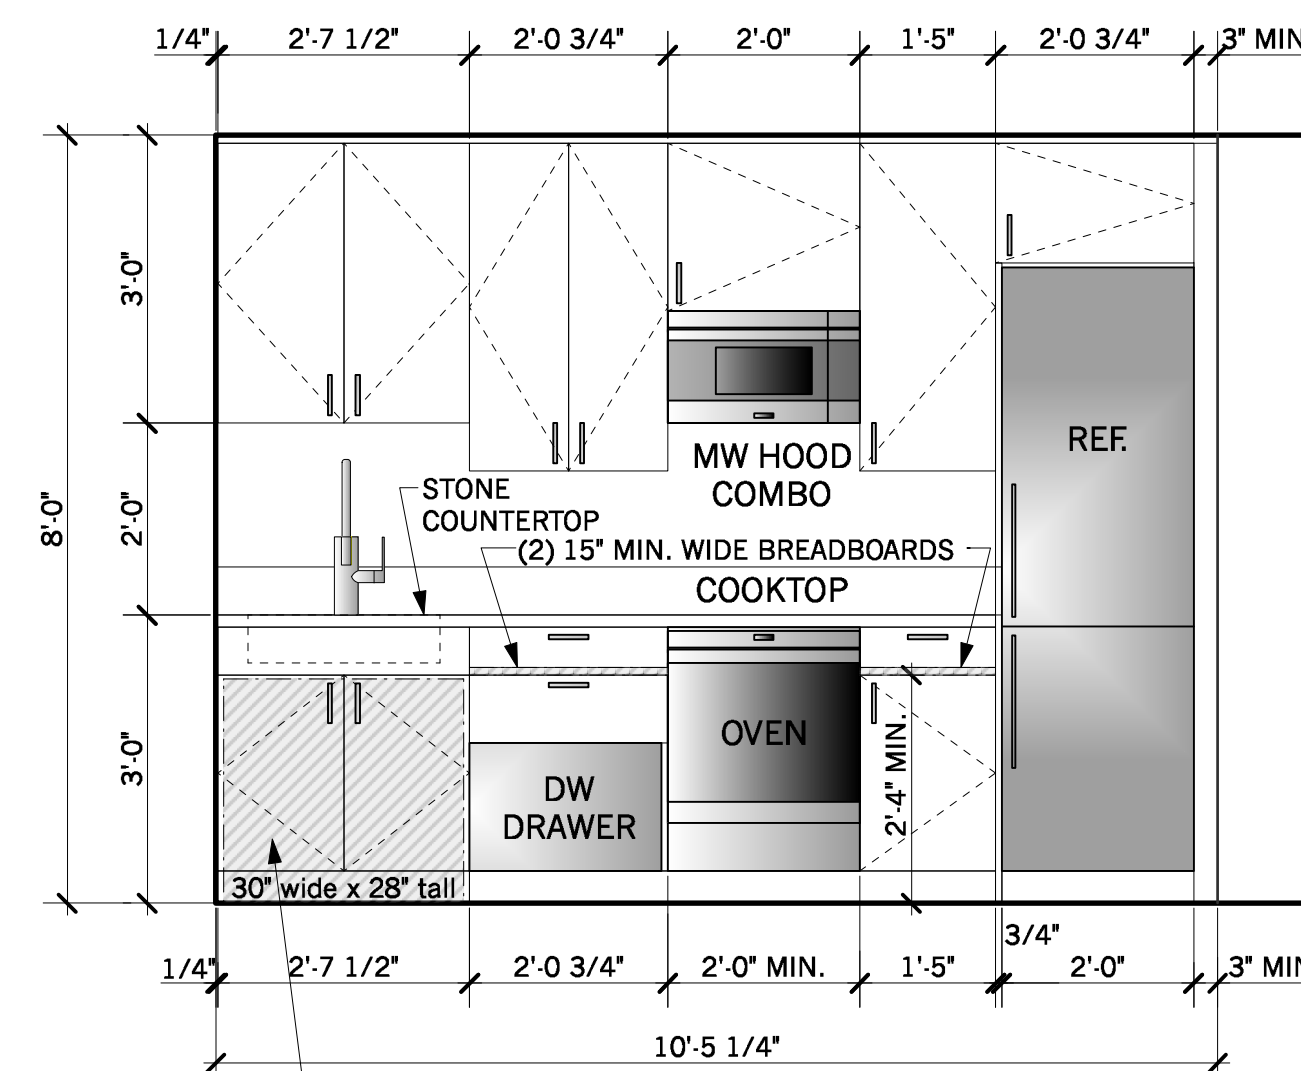

ELEVATION


BASE CABINETS (INCLUDING TOEBOARD AND SHELVING) DIRECTLY UNDER KITCHEN SINK SHALL BE REMOVABLE WITHOUT THE USE OF SPECIALIZED TOOLS OR KNOWLEDGE IN ORDER TO PROVIDE KNEE AND TOE SPACE. THE FINISH FLOOR BENEATH KITCHEN SINK SHALL BE EXTENDED TO THE WALL. WATER SUPPLY AND DRAIN PIPES UNDER SINKS SHALL BE INSULATED OR OTHERWISE COVERED TO PROTECT AGAINST CONTACT. THERE SHALL BE NO SHARP OR ABRASIVE SURFACES UNDER SINKS.

3 TYPICAL UNIT KITCHEN TYPE #2
Scale: 1/2" = 1'-0"

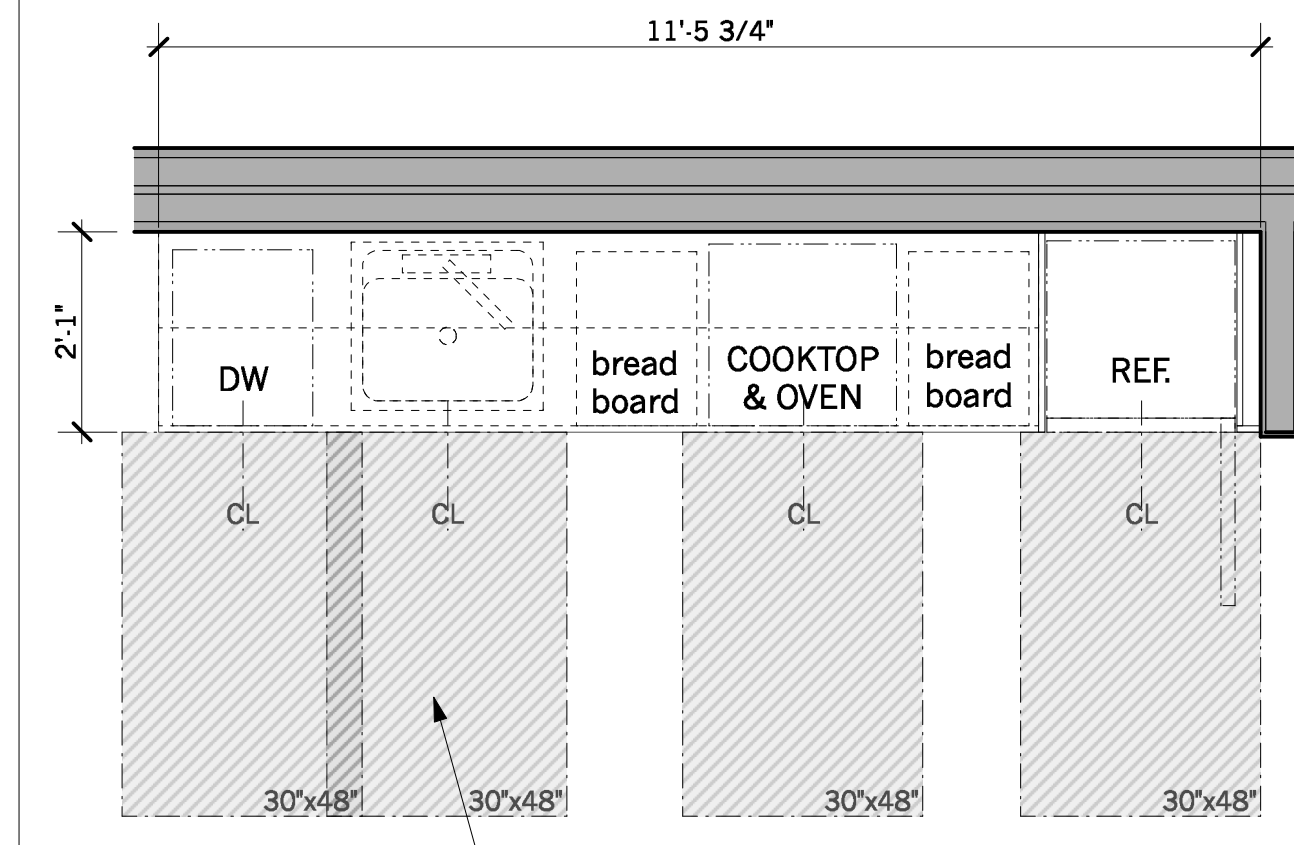

PLAN


30"x48" CLEAR FLOOR SPACE CENTERED ON EACH APPLIANCE AND FIXTURE.

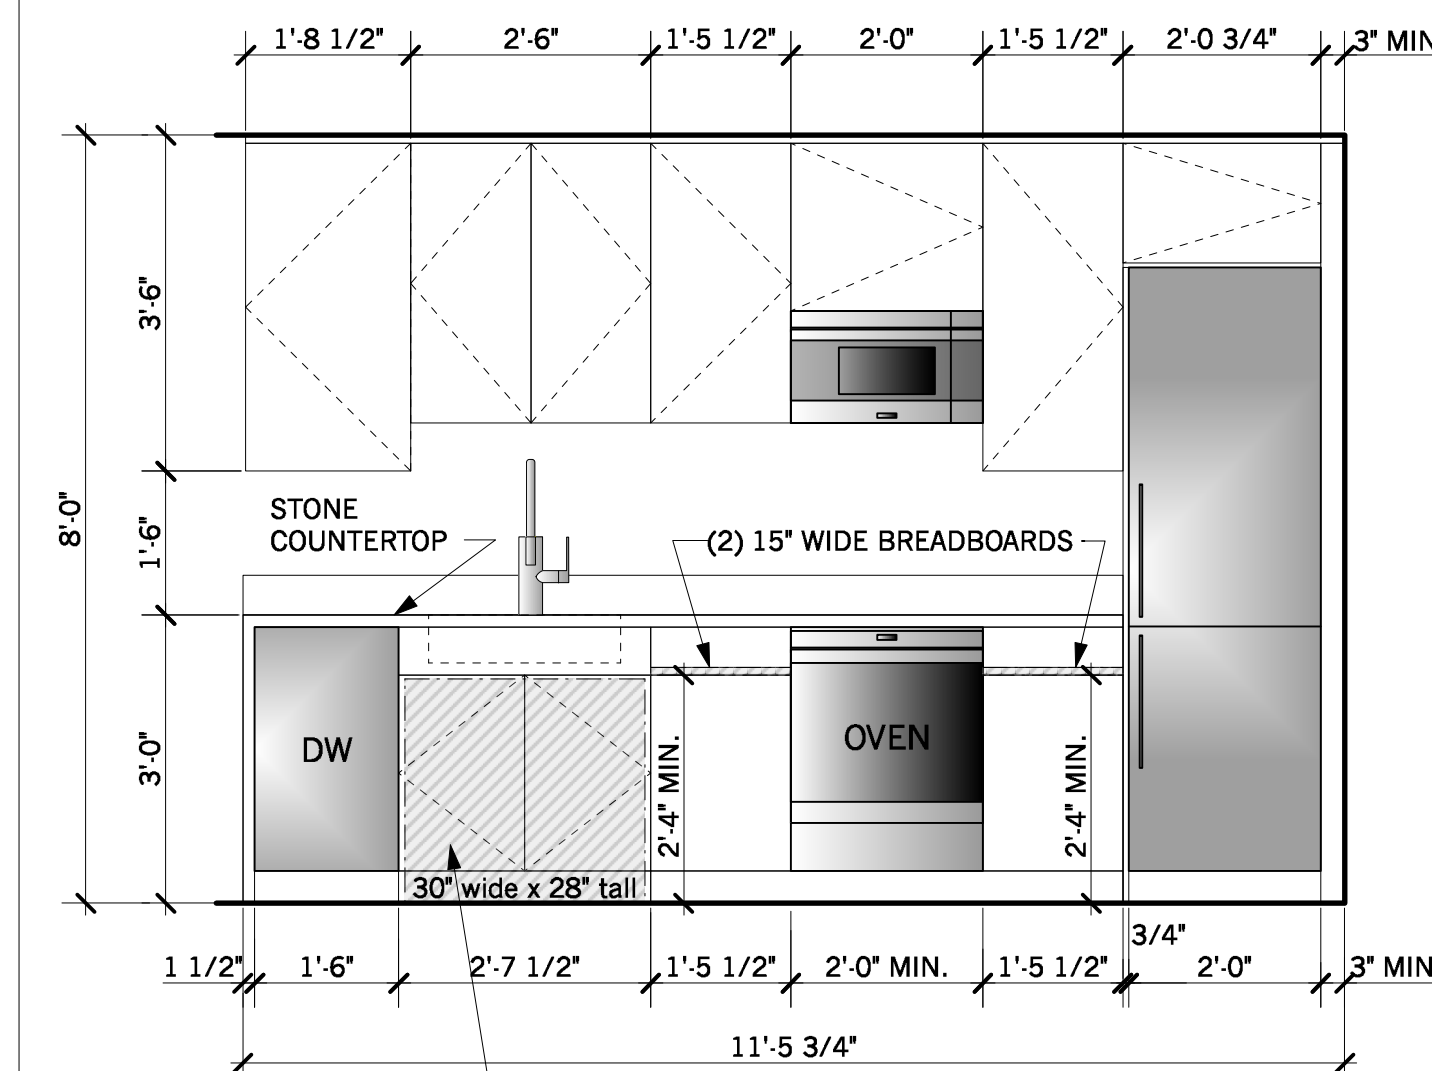

ELEVATION

BASE CABINETS (INCLUDING TOEBOARD AND SHELVING) DIRECTLY UNDER KITCHEN SINK SHALL BE REMOVABLE WITHOUT THE USE OF SPECIALIZED TOOLS OR KNOWLEDGE IN ORDER TO PROVIDE KNEE AND TOE SPACE. THE FINISH FLOOR BENEATH KITCHEN SINK SHALL BE EXTENDED TO THE WALL. WATER SUPPLY AND DRAIN PIPES UNDER SINKS SHALL BE INSULATED OR OTHERWISE COVERED TO PROTECT AGAINST CONTACT. THERE SHALL BE NO SHARP OR ABRASIVE SURFACES UNDER SINKS.


1 TYPICAL UNIT KITCHEN TYPE #1
Scale: 1/2" = 1'-0"

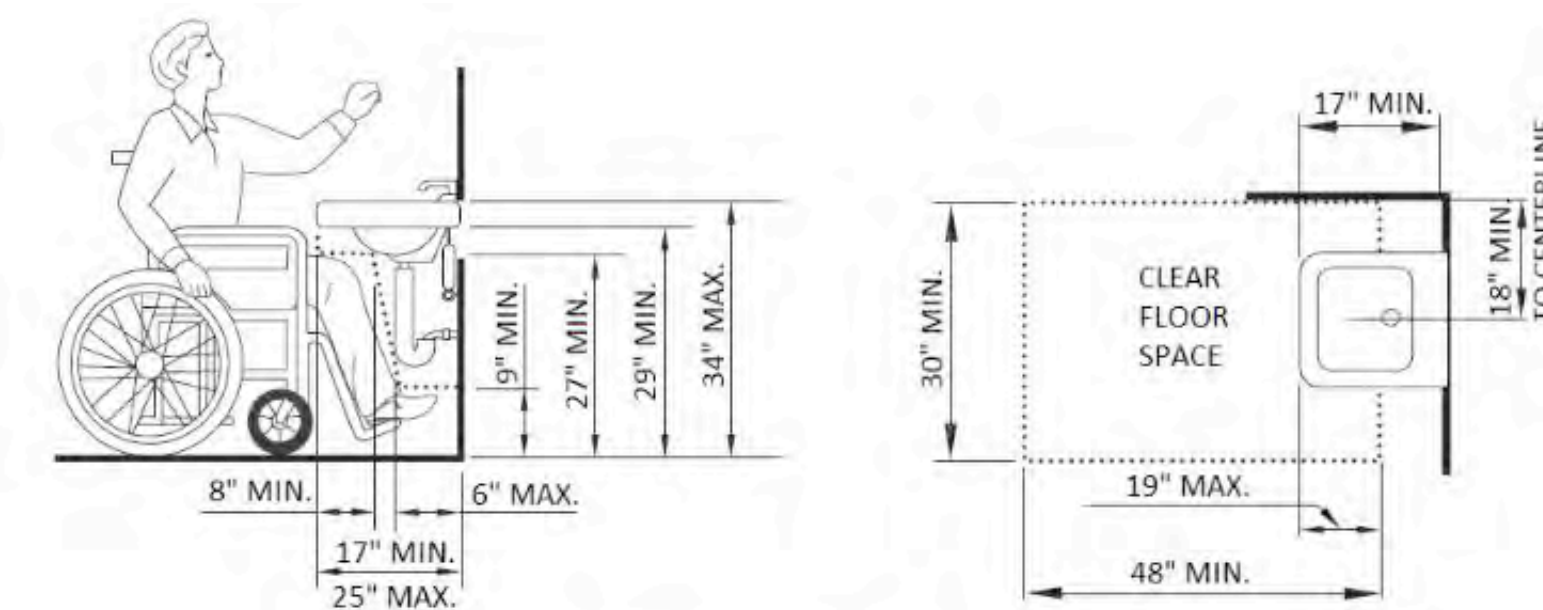

(c) KNEE AND TOE SPACE FOR LAVATORIES

FIGURE 11A-9D
KNEE AND TOE SPACE

2 KNEE AND TOE SPACE REQUIREMENTS AT LAVATORIES
N.T.S.

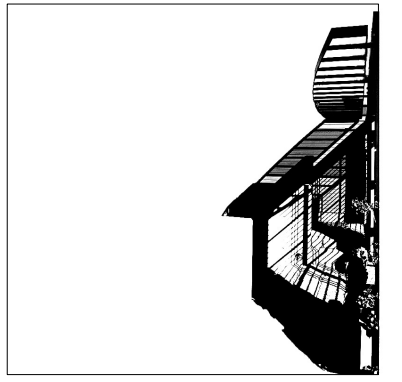

Elevationarchitects
1159 Green Street, Suite 4
San Francisco, CA 94109

415.537.1125 :v
www.elevationarchitects.com :w



agency stamps:


Condominiums
42 Otis Street
San Francisco, CA 94103
Block / Lot : 3505 / 020

#	date	issue
	10.01.19	Addendum #2
1	1.28.20	Plan Check Response 1
2	4.15.20	Project Revision 2
3	4.27.20	Plan Check Response 2
4	8.17.20	Plan Check Response 3
sheet count		10/49

Accessibility Details **3**

project: 16.15
drawn by: MKA
checked by: JP
date: 03.23.17
scale:

A-0.7

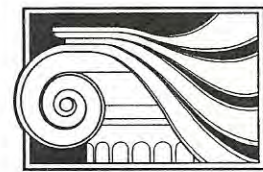

12 May 2019

Ms. Svetlana Fickes
March Capital Management, LLC
3456 Sacramento Street
San Francisco, CA 94118

Subject: Acoustical Evaluation
Compliance with Acoustical Code Requirements
42 Otis Street
San Francisco, CA

Dear Ms. Fickes:

Summarized below is the acoustical evaluation for the new multi-family residential project at 42 Otis Street in San Francisco. The purpose of this evaluation is to determine compliance with the acoustical requirements of both the City of San Francisco Building Code (Section 1207) and the California Building Code (Section 1207.4) for interior noise exposure levels due to exterior noise sources impacting the building as well as sound isolation between adjacent residential units. This evaluation is based on our review of the Site Permit Rev. 1 architectural drawings, dated 1 April 2019, prepared by Elevation Architects.

PROJECT INFORMATION: This is a five-story residential building containing 24 SRO (Single Room Occupancy) units on the 2nd through 5th Floors with commercial and common spaces at the 1st and 2nd Floors. The project site is located on the north side of Otis Street between Brady and 12th Streets. This area is a typical urban environment and the primary source of exterior noise impacting the site is vehicular traffic on the surrounding streets.

EXTERIOR SOUND ISOLATION

EXTERIOR NOISE DESIGN STANDARDS: The general acoustical design requirements of the City of San Francisco and the California Building Code specify that the interior noise exposure level in any habitable space of a multi-family residential project not exceed a Day-Night Average Sound Level (L_{dn}) of 45 dBA where the exterior noise exposure level is greater than (L_{dn}) of 60 dBA.

GENERAL INFORMATION ON ENVIRONMENTAL NOISE: The standard method used to quantify environmental noise involves evaluation of the sound with an adjustment to reflect the fact that human hearing is less sensitive to lower sound frequencies than to the mid and high frequencies. This measurement adjustment is called "A" weighting and the data are reported as A-weighted sound levels (dBA). The A-weighting scale causes the measurement instrumentation to respond to sound in a manner closely correlated with the subjective response of the average person. Community noise is always measured in A-weighted decibels (dBA).

Environmental noise also fluctuates in level over time. Therefore time-averaged sound levels are used to quantify noise levels and determine noise impacts. The most commonly used environmental noise exposure descriptor is the annual Day-Night Average Sound Level (L_{dn}). The cumulative noise exposure at a site, in terms of L_{dn} , represents the steady noise level that contains the same total sound energy as the fluctuating

2

community noise levels during an average 24-hour period and is adjusted to account for the higher sensitivity of people to noise during the evening and nighttime periods.

MEASURED NOISE ENVIRONMENT AT SITE: As indicated, the primary noise source impacting this site is vehicular traffic on the surrounding streets, with some additional contribution from activities in the surrounding community. To determine the existing noise exposure levels at the site, a noise survey was conducted continuously over a five-day period between Wednesday (10 April 2019) and Sunday (14 April 2019). The measurements were completed in front of the project site on Otis Street. The noise survey included both weekdays and weekend days. The daily noise exposure levels measured at the site, in terms of the Day-Night Average Sound Level (L_{dn}), are tabulated below and also indicated on the attached Summary Sheet. As shown, the noise exposure impact at this site was very consistent over the entire measurement period.

Measured Daily Noise Exposure Levels (L_{dn}) On Otis Street		
Wednesday	10 Apr 2019	73.7 dBA
Thursday	11 Apr 2019	73.7 dBA
Friday	12 Apr 2019	73.3 dBA
Saturday	13 Apr 2019	72.4 dBA
Sunday	14 Apr 2019	71.0 dBA
Average Level		72.8 dBA

The time-histories of the sound levels, including statistical and L_{max} levels, measured in 15-minute intervals, are plotted on the attached Figures 1 through 5. The sound data on these Figures are also reported in terms of the Statistical or Percentile Exceeded Sound Level (L_{xx}). These standard statistical sound level descriptors, such as L_{90} , L_{50} , L_{10} , are used to indicate sound levels that are exceeded 90, 50, 10 percent of the time, respectively. L_{90} is typically considered to represent of the background or ambient sound level at the site.

The standards require that potential future increases in noise levels due to increases in traffic volume be included in the noise exposure evaluation. The noise exposure increase typically used for this type of project is a 10% increase over a ten-year period. Based on this standard procedure the future noise exposure levels impacting the building have been projected and used to determine the required sound rating for the exterior building assemblies.

EXTERIOR NOISE MITIGATION: As indicated above, the codes require that the interior noise exposure level in any habitable space of the residential units not exceed 45 dBA from exterior noise sources. To achieve this interior level requires that the exterior building shell provide a minimum Noise Reduction (NR) based on the projected exterior noise levels. Note that Noise Reduction is not the same as the Sound Transmission Class (STC) rating. A review of the exterior wall assemblies and window units shown on the architectural drawings has been completed to determine compliance with the required minimum degree of exterior sound isolation. Based on the measured and projected exterior noise levels, the minimum STC ratings for the exterior building shell are:

Minimum Exterior Sound Isolating Requirements Of Exterior Building Shell for Habitable Spaces of Residential Units	
Front Half of Building (Closest to Otis Street)	STC 35
Rear Half of Building	STC 30

These minimum sound ratings apply to the habitable spaces of the residential units at all floor levels.

3

REVIEW OF EXTERIOR BUILDING ASSEMBLIES: A review of the exterior building assemblies shown on the architectural drawings has been completed. These have been evaluated to determine compliance with the required minimum degree of exterior sound isolation. The three exterior wall assemblies used at the residential levels of this project are Walls Types F2, G2, and H2. The details of these exterior wall types are shown on Dwg. A-8.1. The basic construction of these wall types is similar and provides a sound rating that exceeds the minimum code requirement for exterior sound isolation and no modifications are required.

EXTERIOR WALLS

Basic Wall Assembly: The basic construction of the exterior wall types is similar and consists of: 2" x 6" wood studs with R-21 batt insulation in the stud cavity. On the interior is a layer of 5/8" thick Type 'X' gypsum board installed over resilient channels.

Exterior Finishes: The only difference between these exterior wall types is the exterior finish used. These are:

Wall Type F2: Used at the rear (north) half of building. On the exterior side, a layer of 1/2" thick CDX plywood sheathing is installed on the face of the studs, covered with 7/8" thick exterior cement plaster.

Wall Type G2: Used at the front (south) half of building. On the exterior side, a layer of 5/8" thick Type 'X' DensGlas Gold sheathing is installed on the face of the studs, covered with a mortar setting bed and a thin brick veneer.

Wall Type H2: Used at a portion of the west property line side of building. On the exterior side, a layer of 1/2" thick CDX plywood sheathing, covered with 5/8" thick Type 'X' DensGlas Gold sheathing and covered with exterior grade plywood sheathing.

The laboratory-measured sound rating of these exterior wall assemblies is STC \geq 55. This rating significantly exceeds the minimum code requirement and no modifications are required.

Windows: Since the windows at the habitable spaces of the residential units can represent a significant percentage of the exterior wall they should also provide the minimum sound ratings indicated above, i.e., STC 35 at front half of the building and STC 30 at the rear half of the building. It is recommended that these minimum STC ratings also be included on the Window Schedule, Dwg. A10.1.

Ventilation for Residential Units: To achieve the allowable interior noise exposure level at the habitable spaces of the residential units will require that the windows be closed to maintain the required exterior-to-interior sound isolation. To allow the windows to be closed, the residential units should be provided with supplemental ventilation as designed by the project mechanical engineer.

INTERIOR SOUND ISOLATION

INTERIOR DESIGN STANDARDS: The acoustical code requires that multi-family residential projects be designed to provide a minimum laboratory-measured airborne Sound Transmission Class (STC) rating of 50 between adjacent residential units and between residential units and common spaces. The code also requires that the floor/ceiling assembly provide both a minimum airborne Sound Transmission Class (STC) rating and an Impact Insulation Class (IIC) rating of 50.

REVIEW OF INTERIOR BUILDING ASSEMBLIES: The interior wall and floor/ceiling assemblies shown on the architectural drawings have been reviewed to determine compliance with the minimum airborne and impact sound isolation required by Code.

4

WALL ASSEMBLIES

Demising Walls

Wall Types P1 and P2: These demising walls are 1-hour rated walls and consist of wood studs with 2" thick mineral wool insulation in the stud cavity. Two layers of 5/8" thick Type 'X' gypsum board are installed on both sides of the studs. The gypsum board layers on one side are installed over a resilient channel system. The only difference between the P1 and P2 wall types is the stud size: 2" x 4" or 2" x 6". There is no significant difference in the sound rating between these stud sizes.

The laboratory-measured sound rating of the P1/P2 Demising Wall assembly is STC \geq 55. This rating exceeds the sound isolating code requirement and no modifications are required.

Wall Types Q1 and Q2: These demising walls are 1-hour rated walls and consist of a double row of 2" x 4" wood studs separated by a 1" airspace. Two layers of 5/8" thick Type 'X' gypsum board are installed on the finish side of the both stud systems. R-11 batt insulation is installed between the studs on one side. The only difference between the Q1 and Q2 wall types is the stud size: 2" x 4" or 2" x 6". There is no significant difference in the sound rating between these stud sizes.

The laboratory-measured sound rating of the Q1/Q2 double stud Demising Wall assembly is STC \geq 60. This rating exceeds the sound isolating code requirement and no modifications are required.

Wall Type R1: This demising wall is a 1-hour rated wall consisting of 2" x 4" wood studs staggered on a 2" x 6" plate. Two layers of 5/8" thick Type 'X' gypsum board are installed on the finish side of each stud row. R-11 batt insulation is installed in the stud cavity.

The laboratory-measured sound rating of the R1 Demising Wall assembly is STC \geq 55. This rating exceeds the sound isolating code requirement and no modifications are required.

Corridor Wall: The corridor wall is Type P2. This is a 1-hour rated which is the same wall type described above as a demising wall.

The laboratory-measured sound rating of the P2 corridor wall assembly is STC \geq 55. This rating exceeds the sound isolating code requirement and no modifications are required.

Stairwells and Elevator Shaft: The wall type used between residential units and stairwells and elevator shafts is a 2-hour rated Wall Type J2. This is a wood stud wall with two layers of 5/8" thick Type 'X' gypsum board installed on both sides of the studs. The gypsum board layers on one side are installed over a resilient channel system. 2" thick mineral wool insulation in the stud cavity

The laboratory-measured sound rating of the Wall Type J2 stair and shaft wall assembly is STC \geq 55. This rating exceeds the sound isolating code requirement and no modifications are required.

Walls within Residential Units: There are no acoustical code requirements for sound isolation of walls within the same residential unit.

ENTRY DOORS TO RESIDENTIAL UNITS: The codes require that entry doors to the residential units, together with their perimeter seals, provide a laboratory-measured rating of STC \geq 26. The entry doors are included in the Door Schedule (Dwg. A-10.02) which indicates that the doors are 20-minute rated, 1-3/4" thick wood. These doors should be provided with smoke seals, etc., at the head, jamb, and door bottom.

5

FLOOR/CEILING ASSEMBLIES: The code also requires that the floor/ceiling assemblies between residential units provide both a minimum airborne Sound Transmission Class (STC) rating and an Impact Insulation Class (IIC) rating of 50 between adjacent residential units and between residential and common areas.

1st to 2nd Floor: The floor at the residential units at the 2nd Floor is a 12" (nom.) concrete slab. The First Floor level below contains commercial, and common spaces.

The laboratory-measured sound rating of a concrete slab of this thickness is STC \geq 55. This rating exceeds the sound isolating code requirement and no modifications are required. Note that there is no acoustical code requirement for impact sound transmission down to non-residential spaces.

2nd to 4th Floor: The floor assembly used the residential units at the 2nd to 4th Floors is shown in Dtl. 7 / Dwg. A-8.2. It is a 1-hour rated assembly consisting of TJI joists. On top of the joists is a 3/4" thick T&G plywood subfloor covered with a resilient underlayment mat, such as 3/4" Acousti-Mat II HP, and covered with a 1" thick lightweight concrete topping slab, such as by Maxxon. The finish floor is shown as 1/2" thick engineered wood flooring installed over a resilient 1/8" closed cell foam underlayment pad. The ceiling at the space below consists of two layers of 5/8" thick Type 'X' gypsum board installed to the underside of the joists on a resilient channel system.

Laboratory-measured sound ratings for this floor/ceiling assembly are STC and IIC \geq 55. These ratings exceed the minimum requirements for both airborne and impact sound isolation and no modifications are required.

Common Roof Deck: The roof/ceiling assembly of the common roof deck above the residential units at the 5th Floor is shown in Dtl. 6 / Dwg. A-8.2. The basic assembly is similar to the floor/ceiling assembly between the 2nd through 4th Floors consisting of TJI joists with 3/4" thick T&G plywood subfloor on top. The ceiling at the space below consists of two layers of 5/8" thick Type 'X' gypsum board installed to the underside of the joists on a resilient channel system. On top of the plywood, is installed a layer of rigid insulation sloped to achieve the required roof slope. On top of the rigid insulation is 3/4" thick Densdeck roof board. The walking surface at the roof deck consists of porcelain paving units supported on adjustable leveling pedestal risers such as Bison "Level It" or equal.

Laboratory-measured sound ratings for this roof deck / ceiling assembly are STC and IIC \geq 55. These ratings exceed the minimum requirement for both airborne and impact sound isolation to the residential units and no modifications are required.

GENERAL ACOUSTICAL CONSIDERATIONS

SOUND LEAKS: In order to achieve the full sound isolating capabilities of the construction assemblies it is important to insure that sound leaks, including joints, penetrations, electrical outlets, recessed elements, etc., are minimized and caulked airtight with acoustical sealant. Typical sound flanking or leakage paths have been addressed well in the details and sheet notes on the architectural drawings. Typical sound leaks include:

Joints, Penetrations, and Gaps: Acoustical sealant should be provided at all joints and gaps. Putty pads are to be provided on the back of outlet boxes in wall assemblies of acoustically sensitive walls.

Perimeter Isolation of Floor between Residential Units: A resilient isolation joint should be provided around the perimeter of the lightweight topping slab at the floor assembly shown in Dtl. 7 / Dwg. A-8.2 for the residential units on the 2nd through 4th floors. This resiliently isolated perimeter break is provided to

6

insure that the resiliently isolated topping slab does not rigidly touch the walls and reduce the airborne and impact sound isolation rating. This is included in the topping slab manufacturer's installation details.

MECHANICAL EQUIPMENT ISOLATION: It is recommended that all mechanical and electrical equipment in the project be vibration isolated from the building, including heat pump units at the roof, fans, motors, pumps, hydraulic units, elevator equipment, garage door motor, transformers, etc. Although not required by the codes it is also recommended that all piping serving the residential units be resiliently isolated from the building structure at all support and penetration points at walls, floors, ceiling, etc., using a proprietary piping isolation system such as the "Acousto-Plumb" system by LSP Products, the "Holdrite" silencer system by Hubbard Enterprises, or approved equal.

CALIFORNIA GREEN BUILDING STANDARDS

Interior sound requirements are also included in the Non-Residential Mandatory Measures: Section 5.507 - Environment Comfort of the California Green Building Standards. Under Section 5.507.4.2 the requirements specify that interior sound level shall not exceed an hourly Equivalent Sound Level ($L_{eq}(1-H)$) of 50 dBA in occupied areas during any hour of operation. This requirement applies to the commercial space at the 1st Floor.

Hourly L_{eq} sound levels were measured on Otis Street in front of the site, over the five-day, continuous noise survey, during both the daytime and evening periods. To achieve the maximum allowable interior sound level of $L_{eq} \leq 50$ dBA in the commercial space requires that the windows at the commercial space along Otis Street provide a Noise Reduction of 31 dBA. As noted above, the Noise Reduction (NR) is not the same as the Sound Transmission Class (STC) rating. A standard, fixed, 3/4" thick tempered glass in an aluminum framed storefront system has a sound rating of STC \geq 35 and the Noise Reduction provided by the storefront glass exceeds the acoustical requirement for this project. No modifications or changes are required for the project.

SUMMARY: CONFIRMATION OF ACOUSTICAL COMPLIANCE

The design of the residential project at 42 Otis Street has been completed very well with regard to both the exterior and interior sound isolation code requirements. Based on the measured sound data at the site and an evaluation of the architectural drawings, including details, sheet notes, etc., this letter confirms that the project at 42 Otis Street is in compliance with the acoustical requirements of the City of San Francisco Building Code, the California Building Code, and the CalGreen Building Standards for both exterior-to-interior noise reduction and interior sound isolation between residential units. No changes or modifications to the project are required to achieve acoustical code compliance.


• • •

Please call if you have any questions regarding the acoustical evaluation for the project.

Very truly yours,
WALSH • NORRIS & ASSOCIATES, INC.

David P. Walsh, ASA
Principal

encl:

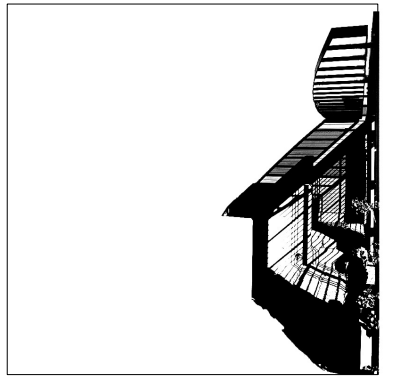

ELEVATIONarchitects

1159 Green Street, Suite 4
San Francisco, CA 94109

415.537.1125 :w
www.elevationarchitects.com :w



agency stamps:

Condominiums
42 Otis Street
San Francisco, CA 94103
Block / Lot : 3505 / 020

#	date	issue
	10.01.19	Addendum #2
1	1.28.20	Plan Check Response 1
2	4.15.20	Project Revision 2
3	4.27.20	Plan Check Response 2
4	8.17.20	Plan Check Response 3

sheet count 11/49

Acoustical Report

project: 16.15


drawn by: MKA

checked by: JP

date: 03.23.17

scale:

A-0.8

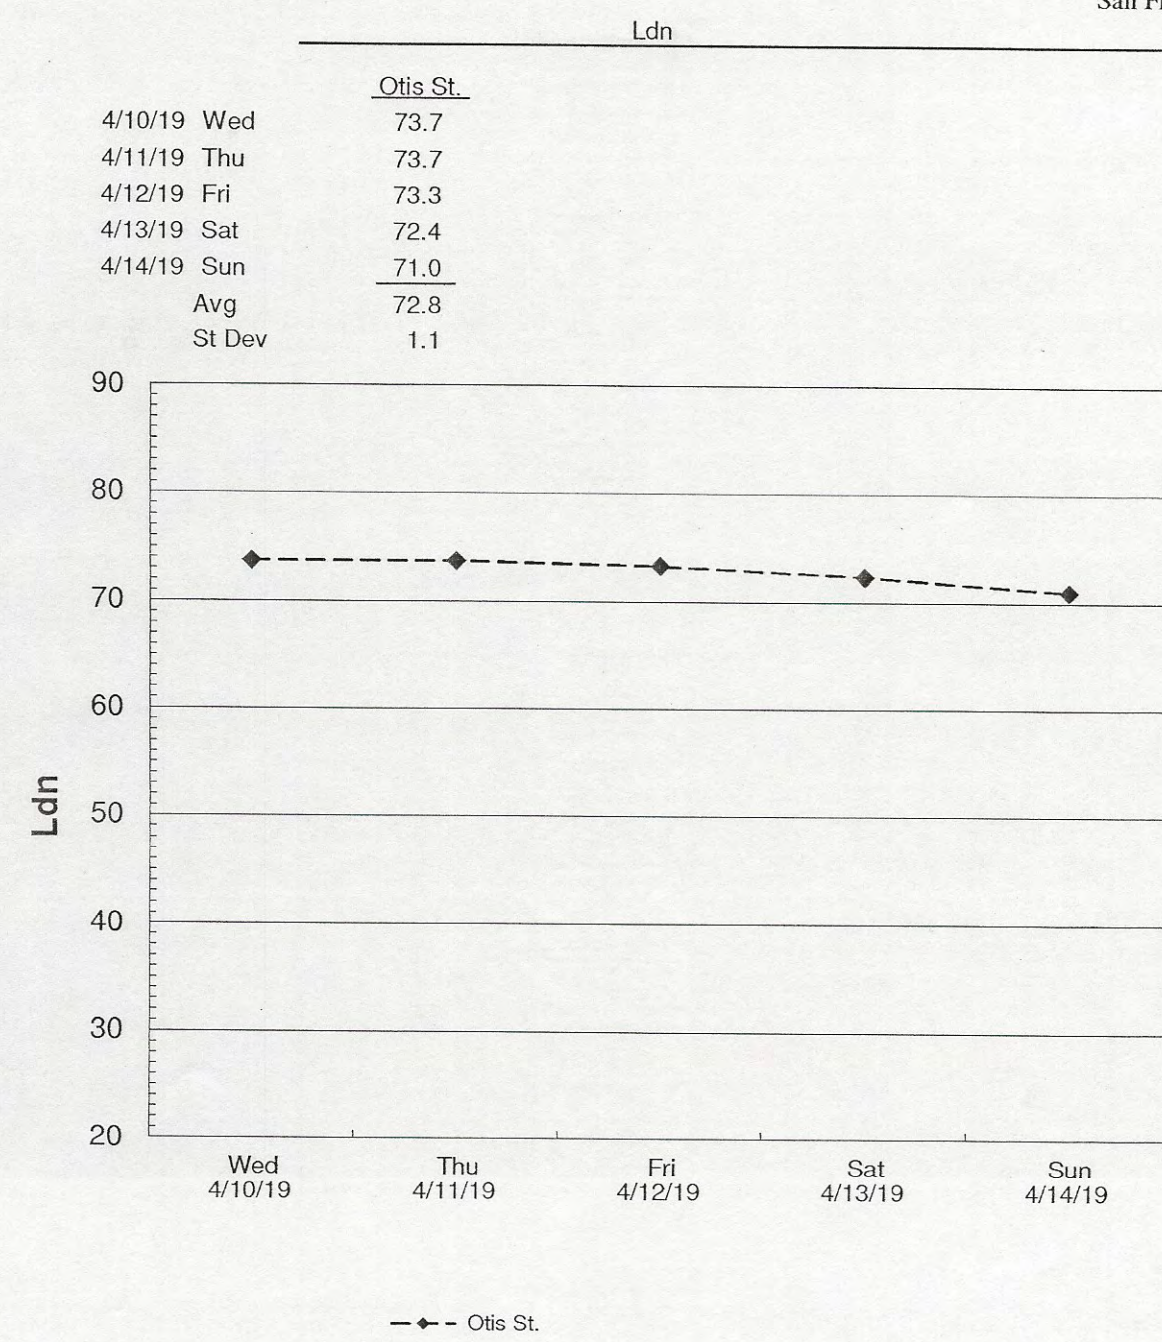

Summary of Measured Noise Exposure Levels
42 Otis Street, San Francisco, CA

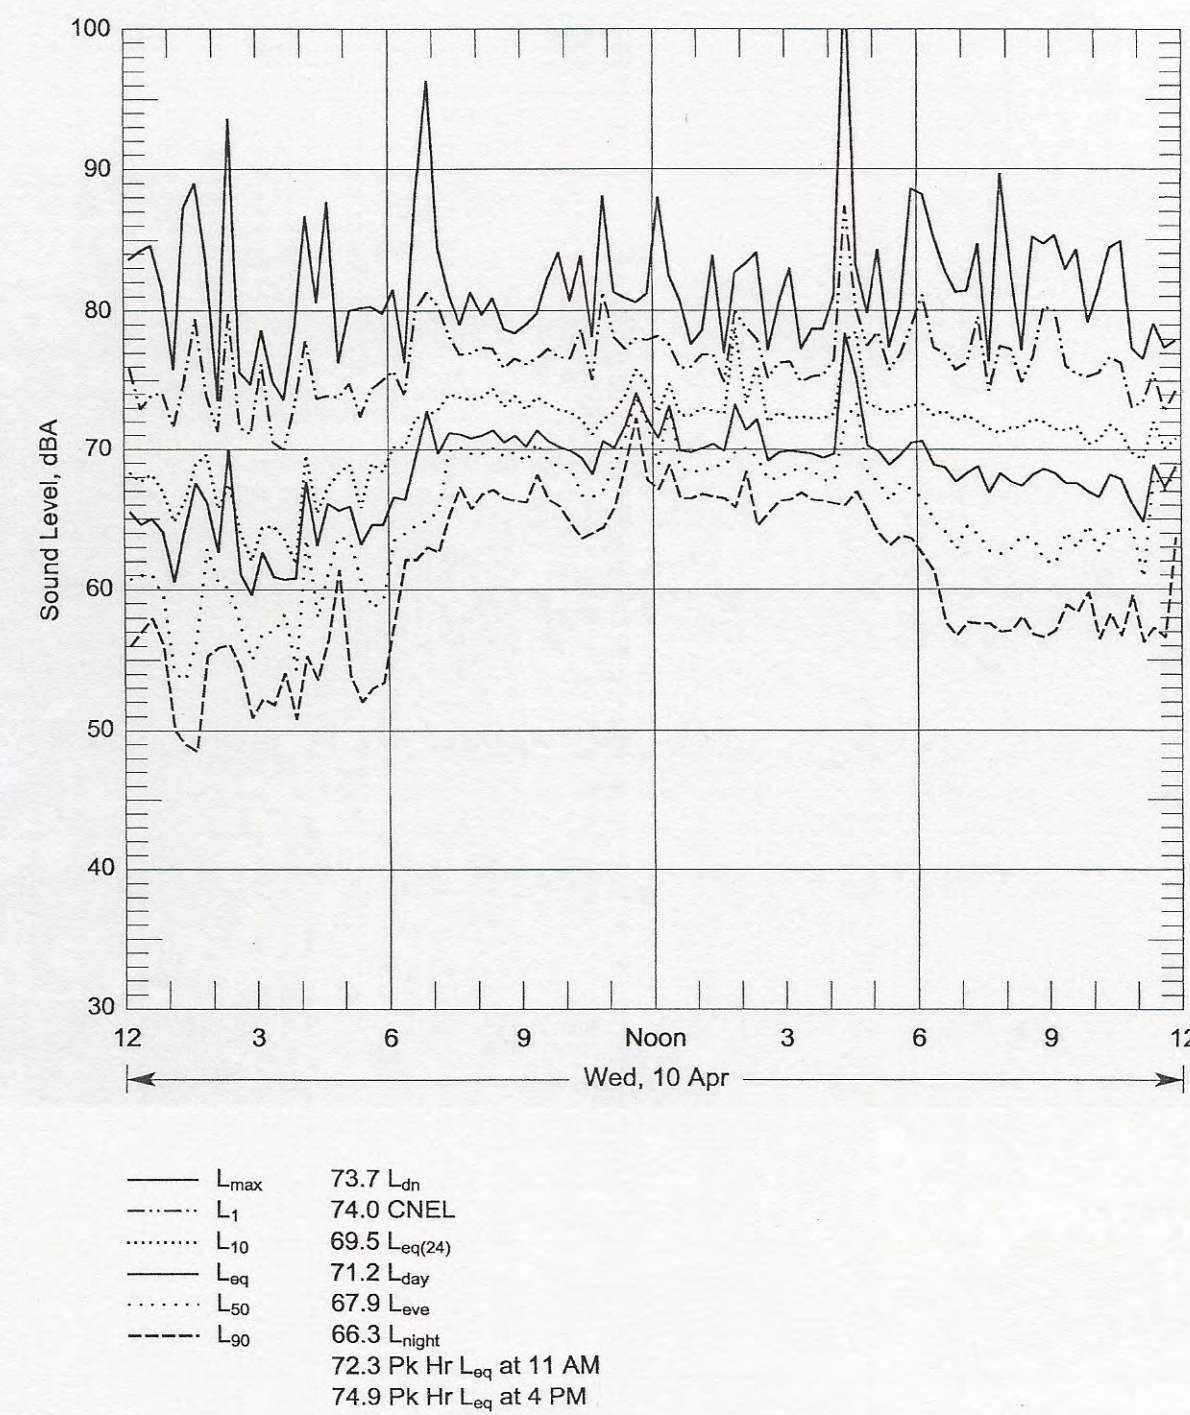


FIGURE 1 Measured Sound Levels
42 Otis Street
San Francisco, CA
Wednesday, 10 April 2019

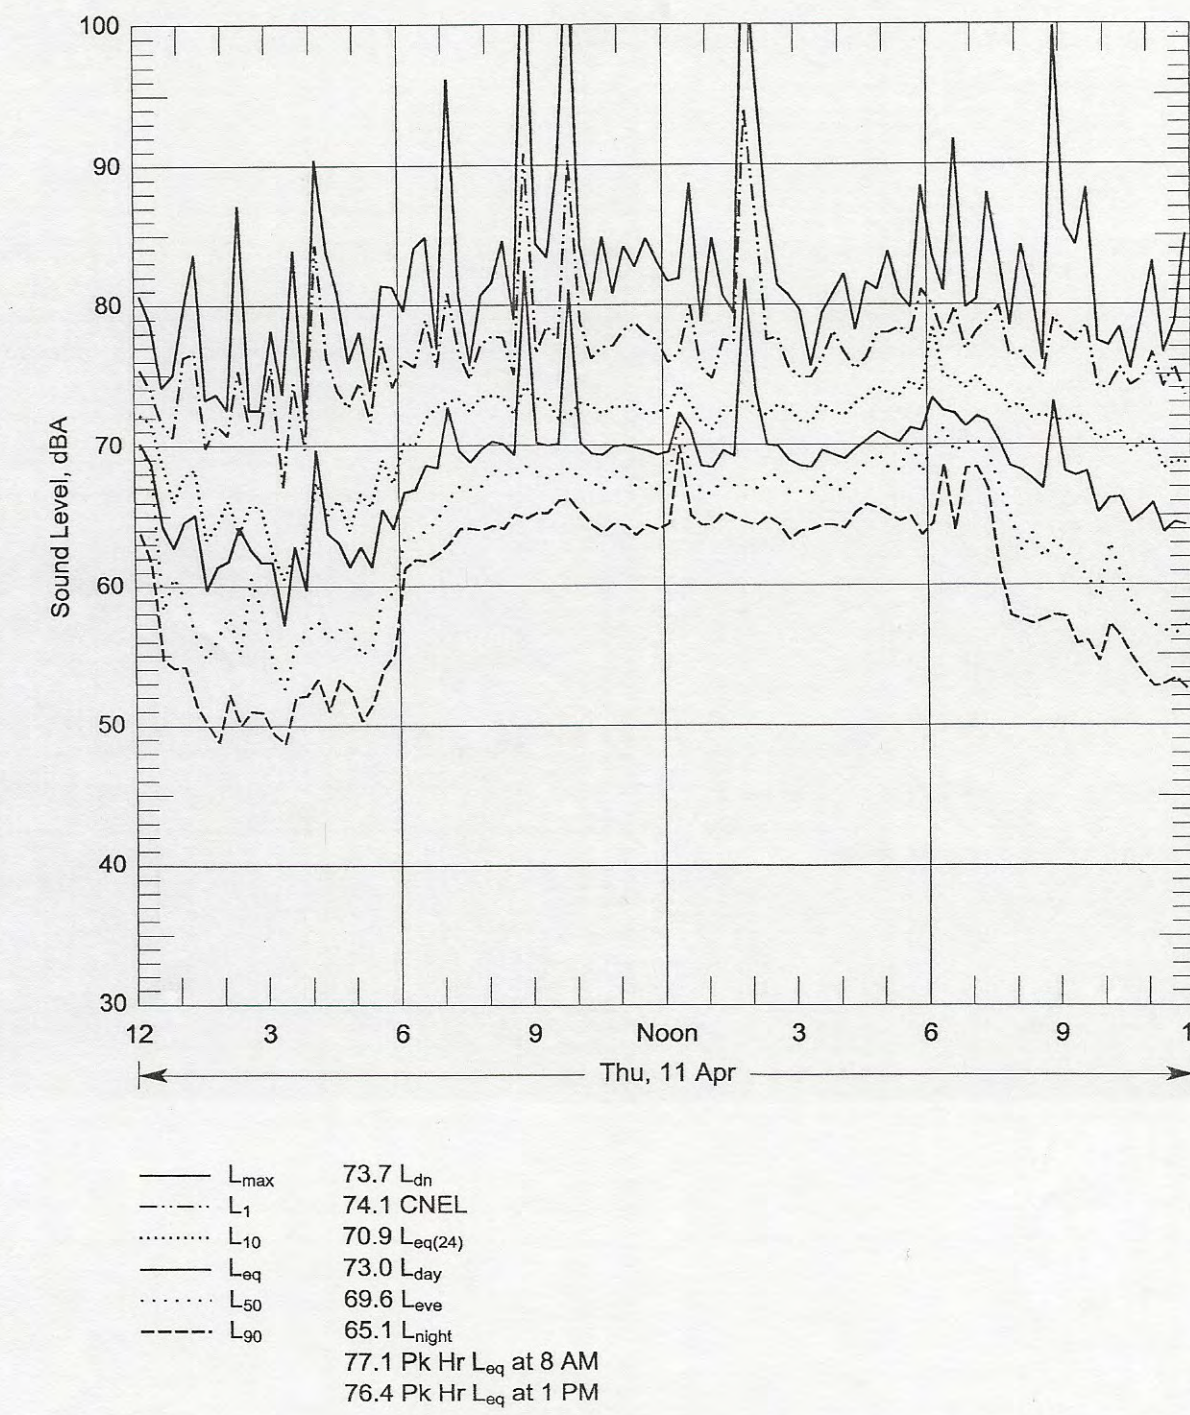


FIGURE 2 Measured Sound Levels
42 Otis Street
San Francisco, CA
Thursday, 11 April 2019

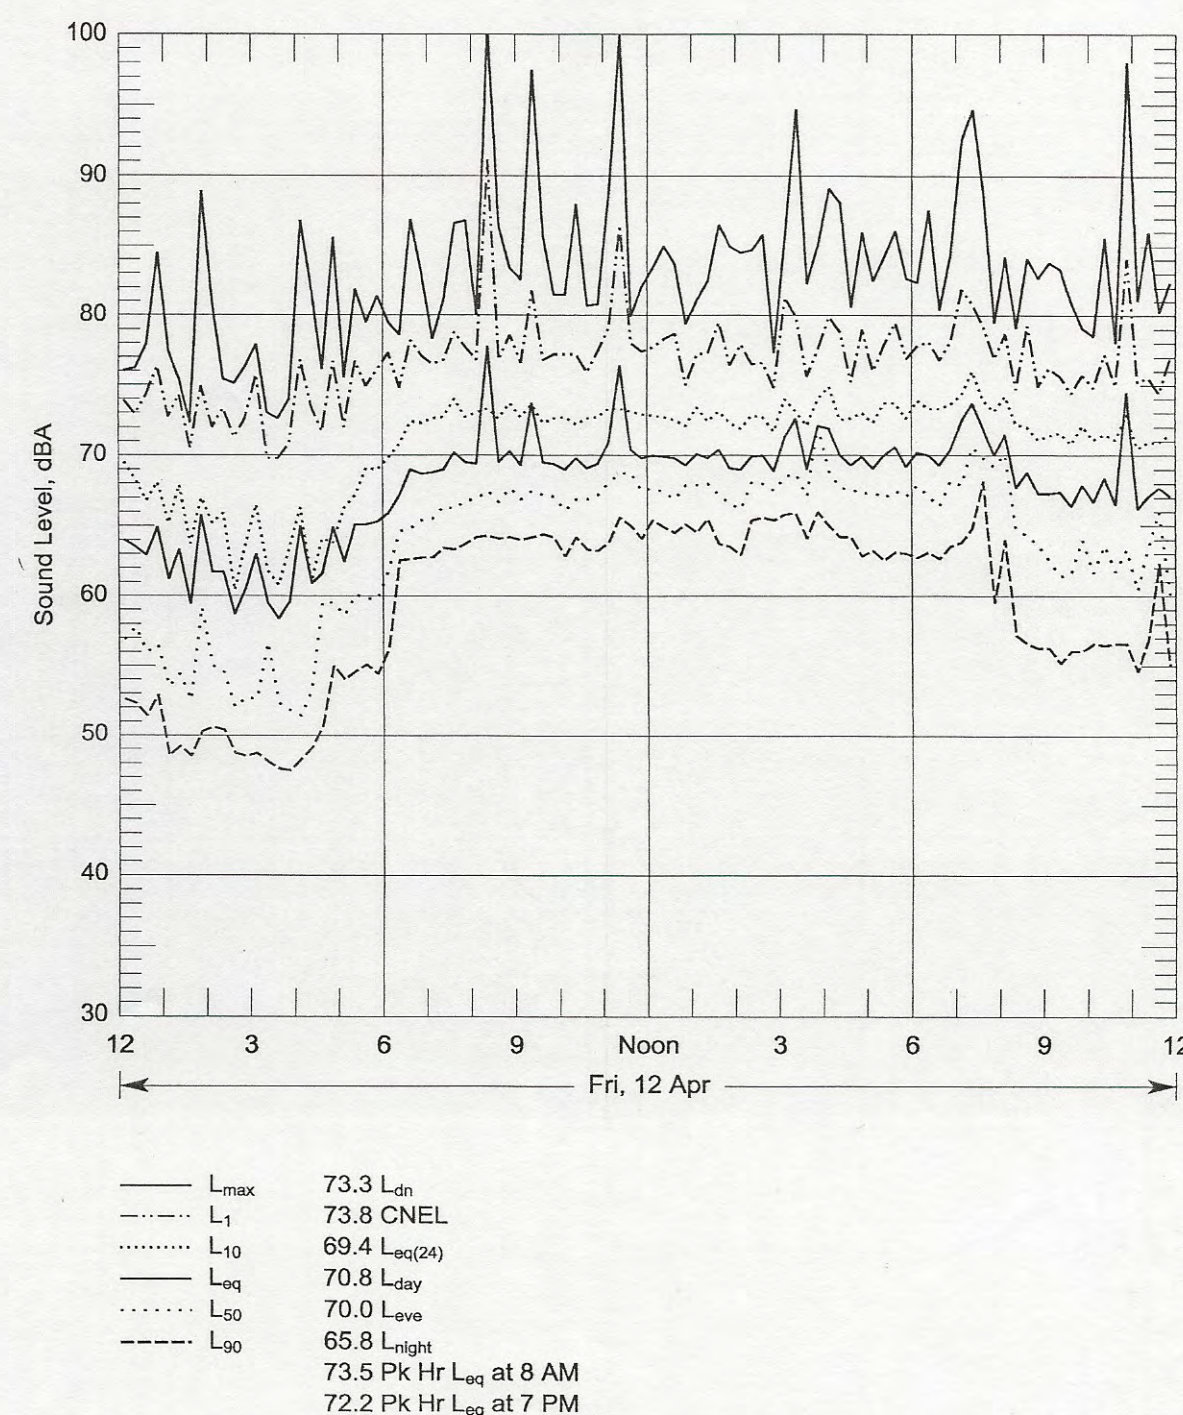


FIGURE 3 Measured Sound Levels
42 Otis Street
San Francisco, CA
Friday, 12 April 2019

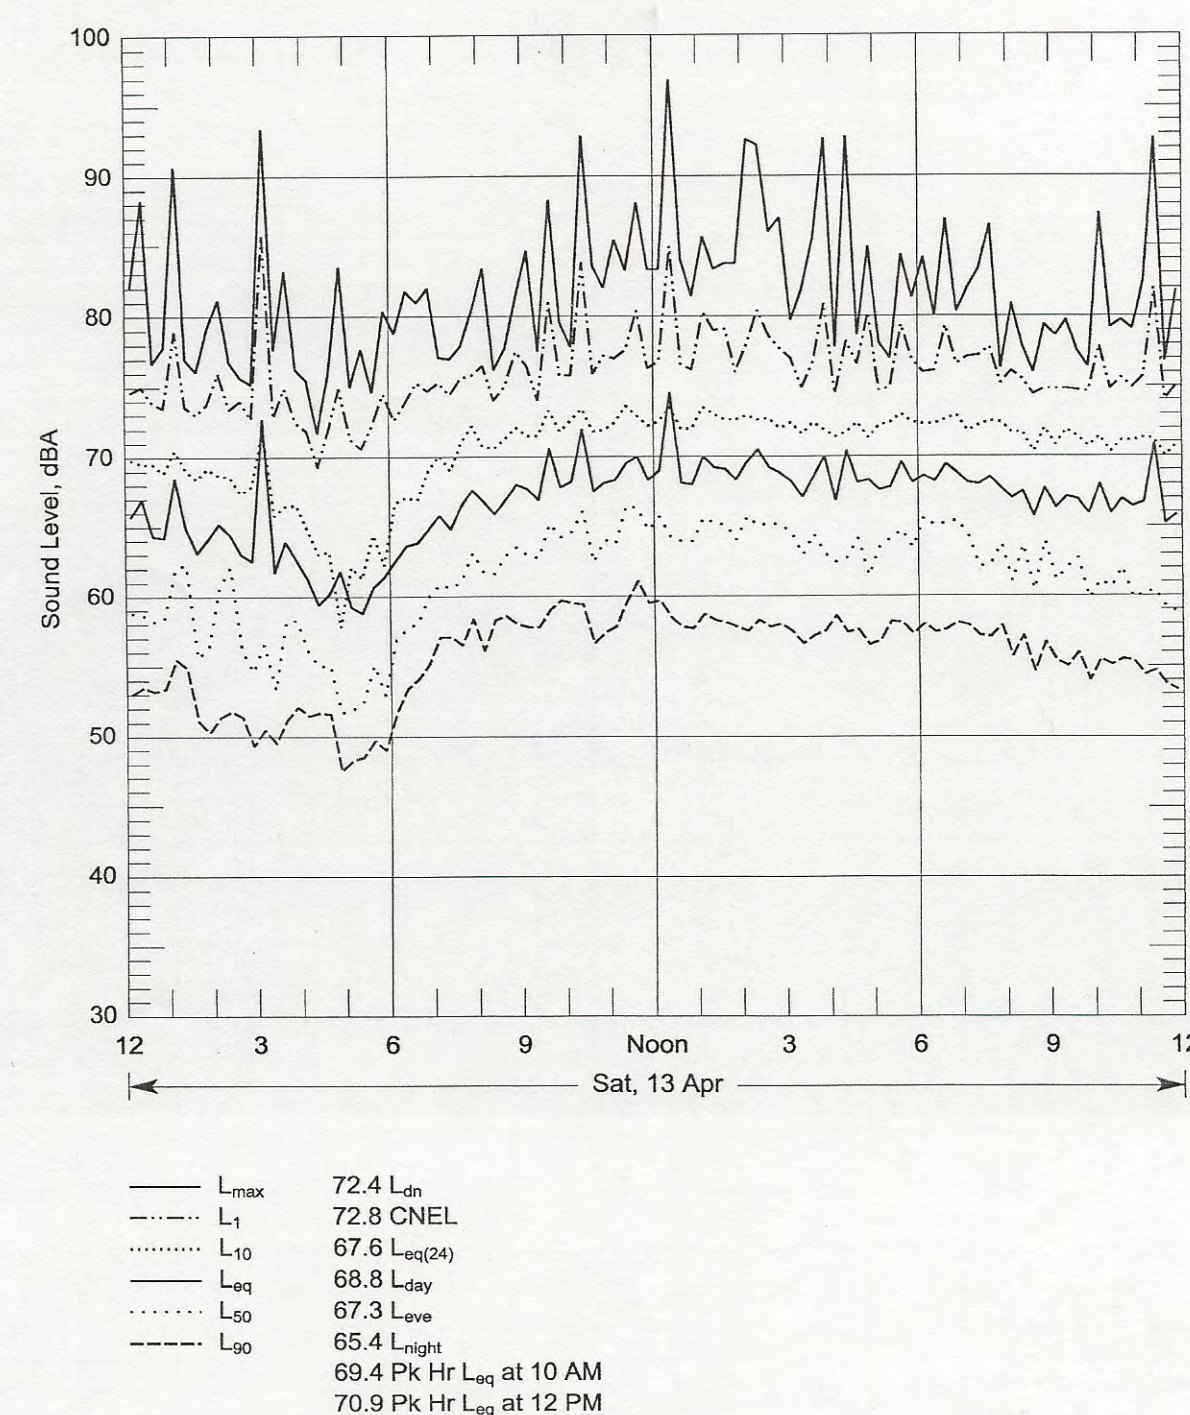


FIGURE 4 Measured Sound Levels
42 Otis Street
San Francisco, CA
Saturday, 13 April 2019


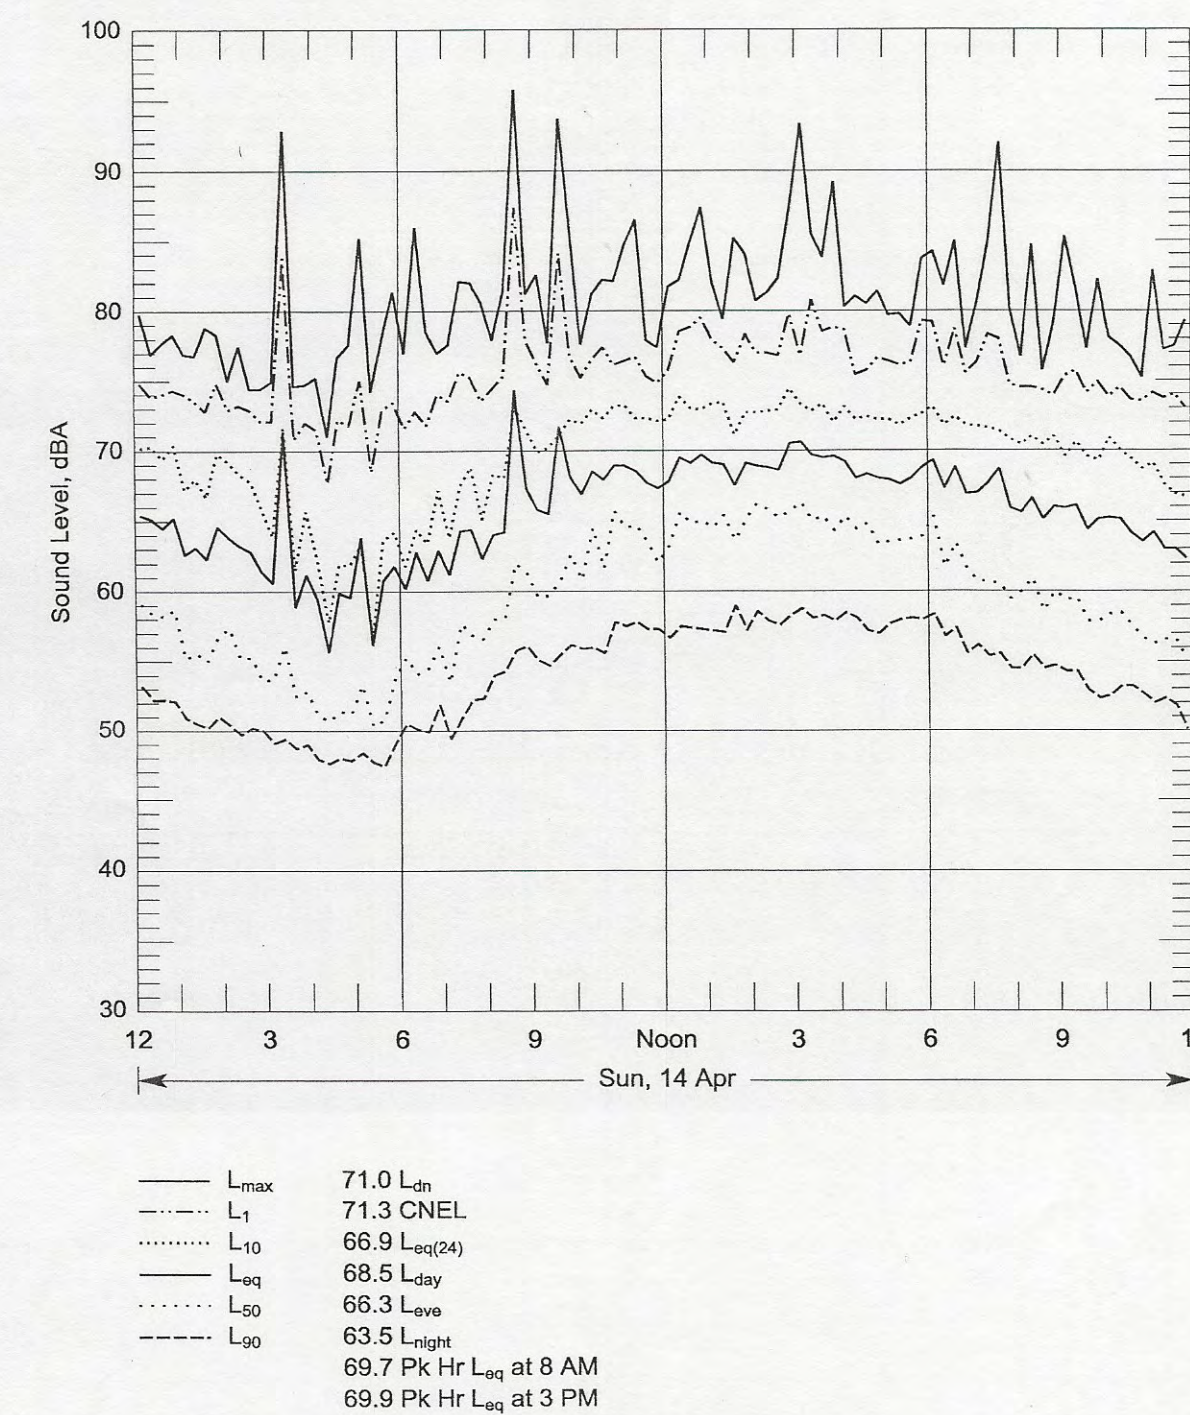



FIGURE 5 Measured Sound Levels
42 Otis Street
San Francisco, CA
Sunday, 14 April 2019

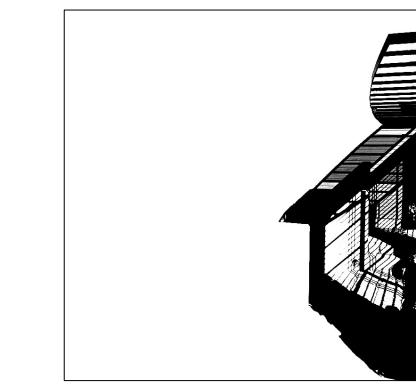

ELEVATIONarchitects

1159 Green Street, Suite 4
San Francisco, CA 94109

415.537.1125 :v
www.elevationarchitects.com :w

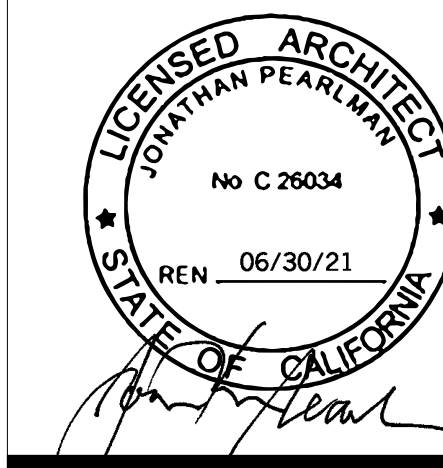

agency stamps:

Condominiums
42 Otis Street
San Francisco, CA 94103
Block / Lot : 3505 / 020

#	date	issue
	10.01.19	Addendum #2
1	1.28.20	Plan Check Response 1
2	4.15.20	Project Revision 2
3	4.27.20	Plan Check Response 2
4	8.17.20	Plan Check Response 3

sheet count 12/49

Acoustical Report

project: 16.15

drawn by: MKA


checked by: JP

date: 03.23.17

scale:

A-0.9

WALSH • NORRIS & ASSOCIATES, INC.
ARCHITECTURALACOUSTICS

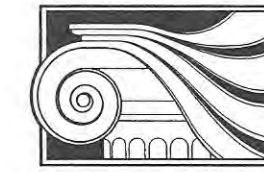

22 BATTERY STREET
♦ SUITE 808 ♦
SAN FRANCISCO, CA
U.S.A. ♦ 94111
WNAcou@aol.com
(415) FAX 351-0727
(415) 351-2166
2 June 2020

Ms. Svetlana Fickes
March Capital Management, LLC
3456 Sacramento Street
San Francisco, CA 94118

Subject: Acoustical Evaluation
Compliance with Acoustical Code Requirements
Project Revision 2 Drawings
42 Otis Street
San Francisco, CA

Dear Ms. Fickes:

We have reviewed the final Project Revision 2 architectural drawings for the new multi-family residential project at 42 Otis Street in San Francisco, dated 16 March 2020, prepared by Elevation Architects. The purpose of this letter is to confirm compliance of the final architectural drawings with the acoustical design regulations of the City of San Francisco (SFBC Section 1207) and the California Building Code (Title 24 Section 1207.4).

ACOUSTICAL CODE REQUIREMENTS and COMPLIANCE

EXTERIOR NOISE: The general acoustical design requirements of the City of San Francisco and the California Building Code specify that the interior noise exposure level in any habitable space of a multi-family residential project not exceed a Day-Night Average Sound Level (L_{dn}) of 60 dBA. The previous acoustical code compliance evaluation and report was based on the Site Permit Revision 1 drawings, dated 1 April 2019. That evaluation included both the results of field measurements of the exterior noise levels impacting the building and the required degree of the sound isolation ratings of the exterior assemblies of the building, including walls and window types.

- The acoustical evaluation of the field measurements, report, and compliance information of the Site Permit Revision 1 drawings are shown on the current, final Revision 2 architectural drawings on Dwg. A-0.8 and A-0.9. The minimum Sound Transmission Class (STC) ratings for the exterior shell of the building are STC 35 at the front half of the building, i.e., closest to Otis Street, and STC 30 at the rear half of the building.
- The final Project Revision 2 architectural drawings confirm the acoustical code compliance requirements for the windows on the exterior elevation drawings, Dwg. A-3.1 through A-3.4, and also on the Window Schedule on Dwg. A-10.1. The minimum required Sound Transmission Class (STC) ratings for each window assembly are shown on the final Project Revision 2 architectural drawings
- The final Project Revision 2 architectural drawings indicate the wall types, details, and STC ratings of the exterior wall assemblies on Dwg. A-8.1, indicating that the sound ratings of the exterior walls exceed the minimum sound ratings.
- To allow the windows to be closed to maintain the required exterior-to-interior sound isolation, the residential units are provided with supplemental ventilation as designed by the project mechanical engineer.

INTERIOR SOUND ISOLATION: The acoustical codes require that wall assemblies in multi-family residential projects be designed to provide a minimum laboratory-measured airborne Sound Transmission Class (STC) rating of 50 between adjacent residential units and between residential units and common spaces. The codes also require that the floor/ceiling assemblies provide both a minimum airborne Sound Transmission Class (STC) rating and an Impact Insulation Class (IIC) rating of 50.

WALSH • NORRIS & ASSOCIATES, INC. 2 Acoustical Code Compliance
ARCHITECTURALACOUSTICS Revision 2 Drawings
42 Otis Street
San Francisco, CA

- To allow the windows to be closed to maintain the required exterior-to-interior sound isolation, the residential units are provided with supplemental ventilation as designed by the project mechanical engineer.

INTERIOR SOUND ISOLATION: The acoustical codes require that wall assemblies in multi-family residential projects be designed to provide a minimum laboratory-measured airborne Sound Transmission Class (STC) rating of 50 between adjacent residential units and between residential units and common spaces. The codes also require that the floor/ceiling assemblies provide both a minimum airborne Sound Transmission Class (STC) rating and an Impact Insulation Class (IIC) rating of 50.


- This acoustical code information regarding interior sound isolation of the wall, floor/ceiling, and roof deck assemblies has been reviewed for the current Revision 2 architectural drawings. The sound ratings of the individual assemblies are indicated on shown on Dwg. A-8.1 and A-8.2. The sound ratings of the individual building assemblies exceed the minimum STC and IIC 50 ratings and are in compliance with the acoustical code requirements.
- The codes also require that the entry doors to the residential units, together with their perimeter seals, provide a laboratory-measured rating of $STC \geq 26$. This acoustical information is shown on the Door Schedule, Dwg. A-10.2, including acoustical information on the sheet notes. The sound ratings of the entry doors are in compliance with the acoustical code requirements.
- In order to achieve the full sound isolating capabilities of the construction assemblies, sound leaks, including joints, penetrations, electrical outlets, recessed elements, etc., be minimized and caulked to be airtight with acoustical sealant. This information regarding control of sound leaks in the construction assemblies is addressed well in the assembly details and sheet notes of the current Revision 2 architectural drawings and achieves code compliance.


CONFIRMATION of ACOUSTICAL COMPLIANCE

The design of the residential project at 42 Otis Street has been completed very well with regard to both the exterior and interior sound isolation code requirements on the final Project Revision 2 architectural drawings.

Based on the current evaluation of the final Project Revision 2 architectural drawings, this letter confirms that the project at 42 Otis Street is in compliance with the acoustical requirements of both the City of San Francisco Building Code (SFBC Section 1207) and the California Building Code (Title 24 Section 1207.4) for both exterior-to-interior noise reduction and interior sound isolation between residential units. No changes or modifications to the project are required to achieve acoustical code compliance.

Very truly yours,
WALSH • NORRIS & ASSOCIATES, INC.

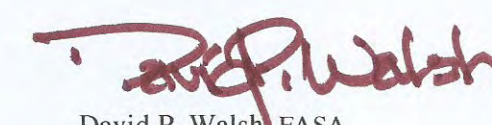
David P. Walsh, FASA
Principal

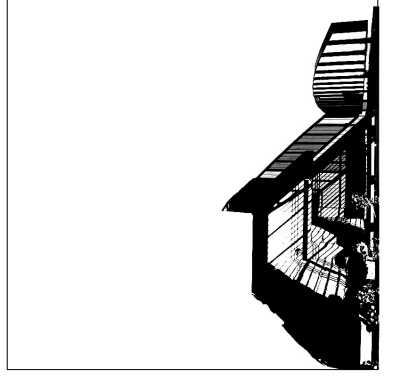

ELEVATIONarchitects
1159 Green Street, Suite 4
San Francisco, CA 94109

415.537.1125 :v
www.elevationarchitects.com :w



agency stamps:

Condominiums
42 Otis Street
San Francisco, CA 94103
Block / Lot : 3505 / 020

#	date	issue
	10.01.19	Addendum #2
1	1.28.20	Plan Check Response 1
2	4.15.20	Project Revision 2
3	4.27.20	Plan Check Response 2
4	8.17.20	Plan Check Response 3

sheet count 13/49

Acoustical Report

project: 16.15
drawn by: MKA
checked by: JP
date: 03.23.17
scale:

A-0.10

Project Name: 42 Otis
Project Address: 42 Otis San Francisco 94103
Compliance Scope: NewEnvelopeAndMechanical

A. PROJECT GENERAL INFORMATION
1. Project Location (city): San Francisco
2. CA Zip Code: 94103
3. Climate Zone: 3
4. Total Conditioned Floor Area in Scope: 11,753 ft²

B. COMPLIANCE RESULTS FOR PERFORMANCE COMPONENTS (Annual TDV Energy Use, kWh/ft²-yr)
BUILDING COMPLIES
1. Energy Component
2. Standard Design (TDV)
3. Proposed Design (TDV)
4. Compliance Margin (TDV)
5. Percent Better than Standard

CA Building Energy Efficiency Standards- 2016 Nonresidential Compliance Report Version: NRCC-PRF-01-E-06262019-5583 Report Generated at: 2020-08-27 16:22:51

Project Name: 42 Otis
Project Address: 42 Otis San Francisco 94103
Compliance Scope: NewEnvelopeAndMechanical

G. COMPLIANCE PATH & CERTIFICATE OF COMPLIANCE SUMMARY

The following building components are only eligible for prescriptive compliance. Indicate which are relevant to the project.

Table with columns: Yes, NA, Prescriptive Requirement, Compliance Forms, Yes, NA, Mandatory Requirement, Compliance Forms

CA Building Energy Efficiency Standards- 2016 Nonresidential Compliance Report Version: NRCC-PRF-01-E-06262019-5583 Report Generated at: 2020-08-27 16:22:51

Project Name: 42 Otis
Project Address: 42 Otis San Francisco 94103
Compliance Scope: NewEnvelopeAndMechanical

H. CERTIFICATE OF INSTALLATION, CERTIFICATE OF ACCEPTANCE & CERTIFICATE OF VERIFICATION SUMMARY (NRCC/NRCA/NRVC) -

Documentation Author to indicate which Certificates must be submitted for the features to be recognized for compliance


Table with columns: Building Component, Compliance Forms (required for submittal), Pass, Fail

I. ENVELOPE GENERAL INFORMATION (See NRCC-PRF-ENV-DETAILS for more information)

Table with columns: 1. Total Conditioned Floor Area, 2. Total Unconditioned Floor Area, 3. Addition Conditioned Floor Area, 4. Addition Unconditioned Floor Area, 5. Number of Floors Above Grade, 6. Number of Floors Below Grade, 7. Opaque Surfaces & Orientation, 8. Total Gross Surface Area, 9. Total Fenestration Area, 10. Window to Wall Ratio

CA Building Energy Efficiency Standards- 2016 Nonresidential Compliance Report Version: NRCC-PRF-01-E-06262019-5583 Report Generated at: 2020-08-27 16:22:51

Project Name: 42 Otis
Project Address: 42 Otis San Francisco 94103
Compliance Scope: NewEnvelopeAndMechanical

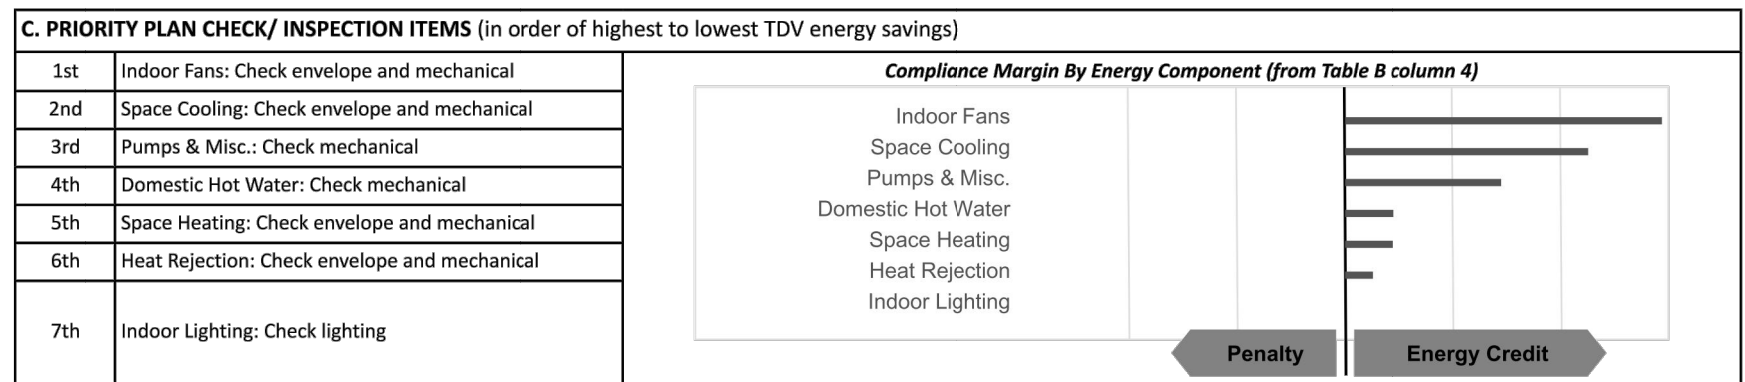

D. EXCEPTIONAL CONDITIONS

This project includes partial performance compliance scope options. The building must show compliance with all other applicable compliance scope options (performance or prescriptive) before occupying.

This project uses the Simplified Geometry Performance Modeling Approach which is not capable of modeling daylighting controls and assumes the prescriptive Secondary Daylit Control requirements are met.

This project includes Domestic Hot Water in the analysis. Please verify that Domestic Hot Water is included in the design for the permitted scope of work.

The user model includes space(s) that are served by mechanical cooling systems, but the cooling systems were not included in the simulation model.

E. HERS VERIFICATION

This Section Does Not Apply

F. ADDITIONAL REMARKS

None Provided

CA Building Energy Efficiency Standards- 2016 Nonresidential Compliance Report Version: NRCC-PRF-01-E-06262019-5583 Report Generated at: 2020-08-27 16:22:51

Project Name: 42 Otis
Project Address: 42 Otis San Francisco 94103
Compliance Scope: NewEnvelopeAndMechanical

H. CERTIFICATE OF INSTALLATION, CERTIFICATE OF ACCEPTANCE & CERTIFICATE OF VERIFICATION SUMMARY (NRCC/NRCA/NRVC) -

Documentation Author to indicate which Certificates must be submitted for the features to be recognized for compliance

Table with columns: Building Component, Compliance Forms (required for submittal), Pass, Fail

CA Building Energy Efficiency Standards- 2016 Nonresidential Compliance Report Version: NRCC-PRF-01-E-06262019-5583 Report Generated at: 2020-08-27 16:22:51

Project Name: 42 Otis
Project Address: 42 Otis San Francisco 94103
Compliance Scope: NewEnvelopeAndMechanical

J. FENESTRATION ASSEMBLY SUMMARY

Table with columns: Fenestration Assembly Name / Tag or I.D., Fenestration Type / Product Type / Frame Type, Certification Method, Assembly Method, Area ft², Overall U-Factor, Overall SHGC, Overall VT, Status, Pass, Fail

K. OPAQUE SURFACE ASSEMBLY SUMMARY

Table with columns: Surface Name, Surface Type, Area (ft²), Framing Type, Cavity R-Value, Continuous R-Value, U-Factor / F-Factor / C-Factor, Status, Pass, Fail

CA Building Energy Efficiency Standards- 2016 Nonresidential Compliance Report Version: NRCC-PRF-01-E-06262019-5583 Report Generated at: 2020-08-27 16:22:51

Project Name: 42 Otis
Project Address: 42 Otis San Francisco 94103
Compliance Scope: NewEnvelopeAndMechanical

G. COMPLIANCE PATH & CERTIFICATE OF COMPLIANCE SUMMARY
Identify which building components use the performance or prescriptive path for compliance. "NA" = not in project

CA Building Energy Efficiency Standards- 2016 Nonresidential Compliance Report Version: NRCC-PRF-01-E-06262019-5583 Report Generated at: 2020-08-27 16:22:51

Project Name: 42 Otis
Project Address: 42 Otis San Francisco 94103
Compliance Scope: NewEnvelopeAndMechanical

H. CERTIFICATE OF INSTALLATION, CERTIFICATE OF ACCEPTANCE & CERTIFICATE OF VERIFICATION SUMMARY (NRCC/NRCA/NRVC) -

Documentation Author to indicate which Certificates must be submitted for the features to be recognized for compliance

Table with columns: Building Component, Compliance Forms (required for submittal), Pass, Fail

CA Building Energy Efficiency Standards- 2016 Nonresidential Compliance Report Version: NRCC-PRF-01-E-06262019-5583 Report Generated at: 2020-08-27 16:22:51

Project Name: 42 Otis
Project Address: 42 Otis San Francisco 94103
Compliance Scope: NewEnvelopeAndMechanical

K. OPAQUE SURFACE ASSEMBLY SUMMARY

Table with columns: Surface Name, Surface Type, Area (ft²), Framing Type, Cavity R-Value, Continuous R-Value, U-Factor / F-Factor / C-Factor, Status, Pass, Fail

L. ROOFING PRODUCT SUMMARY

Table with columns: Product Type, Product Density (lb/ft³), Aged Solar Reflectance, Thermal Emittance, SRI, Cool Roof Credit, Roofing Product Description, Status, Pass, Fail

M. HVAC SYSTEM SUMMARY (See NRCC-PRF-MCH-DETAILS for more information)

Table with columns: Equip Name, Equip Type, System Type (Simple or Complex), Qty, Total Heating Output (kBtu/h), Supp Heat Source (1/0), Supp Heat Output (kBtu/h), Total Cooling Output (kBtu/h), Efficiency, Acceptance Testing Required? (Y/N), Status, Pass, Fail

CA Building Energy Efficiency Standards- 2016 Nonresidential Compliance Report Version: NRCC-PRF-01-E-06262019-5583 Report Generated at: 2020-08-27 16:22:51

REVISION DATE REV#
REVISION DESCRIPTION
ENGINEER OF RECORD: MHC ENGINEERS

42 OTIS STREET
SAN FRANCISCO, CALIFORNIA

TITLE 24 DOCUMENTS
DATE: 02/01/2019
APPROVED: MHC
DRAWN: RML
MHC #M17-162



Project Name:	42 Otis	NRCC-PRF-01-E	Page 10 of 23
Project Address:	42 Otis San Francisco 94103	Calculation Date/Time:	16:21, Thu, Aug 27, 2020
Compliance Scope:	NewEnvelopeAndMechanical	Input File Name:	M17-162 - 42 Otis_Addendum 3_Perf.cibd16x

M. HVAC SYSTEM SUMMARY (see NRCC-PRF-MCH-DETAILS for more information)											§ 110.1 / § 110.2		
Dry System Equipment ¹ (Fan & Economizer info included below in Table N)											Pass	Fail	
1.	2.	3.	4.	5.	6.	7.	8.	9.		10.	11.	Pass	Fail
Equip Name	Equip Type	System Type (Simple or Complex) ²	Qty	Total Heating Output (kBtu/h)	Supp Heat Source (Y/N)	Supp Heat Output (kBtu/h)	Total Cooling Output (kBtu/h)	Efficiency	Acceptance Testing Required? (Y/N) ⁴	Status ⁵	Pass	Fail	
								Heating					
FC-1 (2nd Flr Commercial)	SZHP (Split1Phase)	Simple	4	15	Yes	3	12	SEER-21.100 / EER-13.000	HSPF-10.200	Yes	N	<input type="checkbox"/>	<input type="checkbox"/>
FC-1 (2nd Flr Residential)	SZHP (Split1Phase)	Simple	3	15	Yes	3	12	SEER-21.100 / EER-13.000	HSPF-10.200	Yes	N	<input type="checkbox"/>	<input type="checkbox"/>
FC-1 (3rd Flr Residential)	SZHP (Split1Phase)	Simple	7	15	Yes	3	12	SEER-21.100 / EER-13.000	HSPF-10.200	Yes	N	<input type="checkbox"/>	<input type="checkbox"/>
FC-1 (4th Flr Residential)	SZHP (Split1Phase)	Simple	7	15	Yes	3	12	SEER-21.100 / EER-13.000	HSPF-10.200	Yes	N	<input type="checkbox"/>	<input type="checkbox"/>
FC-1 (5th Flr Residential)	SZHP (Split1Phase)	Simple	7	15	Yes	3	12	SEER-21.100 / EER-13.000	HSPF-10.200	Yes	N	<input type="checkbox"/>	<input type="checkbox"/>

¹ Dry System Equipment includes furnaces, air handling units, heat pumps, etc.
² Simple Systems must complete NRCC-CIR-03-4 commissioning design review form
³ Complex Systems must complete NRCC-CIR-04-E commissioning design review form
⁴ A summary of which acceptance tests are applicable is provided in NRCC-PRF-MCH-DETAILS
⁵ Status: N - New, A - Altered, E - Existing

CA Building Energy Efficiency Standards- 2016 Nonresidential Compliance Report Version: NRCC-PRF-01-E-06262019-5583 Report Generated at: 2020-08-27 16:22:51

Project Name:	42 Otis	NRCC-PRF-01-E	Page 13 of 23
Project Address:	42 Otis San Francisco 94103	Calculation Date/Time:	16:21, Thu, Aug 27, 2020
Compliance Scope:	NewEnvelopeAndMechanical	Input File Name:	M17-162 - 42 Otis_Addendum 3_Perf.cibd16x

Multifamily or Hotel/ Motel Occupancy? (If "Yes", see NRCC-PRF-MCH-DETAILS for DHW system information) Yes

Q. INDOOR CONDITIONED LIGHTING GENERAL INFO (see NRCC-PRF-LTI-DETAILS for more info)
 This Section Does Not Apply

R. INDOOR CONDITIONED LIGHTING SCHEDULE (Adapted from NRCC-LTI-01-E)
 This Section Does Not Apply

¹ Lighting power densities were used in the compliance model. Building Departments will need to check prescriptive forms for Luminaire Schedule details.

S1. COVERED PROCESS SUMMARY - ENCLOSED PARKING GARAGES § 140.9
 This Section Does Not Apply

S2. COVERED PROCESS SUMMARY - COMMERCIAL KITCHENS § 140.9
 This Section Does Not Apply

S3. COVERED PROCESS SUMMARY - COMPUTER ROOMS § 140.9
 This Section Does Not Apply

S4. COVERED PROCESS SUMMARY - LABORATORY EXHAUSTS § 140.9
 This Section Does Not Apply

T. UNMET LOAD HOURS

Thermal Zone Name	Cooling Unmet Load Hour Limit for Thermal Zone	Proposed Cooling Unmet Load Hours	Heating Unmet Load Hour Limit for Thermal Zone	Proposed Heating Unmet Load Hours
1-2nd Floor Commercial Off	150	13.75	150	1907.75
2-2nd Floor Res	150	0	150	189.25
3-3rd Floor Res	150	0	150	161.5
4-4th Floor Res	150	0	150	163.5

CA Building Energy Efficiency Standards- 2016 Nonresidential Compliance Report Version: NRCC-PRF-01-E-06262019-5583 Report Generated at: 2020-08-27 16:22:51

Project Name:	42 Otis	NRCC-PRF-01-E	Page 16 of 23
Project Address:	42 Otis San Francisco 94103	Calculation Date/Time:	16:21, Thu, Aug 27, 2020
Compliance Scope:	NewEnvelopeAndMechanical	Input File Name:	M17-162 - 42 Otis_Addendum 3_Perf.cibd16x

NRCC-PRF-ENV-DETAILS - SECTION START-

A. OPAQUE SURFACE ASSEMBLY DETAILS				Confirmed	
1.	2.	3.	4.	Pass	Fail
Surface Name	Surface Type	Description of Assembly Layers	Notes		
Raised Concrete Floor (No7)	Exterior/Floor	Concrete - 140 lb/ft ³ - 4 in. Carpet - 3/4 in.		<input type="checkbox"/>	<input type="checkbox"/>
R-30 Wall9	Exterior/Wall	Stucco - 7/8 in. Vapor permeable felt - 1/8 in. Wood framed wall, 16in. OC, 2.25in., R-30 Gypsum Board - 1/2 in.		<input type="checkbox"/>	<input type="checkbox"/>
R-30 Floor No Crawlspace19	Exterior/Floor	Wood framed floor, 16in. OC, 9.25in., R-25 Plywood - 1/2 in. Carpet - 3/4 in.		<input type="checkbox"/>	<input type="checkbox"/>
R-38 Metal Framed Roof21	Roof	Asphalt shingles - 1/8 in. Vapor permeable felt - 1/8 in. Plywood - 1/2 in. Air - Ceiling - 3/4 in. Metal framed roof, 16in. OC, 11.25in., R-38 Gypsum Board - 1/2 in.		<input type="checkbox"/>	<input type="checkbox"/>
R-0 Floor No Crawlspace47	Interior/Floor	Air - Cavity - Wall Roof Ceiling - 4 in. or more Plywood - 1/2 in. Carpet - 3/4 in.		<input type="checkbox"/>	<input type="checkbox"/>
Slab On Grade209	Underground/Floor	Slab Type = UnheatedSlabOnGrade Insulation Orientation = None Insulation R-Value = R0		<input type="checkbox"/>	<input type="checkbox"/>
R-30 Roof No Attic212	Roof	Asphalt shingles - 1/4 in. Vapor permeable felt - 1/8 in. Plywood - 1/2 in. Air - Cavity - Wall Roof Ceiling - 4 in. or more Wood framed roof, 16in. OC, 11.25in., R-30 Gypsum Board - 1/2 in.		<input type="checkbox"/>	<input type="checkbox"/>
6 Concrete Wall220	Exterior/Wall	Concrete - 140 lb/ft ³ - 6 in. Air - Cavity - Wall Roof Ceiling - 4 in. or more		<input type="checkbox"/>	<input type="checkbox"/>
6 Concrete Wall w/R-19223	Exterior/Wall	Concrete - 140 lb/ft ³ - 6 in. Wood framed wall, 16in. OC, 5.5in., R-19 Gypsum Board - 5/8 in.		<input type="checkbox"/>	<input type="checkbox"/>

CA Building Energy Efficiency Standards- 2016 Nonresidential Compliance Report Version: NRCC-PRF-01-E-06262019-5583 Report Generated at: 2020-08-27 16:22:51

Project Name:	42 Otis	NRCC-PRF-01-E	Page 11 of 23
Project Address:	42 Otis San Francisco 94103	Calculation Date/Time:	16:21, Thu, Aug 27, 2020
Compliance Scope:	NewEnvelopeAndMechanical	Input File Name:	M17-162 - 42 Otis_Addendum 3_Perf.cibd16x

N. ECONOMIZER & FAN SYSTEMS SUMMARY ¹											§ 140.4		Confirmed	
Discrepancy between modeled and designed equipment sizing? (If "Yes", see Table F. "Additional Remarks" for an explanation)											Pass	Fail		
1.	2.	3.			4.			5.		6.	Pass	Fail		
Equip Name	CFM	CFM	HP	BHP	TSP (Inch WC)	Control	CFM	HP	BHP	TSP (Inch WC)	Control	Economizer Type (if present)	Pass	Fail
OSA-1	1247	1825	0.480	0.480	0.83	VariableSpeedDrive	NA	NA	NA	NA	NA	DifferentialDryBub	<input type="checkbox"/>	<input type="checkbox"/>
FC-1 (2nd Flr Commercial)	0	500	0.027	0.027	0.17	ConstantVolume	NA	NA	NA	NA	NA	NA	<input type="checkbox"/>	<input type="checkbox"/>
FC-1 (2nd Flr Residential)	0	500	0.027	0.027	0.17	ConstantVolume	NA	NA	NA	NA	NA	NA	<input type="checkbox"/>	<input type="checkbox"/>
FC-1 (3rd Flr Residential)	0	500	0.027	0.027	0.17	ConstantVolume	NA	NA	NA	NA	NA	NA	<input type="checkbox"/>	<input type="checkbox"/>
FC-1 (4th Flr Residential)	0	500	0.027	0.027	0.17	ConstantVolume	NA	NA	NA	NA	NA	NA	<input type="checkbox"/>	<input type="checkbox"/>
FC-1 (5th Flr Residential)	0	500	0.027	0.027	0.17	ConstantVolume	NA	NA	NA	NA	NA	NA	<input type="checkbox"/>	<input type="checkbox"/>

¹ Wet System Equipment includes boilers, chillers, cooling towers, water heaters, etc.
² Status: N - New, A - Altered, E - Existing

Discrepancy between modeled and designed equipment sizing? (If "Yes", see Table F. "Additional Remarks" for an explanation) No

N. ECONOMIZER & FAN SYSTEMS SUMMARY¹ § 140.4 Confirmed

U. ENERGY USE SUMMARY										
Energy Component	Standard Design Site (MWh)	Proposed Design Site (MWh)	Margin (MWh)	Standard Design Site (MWh)	Proposed Design Site (MWh)	Margin (MWh)				
Space Heating	0.0	5.8	--	68.8	0.0	--				
Space Cooling	2.6	0.5	2.1	--	--	--				
Indoor Fans	6.8	4.2	2.6	--	--	--				
Heat Rejection	0.1	--	--	--	--	--				
Pumps & Misc.	1.4	--	--	--	--	--				
Domestic Hot Water	0.3	0.5	-0.2	248.9	236.9	12.0				
Indoor Lighting	5.0	5.0	0.0	--	--	--				
COMPLIANCE TOTAL	16.2	16.0	0.2	317.7	236.9	80.8				
Receptacle	20.9	20.9	0.0	6.1	6.1	0.0				
Process	--	--	--	--	--	--				
Other Ltg	13.8	13.8	0.0	--	--	--				
Process Motors	--	--	--	--	--	--				
TOTAL	50.9	50.7	0.2	323.8	243.0	80.8				

¹ Mechanical ventilation calculations and exhaust fans are included in the NRCC-PRF-MCH-DETAILS section

CA Building Energy Efficiency Standards- 2016 Nonresidential Compliance Report Version: NRCC-PRF-01-E-06262019-5583 Report Generated at: 2020-08-27 16:22:51

Project Name:	42 Otis	NRCC-PRF-01-E	Page 14 of 23
Project Address:	42 Otis San Francisco 94103	Calculation Date/Time:	16:21, Thu, Aug 27, 2020
Compliance Scope:	NewEnvelopeAndMechanical	Input File Name:	M17-162 - 42 Otis_Addendum 3_Perf.cibd16x

U. ENERGY USE SUMMARY

Energy Component	Standard Design Site (MWh)	Proposed Design Site (MWh)	Margin (MWh)	Standard Design Site (MWh)	Proposed Design Site (MWh)	Margin (MWh)
Space Heating	0.0	5.8	--	68.8	0.0	--
Space Cooling	2.6	0.5	2.1	--	--	--
Indoor Fans	6.8	4.2	2.6	--	--	--
Heat Rejection	0.1	--	--	--	--	--
Pumps & Misc.	1.4	--	--	--	--	--
Domestic Hot Water	0.3	0.5	-0.2	248.9	236.9	12.0
Indoor Lighting	5.0	5.0	0.0	--	--	--
COMPLIANCE TOTAL	16.2	16.0	0.2	317.7	236.9	80.8
Receptacle	20.9	20.9	0.0	6.1	6.1	0.0
Process	--	--	--	--	--	--
Other Ltg	13.8	13.8	0.0	--	--	--
Process Motors	--	--	--	--	--	--
TOTAL	50.9	50.7	0.2	323.8	243.0	80.8

CA Building Energy Efficiency Standards- 2016 Nonresidential Compliance Report Version: NRCC-PRF-01-E-06262019-5583 Report Generated at: 2020-08-27 16:22:51

Project Name:	42 Otis	NRCC-PRF-01-E	Page 17 of 23
Project Address:	42 Otis San Francisco 94103	Calculation Date/Time:	16:21, Thu, Aug 27, 2020
Compliance Scope:	NewEnvelopeAndMechanical	Input File Name:	M17-162 - 42 Otis_Addendum 3_Perf.cibd16x

B. OVERHANG DETAILS (Adapted from NRCC-ENV-02-E)
 This Section Does Not Apply

C. OPAQUE DOOR SUMMARY
 This Section Does Not Apply

NRCC-PRF-MCH-DETAILS - SECTION START-

A. MECHANICAL VENTILATION AND REHEAT (Adapted from 2016-NRCC-MCH-03-E)

A. MECHANICAL VENTILATION AND REHEAT (Adapted from 2016-NRCC-MCH-03-E)											Confirmed								
CONDITIONED ZONE NAME	HEATING/COOLING SYSTEM ID	1. DESIGN AIR FLOWS				2. VENTILATION (§ 120.1)					Pass	Fail							
		DESIGN PRIMARY AIR FLOW (CFM)	DESIGN TERTIARY AIR FLOW (CFM)	MINIMUM HEATING AIR FLOW (CFM)	MAXIMUM HEATING AIR FLOW (CFM)	DC CONTROL (Y/N)	DESIGN VENT AIR FLOW (CFM)	TRANSFER AIRFLOW (CFM)	OPERABLE WINDOW INTERVAL ⁵ 1400 (h)/N										
1-2nd Floor Commercial Off	FC-1 (2nd Flr Commercial)	70	70	1.00	NA	NA	Y	OSA-1	1,400	0.15	7.00	30.00	210	210	NA	N	N	<input type="checkbox"/>	<input type="checkbox"/>
2-2nd Floor Res	FC-1 (2nd Flr Residential)	35	35	1.00	NA	NA	Y	OSA-1	1,050	0.09	6.00	15.50	93	93	NA	N	N	<input type="checkbox"/>	<input type="checkbox"/>
3-3rd Floor Res	FC-1 (3rd Flr Residential)	35	35	1.00	NA	NA	Y	OSA-1	2,450	0.09	14.00	15.50	217	217	NA	N	N	<input type="checkbox"/>	<input type="checkbox"/>
4-4th Floor Res	FC-1 (4th Flr Residential)	35	35	1.00	NA	NA	Y	OSA-1	2,450	0.09	14.00	15.50	217	217	NA	N	N	<input type="checkbox"/>	<input type="checkbox"/>
5-5th Floor Res	FC-1 (5th Flr Residential)	35	35	1.00	NA	NA	Y	OSA-1	2,450	0.09	14.00	15.50	217	217	NA	N	N	<input type="checkbox"/>	<input type="checkbox"/>

CA Building Energy Efficiency Standards- 2016 Nonresidential Compliance Report Version: NRCC-PRF-01-E-06262019-5583 Report Generated at: 2020-08-27 16:22:51

Project Name:	42 Otis	NRCC-PRF-01-E	Page 12 of 23
Project Address:	42 Otis San Francisco 94103	Calculation Date/Time:	16:21, Thu, Aug 27, 2020
Compliance Scope:	NewEnvelopeAndMechanical	Input File Name:	M17-162 - 42 Otis_Addendum 3_Perf.cibd16x

O. EQUIPMENT CONTROLS											§ 120.2		Confirmed
Discrepancy between modeled and designed equipment sizing? (If "Yes", see NRCC-PRF-MCH-DETAILS for system information)											Pass	Fail	
1.	2.	3.			4.		5.		6.		Pass	Fail	
Equip Name	Equip Type	Controls	Control	Control	Control	Control	Control	Control	Control	Control	Pass	Fail	
OSA-1	PVAV	No DCV Controls, DDC Controls Differential Drybulb Economizer Warmest Zone Supply Air Temp. Reset Optimum Start No Evaporative Cooler No Heat Recovery	NA	NA	NA	NA	NA	NA	NA	NA	<input type="checkbox"/>	<input type="checkbox"/>	
2nd Floor Commercial Off3	Exhaust	NA	NA	NA	NA	NA	NA	NA	NA	NA	<input type="checkbox"/>	<input type="checkbox"/>	
2nd Floor Res34	Exhaust	NA	NA	NA	NA	NA	NA	NA	NA	NA	<input type="checkbox"/>	<input type="checkbox"/>	
3rd Floor Res60	Exhaust	NA	NA	NA	NA	NA	NA	NA	NA	NA	<input type="checkbox"/>	<input type="checkbox"/>	
4th Floor Res108	Exhaust	NA	NA	NA	NA	NA	NA	NA	NA	NA	<input type="checkbox"/>	<input type="checkbox"/>	
5th Floor Res151	Exhaust	NA	NA	NA	NA	NA	NA	NA	NA	NA	<input type="checkbox"/>	<input type="checkbox"/>	
Undefined Plant2 - SHW	Service Hot Water, Primary Only	Fixed Temperature Control, No DDC No Heat Recovery	NA	NA	NA	NA	NA	NA	NA	NA	<input type="checkbox"/>	<input type="checkbox"/>	

P. SYSTEM DISTRIBUTION SUMMARY § 120.4/ § 140.4(i)

P. SYSTEM DISTRIBUTION SUMMARY											Confirmed	
Discrepancy between modeled and designed equipment sizing? (If "Yes", see NRCC-PRF-MCH-DETAILS for system information)											Pass	Fail
1.	2.	3.		4.		5.		6.		Pass	Fail	
Equip Name	Equip Type	Duct Leakage and Sealing Required per 140.4(i)	Duct Leakage will be verified per NA1 and NA2									

Project Name:	42 Otis	NRCC-PRF-01-E	Page 19 of 23
Project Address:	42 Otis San Francisco 94103	Calculation Date/Time:	16:21, Thu, Aug 27, 2020
Compliance Scope:	NewEnvelopeAndMechanical	Input File Name:	M17-162 - 42 Otis_Addendum 3_Perf.cbld16x

B. ZONAL SYSTEM AND TERMINAL UNIT SUMMARY											§ 140.4			
System ID	System Type	Qty	Rated Capacity (kBtu/h)		Economizer	Zone Name	Airflow (cfm)			Fan			Pass	Fail
			Heating	Cooling			Design	Min.	Min. Ratio	BHP	Cycles	ECM Motor		
FC-1 (5th Flr Residential)	SZHP	7	15.00	12.00	No	5-5th Floor Res	500	NA	NA	0.027	☒	☐	☐	☐
11-Hallway 5-Trm	VAVNoReheatBox	1	NA	NA	NA	11-Hallway 5	50	50	1.00	NA	NA	☐	☐	☐
10-Hallway 4-Trm	VAVNoReheatBox	1	NA	NA	NA	10-Hallway 4	50	50	1.00	NA	NA	☐	☐	☐
9-Hallway 3-Trm	VAVNoReheatBox	1	NA	NA	NA	9-Hallway 3	50	50	1.00	NA	NA	☐	☐	☐
8-Hallway 2-Trm	VAVNoReheatBox	1	NA	NA	NA	8-Hallway 2	50	50	1.00	NA	NA	☐	☐	☐
6-Hallway 1-Trm	VAVNoReheatBox	1	NA	NA	NA	6-Hallway 1	200	200	1.00	NA	NA	☐	☐	☐
5-5th Floor Res-Trm	VAVNoReheatBox	7	NA	NA	NA	5-5th Floor Res	35	35	1.00	NA	NA	☐	☐	☐
4-4th Floor Res-Trm	VAVNoReheatBox	7	NA	NA	NA	4-4th Floor Res	35	35	1.00	NA	NA	☐	☐	☐
3-3rd Floor Res-Trm	VAVNoReheatBox	7	NA	NA	NA	3-3rd Floor Res	35	35	1.00	NA	NA	☐	☐	☐
2-2nd Floor Res-Trm	VAVNoReheatBox	3	NA	NA	NA	2-2nd Floor Res	35	35	1.00	NA	NA	☐	☐	☐
1-2nd Floor Commercial Off-Trm	VAVNoReheatBox	4	NA	NA	NA	1-2nd Floor Commercial Off	70	70	1.00	NA	NA	☐	☐	☐

C. EXHAUST FAN SUMMARY						Confirmed	
System ID	Zone Name	Qty	CFM	Motor BHP	Total Static Pressure (in H2O)	Pass	Fail
2nd Floor Commercial Off3	1-2nd Floor Commercial Off	4	30	0.008	1.02	☐	☐
2nd Floor Res34	2-2nd Floor Res	4	30	0.008	1.02	☐	☐
3rd Floor Res60	3-3rd Floor Res	7	30	0.010	1.26	☐	☐
4th Floor Res108	4-4th Floor Res	7	30	0.010	1.26	☐	☐
5th Floor Res151	5-5th Floor Res	7	30	0.008	1.02	☐	☐

CA Building Energy Efficiency Standards- 2016 Nonresidential Compliance Report Version: NRCC-PRF-01-E-06262019-5583 Report Generated at: 2020-08-27 16:22:51

Project Name:	42 Otis	NRCC-PRF-01-E	Page 22 of 23
Project Address:	42 Otis San Francisco 94103	Calculation Date/Time:	16:21, Thu, Aug 27, 2020
Compliance Scope:	NewEnvelopeAndMechanical	Input File Name:	M17-162 - 42 Otis_Addendum 3_Perf.cbld16x

G. MECHANICAL HVAC ACCEPTANCE TESTS & FORMS (Adapted from 2016-NRCC-MCH-01-E)											§ RA4																																																																																																																																																																																																																																																																																																																																																																																																																																																																																																																																																																																															
Declaration of Required Acceptance Certificates (NRCA) - Acceptance Certificates that may be submitted. (Retain copies and verify forms are completed and signed to post in field for Field Inspector to verify).											Confirmed																																																																																																																																																																																																																																																																																																																																																																																																																																																																																																																																																																																															
Test Description	MCH-02A	MCH-03A	MCH-04A	MCH-586A	MCH-58

STATE OF CALIFORNIA
Solar Ready Areas
 NRCC-SRA-E (Created 11/19) CALIFORNIA ENERGY COMMISSION

CERTIFICATE OF COMPLIANCE		NRCC-SRA-E
Project Name: 42 Otis Street	Report Page:	Page 5 of 5
Project Address: 42 Otis Street	Date Prepared:	08/27/2020

DOCUMENTATION AUTHOR'S DECLARATION STATEMENT
 I certify that this Certificate of Compliance documentation is accurate and complete

Documentation Author Name: MENG HSIU CHEN	Documentation Author Signature:
Company: MHC ENGINEERS, INC	Signature Date: 08/27/2020
Address: 150 8TH STREET	CEA/HERS Certification Identification (if applicable):
City/State/Zip: CALIFORNIA	Phone: 415-512-7141

RESPONSIBLE PERSON'S DECLARATION STATEMENT
 I certify the following under penalty of perjury, under the laws of the State of California:

- The information provided on this Certificate of Compliance is true and correct.
- I am eligible under Division 3 of the Business and Professions Code to accept responsibility for the building design or system design identified on this Certificate of Compliance [responsible designer]
- The energy features and performance specifications, materials, components, and manufactured devices for the building design or system design identified on this Certificate of Compliance conform to the requirements of Title 24, Part 1 and Part 6 of the California Code of Regulations.
- The building design features or system design features identified on this Certificate of Compliance are consistent with the information provided on other applicable compliance documents, worksheets, calculations, plans and specifications submitted to the enforcement agency for approval with this building permit application.
- I will ensure that a completed signed copy of this Certificate of Compliance shall be made available with the building permit(s) issued for the building, and made available to the enforcement agency for all applicable inspections. I understand that a completed signed copy of this Certificate of Compliance is required to be included with the documentation the builder provides to the building owner at occupancy.

Responsible Designer Name:	Responsible Designer Signature:
Company:	Date Signed:
Address:	License:
City/State/Zip:	Phone:

CA Building Energy Efficiency Standards - 2019 Nonresidential Compliance: <http://www.energy.ca.gov/title24/2019standards> November 2019

City and County of San Francisco
 Department of Building Inspection



London N. Breed, Mayor
 Tom C. Hui, S.E., C.B.O., Director

NOTICE

TITLE-24 NON-RESIDENTIAL ENERGY/GREEN INSPECTION REQUIREMENTS (BUILDING)

Please note that Certificates of Installation and/or Acceptance and/or Verification are required for this project, as indicated on this form issued with this permit. Ensuring the accurate completion of this documentation is the direct responsibility of the engineer/architect of record. This documentation is required *in addition* to the called inspections performed by the Department of Building Inspection.

For questions regarding the details or extent of required documentation or testing, and if there are any field problems regarding documentation or testing, please call your District Building Inspector or 415-558-6570.

Before final building inspection is scheduled, documentation of energy compliance "Certificate of Installation, Acceptance, and Verification" and green building "Attachment E" must be completed and signed by the responsible person in charge. **The permit will not be finalized without compliance with the energy inspection requirements.**

Energy Inspection Services Contact Information

- Telephone: (415) 558-6132
- Fax: (415) 558-6474
- Email: dbi.energyinspections@sfgov.org
- In person: 3rd floor at 1660 Mission St.

Note: We are moving towards a 'paperless' mode of operation. All special inspection submittals, including final letters, may be emailed (preferred) or faxed. We will also be shifting to a paperless fax receipt mode.

Installation, Acceptance, and Verification certificates can be found on the California Energy Commission website at <http://energy.ca.gov/title24/2016standards/>

Information Sheet M-06 provides submittal instructions for the Title-24 installation, verification, and acceptance energy certificates and Green Building Attachment E. M-06 may be found on the SFDBI website at <http://sfdbi.org/information-sheets>

Energy Inspection Services
 1660 Mission Street - San Francisco CA 94103
 Office (415) 558-6132 - FAX (415) 558-6474 - www.sfgov.org/dbi (website) Rev 10/16/2019

TITLE-24 NON-RESIDENTIAL ENERGY/GREEN INSPECTION (BUILDING)
 A COPY OF THIS DOCUMENT SHALL BE KEPT WITH THE APPROVED DRAWING SET
Attachment NRB

JOB ADDRESS: 42 OTIS APPLICATION NO. ADDENDUM NO.
 ENGINEER/ARCHITECT NAME: MHC ENGINEERS, INC PHONE NO. (415) 512-7141

Ensuring the completion of installation documentation as well as the required acceptance/verification testing is the direct responsibility of the undersigned. Installation documentation must be completed by the contractor performing the installation. Acceptance testing must be performed by an individual licensed to perform the specific testing needed. Verification testing must be completed by a certified HERS rater. Green Building Attachment E shall be completed as per SFGBC AB-093.

In accordance with the requirements of the 2016 California Energy Code and 2016 SFGBC AB-093, the following documentation is required for the building elements in this project:

- Installation**
 - Envelope
 - NRCA-ENV-01-E Envelope (IB35)
 - Mechanical
 - NRCA-MCH-01-E Mechanical (IB36)
 - Process
 - NRCA-PRC-01-E Covered Processes (IB37)
- Acceptance**
 - Envelope
 - NRCA-ENV-02-F Fenestration Acceptance (AB1)
 - Mechanical
 - NRCA-MCH-02-A Outdoor Air (AB2)
 - NRCA-MCH-03-A Constant Volume Single Zone HVAC (AB3)
 - NRCA-MCH-04-H HERS Air Distribution Duct Leakage Testing (AB4)
 - NRCA-MCH-05-A Air Economizer Controls (AB5)
 - NRCA-MCH-06-A Demand Control Ventilation (DVC) (AB6)
 - NRCA-MCH-07-A Supply Fan Variable Flow Controls (VFC) (AB7)
 - NRCA-MCH-11-A Automatic Demand Shed Controls (AB8)
 - NRCA-MCH-12-A Fault Detection & Diagnostics for DX Units (AB9)
 - NRCA-MCH-13-A Automatic Fault Detection & Diagnostics for Air Handling & Zone Terminal Units (AB10)
 - NRCA-MCH-14-A Distributed Energy Storage DX AC Systems Test (AB11)
 - NRCA-MCH-15-A Thermal Energy Storage (TES) Systems (AB12)
 - NRCA-MCH-16-A Supply Air Temperature Reset Controls (AB13)
 - NRCA-MCH-18-A Energy Management Control System (AB14)
 - Process
 - NRCA-PRC-01-F Compressed Air Systems (AB15)
 - NRCA-PRC-02-F Commercial Kitchen Exhaust (AB16)
 - NRCA-PRC-03-F Parking Garage Exhaust (AB17)
 - NRCA-PRC-04-F Refrigerated Warehouse - Evaporator Fan Controls (AB18)
 - NRCA-PRC-05-F Refrigerated Warehouse - Evaporative Condenser Controls (AB19)
 - NRCA-PRC-06-F Refrigerated Warehouse - Air-cooled Condenser Controls (AB20)
 - NRCA-PRC-07-F Refrigerated Warehouse - Variable Speed Compressor (AB21)
 - NRCA-PRC-08-F Refrigerated Warehouse - Electric Resistance Underdrain Heating System (AB22)
 - NRCA-PRC-12-F Elevator Lighting & Ventilation Controls (AB23)
 - NRCA-PRC-13-F Escalators & Moving Walkways Speed Controls (AB24)
- Verification**
 - Mechanical
 - NRCV-MCH-04a-H HERS Duct Leakage Measurement - New System (VB30)
 - NRCV-MCH-04b-H HERS Duct Leakage Measurement - Low Leakage Air-Handling Units (VB31)
 - NRCV-MCH-04c-H HERS Duct Leakage Measurement - Altered (Existing) System (VB32)
 - NRCV-MCH-04e-H HERS Duct Leakage Measurement - Sealing of All Accessible Leaks (VB33)
- Green Building (For New Construction and Major Alterations)**
 - Green Building Attachment E (GBCE1)

Required information:
 Prepared by: MENG HSIU CHEN Date: 1/7/2019

Fax: Email:

Review by: Phone: (415) 558-

APPROVAL (Based on submitted reports)

DATE DBI Building Inspector or Energy Inspection Services Staff

QUESTIONS ABOUT TITLE-24 ENERGY INSPECTION SHOULD BE DIRECTED TO:
 Energy Inspection Services (415) 558-6132; or, dbi.energyinspections@sfgov.org; or FAX (415) 558-6474

Revised 10/16/2019

REVISION DATE	REVISION BY
03/25/2020	
01/10/2020	
03/29/2019	

REVISION DESCRIPTION

ADDENDUM 3

PERMIT ADDENDUM

DD DRAFT

ENGINEER OF RECORD:

MHC ENGINEERS
 150 8TH STREET
 SAN FRANCISCO, CA 94103
 PH: (415) 512-7141
 FAX: (415) 512-7120

42 OTIS STREET
 SAN FRANCISCO, CALIFORNIA

TITLE 24 DOCUMENTS



DATE: 02/01/2019
 APPROVED: MHC
 DRAWN: RML
 JOB: MHC #M17-162

T24.3
 4/3

CONSTRUCTION NOTES

- 1 LIMIT OF IMPROVEMENT. MATCH EXISTING GRADES, PROVIDE SMOOTH TRANSITION AND POSITIVE DRAINAGE.
- 2 SAW CUT AND REMOVE MINIMUM 2' WIDE EXISTING ASPHALT CONCRETE PAVEMENT AND CONCRETE BASE. CONSTRUCT 2' WIDE, 8" THICK CONCRETE BASE AND 2" ASPHALT CONCRETE PAVEMENT PER DETAIL NO. 1 ON THIS SHEET.
- 3 SAW CUT AT EXISTING JOINT AND REMOVE EXISTING CURB. CONSTRUCT 6" CURB, PARKING STRIP AND JOINTS PER CITY STANDARD DETAIL FILE 87,170 (OLD FILE L-24,456 CH. 1) AND FILE 87,173 (OLD FILE L-31,374 CH. 1).
- 4 SAW CUT AND REMOVE EXISTING CONCRETE SIDEWALK. CONSTRUCT NEW CONCRETE SIDEWALK PER DETAIL NO. 1 ON THIS SHEET AND CITY STANDARD PLAN FILE L31,374 CH.1 AND 96,608. CONTRACTOR SHALL REFER TO ARCHITECTURAL PLANS FOR SCORE LINE PATTERN. CONSTRUCT EXPANSION AND CONSTRUCTION JOINTS PER CITY STANDARD DETAIL FILE NO. 96,608.
- 5 SAWCUT AT NEAREST JOINT AND PROVIDE CONNECTION BETWEEN EXISTING AND NEW SIDEWALK PER DPW STANDARD DRAWING NO. 96,608 AND DPW ORDER 181,306.
- 6 EXISTING UTILITY/PARKING METER TO REMAIN. CONTRACTOR SHALL ADJUST TO MATCH NEW FINISH GRADE OF SIDEWALK.
- 7 CONTRACTOR TO INSTALL NEW STORM SEWER AND SANITARY SEWER LATERAL FROM BUILDING WITH CLEANOUT AND P-TRAP AND CONNECT TO EXISTING CITY MAIN SEWER PIPE PER CITY STANDARD PLAN FILE 87,196. CONTRACTOR SHALL APPLY FOR THE SIDE SEWER CONNECTION WITH DPW AND MAKE THE CONNECTION TO THE MAIN PRIOR TO BUILDING PLUMBING INSTALLATION. IF THERE IS A CONFLICT, CONTRACTOR SHALL NOTIFY THE CIVIL ENGINEER FOR AN ALTERNATE DESIGN. CONNECT BUILDING LATERALS TO THE SEWER CLEANOUTS, VERIFY PIPE SIZE AND FLOW LINE INFO ON THE PLUMBING/ARCHITECTURAL PLAN PRIOR TO INSTALLING SIDE SEWER PIPE. ANY LANDSCAPE OR SUBSURFACE DRAINAGE SHALL PASS THROUGH A SAND TRAP WITHIN THE PROPERTY PRIOR TO CONNECTION TO CITY MAIN. REMOVE EXISTING SEWER SERVICE THAT IS CONFLICT WITH PG&E TRANSFORMER.
- 8 CONTRACTOR SHALL APPLY FOR WATER CONNECTION TO BUILDINGS. OWNER SHALL PAY ALL RELATED FEES, OBTAIN THE BUILDING WATER DEMAND INFO FROM THE PLUMBING PLAN, AND COORDINATE WITH WATER DEPARTMENT FOR THEM TO DETERMINE THE METER AND LATERAL SIZE, AND INSTALL THEIR WATER METER. CONNECT TO THE BUILDING WATER SYSTEM PER PLUMBING PLANS AND REFER TO PLUMBING PLANS FOR FINAL PIPE SIZES AND LOCATION. CONTRACTOR SHALL OBTAIN APPROVAL FROM THE WATER QUALITY CONTROL DIVISION FOR THE TYPE OF BACK FLOW DEVICE PRIOR TO INSTALLATION. CONTRACTOR SHALL VERIFY AND REFER TO THE ARCHITECTURAL OR PLUMBING DRAWINGS FOR FINAL BFP LOCATION. CONTRACTOR SHALL INSTALL CONCRETE THRUST BLOCKS AS NECESSARY PER SFWD DETAILS WHERE PIPES CHANGE DIRECTION. CONTRACTOR TO DO ALL EXCAVATION, BACKFILLING, PAVING AND RESTORATION, SFWD TO INSTALL PIPING FROM MAIN TO METER, INCLUDING METER.
- 9 PROPOSED TREE WELL, TREE TO BE 3 FEET FROM WATER UTILITIES/SERVICE LATERALS. OWNER/ARCHITECT/CONTRACTOR TO APPLY FOR A NEW TREE OR LANDSCAPING PERMIT FROM URBAN FORESTRY, 1680 MISSION STREET, SF CA 94103, 415-554-6700.
- 10 RECONSTRUCT DRIVEWAY FLARE TO RAISE SIDEWALK TO STANDARD SLOPE
- 11 CONSTRUCT CITY STANDARD CIRCULAR PROFILE SQUARE TUBING, SURFACE-MOUNTED, ZINC COATED/GALVANIZED BIKE RACK WITH ZINC PLATED CARBON STEEL FASTENERS PER SFMTA APPENDIX D BICYCLE RACK SPECIFICATIONS. THE RACKS MEET ALL THE MINIMUM CLEARANCES SPECIFIED ON PAGE 21 OF THE SFMTA BIKE PARKING GUIDELINES AND WILL MATCH THE CITY STANDARD BIKE RACKS. THEY WILL BE ATTACHED WITH SIDEWALK RACK MOUNTING HARDWARE EXPANSION BOLTS, MUSHROOM SPIKED AND FLANGES PER SECTION 9.2 OF THE GUIDELINE. SEE ARCHITECTURAL/LANDSCAPE PLANS FOR EXACT LOCATIONS.
- 12 CONSTRUCT PG&E TRANSFORMER, SEE JOINT TRENCH/ELECTICAL PLANS. REMOVALS OF EXISTING PG&E INFRASTRUCTURE MAY BE REQUIRED
- 13 EXISTING GAS SERVICE TO BE ABANDONED.
- 14 PARKING METER MAY NEED TO BE RELOCATED, IN CONFLICT WITH PROPOSED TREE WELL/TRANSFORMER. CONTRACTOR TO CONTACT AND COORDINATE WITH SFMTA ON GETTING METER REMOVED PRIOR TO SIDEWALK WORK AND REINSTALLED AFTER SIDEWALK WORK IS COMPLETE.
- 15 LOCATION OF GAS PIPE FOR BUILDING GAS SUPPLY SHOWN FOR REFERENCE ONLY. SEE PLUMBING/ARCHITECTURAL BUILDING PLAN FOR GAS METER LOCATION, EXACT PIPE SIZE, BUILDING P.O.C. AND CONTINUATION.
- 16 SQUARE OFF EXISTING PAVEMENT WHERE DISTANCE BETWEEN EXISTING/PROPOSED TRENCHES CROSSING THE STREET IS LESS THAN 50 FEET. GRIND EXISTING PAVEMENT AND OVERLAY WITH MINIMUM 2" OF NEW AC PER DPW STANDARDS.
- 17 CONTRACTOR SHALL APPLY FOR FIRE WATER CONNECTION TO BUILDING. OWNER SHALL PAY ALL RELATED FEES AND COORDINATE WITH WATER DEPARTMENT. CONTRACTOR SHALL INSTALL THE BACK FLOW PREVENTOR PER WATER QUALITY CONTROL DIVISION REQUIREMENTS. CONTRACTOR SHALL OBTAIN APPROVAL FROM THE WATER QUALITY CONTROL DIVISION FOR THE TYPE OF BACK FLOW DEVICE PRIOR TO INSTALLATION. CONTRACTOR SHALL VERIFY AND REFER TO THE ARCHITECTURAL OR FIRE PROTECTION DRAWINGS FOR FINAL BFP LOCATION. CONTRACTOR SHALL INSTALL CONCRETE THRUST BLOCKS AS NECESSARY PER SFWD DETAILS WHERE PIPE CHANGES DIRECTION. TREES TO BE 3 FEET FROM WATER UTILITIES/SERVICE LATERALS. CONTRACTOR TO DO ALL EXCAVATION, BACKFILLING, PAVING AND RESTORATION, SFWD TO INSTALL PIPING FROM MAIN TO BACK OF CURB.
- 18 EXISTING UTILITY TO BE REMOVED, CONTRACTOR TO COORDINATE WORK WITH CITY/UTILITY AGENCIES PRIOR TO EXISTING SITE DEMOLITION.
- 19 PROPOSED CONNECTION TO EXISTING 3'x5' BRICK EGG-SHAPED SEWER MAIN ON OTIS STREET SHALL BE MADE PER TYPE 6 DETAIL OF SFPUC SEWER LATERAL STANDARD DETAILS (SHEET 11), SHOWN ON SHEET C-1. NEW LATERAL SHALL CONNECT TO THE MAIN BETWEEN 2 O'CLOCK AND 4 O'CLOCK OR 8 O'CLOCK AND 10 O'CLOCK POSITIONS. IN NO CASE SHALL THE CONNECTION BE WITHIN 18 INCHES OF THE INVERT.

APN NII 2003

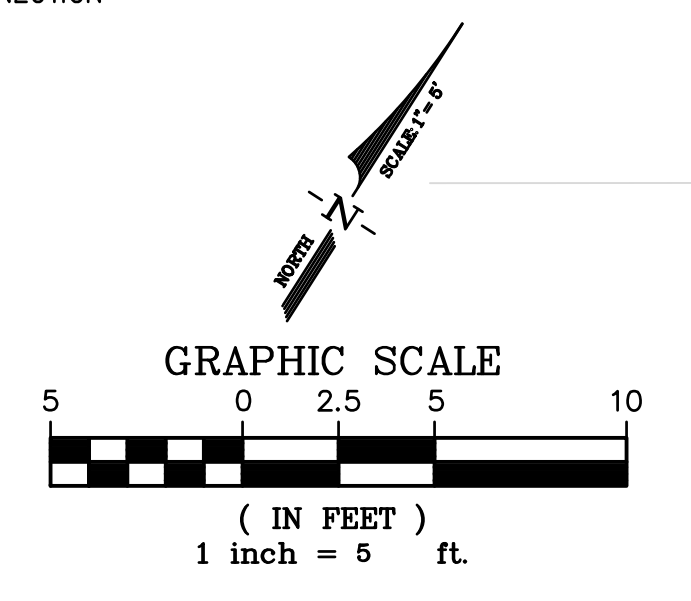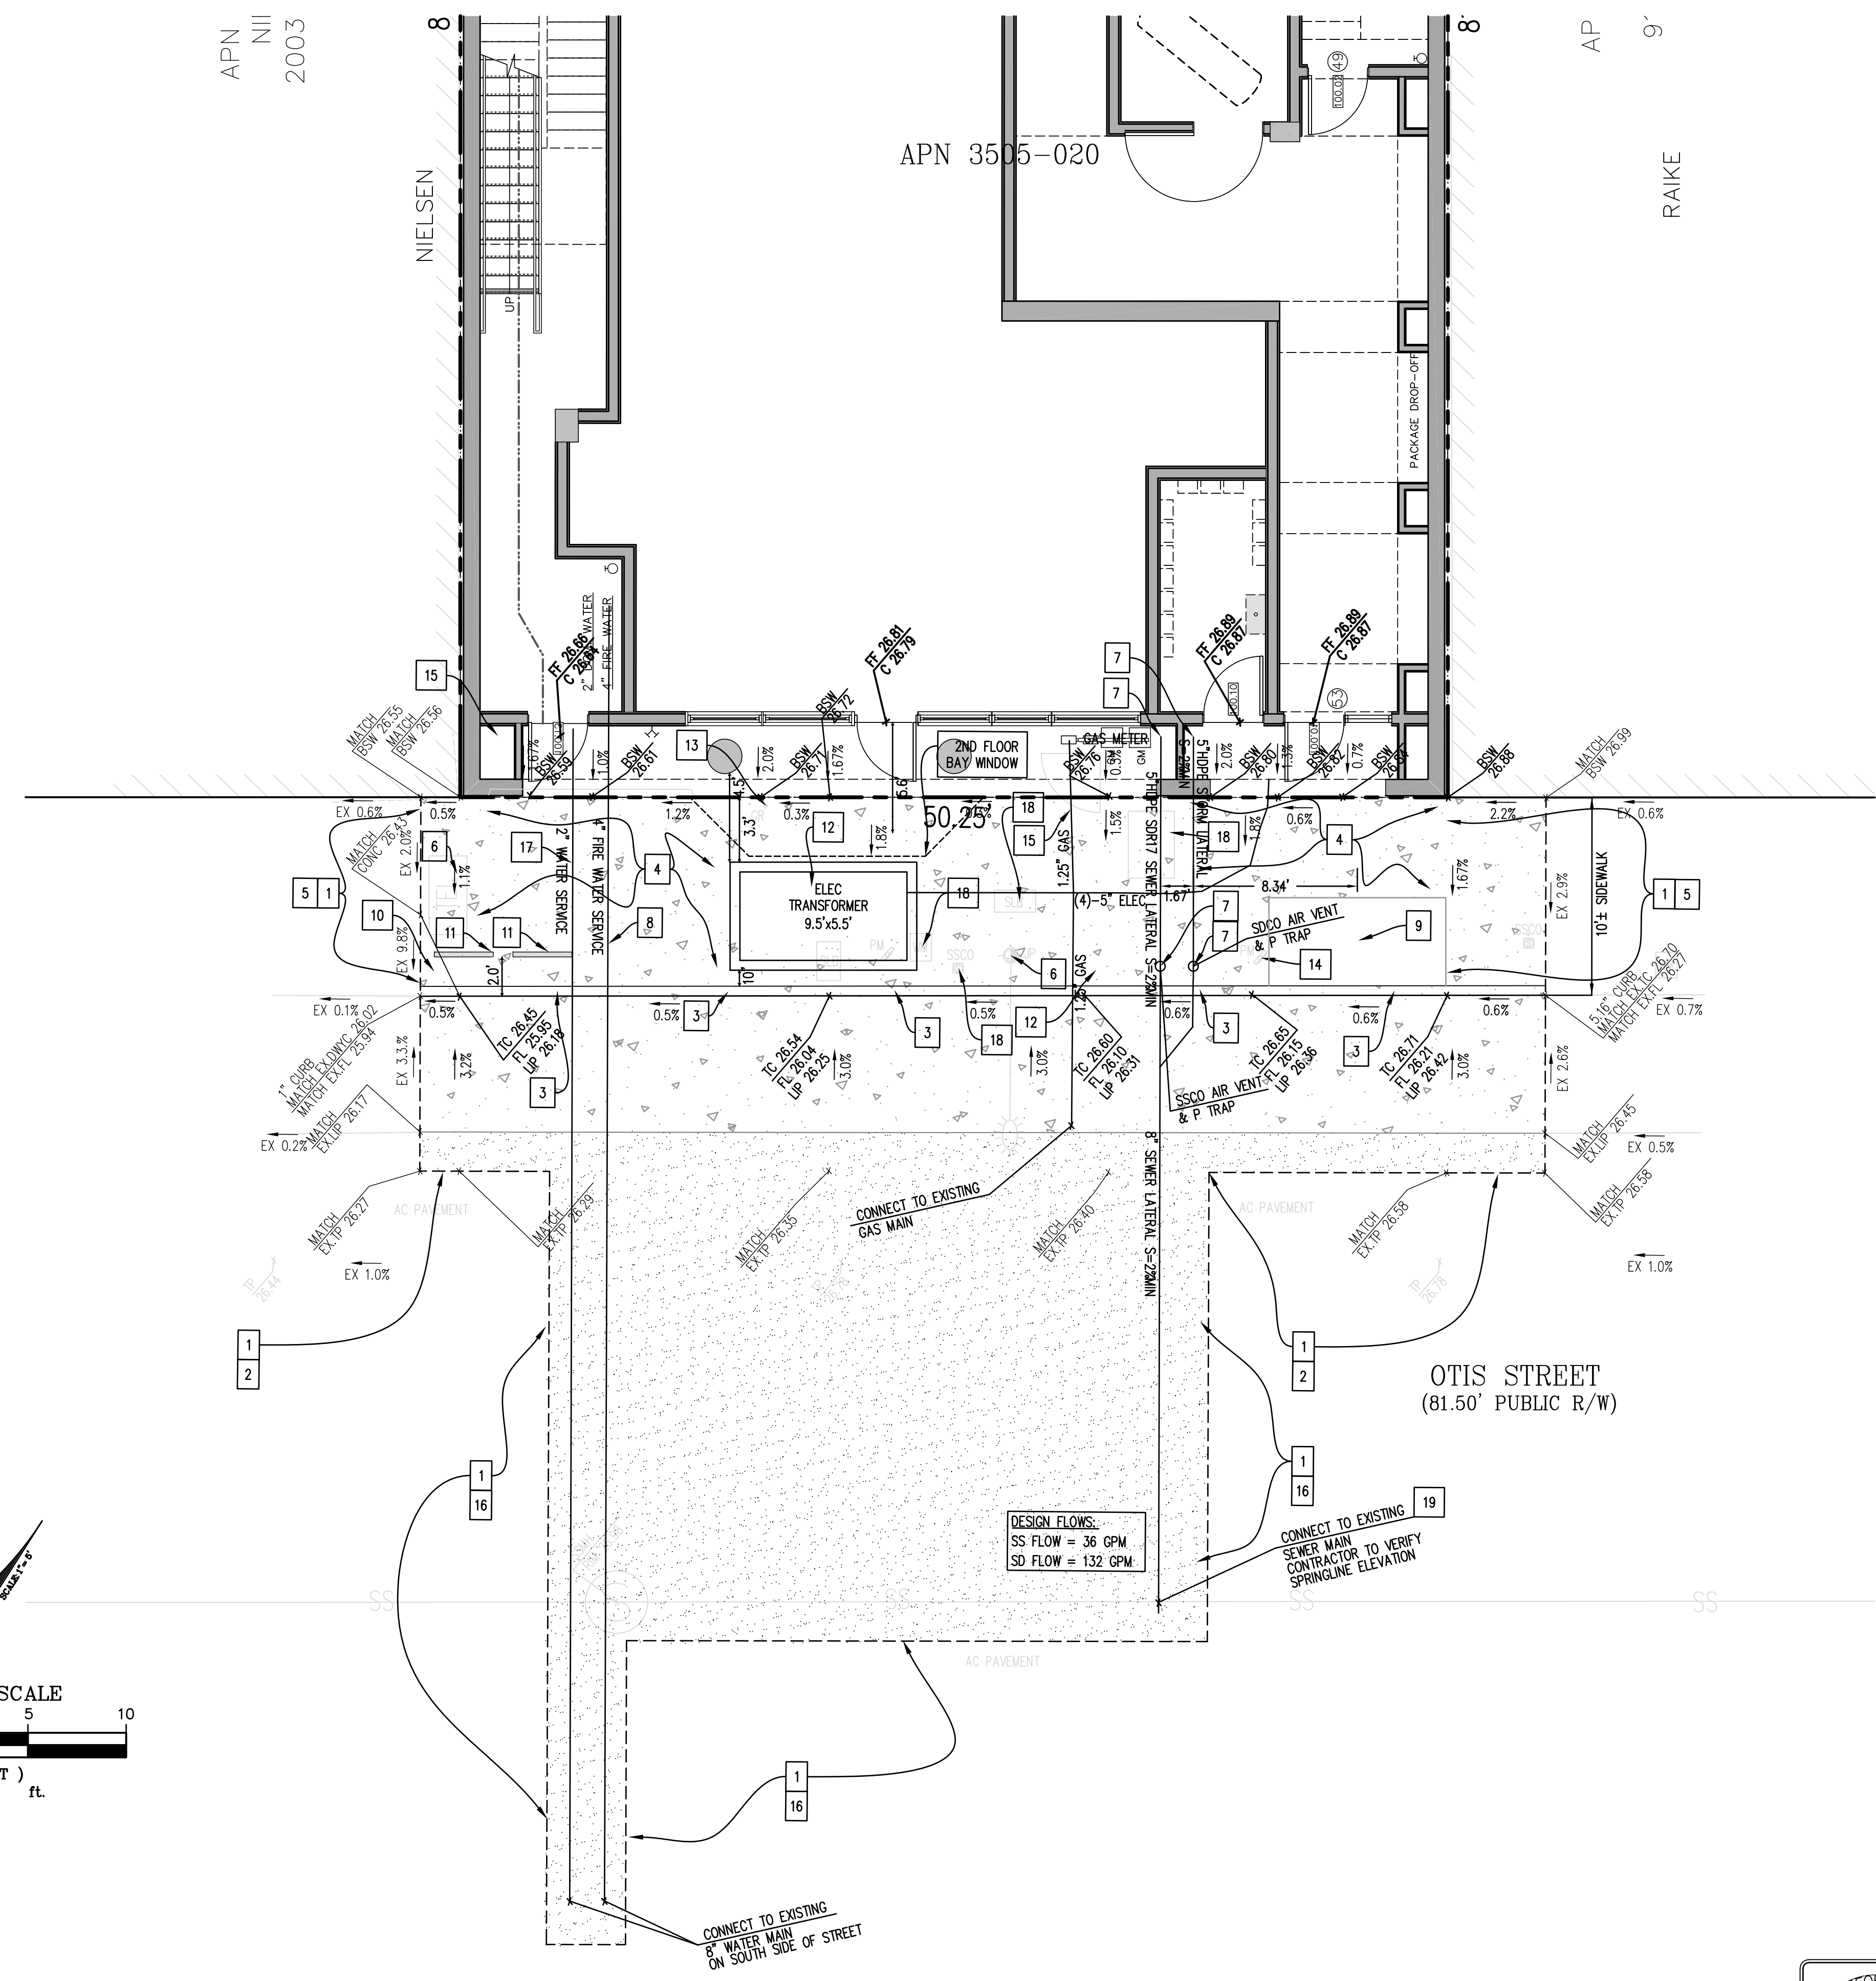


IMPROVEMENT PLAN

SCALE = 1" = 5'

Luk and Associates

Civil Engineering
Land Planning
Land Surveying
738 Alfred Nobel Drive
Hercules, CA 94547
Phone (510) 724-3388
Fax (510) 724-3383
Email: aluk@lukassociates.com

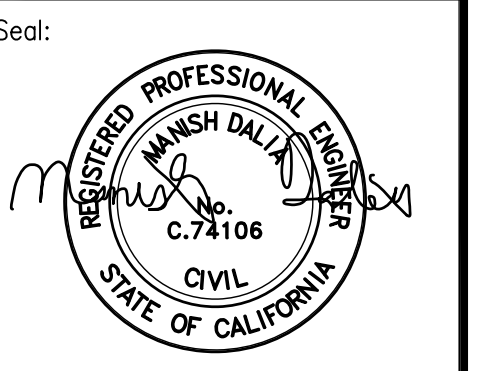


MIXED-USE BUILDING IMPROVEMENT PLAN


42 OTIS STREET
SAN FRANCISCO, CA 94103

NO.	DATE	DESCRIPTION

Title: IMPROVEMENT PLAN
Date: AUGUST, 2019
Scale: AS SHOWN
Drawn By: D.A.D.
Checked By: J.L. / M.D.
Job No.: 17167A10
Drawing No.: MASTER-17167A10.dwg
Plot Date: 8/31/2020
Sheet No.: C-2

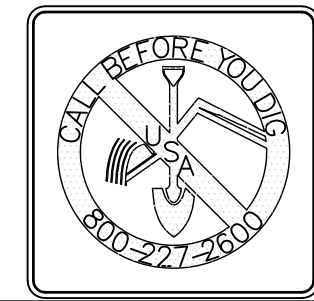

XREF: MASTOPO BLDG, GF
SNAP SHOT: BY VIEWPORT

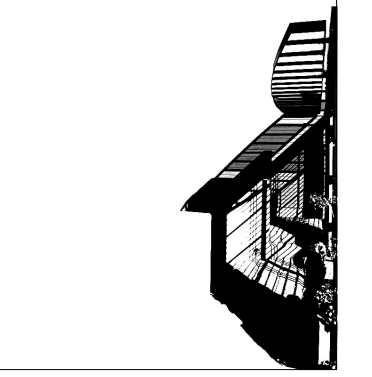

ELEVATIONarchitects
1159 Green Street, Suite 4
San Francisco, CA 94109

415.537.1125 :v
www.elevationarchitects.com :w



agency stamps:

Condominiums
42 Otis Street
San Francisco, CA 94103
Block / Lot : 3503 / 020


#	date	issue
2	4.15.20	Project Revision 2
3	4.27.20	Plan Check Response 2
4	8.17.20	Plan Check Response 3

sheet count 19/49



(E) Site Plan &
(N) Site Plan

project: 16.15
drawn by: CT
checked by: JP
date: 03.23.17
scale:


A-1.1

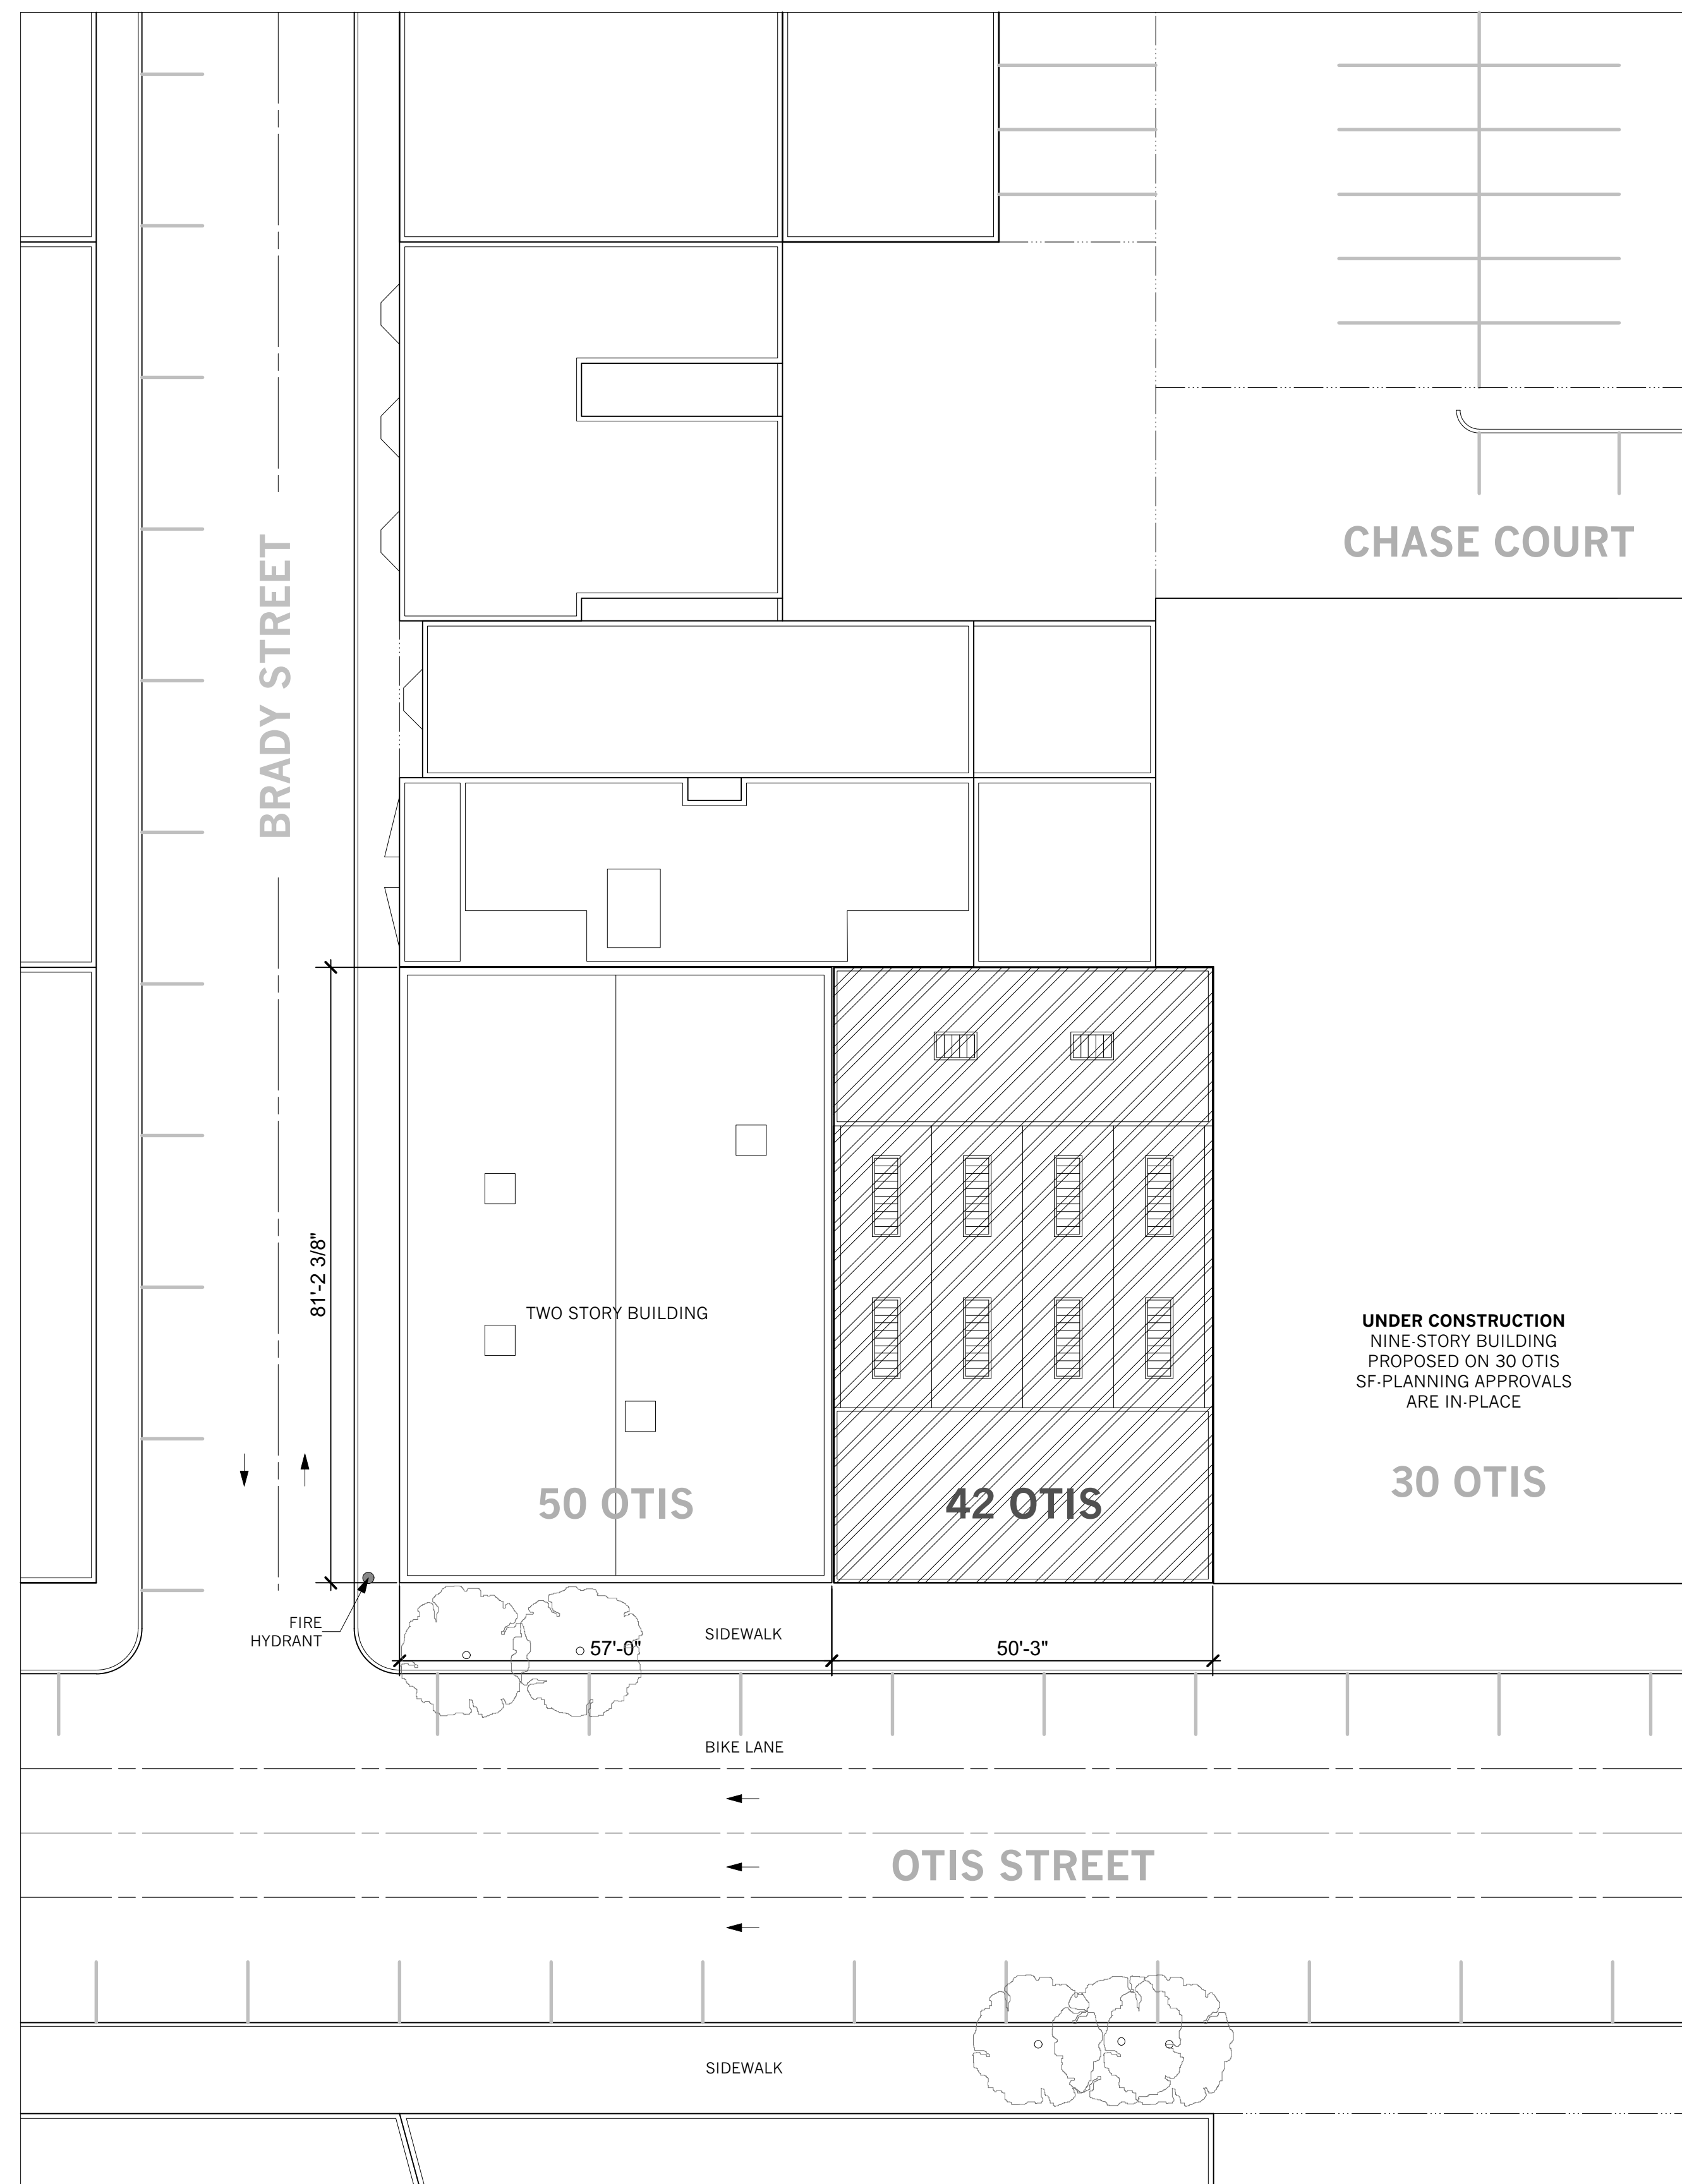

2 EXISTING SITE PLAN
Scale: 1/16" = 1'-0"

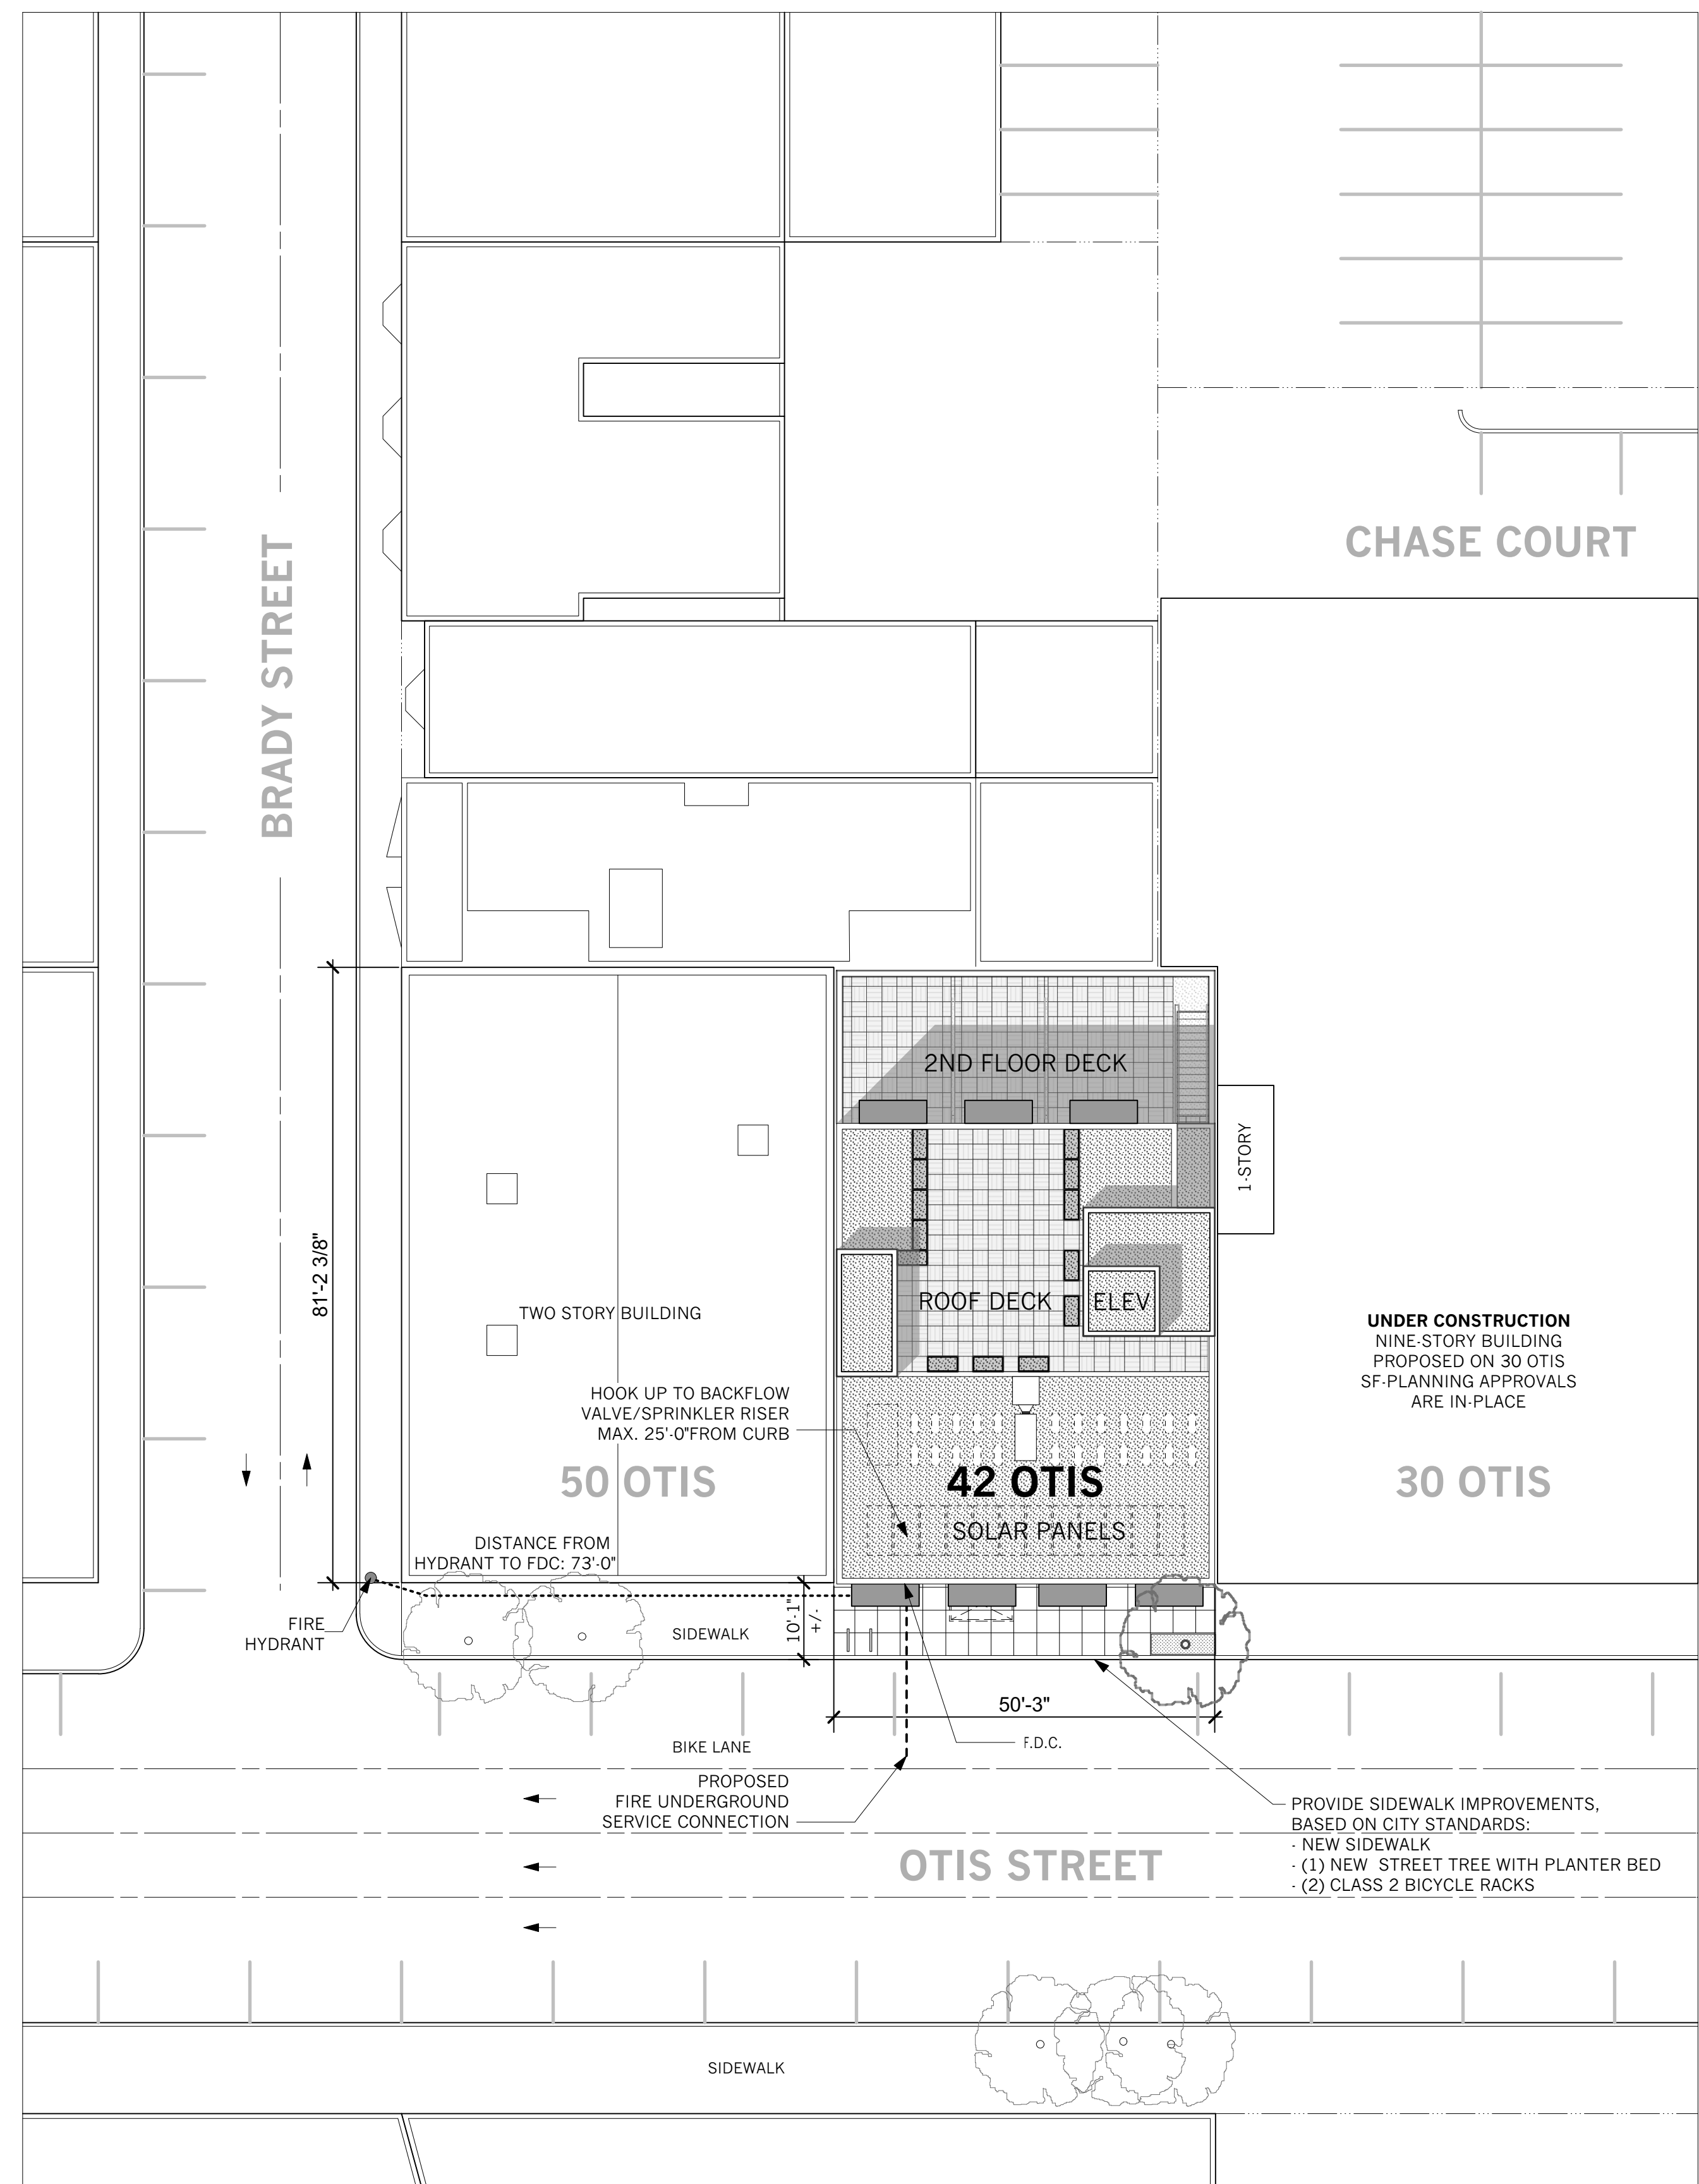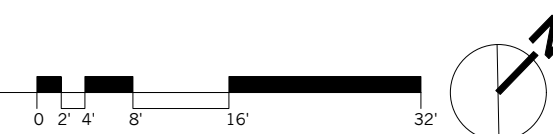

1 PROPOSED SITE PLAN
Scale: 1/16" = 1'-0"

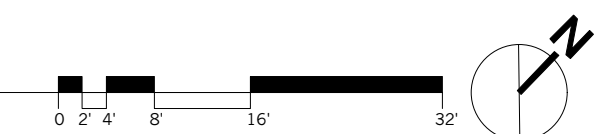

GROSS FLOOR AREA: RESIDENTIAL COMMON AREA = 1787 SQ.FT. COMMERCIAL SPACE = 2105 SQ.FT. TOTAL = 3892 SQ.FT.	EXITING: OCCUPANCY TYPE: S RESIDENTIAL LOAD FACTOR: 200 GSF/PERSON BICYCLE PARKING: 285 SF/200 SF = 2 PEOPLE	EXITING: EXIT WIDTH REQUIRED: 0.2 IN. PER OCCUPANT: 0.2' x 25 = 5.0' STAIR-1 EXIT DOOR: 36 IN. PROVIDED > 5.0 IN. STAIR-2 EXIT DOOR: 36 IN. PROVIDED > 5.0 IN.
COMMON PATH OF TRAVEL: COMMERCIAL SPACE = 63'-10" < 75'-0"	EXITING: OCCUPANCY TYPE: M OCCUPANT LOAD FACTOR: 60 GSF/PERSON COMMERCIAL SPACE: 2105 SF/60 SF = 36 PEOPLE 1 EXIT REQ. 2 EXITS PROVIDED	EXIT WIDTH REQUIRED: 0.2 IN. PER OCCUPANT: 0.2' x 18 = 3.6 IN. ENTRY DOOR: 36 IN. PROVIDED > 3.6 IN.
MAXIMUM TRAVEL DISTANCE: BICYCLE STORAGE = 95'-0"FT < 100'		STAIR WIDTH REQUIRED: 0.3 IN. PER OCCUPANT: 0.3' x 25 = 7.5 IN. 36 IN. PROVIDED AS PER 2016 CBC SECTION 1011.2 EXCEPTION 1
		BUILDING DIAGONAL: 95'-0" 1/3 DIAGONAL: 31'-8" EXIT ACCESS SEPARATION: 41'-6" > 31'-8"




ELEVATIONarchitects

1159 Green Street, Suite 4
San Francisco, CA 94109

415.537.1125 v
www.elevationarchitects.com w




agency stamps:

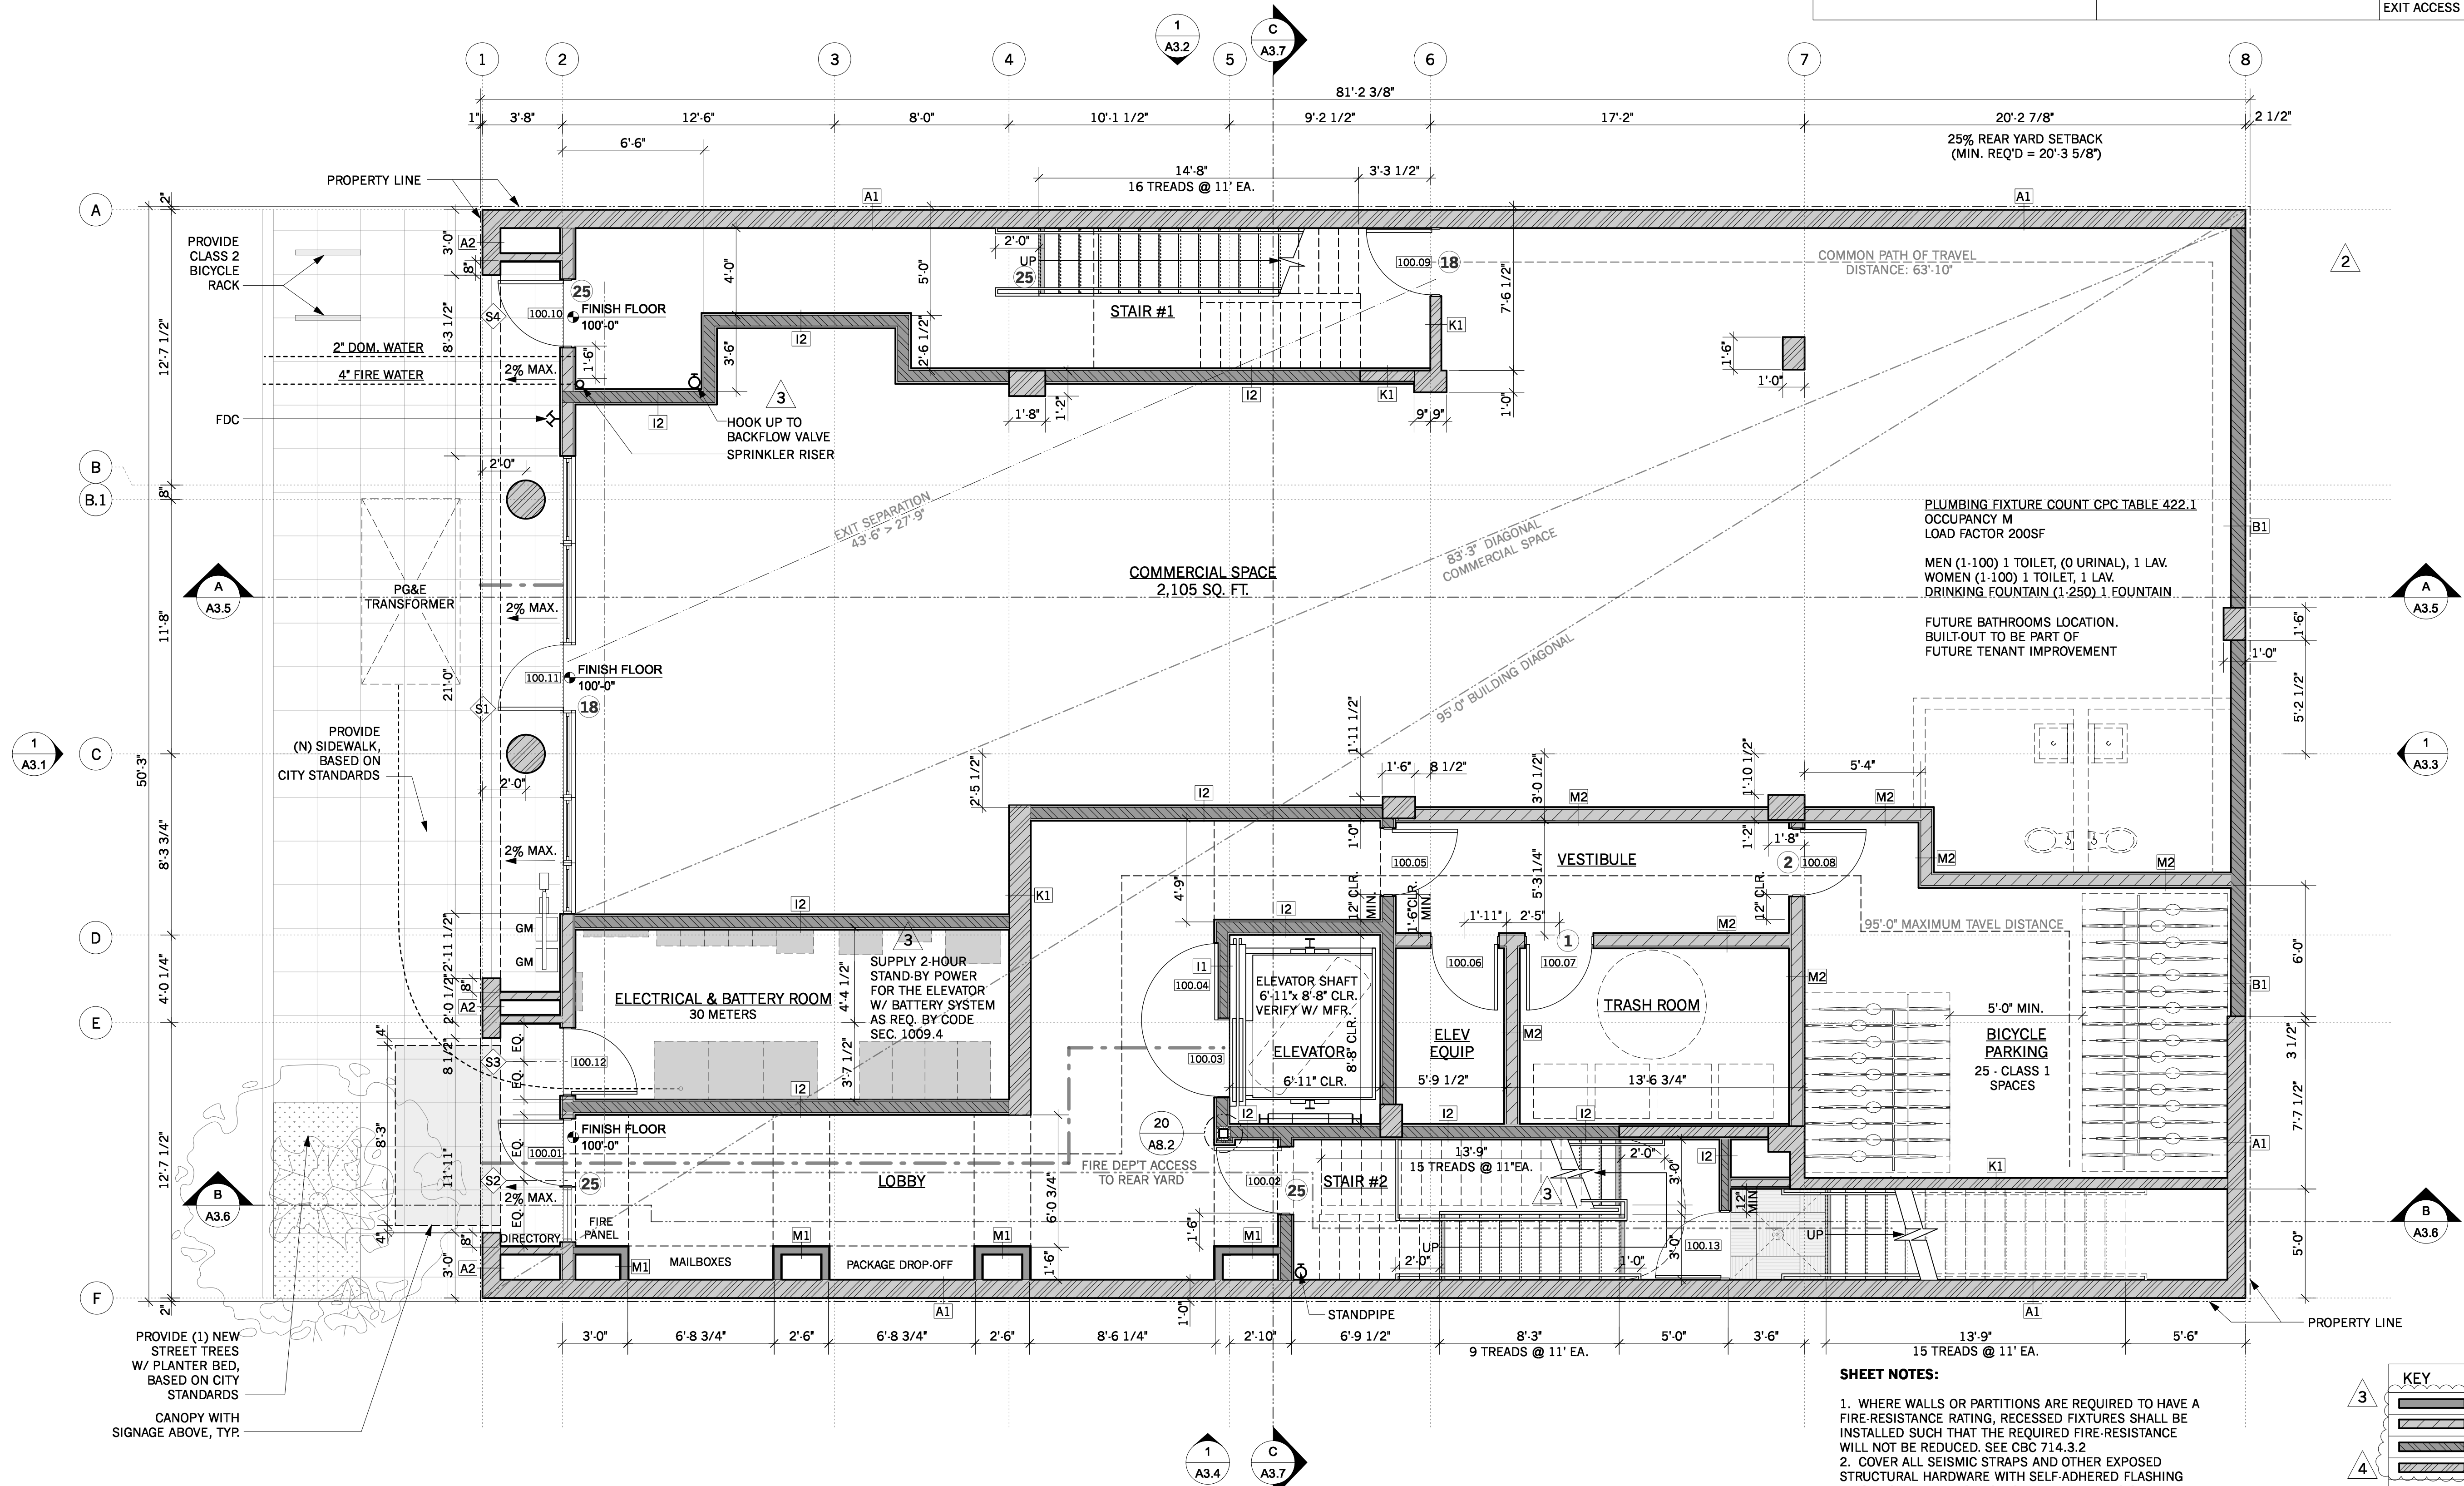

- SHEET NOTES:**
- WHERE WALLS OR PARTITIONS ARE REQUIRED TO HAVE A FIRE-RESISTANCE RATING, RECESSED FIXTURES SHALL BE INSTALLED SUCH THAT THE REQUIRED FIRE-RESISTANCE WILL NOT BE REDUCED. SEE CBC 714.3.2
 - COVER ALL SEISMIC STRAPS AND OTHER EXPOSED STRUCTURAL HARDWARE WITH SELF-ADHERED FLASHING PRIOR TO THE APPLICATION OF THE WATER-RESISTIVE BARRIER
 - FIREBLOCKING SHALL BE PROVIDED IN CONCEALED SPACES OF STUD WALLS AND PARTITIONS, INCLUDING FURRED SPACES, AND PARALLEL ROWS OF STUDS OR STAGGERED STUDS, AS FOLLOWS:
 - VERTICALLY AT THE CEILING AND FLOOR LEVELS.
 - HORIZONTALLY AT INTERVALS NOT EXCEEDING 10 FEET.
 - EMERGENCY EGRESS WINDOW TO HAVE:
 - NET CLEAR OPENABLE AREA OF 5.7 SQ.FT.
 - NET CLEAR HEIGHT 24" MINIMUM.
 - NET CLEAR WIDTH 20" MINIMUM.
 - SILL HEIGHT 44" MAXIMUM.

KEY	
(N) UNRATED WALL	(N) UNRATED WALL
(N) 1-HR WALL	(N) 1-HR WALL
(N) 2-HR WALL	(N) 2-HR WALL
(N) 3-HR WALL	(N) 3-HR WALL
----- COMMON PATH OF TRAVEL	----- COMMON PATH OF TRAVEL
----- EGRESS PATH OF TRAVEL	----- EGRESS PATH OF TRAVEL
----- ACCESSIBLE PATH OF TRAVEL	----- ACCESSIBLE PATH OF TRAVEL
(12) OCCUPANT LOAD	(12) OCCUPANT LOAD
□ RATED SHAFT	□ RATED SHAFT

1 FIRST FLOOR PLAN
Scale: 1/4" = 1'-0"

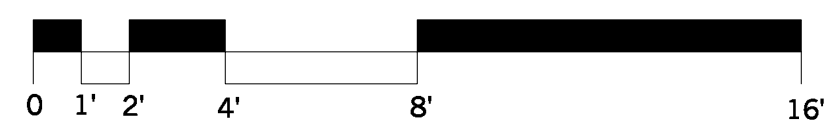

Condominiums
42 Otis Street
San Francisco, CA 94103
Block / Lot : 3503 / 020

#	date	issue
2	4.15.20	Project Revision 2
3	4.27.20	Plan Check Response 2
4	8.17.20	Plan Check Response 3

sheet count 20/49

1st Floor Plan

project: 16.15
drawn by: mka
checked by: jp
date: 01.21.19
scale:

A-2.1

UNIT 201 344 sqft	UNIT 207 343 sqft	UNIT 207 liv. 209 sqft total 299 sqft	UNIT 201 241 sqft 8% 19.4 sqft 4% 9.7 sqft	UNIT 207 231 sqft 8% 18.6 sqft 4% 9.3 sqft
UNIT 202 357 sqft	UNIT 206 338 sqft	UNIT 206 liv. 198 sqft total 300 sqft	UNIT 202 264 sqft 8% 21.2 sqft 4% 10.6 sqft	UNIT 206 234 sqft 8% 18.8 sqft 4% 9.4 sqft
UNIT 203 338 sqft	UNIT 205 397 sqft	UNIT 205 liv. 223 sqft total 350 sqft	UNIT 203 245 sqft 8% 19.6 sqft 4% 9.8 sqft	UNIT 205 285 sqft 8% 22.8 sqft 4% 11.4 sqft
UNIT 204 363 sqft	567 sqft		UNIT 204 258 sqft 8% 20.8 sqft 4% 10.4 sqft	

GROSS FLOOR AREA:

COMMERCIAL UNITS:
 UNIT 201 = 344 SQ.FT.
 UNIT 202 = 357 SQ.FT.
 UNIT 203 = 338 SQ.FT.
 UNIT 204 = 363 SQ.FT.

EFFICIENCY UNITS:
 UNIT 205 = 397 SQ.FT.
 UNIT 206 = 338 SQ.FT.
 UNIT 207 = 343 SQ.FT.

COMMON = 567 SQ.FT.
 TOTAL = 3047 SQ.FT.

EFFICIENCY UNIT LIV. FLOOR AREA:

UNIT 205 = 223 SQ.FT. > 150 SQ.FT.
 UNIT 206 = 198 SQ.FT. > 150 SQ.FT.
 UNIT 207 = 209 SQ.FT. > 150 SQ.FT.

EFFICIENCY UNIT TOTAL FLOOR AREA:

UNIT 205 = 350 SQ.FT. > 220 SQ.FT.
 UNIT 206 = 300 SQ.FT. > 220 SQ.FT.
 UNIT 207 = 299 SQ.FT. > 220 SQ.FT.

COMMON PATH OF TRAVEL:

UNIT 201 = 35'-0"FT <100'
 UNIT 202 = 35'-0"FT <100'
 UNIT 203 = 35'-0"FT <100'
 UNIT 204 = 35'-0"FT <100'
 UNIT 205 = 62'-3"FT <125'
 UNIT 206 = 52'-0"FT <125'
 UNIT 207 = 55'-6"FT <125'

MAXIMUM TRAVEL DISTANCE:

UNIT 201 = 74'-6"FT <300'
 UNIT 202 = 68'-0"FT <300'
 UNIT 203 = 63'-0"FT <300'
 UNIT 204 = 69'-9"FT <300'
 UNIT 205 = 78'-4"FT <250'
 UNIT 206 = 72'-0"FT <250'
 UNIT 207 = 63'-0"FT <250'

EXITING:

OCCUPANCY TYPE: R-2
 RESIDENTIAL LOAD FACTOR: 200 GSF/PERSON
 OCCUPANCY: 1645 SF/200 SF = 9 PEOPLE
 OCCUPANCY TYPE: B
 BUSINESS LOAD FACTOR: 100 GSF/PERSON
 OCCUPANCY: 1403 SF/100 SF = 15 PEOPLE

BUILDING:
 NUMBER OF EXITS REQUIRED: 2
 NUMBER OF EXITS PROVIDED: 2

REAR YARD:
 NUMBER OF EXITS REQUIRED: 1
 NUMBER OF EXITS PROVIDED: 2

EXITING:

EXIT WIDTH REQUIRED:
 0.2 IN. PER OCCUPANT: 0.2' x 12 = 2.4'
 STAIR-1 EXIT DOOR: 36 IN. PROVIDED
 STAIR-2 EXIT DOOR: 36 IN. PROVIDED

STAIR WIDTH REQUIRED:
 0.3 IN. PER OCCUPANT: 0.3' x 12 = 3.6 IN.
 36 IN. PROVIDED AS PER 2016 CBC
 SECTION 1011.2 EXCEPTION 1

BUILDING DIAGONAL: 76'-4"
 1/3 DIAGONAL: 28'-6"
 EXIT ACCESS SEPARATION: 38'-6" > 28'-6"

LIGHT AND AIR CALCULATIONS:

UNIT 201
 FLOOR AREA = 241.00 SQ.FT.
 REQ. MIN. WDW AREA 8% = 19.40 SQ.FT.
 PROVIDED WDW AREA = 28.95 SQ.FT.
 REQ. MIN. VENT AREA 4% = 9.70 SQ.FT.
 PROVIDED VENT AREA = MECH. VENT.

UNIT 202
 FLOOR AREA = 264.00 SQ.FT.
 REQ. MIN. WDW AREA 8% = 21.20 SQ.FT.
 PROVIDED WDW AREA = 31.95 SQ.FT.
 REQ. MIN. VENT AREA 4% = 10.60 SQ.FT.
 PROVIDED VENT AREA = MECH. VENT.

UNIT 203
 FLOOR AREA = 245.00 SQ.FT.
 REQ. MIN. WDW AREA 8% = 19.60 SQ.FT.
 PROVIDED WDW AREA = 28.95 SQ.FT.
 REQ. MIN. VENT AREA 4% = 9.80 SQ.FT.
 PROVIDED VENT AREA = MECH. VENT.


UNIT 204
 FLOOR AREA = 258.00 SQ.FT.
 REQ. MIN. WDW AREA 8% = 20.80 SQ.FT.
 PROVIDED WDW AREA = 31.95 SQ.FT.
 REQ. MIN. VENT AREA 4% = 10.40 SQ.FT.
 PROVIDED VENT AREA = MECH. VENT.

UNIT 205
 FLOOR AREA = 285.00 SQ.FT.
 REQ. MIN. WDW AREA 8% = 22.80 SQ.FT.
 PROVIDED WDW AREA = 54.00 SQ.FT.
 REQ. MIN. VENT AREA 4% = 11.40 SQ.FT.
 PROVIDED VENT AREA = MECH. VENT.

UNIT 206
 FLOOR AREA = 234.00 SQ.FT.
 REQ. MIN. WDW AREA 8% = 18.80 SQ.FT.
 PROVIDED WDW AREA = 54.00 SQ.FT.
 REQ. MIN. VENT AREA 4% = 9.40 SQ.FT.
 PROVIDED VENT AREA = MECH. VENT.

UNIT 207
 FLOOR AREA = 231.00 SQ.FT.
 REQ. MIN. WDW AREA 8% = 18.60 SQ.FT.
 PROVIDED WDW AREA = 54.00 SQ.FT.
 REQ. MIN. VENT AREA 4% = 9.30 SQ.FT.
 PROVIDED VENT AREA = MECH. VENT.


NOTE:
 SEE MECHANICAL DRAWINGS FOR UNIT VENTILATION

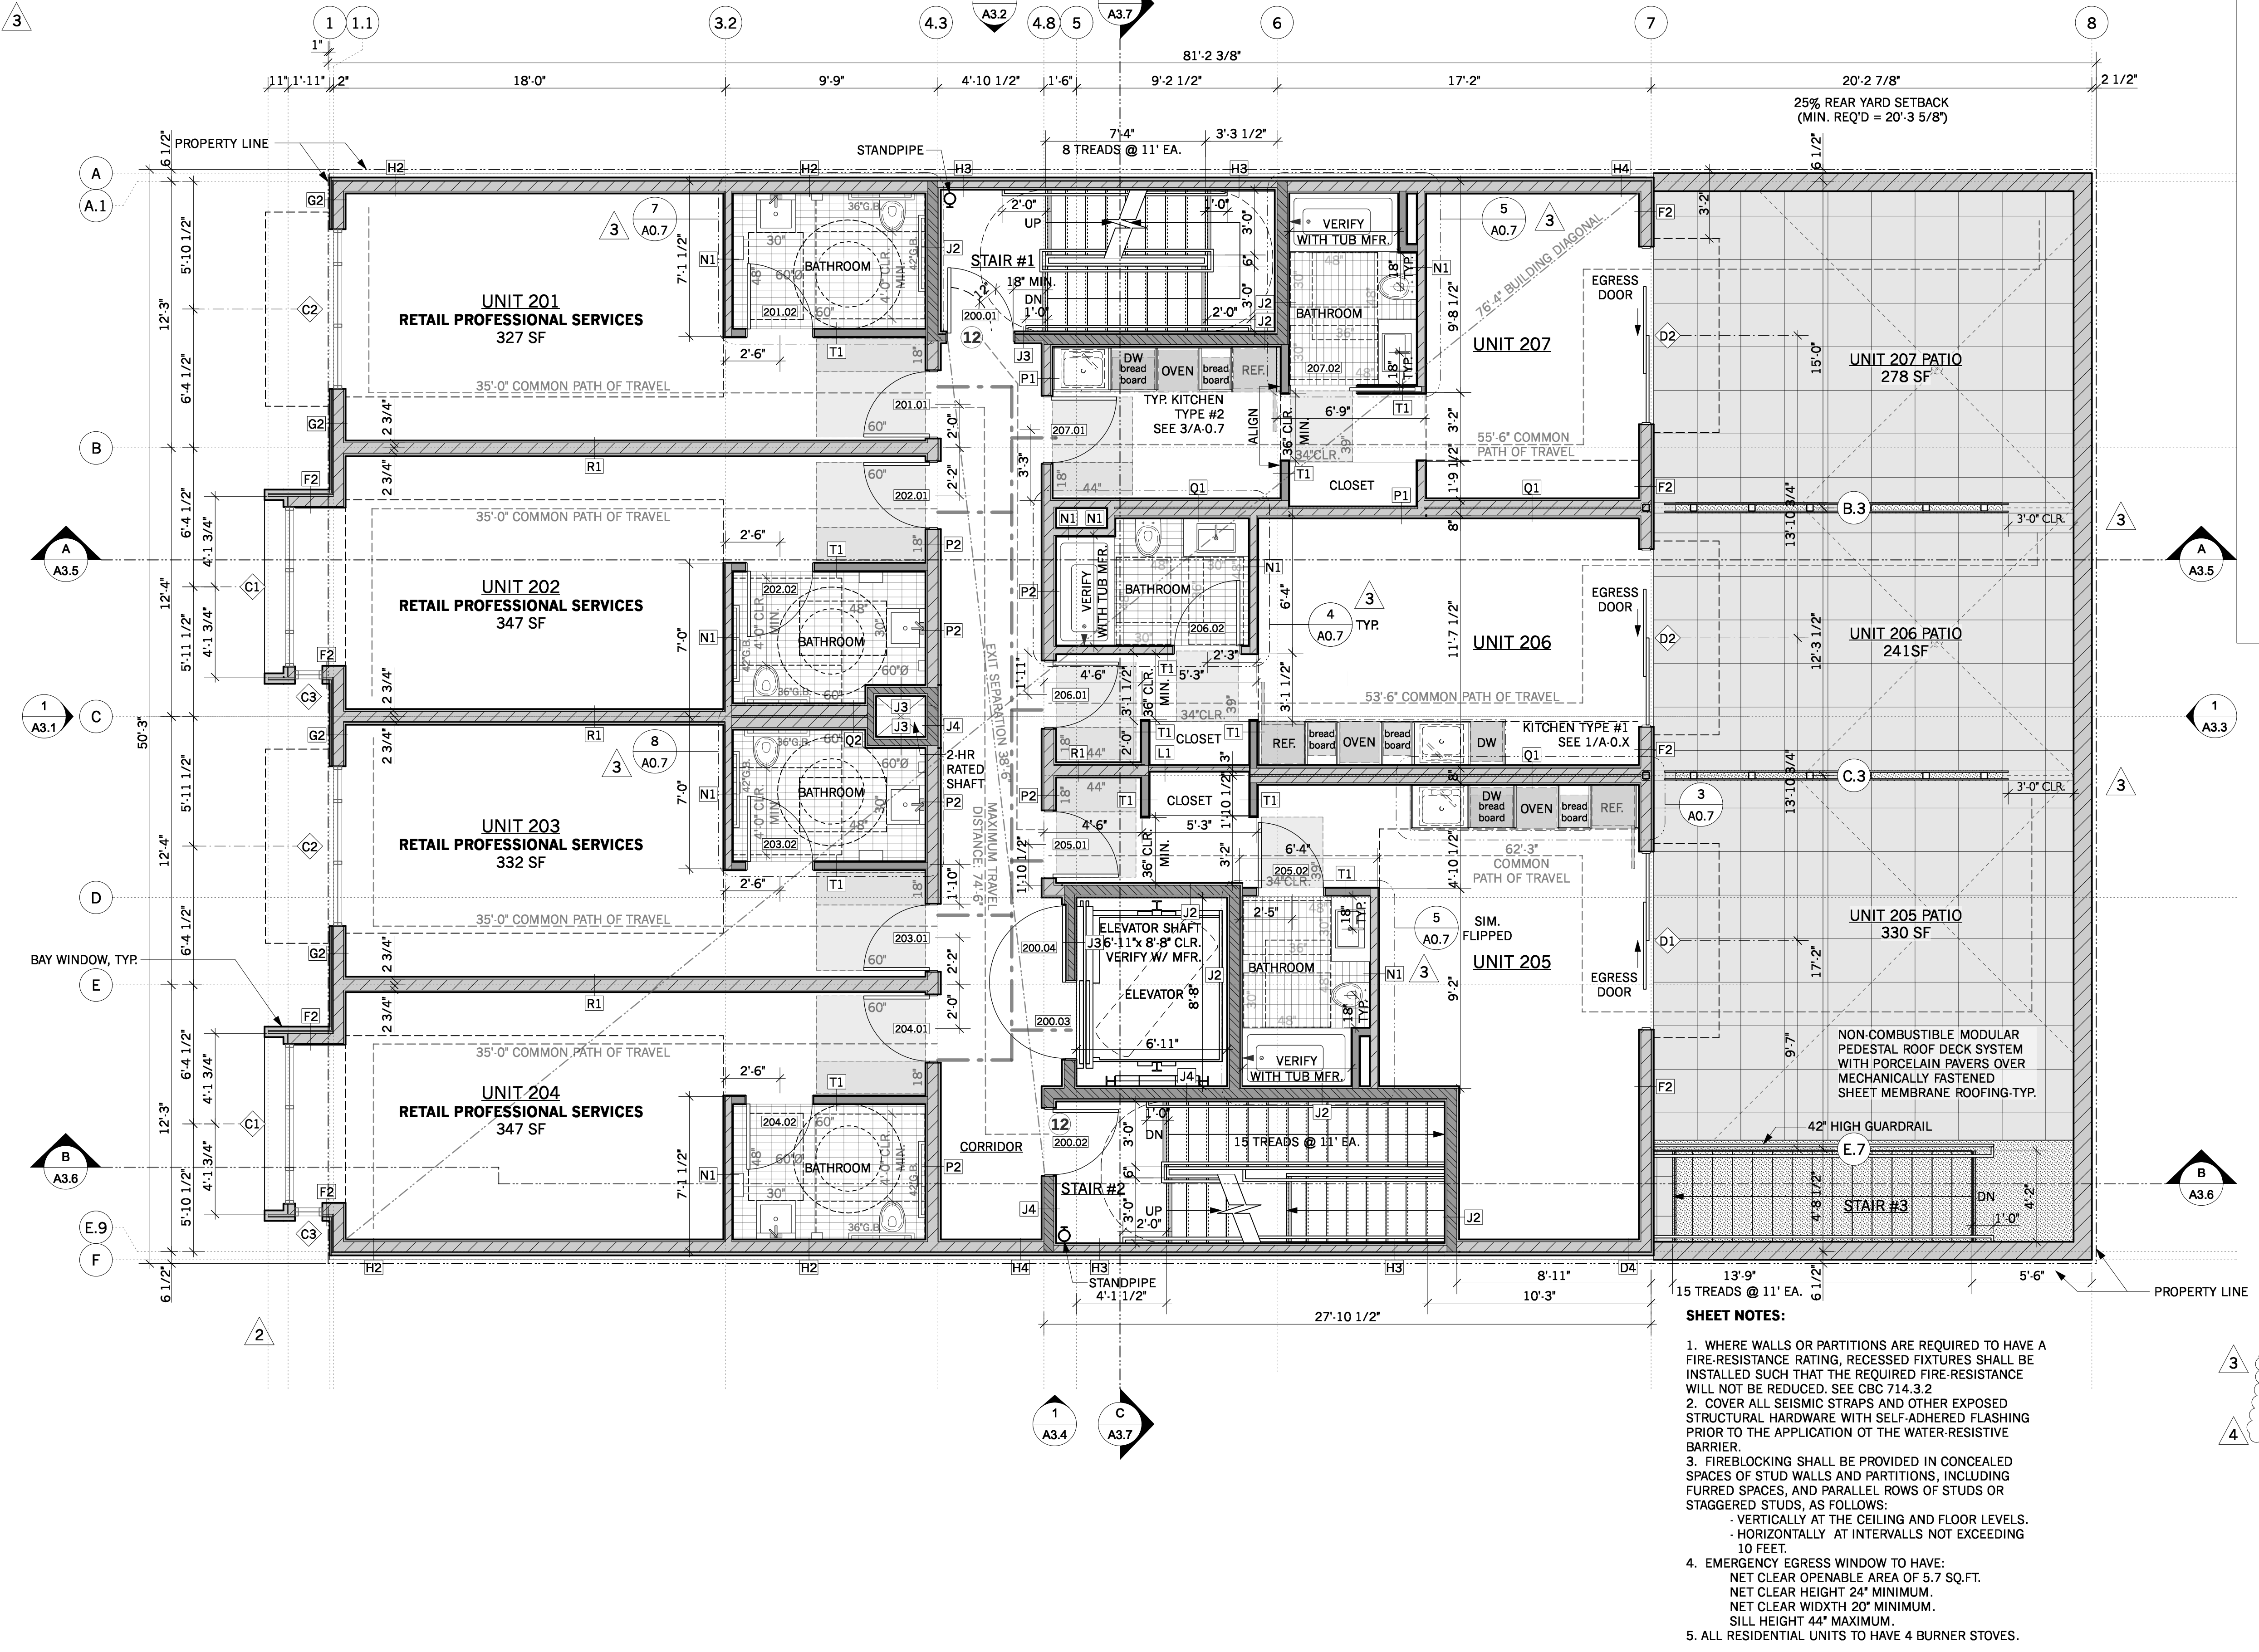

- SHEET NOTES:**
- WHERE WALLS OR PARTITIONS ARE REQUIRED TO HAVE A FIRE RESISTANCE RATING, RECESSED FIXTURES SHALL BE INSTALLED SUCH THAT THE REQUIRED FIRE RESISTANCE WILL NOT BE REDUCED. SEE CBC 714.3.2
 - COVER ALL SEISMIC STRAPS AND OTHER EXPOSED STRUCTURAL HARDWARE WITH SELF-ADHERED FLASHING PRIOR TO THE APPLICATION OF THE WATER-RESISTIVE BARRIER.
 - FIREBLOCKING SHALL BE PROVIDED IN CONCEALED SPACES OF STUD WALLS AND PARTITIONS, INCLUDING FURRED SPACES, AND PARALLEL ROWS OF STUDS OR STAGGERED STUDS, AS FOLLOWS:
 - VERTICALLY AT THE CEILING AND FLOOR LEVELS.
 - HORIZONTALLY AT INTERVALS NOT EXCEEDING 10 FEET.
 - EMERGENCY EGRESS WINDOW TO HAVE:
 NET CLEAR OPENABLE AREA OF 5.7 SQ.FT.
 NET CLEAR HEIGHT 24" MINIMUM.
 NET CLEAR WIDTH 20" MINIMUM.
 SILL HEIGHT 44" MAXIMUM.
 - ALL RESIDENTIAL UNITS TO HAVE 4 BURNER STOVES.

KEY

(N) UNRATED WALL
(N) 1-HR WALL
(N) 2-HR WALL
(N) 3-HR WALL
----- COMMON PATH OF TRAVEL
----- EGRESS PATH OF TRAVEL
----- ACCESSIBLE PATH OF TRAVEL
(12) OCCUPANT LOAD
□ RATED SHAFT

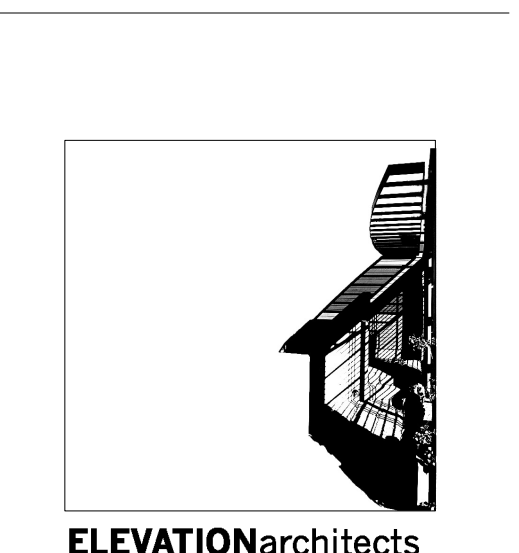

Elevation Architects
 1159 Green Street, Suite 4
 San Francisco, CA 94109
 415.537.1125 :v
 www.elevationarchitects.com :w



agency stamps:

Condominiums
 42 Otis Street
 San Francisco, CA 94103
 Block / Lot : 3503 / 020

#	date	issue
2	4.15.20	Project Revision 2
3	4.27.20	Plan Check Response 2
4	8.17.20	Plan Check Response 3


sheet count 21/49

2nd Floor Plan

project: 16.15
 drawn by: mka
 checked by: jp
 date: 01.21.19
 scale:

A-2.2

1 SECOND FLOOR PLAN
 Scale: 1/4" = 1'-0"

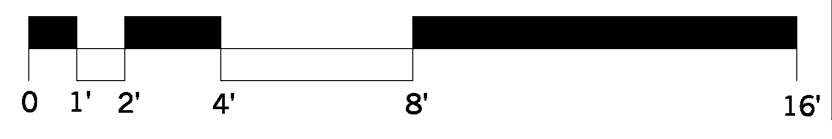

UNIT	AREA	EFFICIENCY	LIGHT AND AIR
UNIT 301	363 sqft	248 sqft liv. 212 sqft total 314 sqft	248 sqft liv. 225 sqft total 316 sqft
UNIT 302	338 sqft	236 sqft liv. 198 sqft total 301 sqft	234 sqft liv. 197 sqft total 300 sqft
UNIT 303	357 sqft	252 sqft liv. 214 sqft total 317 sqft	266 sqft liv. 205 sqft total 333 sqft
UNIT 304	344 sqft	232 sqft liv. 195 sqft total 297 sqft	232 sqft liv. 186 sqft total 297 sqft
UNIT 501	363 sqft	248 sqft liv. 212 sqft total 314 sqft	246 sqft liv. 197 sqft total 316 sqft
UNIT 502	338 sqft	236 sqft liv. 198 sqft total 301 sqft	234 sqft liv. 197 sqft total 300 sqft
UNIT 503	357 sqft	252 sqft liv. 214 sqft total 317 sqft	266 sqft liv. 205 sqft total 333 sqft
UNIT 504	344 sqft	232 sqft liv. 195 sqft total 297 sqft	232 sqft liv. 186 sqft total 297 sqft

GROSS FLOOR AREA:

UNIT 301 = 363 SQ.FT.
 UNIT 302 = 338 SQ.FT.
 UNIT 303 = 357 SQ.FT.
 UNIT 304 = 344 SQ.FT.
 UNIT 305 = 377 SQ.FT.
 UNIT 306 = 341 SQ.FT.
 UNIT 307 = 360 SQ.FT.
 COMMON = 550 SQ.FT.
 TOTAL = 3031 SQ.FT.

EFFICIENCY UNIT LIV. FLOOR AREA:

UNIT 301 = 212 SQ.FT. > 150 SQ.FT.
 UNIT 302 = 198 SQ.FT. > 150 SQ.FT.
 UNIT 303 = 214 SQ.FT. > 150 SQ.FT.
 UNIT 304 = 195 SQ.FT. > 150 SQ.FT.
 UNIT 305 = 205 SQ.FT. > 150 SQ.FT.
 UNIT 306 = 197 SQ.FT. > 150 SQ.FT.
 UNIT 307 = 225 SQ.FT. > 150 SQ.FT.

COMMON PATH OF TRAVEL:

UNIT 301 = 35'-9"FT <125'
 UNIT 302 = 34'-9"FT <125'
 UNIT 303 = 34'-9"FT <125'
 UNIT 304 = 34'-9"FT <125'
 UNIT 305 = 39'-0"FT <125'
 UNIT 306 = 34'-6"FT <125'
 UNIT 307 = 37'-4"FT <125'

EXITING:

OCCUPANCY TYPE: R-2
 RESIDENTIAL LOAD FACTOR: 200 GSF/PERSON
 OCCUPANCY: 3,031 SF/200 SF = 16 PEOPLE

NUMBER OF EXITS REQUIRED: 2
 NUMBER OF EXITS PROVIDED: 2


EXIT WIDTH REQUIRED PER EXIT:
 0.2 IN. PER OCCUPANT: 0.2' x 8 = 2.4'

EXIT WIDTH PROVIDED PER EXIT:
 STAIR-1 EXIT DOOR: 36 IN. > 2.4 IN.
 STAIR-2 EXIT DOOR: 36 IN. > 2.4 IN.

EXITING:

STAIR WIDTH REQUIRED:
 0.3 IN. PER OCCUPANT: 0.3' x 8 = 2.4 IN.
 36 IN. PROVIDED AS PER 2016 CBC SECTION 1011.2 EXCEPTION 1

BUILDING DIAGONAL: 76'-4"
 1/3 DIAGONAL: 28'-5"
 EXIT ACCESS SEPARATION: 38'-6" > 28'-6"

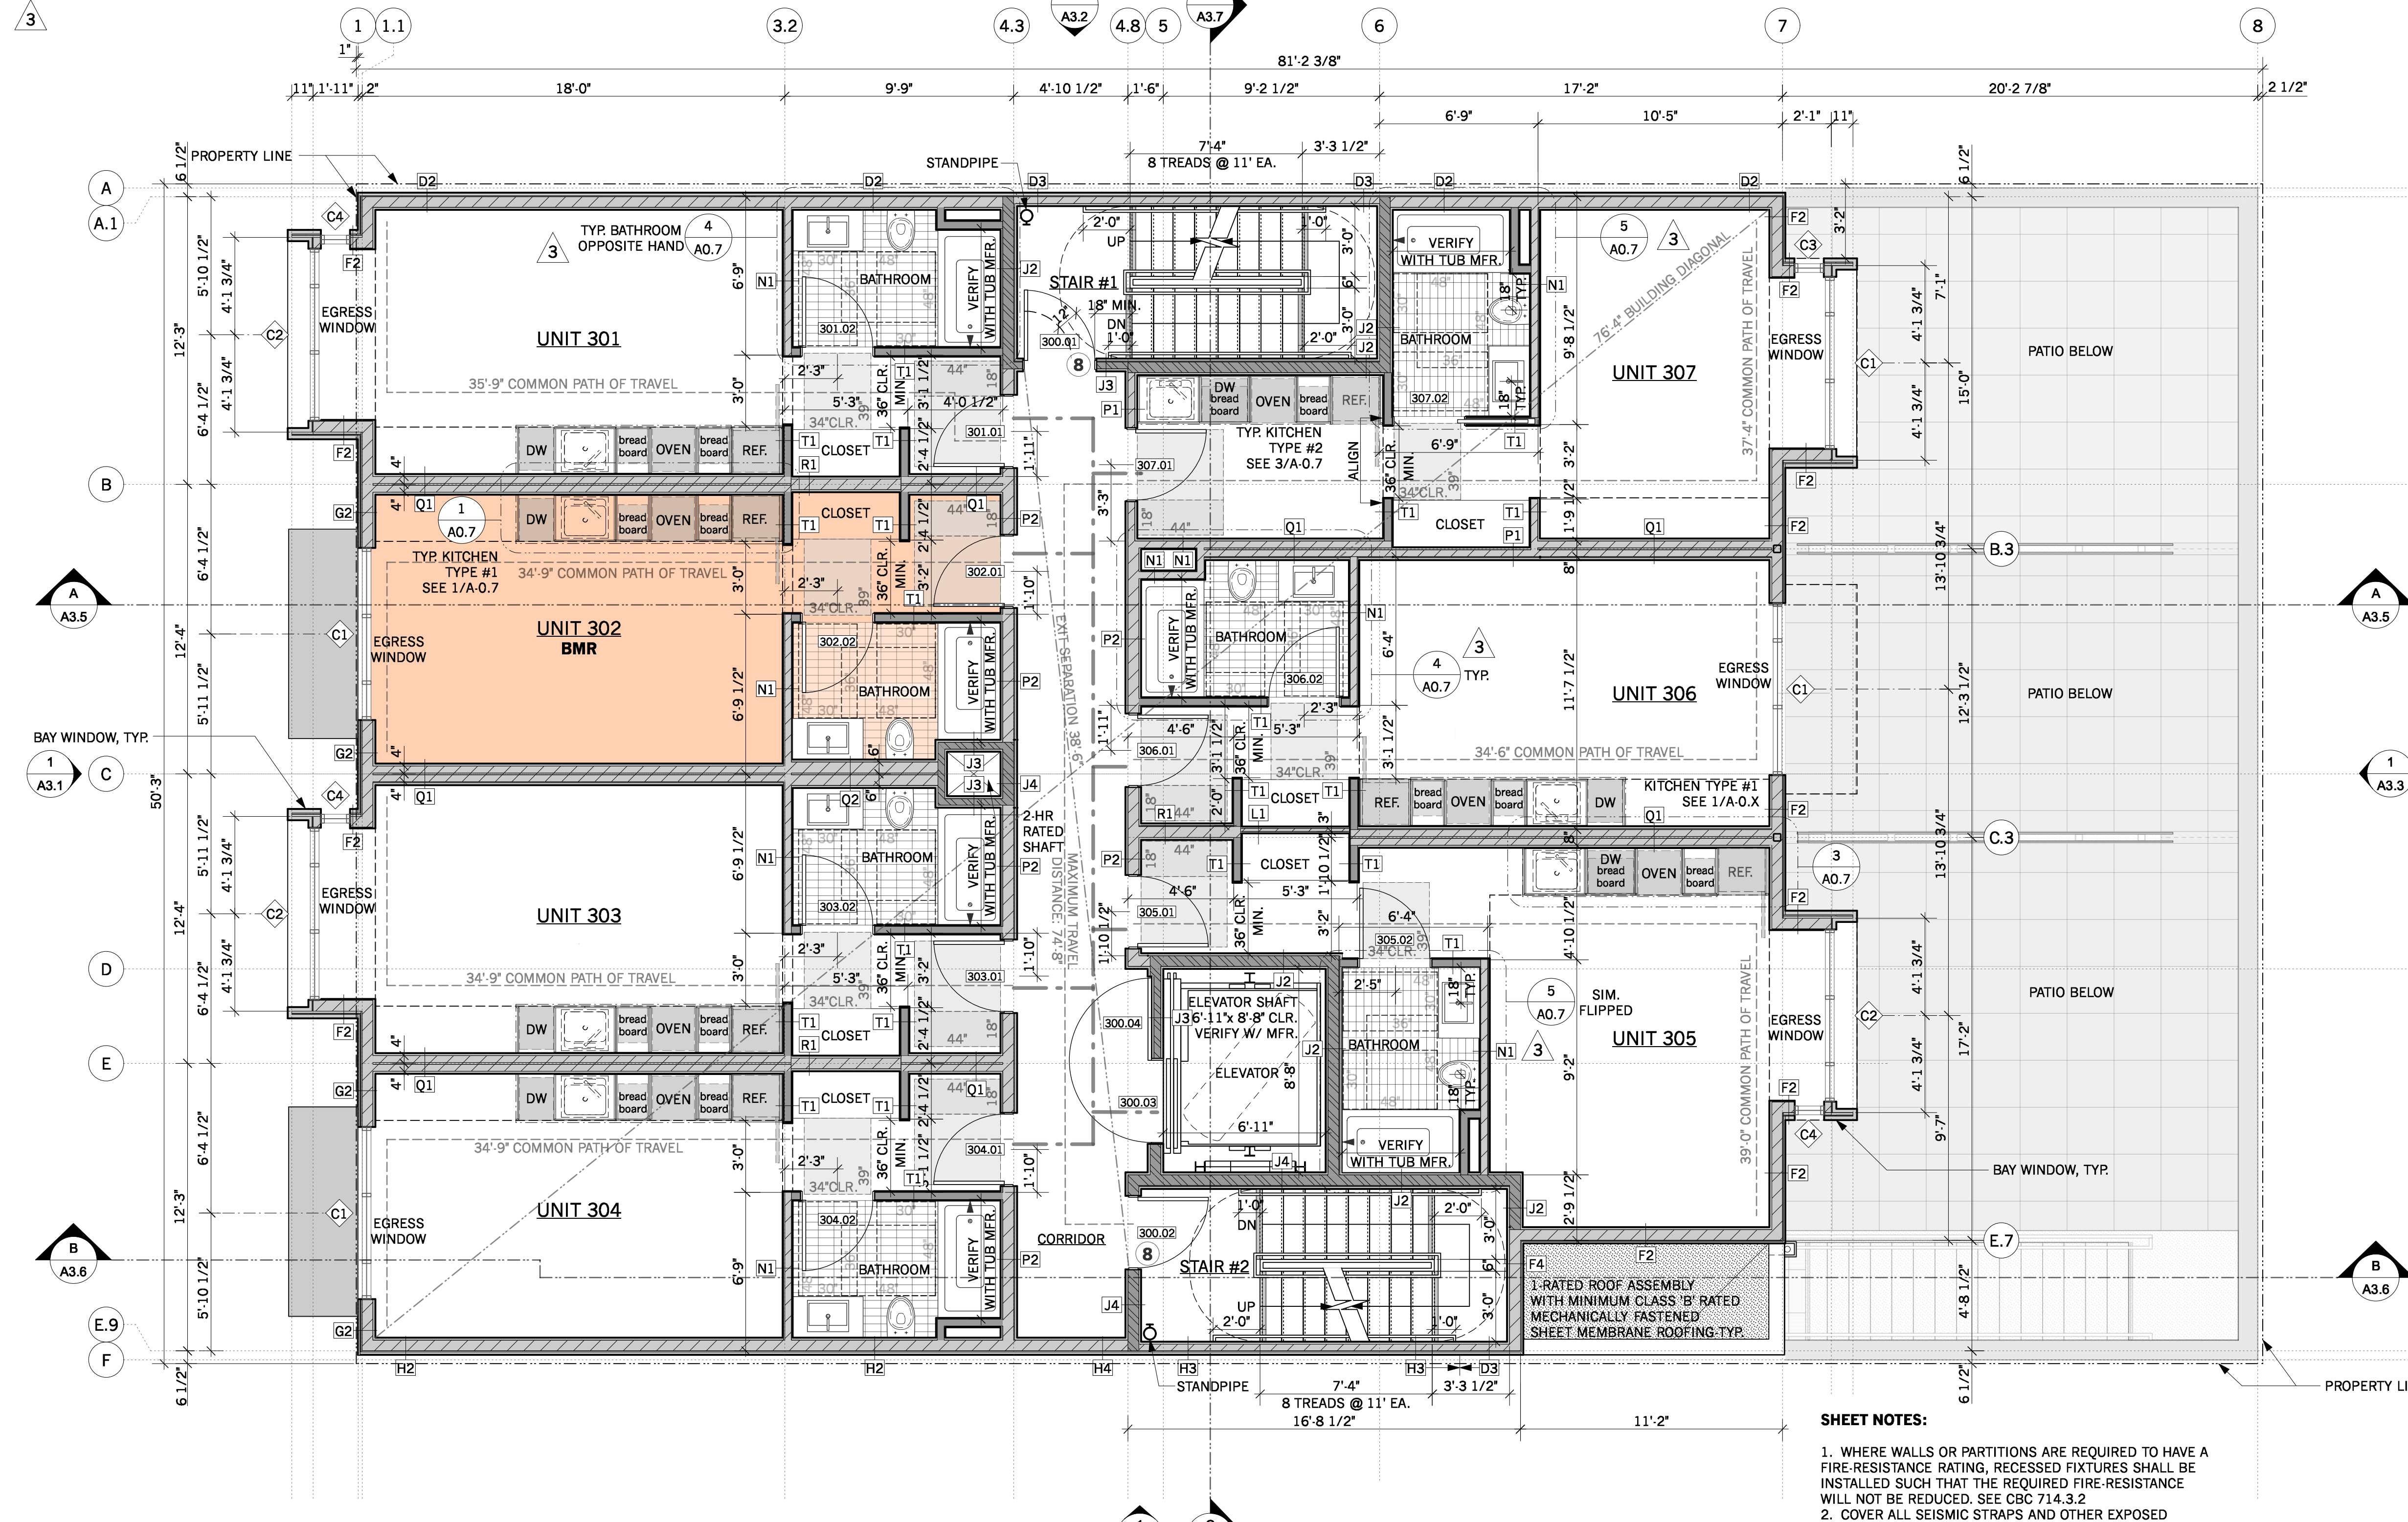

LIGHT AND AIR CALCULATIONS

UNIT 301
 FLOOR AREA = 248.00 SQ.FT.
 REQ. MIN. WDW AREA 8% = 19.85 SQ.FT.
 PROVIDED WDW AREA = 31.95 SQ.FT.
 REQ. MIN. VENT AREA 4% = 9.93 SQ.FT.
 PROVIDED VENT AREA = MECH. VENT.

UNIT 302
 FLOOR AREA = 236.00 SQ.FT.
 REQ. MIN. WDW AREA 8% = 18.88 SQ.FT.
 PROVIDED WDW AREA = 28.95 SQ.FT.
 REQ. MIN. VENT AREA 4% = 9.44 SQ.FT.
 PROVIDED VENT AREA = MECH. VENT.

UNIT 303
 FLOOR AREA = 252.00 SQ.FT.
 REQ. MIN. WDW AREA 8% = 20.16 SQ.FT.
 PROVIDED WDW AREA = 31.95 SQ.FT.
 REQ. MIN. VENT AREA 4% = 10.08 SQ.FT.
 PROVIDED VENT AREA = MECH. VENT.

UNIT 304
 FLOOR AREA = 232.00 SQ.FT.
 REQ. MIN. WDW AREA 8% = 18.40 SQ.FT.
 PROVIDED WDW AREA = 28.95 SQ.FT.
 REQ. MIN. VENT AREA 4% = 9.20 SQ.FT.
 PROVIDED VENT AREA = MECH. VENT.

UNIT 305
 FLOOR AREA = 266.00 SQ.FT.
 REQ. MIN. WDW AREA 8% = 21.28 SQ.FT.
 PROVIDED WDW AREA = 28.95 SQ.FT.
 REQ. MIN. VENT AREA 4% = 10.64 SQ.FT.
 PROVIDED VENT AREA = MECH. VENT.

UNIT 306
 FLOOR AREA = 234.00 SQ.FT.
 REQ. MIN. WDW AREA 8% = 18.72 SQ.FT.
 PROVIDED WDW AREA = 31.95 SQ.FT.
 REQ. MIN. VENT AREA 4% = 9.36 SQ.FT.
 PROVIDED VENT AREA = MECH. VENT.

UNIT 307
 FLOOR AREA = 246.00 SQ.FT.
 REQ. MIN. WDW AREA 8% = 19.68 SQ.FT.
 PROVIDED WDW AREA = 28.95 SQ.FT.
 REQ. MIN. VENT AREA 4% = 9.84 SQ.FT.
 PROVIDED VENT AREA = MECH. VENT.


NOTE:
 SEE MECHANICAL DRAWINGS FOR UNIT VENTILATION

- SHEET NOTES:**
- WHERE WALLS OR PARTITIONS ARE REQUIRED TO HAVE A FIRE-RESISTANCE RATING, RECESSED FIXTURES SHALL BE INSTALLED SUCH THAT THE REQUIRED FIRE-RESISTANCE WILL NOT BE REDUCED. SEE CBC 714.3.2
 - COVER ALL SEISMIC STRAPS AND OTHER EXPOSED STRUCTURAL HARDWARE WITH SELF-ADHERED FLASHING PRIOR TO THE APPLICATION OF THE WATER-RESISTIVE BARRIER.
 - FIREBLOCKING SHALL BE PROVIDED IN CONCEALED SPACES OF STUD WALLS AND PARTITIONS, INCLUDING FURRED SPACES, AND PARALLEL ROWS OF STUDS OR STAGGERED STUDS, AS FOLLOWS:
 - VERTICALLY AT THE CEILING AND FLOOR LEVELS.
 - HORIZONTALLY AT INTERVALS NOT EXCEEDING 10 FEET.
 - EMERGENCY EGRESS WINDOW TO HAVE:
 NET CLEAR OPENABLE AREA OF 5.7 SQ.FT.
 NET CLEAR HEIGHT 24" MINIMUM.
 NET CLEAR WIDTH 20" MINIMUM.
 SILL HEIGHT 44" MAXIMUM.
 - ALL RESIDENTIAL UNITS TO HAVE 4 BURNER STOVES.

KEY

(N) UNRATED WALL
(N) 1-HR WALL
(N) 2-HR WALL
(N) 3-HR WALL
COMMON PATH OF TRAVEL
EGRESS PATH OF TRAVEL
ACCESSIBLE PATH OF TRAVEL
(12) OCCUPANT LOAD
RATED SHAFT

1 THIRD FLOOR PLAN
 Scale: 1/4" = 1'-0"

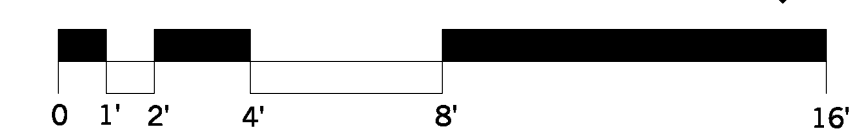

agency stamps:

Condominiums
 42 Otis Street
 San Francisco, CA 94103
 Block / Lot : 3503 / 020

#	date	issue
2	4.15.20	Project Revision 2
3	4.27.20	Plan Check Response 2
4	8.17.20	Plan Check Response 3

sheet count 22/49

3rd Floor Plans

project: 16.15
 drawn by: mka
 checked by: jp
 date: 01.21.19
 scale:

A-2.3

UNIT 401 344 sqft	UNIT 407 341 sqft	UNIT 401 liv. 195 sqft total 297 sqft	UNIT 407 liv. 208 sqft total 299 sqft
UNIT 402 357 sqft	UNIT 406 360 sqft	UNIT 402 liv. 215 sqft total 318 sqft	UNIT 406 liv. 214 sqft total 317 sqft
UNIT 403 338 sqft	UNIT 405 358 sqft	UNIT 403 liv. 198 sqft total 301 sqft	UNIT 405 liv. 188 sqft total 316 sqft
UNIT 404 363 sqft	550 sqft	UNIT 404 liv. 212 sqft total 314 sqft	

UNIT 401 232 sqft 8% 18.6 sqft 4% 9.3 sqft	UNIT 407 230 sqft 8% 18.4 sqft 4% 9.2 sqft
UNIT 402 252 sqft 8% 20.2 sqft 4% 10.1 sqft	UNIT 406 250 sqft 8% 20.0 sqft 4% 10.0 sqft
UNIT 403 234 sqft 8% 18.7 sqft 4% 9.4 sqft	UNIT 405 250 sqft 8% 20.0 sqft 4% 10.0 sqft
UNIT 404 250 sqft 8% 20.0 sqft 4% 10.0 sqft	

GROSS FLOOR AREA:

UNIT 401 = 344 SQ.FT.
UNIT 402 = 357 SQ.FT.
UNIT 403 = 338 SQ.FT.
UNIT 404 = 363 SQ.FT.
UNIT 405 = 358 SQ.FT.
UNIT 406 = 360 SQ.FT.
UNIT 407 = 341 SQ.FT.
COMMON = 550 SQ.FT.
TOTAL = 3012 SQ.FT.

EFFICIENCY UNIT LIV. FLOOR AREA:

UNIT 401 = 195 SQ.FT. > 150 SQ.FT.
UNIT 402 = 215 SQ.FT. > 150 SQ.FT.
UNIT 403 = 198 SQ.FT. > 150 SQ.FT.
UNIT 404 = 212 SQ.FT. > 150 SQ.FT.
UNIT 405 = 188 SQ.FT. > 150 SQ.FT.
UNIT 406 = 214 SQ.FT. > 150 SQ.FT.
UNIT 407 = 208 SQ.FT. > 150 SQ.FT.

EFFICIENCY UNIT TOTAL FLOOR AREA:

UNIT 401 = 297 SQ.FT. > 220 SQ.FT.
UNIT 402 = 318 SQ.FT. > 220 SQ.FT.
UNIT 403 = 301 SQ.FT. > 220 SQ.FT.
UNIT 404 = 314 SQ.FT. > 220 SQ.FT.
UNIT 405 = 316 SQ.FT. > 220 SQ.FT.
UNIT 406 = 317 SQ.FT. > 220 SQ.FT.
UNIT 407 = 299 SQ.FT. > 220 SQ.FT.

COMMON PATH OF TRAVEL:

UNIT 401 = 35'-9"FT <125'
UNIT 402 = 34'-9"FT <125'
UNIT 403 = 34'-9"FT <125'
UNIT 404 = 34'-9"FT <125'
UNIT 405 = 39'-0"FT <125'
UNIT 406 = 34'-6"FT <125'
UNIT 407 = 37'-4"FT <125'

MAXIMUM TRAVEL DISTANCE:

UNIT 401 = 74'-6"FT <250'
UNIT 402 = 68'-0"FT <250'
UNIT 403 = 63'-0"FT <250'
UNIT 404 = 69'-9"FT <250'
UNIT 405 = 65'-9"FT <250'
UNIT 406 = 62'-0"FT <250'
UNIT 407 = 74'-8"FT <250'

EXITING:

OCCUPANCY TYPE: R-2
RESIDENTIAL LOAD FACTOR: 200 GSF/PERSON
OCCUPANCY: 3,012 SF/200 SF = 16 PEOPLE

NUMBER OF EXITS REQUIRED: 2
NUMBER OF EXITS PROVIDED: 2

EXIT WIDTH REQUIRED PER EXIT:
0.2 IN. PER OCCUPANT: 0.2' x 8 = 2.4'

EXIT WIDTH PROVIDED PER EXIT:
STAIR-1 EXIT DOOR: 36 IN. > 2.4 IN.
STAIR-2 EXIT DOOR: 36 IN. > 2.4 IN.

EXITING:

STAIR WIDTH REQUIRED:
0.3 IN. PER OCCUPANT: 0.3' x 8 = 2.4 IN.
36 IN. PROVIDED AS PER 2016 CBC
SECTION 1011.2 EXCEPTION 1

BUILDING DIAGONAL: 76'-4"
1/3 DIAGONAL: 28'-6"
EXIT ACCESS SEPARATION: 38'-6" > 28'-6"

LIGHT AND AIR CALCULATIONS:

UNIT 401
FLOOR AREA = 232.00 SQ.FT.
REQ. MIN. WDW AREA 8% = 18.40 SQ.FT.
PROVIDED WDW AREA = 28.95 SQ.FT.
REQ. MIN. VENT AREA 4% = 9.20 SQ.FT.
PROVIDED VENT AREA = MECH. VENT.

UNIT 402
FLOOR AREA = 252.00 SQ.FT.
REQ. MIN. WDW AREA 8% = 20.16 SQ.FT.
PROVIDED WDW AREA = 31.95 SQ.FT.
REQ. MIN. VENT AREA 4% = 10.08 SQ.FT.
PROVIDED VENT AREA = MECH. VENT.

UNIT 403
FLOOR AREA = 234.00 SQ.FT.
REQ. MIN. WDW AREA 8% = 18.72 SQ.FT.
PROVIDED WDW AREA = 28.95 SQ.FT.
REQ. MIN. VENT AREA 4% = 9.36 SQ.FT.
PROVIDED VENT AREA = MECH. VENT.


UNIT 404
FLOOR AREA = 250.00 SQ.FT.
REQ. MIN. WDW AREA 8% = 20.00 SQ.FT.
PROVIDED WDW AREA = 31.95 SQ.FT.
REQ. MIN. VENT AREA 4% = 10.00 SQ.FT.
PROVIDED VENT AREA = MECH. VENT.

UNIT 405
FLOOR AREA = 250.00 SQ.FT.
REQ. MIN. WDW AREA 8% = 20.00 SQ.FT.
PROVIDED WDW AREA = 28.95 SQ.FT.
REQ. MIN. VENT AREA 4% = 10.00 SQ.FT.
PROVIDED VENT AREA = MECH. VENT.

UNIT 406
FLOOR AREA = 250.00 SQ.FT.
REQ. MIN. WDW AREA 8% = 20.00 SQ.FT.
PROVIDED WDW AREA = 28.95 SQ.FT.
REQ. MIN. VENT AREA 4% = 10.00 SQ.FT.
PROVIDED VENT AREA = MECH. VENT.

UNIT 407
FLOOR AREA = 230.00 SQ.FT.
REQ. MIN. WDW AREA 8% = 18.40 SQ.FT.
PROVIDED WDW AREA = 28.95 SQ.FT.
REQ. MIN. VENT AREA 4% = 9.20 SQ.FT.
PROVIDED VENT AREA = MECH. VENT.

NOTE:
SEE MECHANICAL DRAWINGS FOR UNIT VENTILATION

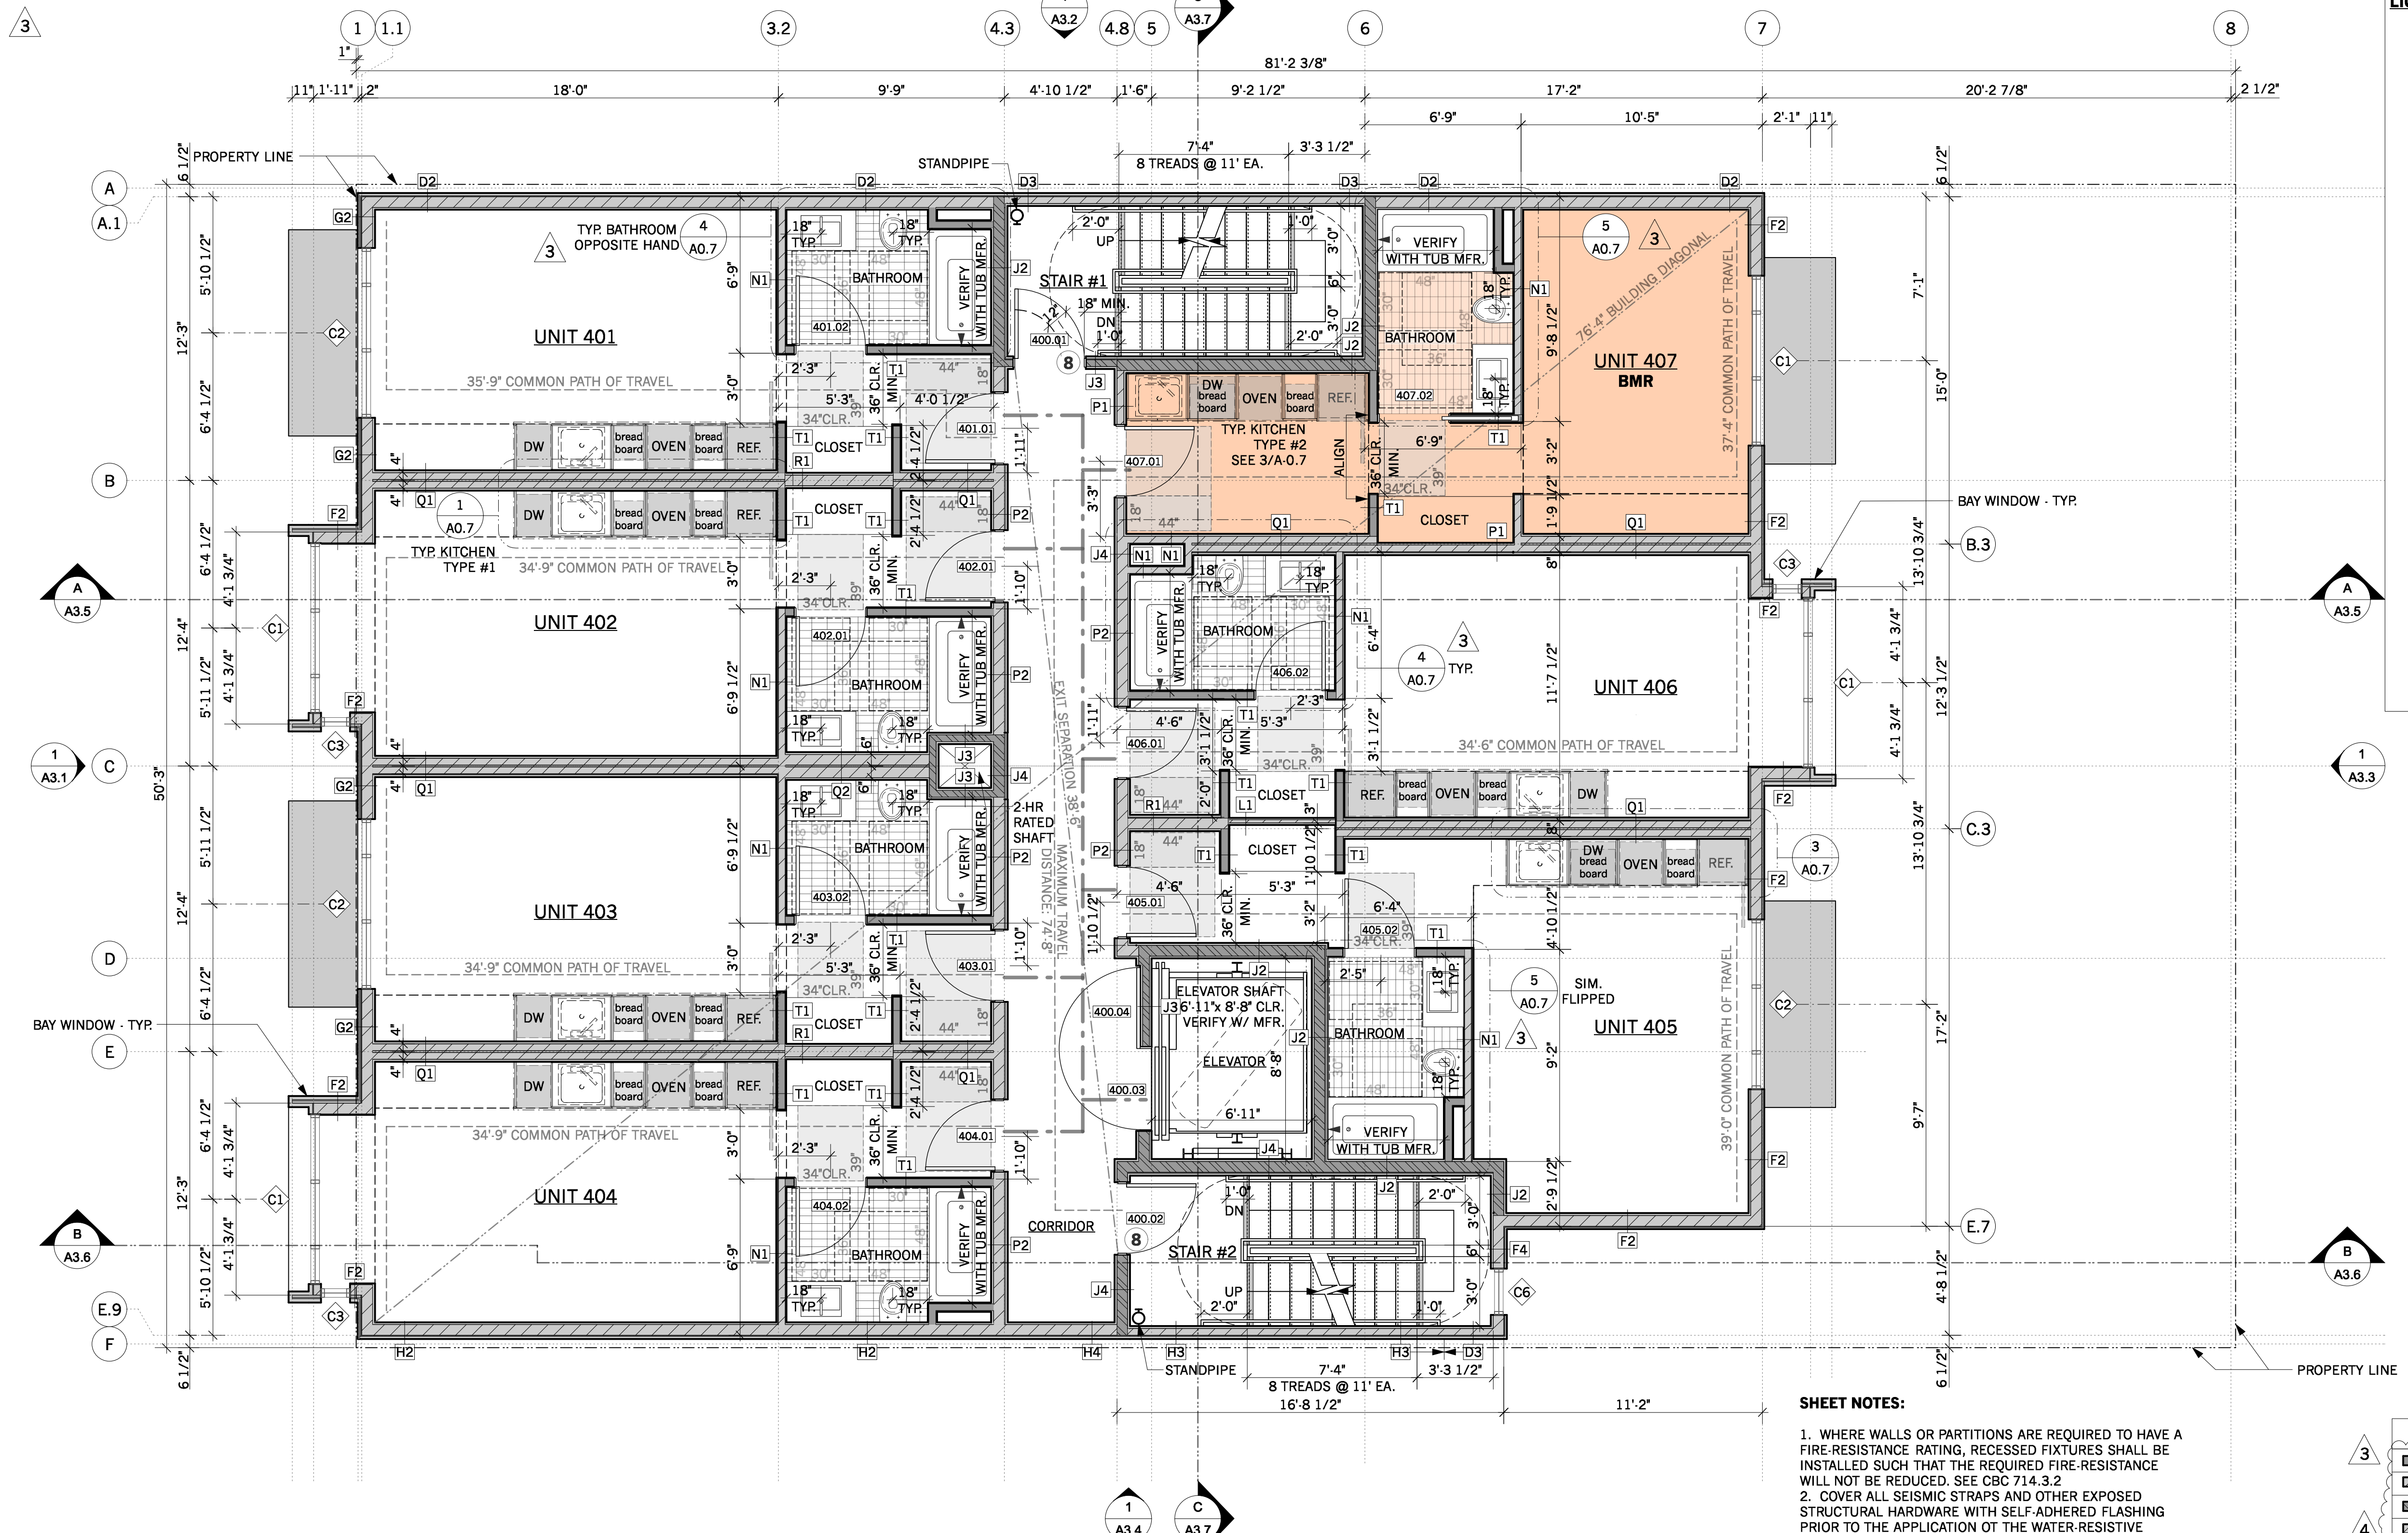


- SHEET NOTES:**
- WHERE WALLS OR PARTITIONS ARE REQUIRED TO HAVE A FIRE-RESISTANCE RATING, RECESSED FIXTURES SHALL BE INSTALLED SUCH THAT THE REQUIRED FIRE-RESISTANCE WILL NOT BE REDUCED. SEE CBC 714.3.2
 - COVER ALL SEISMIC STRAPS AND OTHER EXPOSED STRUCTURAL HARDWARE WITH SELF-ADHERED FLASHING PRIOR TO THE APPLICATION OF THE WATER-RESISTIVE BARRIER.
 - FIREBLOCKING SHALL BE PROVIDED IN CONCEALED SPACES OF STUD WALLS AND PARTITIONS, INCLUDING FURRED SPACES, AND PARALLEL ROWS OF STUDS OR STAGGERED STUDS, AS FOLLOWS:
- VERTICALLY AT THE CEILING AND FLOOR LEVELS.
- HORIZONTALLY AT INTERVALS NOT EXCEEDING 10 FEET.
 - EMERGENCY EGRESS WINDOW TO HAVE:
NET CLEAR OPENABLE AREA OF 5.7 SQ.FT.
NET CLEAR HEIGHT 24" MINIMUM.
NET CLEAR WIDTH 20" MINIMUM.
SILL HEIGHT 44" MAXIMUM.
 - ALL RESIDENTIAL UNITS TO HAVE 4 BURNER STOVES.

KEY

(N) UNRATED WALL
(N) 1-HR WALL
(N) 2-HR WALL
(N) 3-HR WALL
--- COMMON PATH OF TRAVEL
--- EGRESS PATH OF TRAVEL
--- ACCESSIBLE PATH OF TRAVEL
(1) OCCUPANT LOAD
▣ RATED SHAFT

FOURTH FLOOR PLAN
Scale: 1/4" = 1'-0"

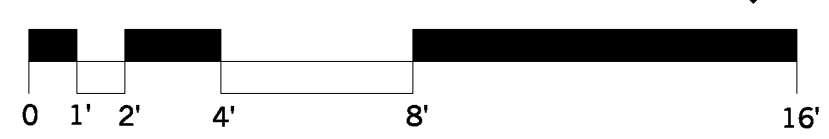

agency stamps:

Condominiums
42 Otis Street
San Francisco, CA 94103
Block / Lot : 3503 / 020

#	date	issue
2	4.15.20	Project Revision 2
3	4.27.20	Plan Check Response 2
4	8.17.20	Plan Check Response 3

sheet count 23/49

4th Floor Plan

project: 16.15
drawn by: mka
checked by: jp
date: 01.21.19
scale:

A-2.4

UNIT	sqft	UNIT	sqft	UNIT	sqft	UNIT	sqft
UNIT 501	363 sqft	UNIT 507	360 sqft	UNIT 501	248 sqft	UNIT 507	246 sqft
UNIT 502	338 sqft	UNIT 506	341 sqft	UNIT 502	236 sqft	UNIT 506	234 sqft
UNIT 503	357 sqft	UNIT 505	377 sqft	UNIT 503	252 sqft	UNIT 505	266 sqft
UNIT 504	344 sqft			UNIT 504	232 sqft	UNIT 505	213 sqft
GROSS AREA		EFFICIENCY UNITS		LIGHT AND AIR			
UNIT 501	liv. 212 sqft total 314 sqft	UNIT 502	liv. 198 sqft total 301 sqft	UNIT 503	liv. 214 sqft total 317 sqft	UNIT 504	liv. 195 sqft total 297 sqft
UNIT 507	liv. 225 sqft total 316 sqft	UNIT 506	liv. 197 sqft total 300 sqft	UNIT 505	liv. 205 sqft total 333 sqft		


UNIT	sqft	UNIT	sqft	UNIT	sqft	UNIT	sqft
UNIT 501	248 sqft	UNIT 507	246 sqft	UNIT 501	236 sqft	UNIT 506	234 sqft
UNIT 502	236 sqft	UNIT 506	234 sqft	UNIT 503	252 sqft	UNIT 505	266 sqft
UNIT 503	252 sqft	UNIT 505	266 sqft	UNIT 504	232 sqft	UNIT 505	213 sqft
UNIT 504	232 sqft	UNIT 505	213 sqft				
GROSS FLOOR AREA:		EFFICIENCY UNIT LIV. FLOOR AREA:		COMMON PATH OF TRAVEL:			
UNIT 501	= 363 SQ.FT.	UNIT 501	= 212 SQ.FT. > 150 SQ.FT.	UNIT 501	= 35'-9"FT	<125'	
UNIT 502	= 338 SQ.FT.	UNIT 502	= 198 SQ.FT. > 150 SQ.FT.	UNIT 502	= 34'-9"FT	<125'	
UNIT 503	= 357 SQ.FT.	UNIT 503	= 214 SQ.FT. > 150 SQ.FT.	UNIT 503	= 34'-9"FT	<125'	
UNIT 504	= 344 SQ.FT.	UNIT 504	= 195 SQ.FT. > 150 SQ.FT.	UNIT 504	= 34'-9"FT	<125'	
UNIT 505	= 377 SQ.FT.	UNIT 505	= 205 SQ.FT. > 150 SQ.FT.	UNIT 505	= 39'-0"FT	<125'	
UNIT 506	= 341 SQ.FT.	UNIT 506	= 197 SQ.FT. > 150 SQ.FT.	UNIT 506	= 34'-6"FT	<125'	
UNIT 507	= 360 SQ.FT.	UNIT 507	= 225 SQ.FT. > 150 SQ.FT.	UNIT 507	= 37'-4"FT	<125'	
COMMON	= 550 SQ.FT.						
TOTAL	= 3031 SQ.FT.						

UNIT	sqft	UNIT	sqft	UNIT	sqft	UNIT	sqft
UNIT 501	314 sqft	UNIT 502	301 sqft	UNIT 503	317 sqft	UNIT 504	297 sqft
UNIT 505	333 sqft	UNIT 506	300 sqft	UNIT 507	316 sqft		
EFFICIENCY UNIT TOTAL FLOOR AREA:		MAXIMUM TRAVEL DISTANCE:					
UNIT 501	= 314 SQ.FT. > 220 SQ.FT.	UNIT 501	= 74'-6"FT	<250'			
UNIT 502	= 301 SQ.FT. > 220 SQ.FT.	UNIT 502	= 68'-0"FT	<250'			
UNIT 503	= 317 SQ.FT. > 220 SQ.FT.	UNIT 503	= 63'-0"FT	<250'			
UNIT 504	= 297 SQ.FT. > 220 SQ.FT.	UNIT 504	= 69'-9"FT	<250'			
UNIT 505	= 333 SQ.FT. > 220 SQ.FT.	UNIT 505	= 65'-9"FT	<250'			
UNIT 506	= 300 SQ.FT. > 220 SQ.FT.	UNIT 506	= 62'-0"FT	<250'			
UNIT 507	= 316 SQ.FT. > 220 SQ.FT.	UNIT 507	= 74'-8"FT	<250'			

UNIT	sqft	UNIT	sqft	UNIT	sqft	UNIT	sqft
UNIT 501	248 sqft	UNIT 507	246 sqft	UNIT 501	236 sqft	UNIT 506	234 sqft
UNIT 502	236 sqft	UNIT 506	234 sqft	UNIT 503	252 sqft	UNIT 505	266 sqft
UNIT 503	252 sqft	UNIT 505	266 sqft	UNIT 504	232 sqft	UNIT 505	213 sqft
UNIT 504	232 sqft	UNIT 505	213 sqft				
EXITING:		EXITING:					
OCCUPANCY TYPE: R-2		OCCUPANCY TYPE: R-2					
RESIDENTIAL LOAD FACTOR: 200 GSF/PERSON		RESIDENTIAL LOAD FACTOR: 200 GSF/PERSON					
OCCUPANCY: 3,031 SF/200 SF = 16 PEOPLE		OCCUPANCY: 3,031 SF/200 SF = 16 PEOPLE					
NUMBER OF EXITS REQUIRED: 2		NUMBER OF EXITS REQUIRED: 2					
NUMBER OF EXITS PROVIDED: 2		NUMBER OF EXITS PROVIDED: 2					
EXIT WIDTH REQUIRED PER EXIT: 0.2 IN. PER OCCUPANT: 0.2' x 8 = 2.4"		EXIT WIDTH REQUIRED PER EXIT: 0.2 IN. PER OCCUPANT: 0.2' x 8 = 2.4"					
EXIT WIDTH PROVIDED PER EXIT: STAIR-1 EXIT DOOR: 36 IN. > 2.4 IN.		EXIT WIDTH PROVIDED PER EXIT: STAIR-1 EXIT DOOR: 36 IN. > 2.4 IN.					
STAIR-2 EXIT DOOR: 36 IN. > 2.4 IN.		STAIR-2 EXIT DOOR: 36 IN. > 2.4 IN.					

UNIT	sqft	UNIT	sqft	UNIT	sqft	UNIT	sqft
UNIT 501	248 sqft	UNIT 507	246 sqft	UNIT 501	236 sqft	UNIT 506	234 sqft
UNIT 502	236 sqft	UNIT 506	234 sqft	UNIT 503	252 sqft	UNIT 505	266 sqft
UNIT 503	252 sqft	UNIT 505	266 sqft	UNIT 504	232 sqft	UNIT 505	213 sqft
UNIT 504	232 sqft	UNIT 505	213 sqft				
STAIR WIDTH REQUIRED:		STAIR WIDTH REQUIRED:					
0.3 IN. PER OCCUPANT: 0.3' x 8 = 2.4 IN.		0.3 IN. PER OCCUPANT: 0.3' x 8 = 2.4 IN.					
36 IN. PROVIDED AS PER 2016 CBC SECTION 1011.2 EXCEPTION 1		36 IN. PROVIDED AS PER 2016 CBC SECTION 1011.2 EXCEPTION 1					
BUILDING DIAGONAL: 76'-4"		BUILDING DIAGONAL: 76'-4"					
1/3 DIAGONAL: 28'-6"		1/3 DIAGONAL: 28'-6"					
EXIT ACCESS SEPARATION: 38'-6" > 28'-6"		EXIT ACCESS SEPARATION: 38'-6" > 28'-6"					

UNIT	sqft	UNIT	sqft	UNIT	sqft	UNIT	sqft
UNIT 501	248 sqft	UNIT 507	246 sqft	UNIT 501	236 sqft	UNIT 506	234 sqft
UNIT 502	236 sqft	UNIT 506	234 sqft	UNIT 503	252 sqft	UNIT 505	266 sqft
UNIT 503	252 sqft	UNIT 505	266 sqft	UNIT 504	232 sqft	UNIT 505	213 sqft
UNIT 504	232 sqft	UNIT 505	213 sqft				
LIGHT AND AIR CALCULATIONS:		LIGHT AND AIR CALCULATIONS:					
FLOOR AREA = 248.00 SQ.FT.		FLOOR AREA = 236.00 SQ.FT.					
REQ. MIN. WDW AREA 8% = 19.85 SQ.FT.		REQ. MIN. WDW AREA 8% = 18.88 SQ.FT.					
PROVIDED WDW AREA = 31.95 SQ.FT.		PROVIDED WDW AREA = 28.95 SQ.FT.					
REQ. MIN. VENT AREA 4% = 9.93 SQ.FT.		REQ. MIN. VENT AREA 4% = 9.44 SQ.FT.					
PROVIDED VENT AREA = MECH. VENT.		PROVIDED VENT AREA = MECH. VENT.					

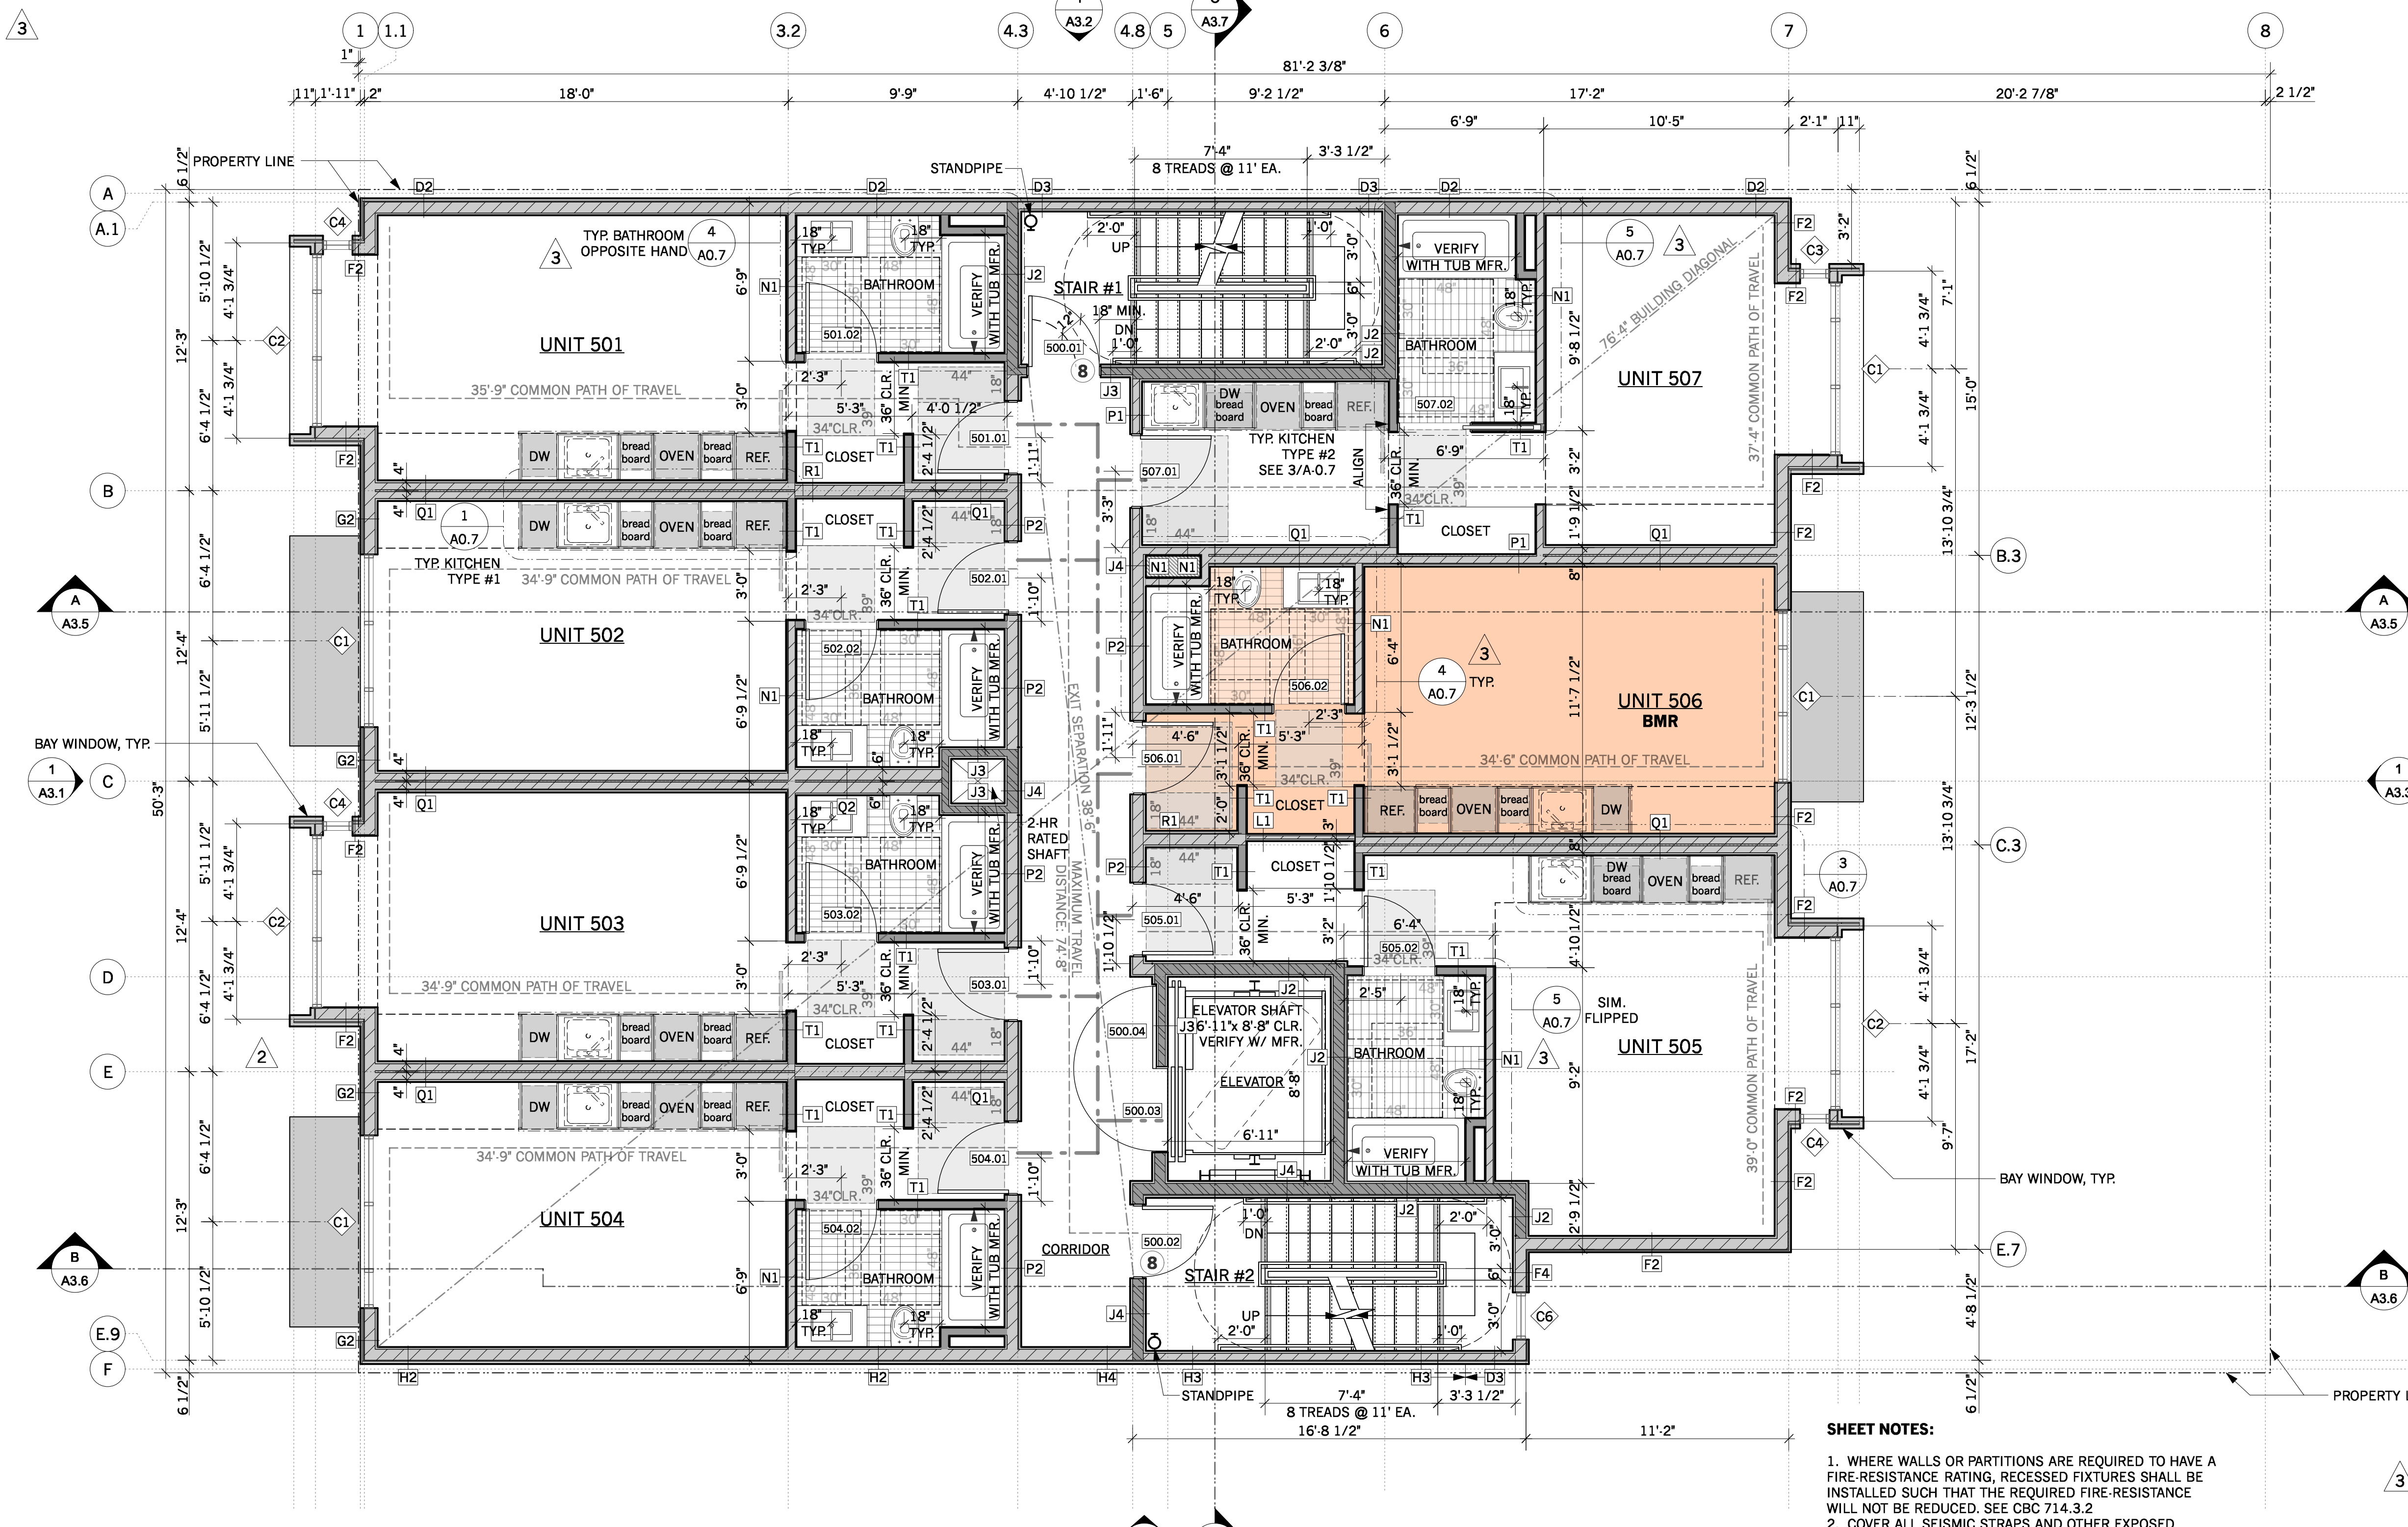


UNIT	sqft	UNIT	sqft	UNIT	sqft	UNIT	sqft
UNIT 501	248 sqft	UNIT 507	246 sqft	UNIT 501	236 sqft	UNIT 506	234 sqft
UNIT 502	236 sqft	UNIT 506	234 sqft	UNIT 503	252 sqft	UNIT 505	266 sqft
UNIT 503	252 sqft	UNIT 505	266 sqft	UNIT 504	232 sqft	UNIT 505	213 sqft
UNIT 504	232 sqft	UNIT 505	213 sqft				
STAIR WIDTH REQUIRED:		STAIR WIDTH REQUIRED:					
0.3 IN. PER OCCUPANT: 0.3' x 8 = 2.4 IN.		0.3 IN. PER OCCUPANT: 0.3' x 8 = 2.4 IN.					
36 IN. PROVIDED AS PER 2016 CBC SECTION 1011.2 EXCEPTION 1		36 IN. PROVIDED AS PER 2016 CBC SECTION 1011.2 EXCEPTION 1					
BUILDING DIAGONAL: 76'-4"		BUILDING DIAGONAL: 76'-4"					
1/3 DIAGONAL: 28'-6"		1/3 DIAGONAL: 28'-6"					
EXIT ACCESS SEPARATION: 38'-6" > 28'-6"		EXIT ACCESS SEPARATION: 38'-6" > 28'-6"					

SHEET NOTES:

- WHERE WALLS OR PARTITIONS ARE REQUIRED TO HAVE A FIRE-RESISTANCE RATING, RECESSED FIXTURES SHALL BE INSTALLED SUCH THAT THE REQUIRED FIRE-RESISTANCE WILL NOT BE REDUCED. SEE CBC 714.3.2
- COVER ALL SEISMIC STRAPS AND OTHER EXPOSED STRUCTURAL HARDWARE WITH SELF-ADHERED FLASHING PRIOR TO THE APPLICATION OF THE WATER-RESISTIVE BARRIER.
- FIREBLOCKING SHALL BE PROVIDED IN CONCEALED SPACES OF STUD WALLS AND PARTITIONS, INCLUDING FURRED SPACES, AND PARALLEL ROWS OF STUDS OR STAGGERED STUDS, AS FOLLOWS:
VERTICALLY AT THE CEILING AND FLOOR LEVELS.
HORIZONTALLY AT INTERVALS NOT EXCEEDING 10 FEET.
- EMERGENCY EGRESS WINDOW TO HAVE:
NET CLEAR OPENABLE AREA OF 5.7 SQ.FT.
NET CLEAR HEIGHT 24" MINIMUM.
NET CLEAR WIDTH 20" MINIMUM.
SILL HEIGHT 44" MAXIMUM.
- ALL RESIDENTIAL UNITS TO HAVE 4 BURNER STOVES.

KEY	DESCRIPTION
(N) UNRATED WALL	(N) UNRATED WALL
(N) 1-HR WALL	(N) 1-HR WALL
(N) 2-HR WALL	(N) 2-HR WALL
(N) 3-HR WALL	(N) 3-HR WALL
---	COMMON PATH OF TRAVEL
- - -	EGRESS PATH OF TRAVEL
- · - · -	ACCESSIBLE PATH OF TRAVEL
(12)	OCCUPANT LOAD
⊠	RATED SHAFT

1 FIFTH FLOOR PLAN
Scale: 1/4" = 1'-0"

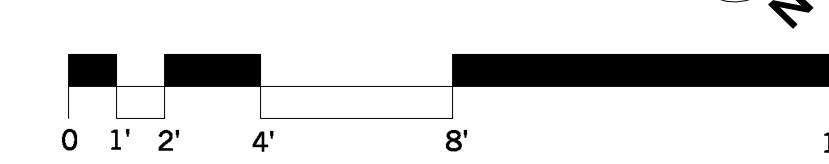

ELEVATIONarchitects
1159 Green Street, Suite 4
San Francisco, CA 94109
415.537.1125 :v
www.elevationarchitects.com :w

LICENSED ARCHITECT
JONATHAN PEARLMAN
No C 26034
RENEW 06/30/21
STATE OF CALIFORNIA


agency stamps:

Condominiums
42 Otis Street
San Francisco, CA 94103
Block / Lot : 3503 / 020

#	date	issue
2	4.15.20	Project Revision 2
3	4.27.20	Plan Check Response 2
4	8.17.20	Plan Check Response 3


sheet count 24/49
5th Floor Plan
project: 16.15
drawn by: mka
checked by: jp
date: 01.21.19
scale:

A-2.5

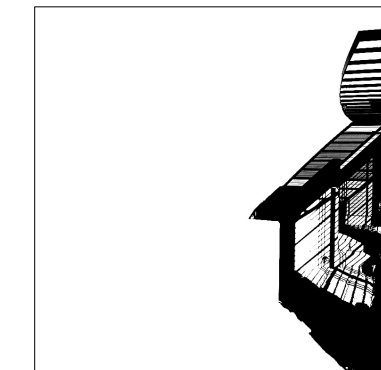

ELEVATIONarchitects
1159 Green Street, Suite 4
San Francisco, CA 94109

415.537.1125 :v
www.elevationarchitects.com :w

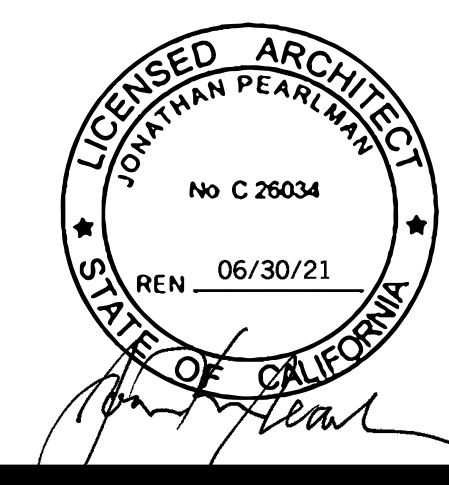

agency stamps:

Condominiums
42 Otis Street
San Francisco, CA 94103
Block / Lot : 3503 / 020


#	date	issue
2	4.15.20	Project Revision 2
3	4.27.20	Plan Check Response 2
4	8.17.20	Plan Check Response 3

sheet count 25/49


Roof Plan


project: 16.15
drawn by: mka
checked by: jp
date: 01.21.19
scale:

A-2.6

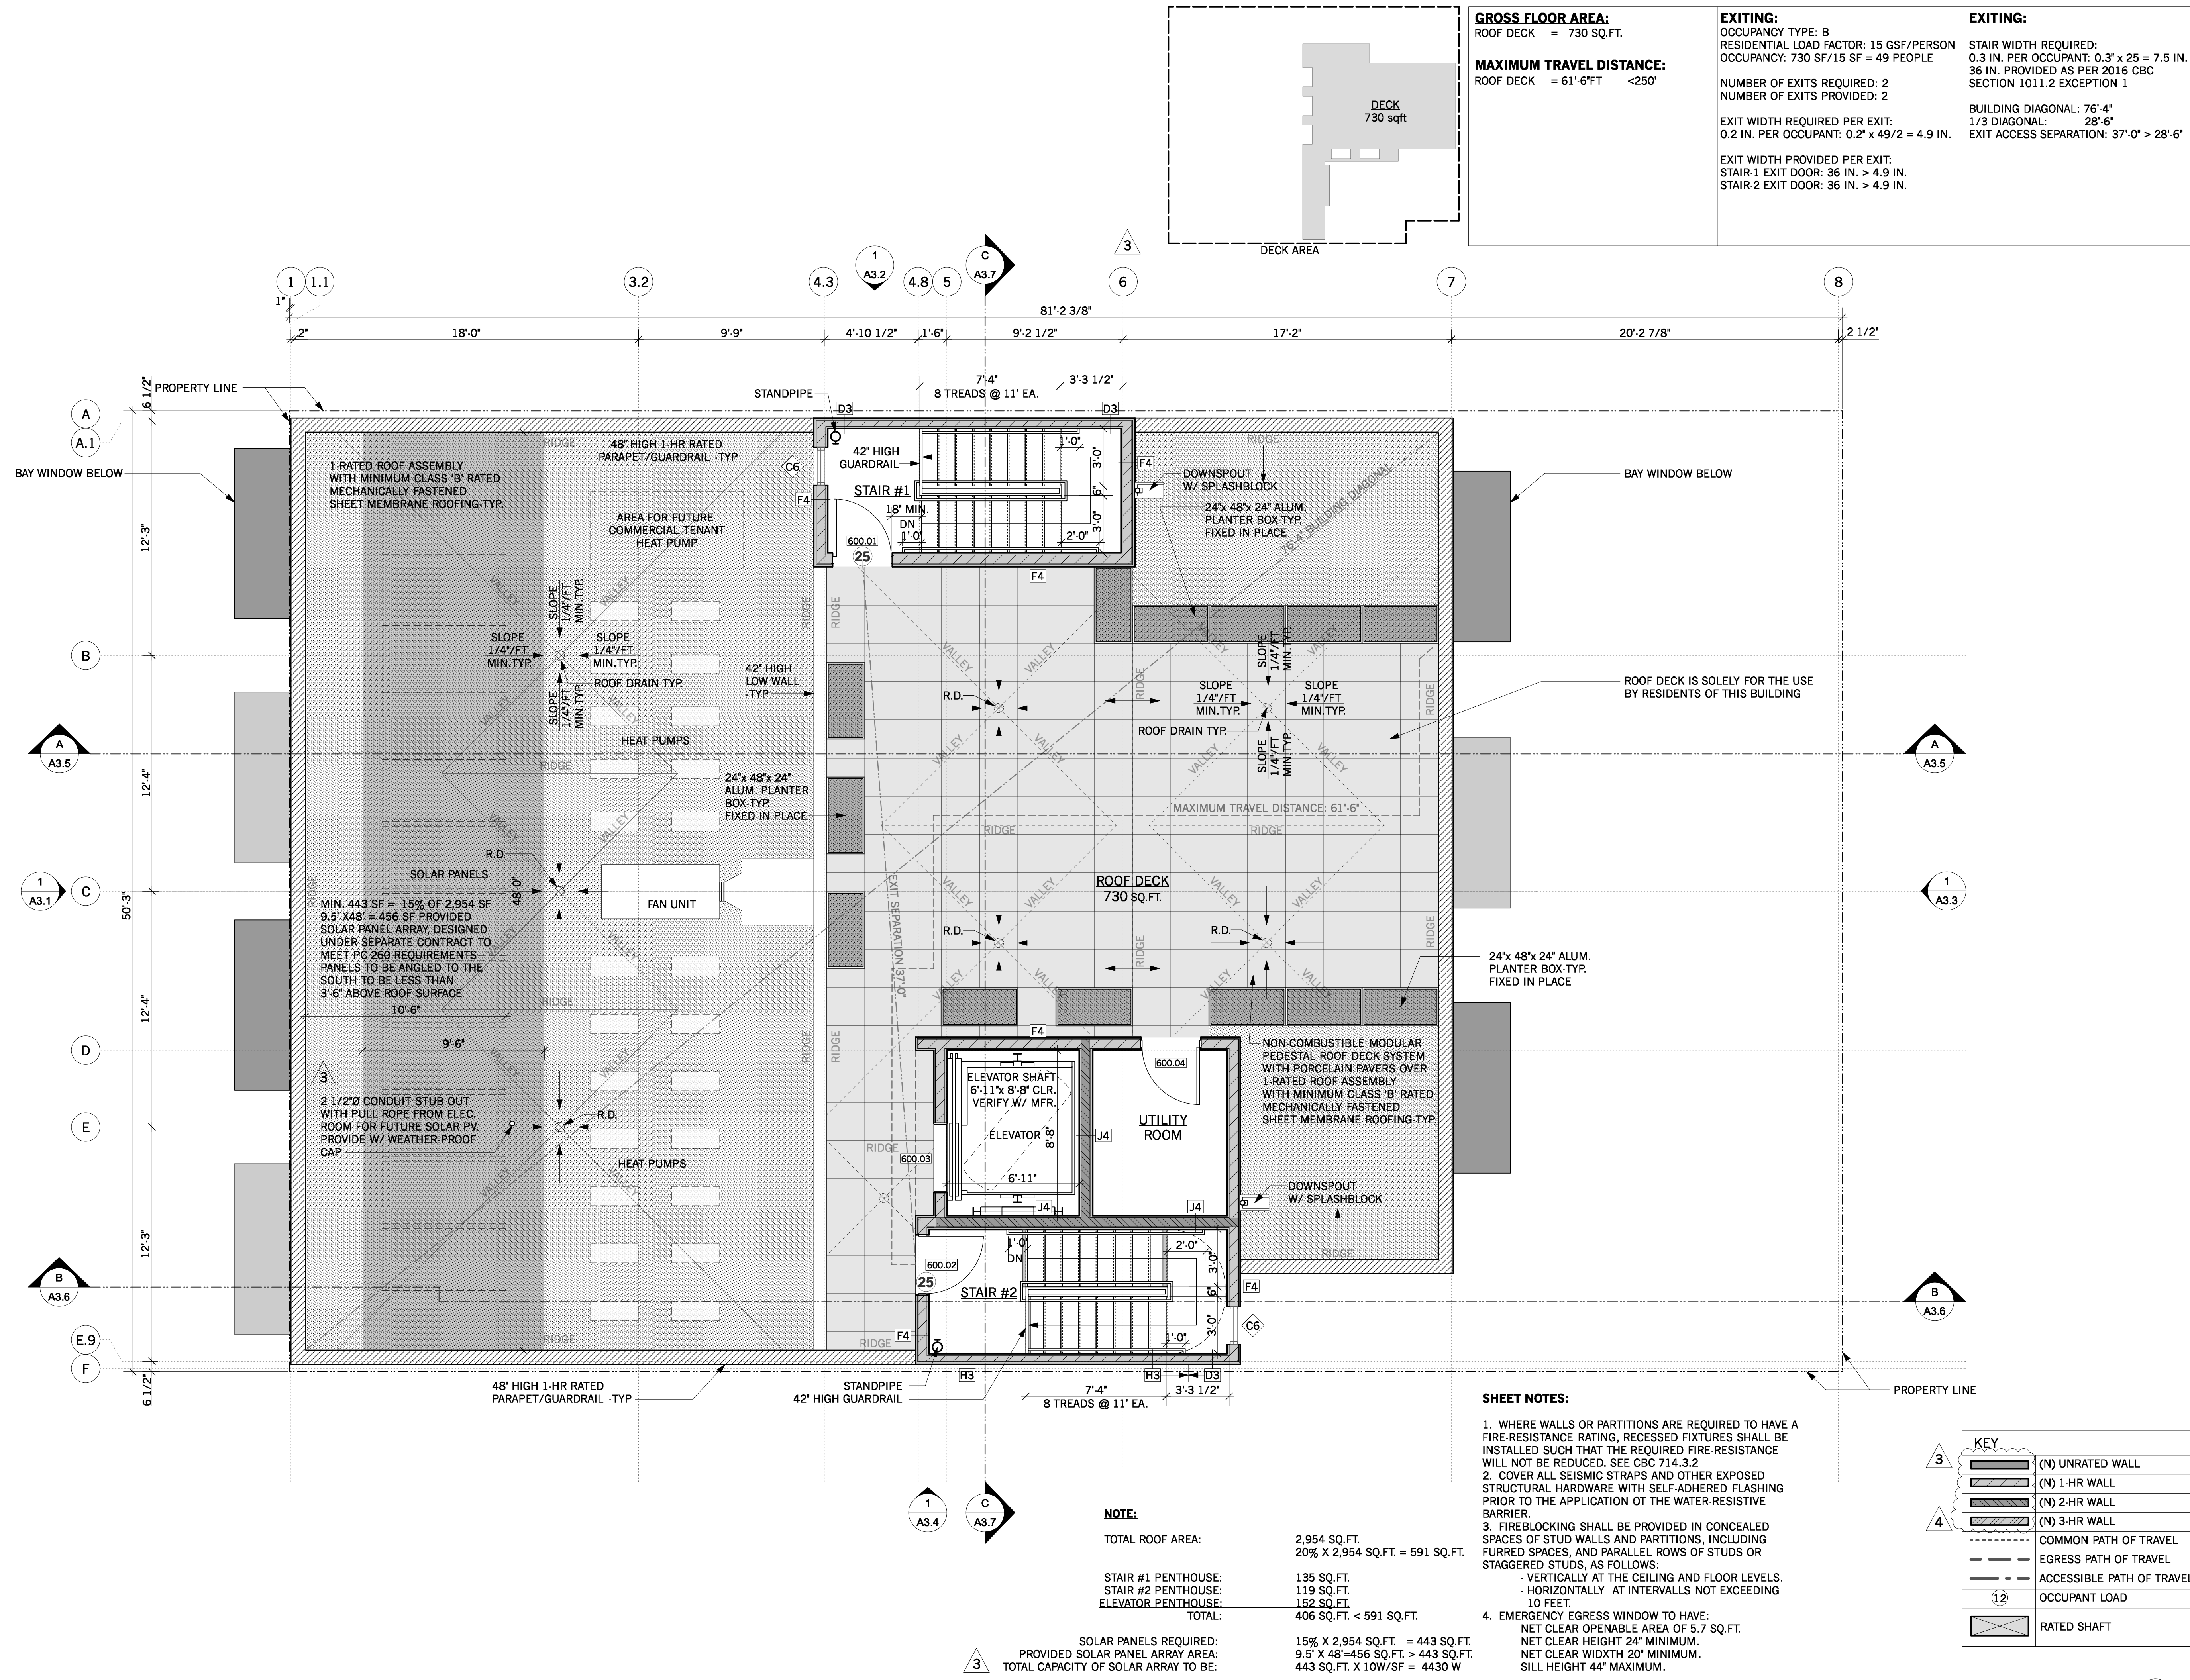


1 ROOF PLAN
Scale: 1/4" = 1'-0"

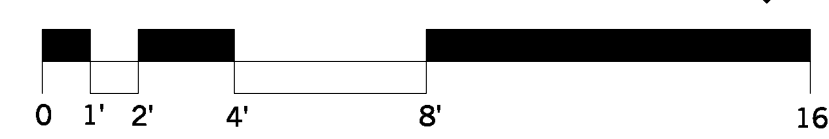

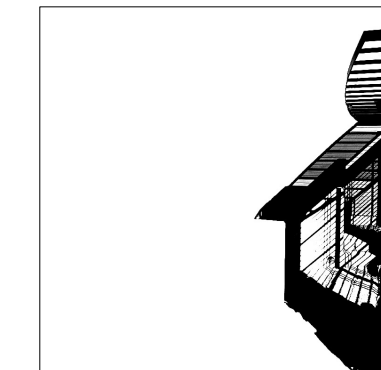

ELEVATIONarchitects
 1159 Green Street, Suite 4
 San Francisco, CA 94109

415.537.1125 :v
 www.elevationarchitects.com :w

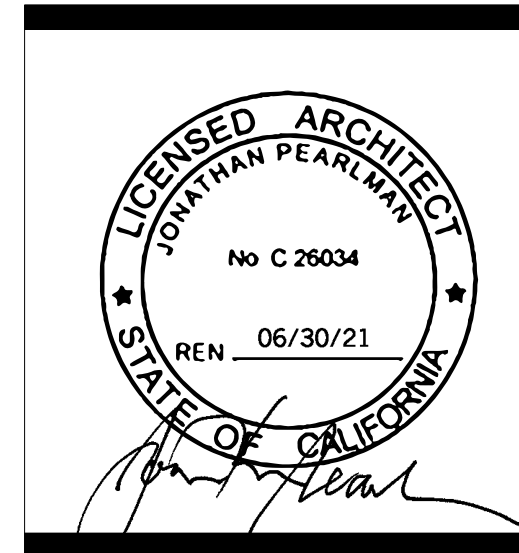

agency stamps:

Condominiums
 42 Otis Street
 San Francisco, CA 94103
 Block / Lot : 3503 / 020


#	date	issue
2	4.15.20	Project Revision 2
3	4.27.20	Plan Check Response 2
4	8.17.20	Plan Check Response 3

sheet count 26/49


Penthouse Roof Plan

project: 16.15
 drawn by: mka
 checked by: jp
 date: 01.21.19
 scale:

A-2.7

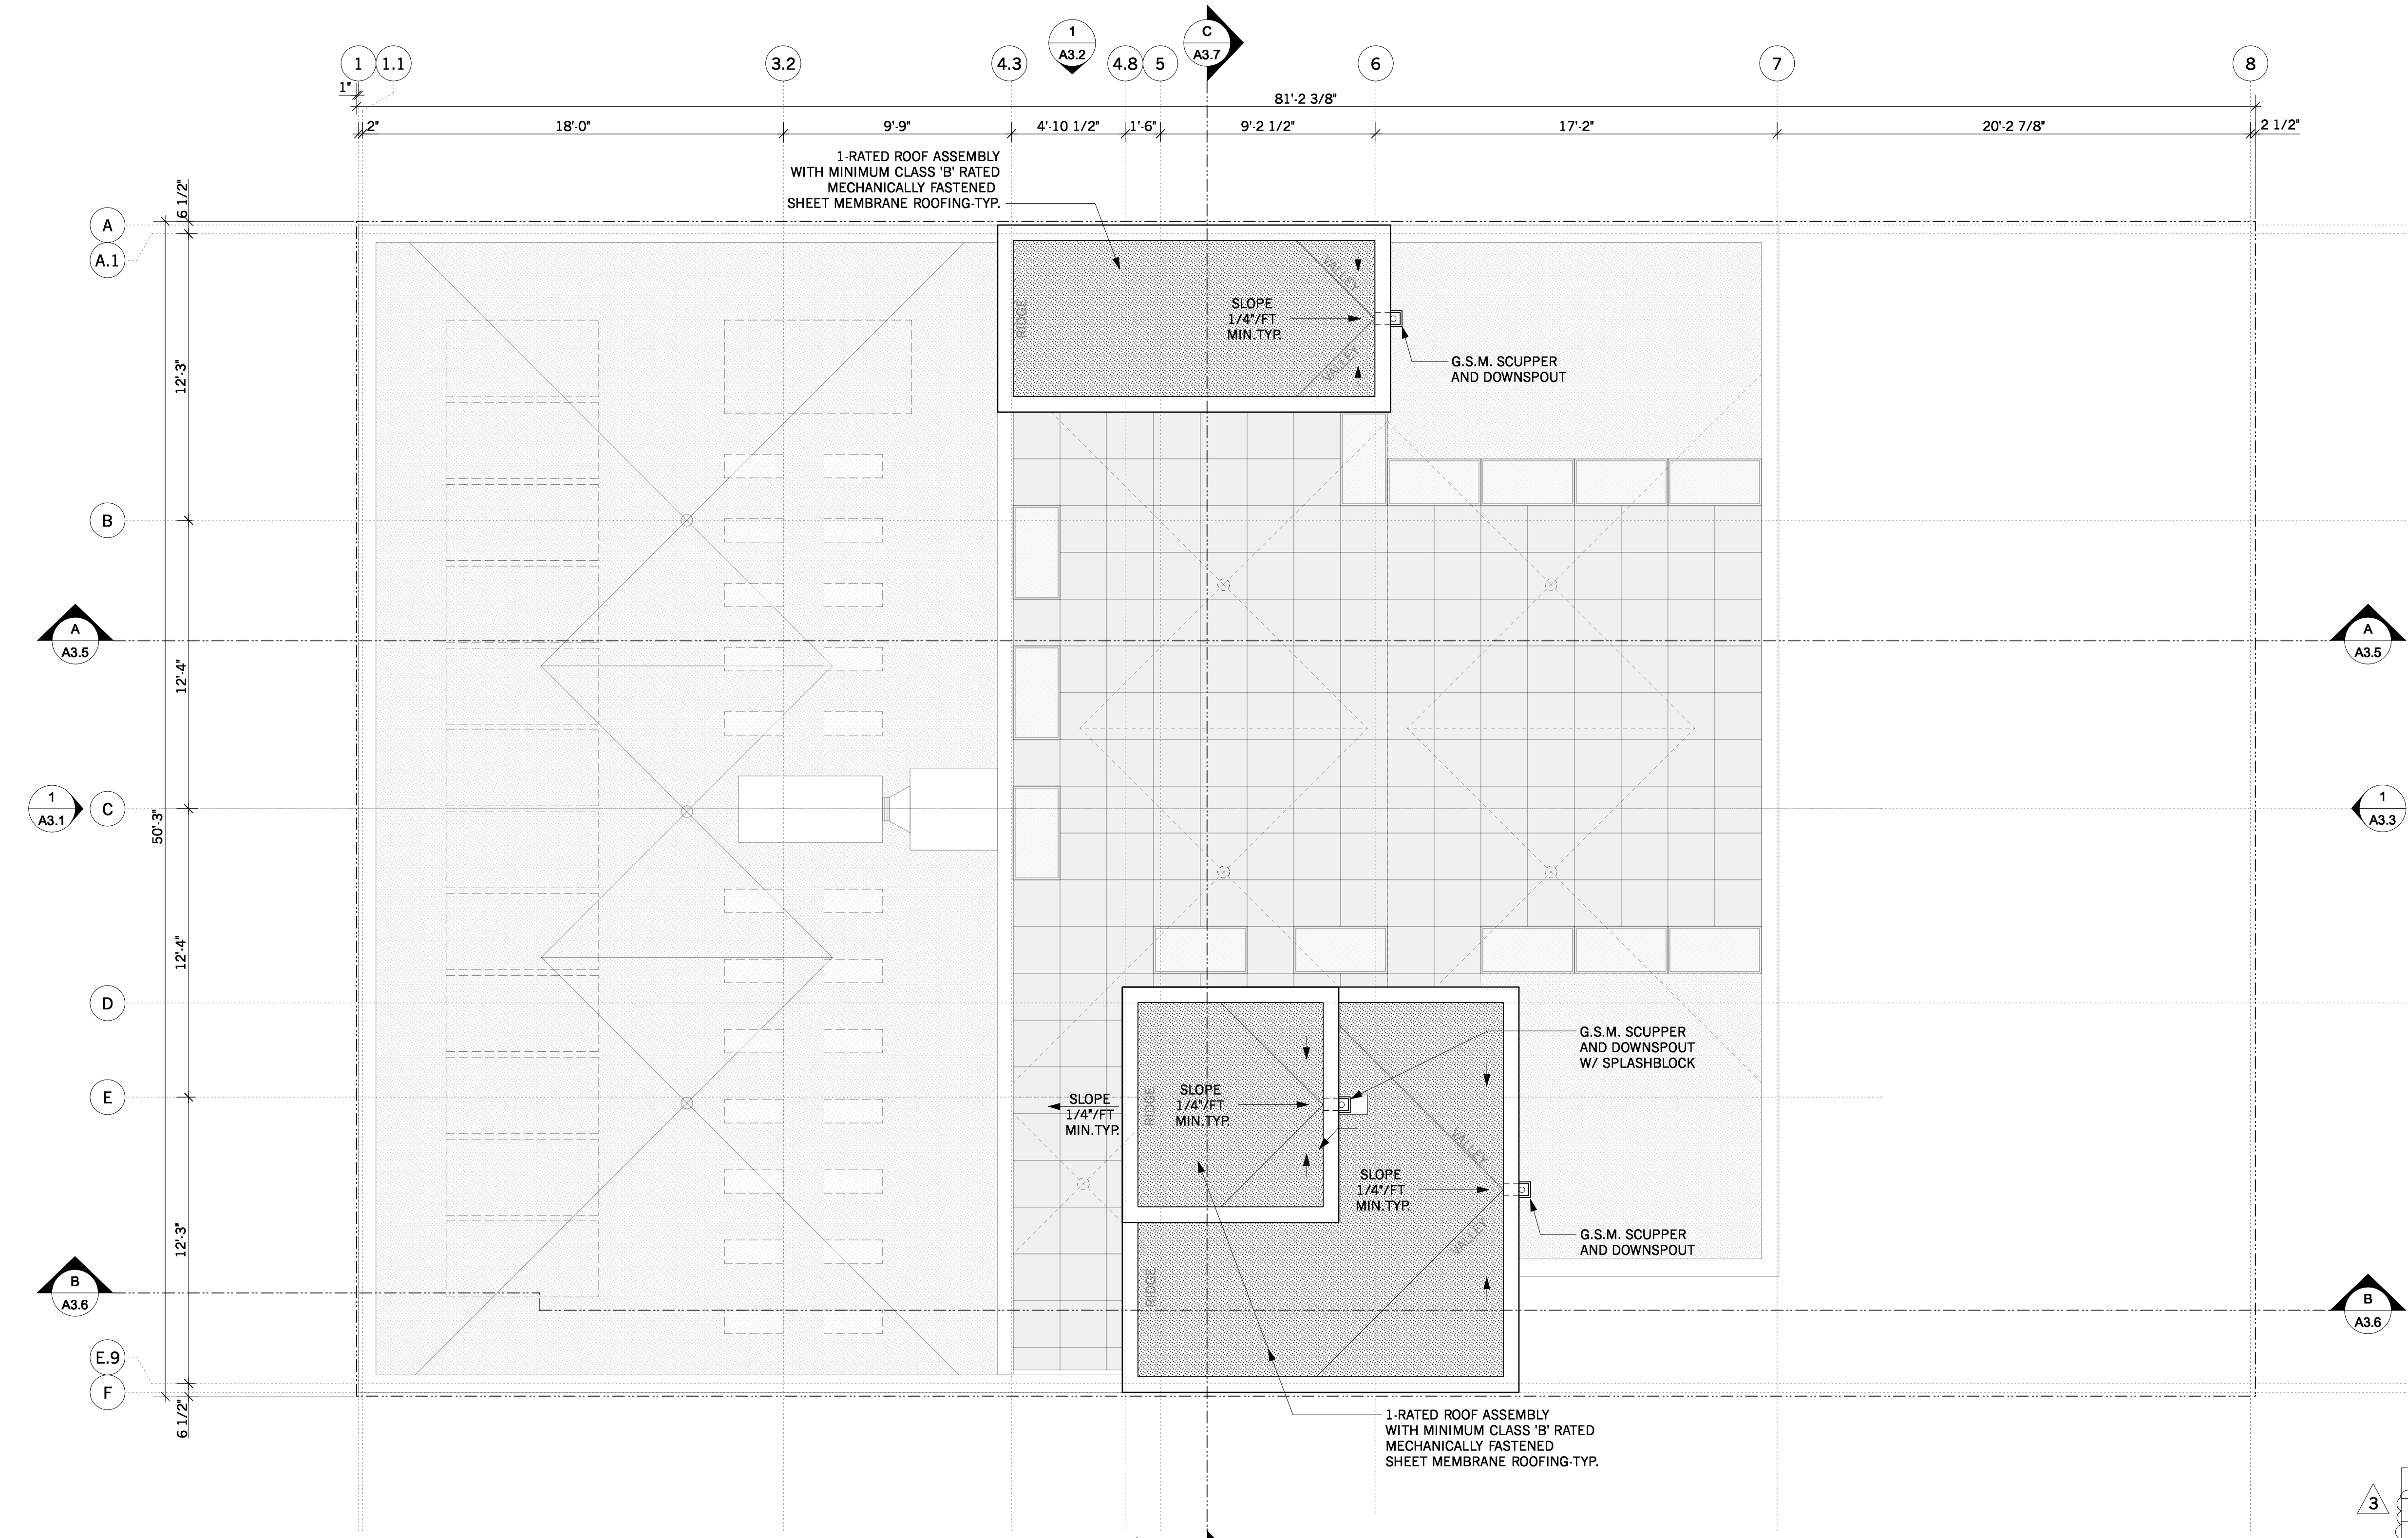


KEY	
(Symbol)	(N) UNRATED WALL
(Symbol)	(N) 1-HR WALL
(Symbol)	(N) 2-HR WALL
(Symbol)	(N) 3-HR WALL
(Symbol)	COMMON PATH OF TRAVEL
(Symbol)	EGRESS PATH OF TRAVEL
(Symbol)	ACCESSIBLE PATH OF TRAVEL
(Symbol)	OCCUPANT LOAD
(Symbol)	RATED SHAFT

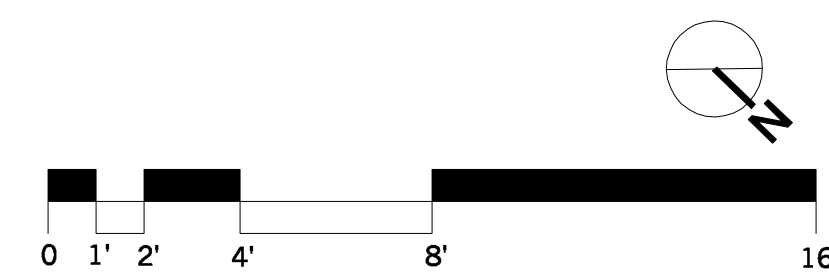

1 PENTHOUSE ROOF PLAN
 Scale: 1/4" = 1'-0"



1 SOUTH ELEVATION
Scale: 1/4" = 1'-0"

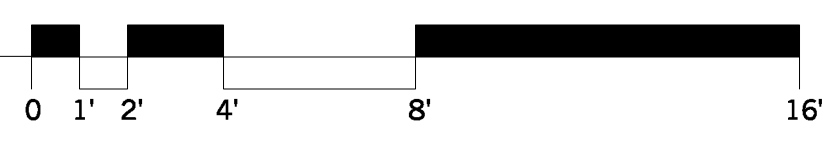

ELEVATIONArchitects
1159 Green Street, Suite 4
San Francisco, CA 94109
415.537.1125 :v
www.elevationarchitects.com :w



agency stamps:

Condominiums
42 Otis Street
San Francisco, CA 94103
Block / Lot : 3503 / 020

#	date	issue
2	4.15.20	Project Revision 2
3	4.27.20	Plan Check Response 2
4	8.17.20	Plan Check Response 3


sheet count 27/49

South Elevation

project: 16.15
drawn by: mka
checked by: jp
date: 01.21.19
scale: as noted

A-3.1

NOTES:
1. EMERGENCY EGRESS WINDOW TO HAVE:
NET CLEAR OPENABLE AREA OF 5.7 SQ.FT.
NET CLEAR HEIGHT 24" MINIMUM.
NET CLEAR WIDTH 20" MINIMUM.
SILL HEIGHT 44" MAXIMUM.

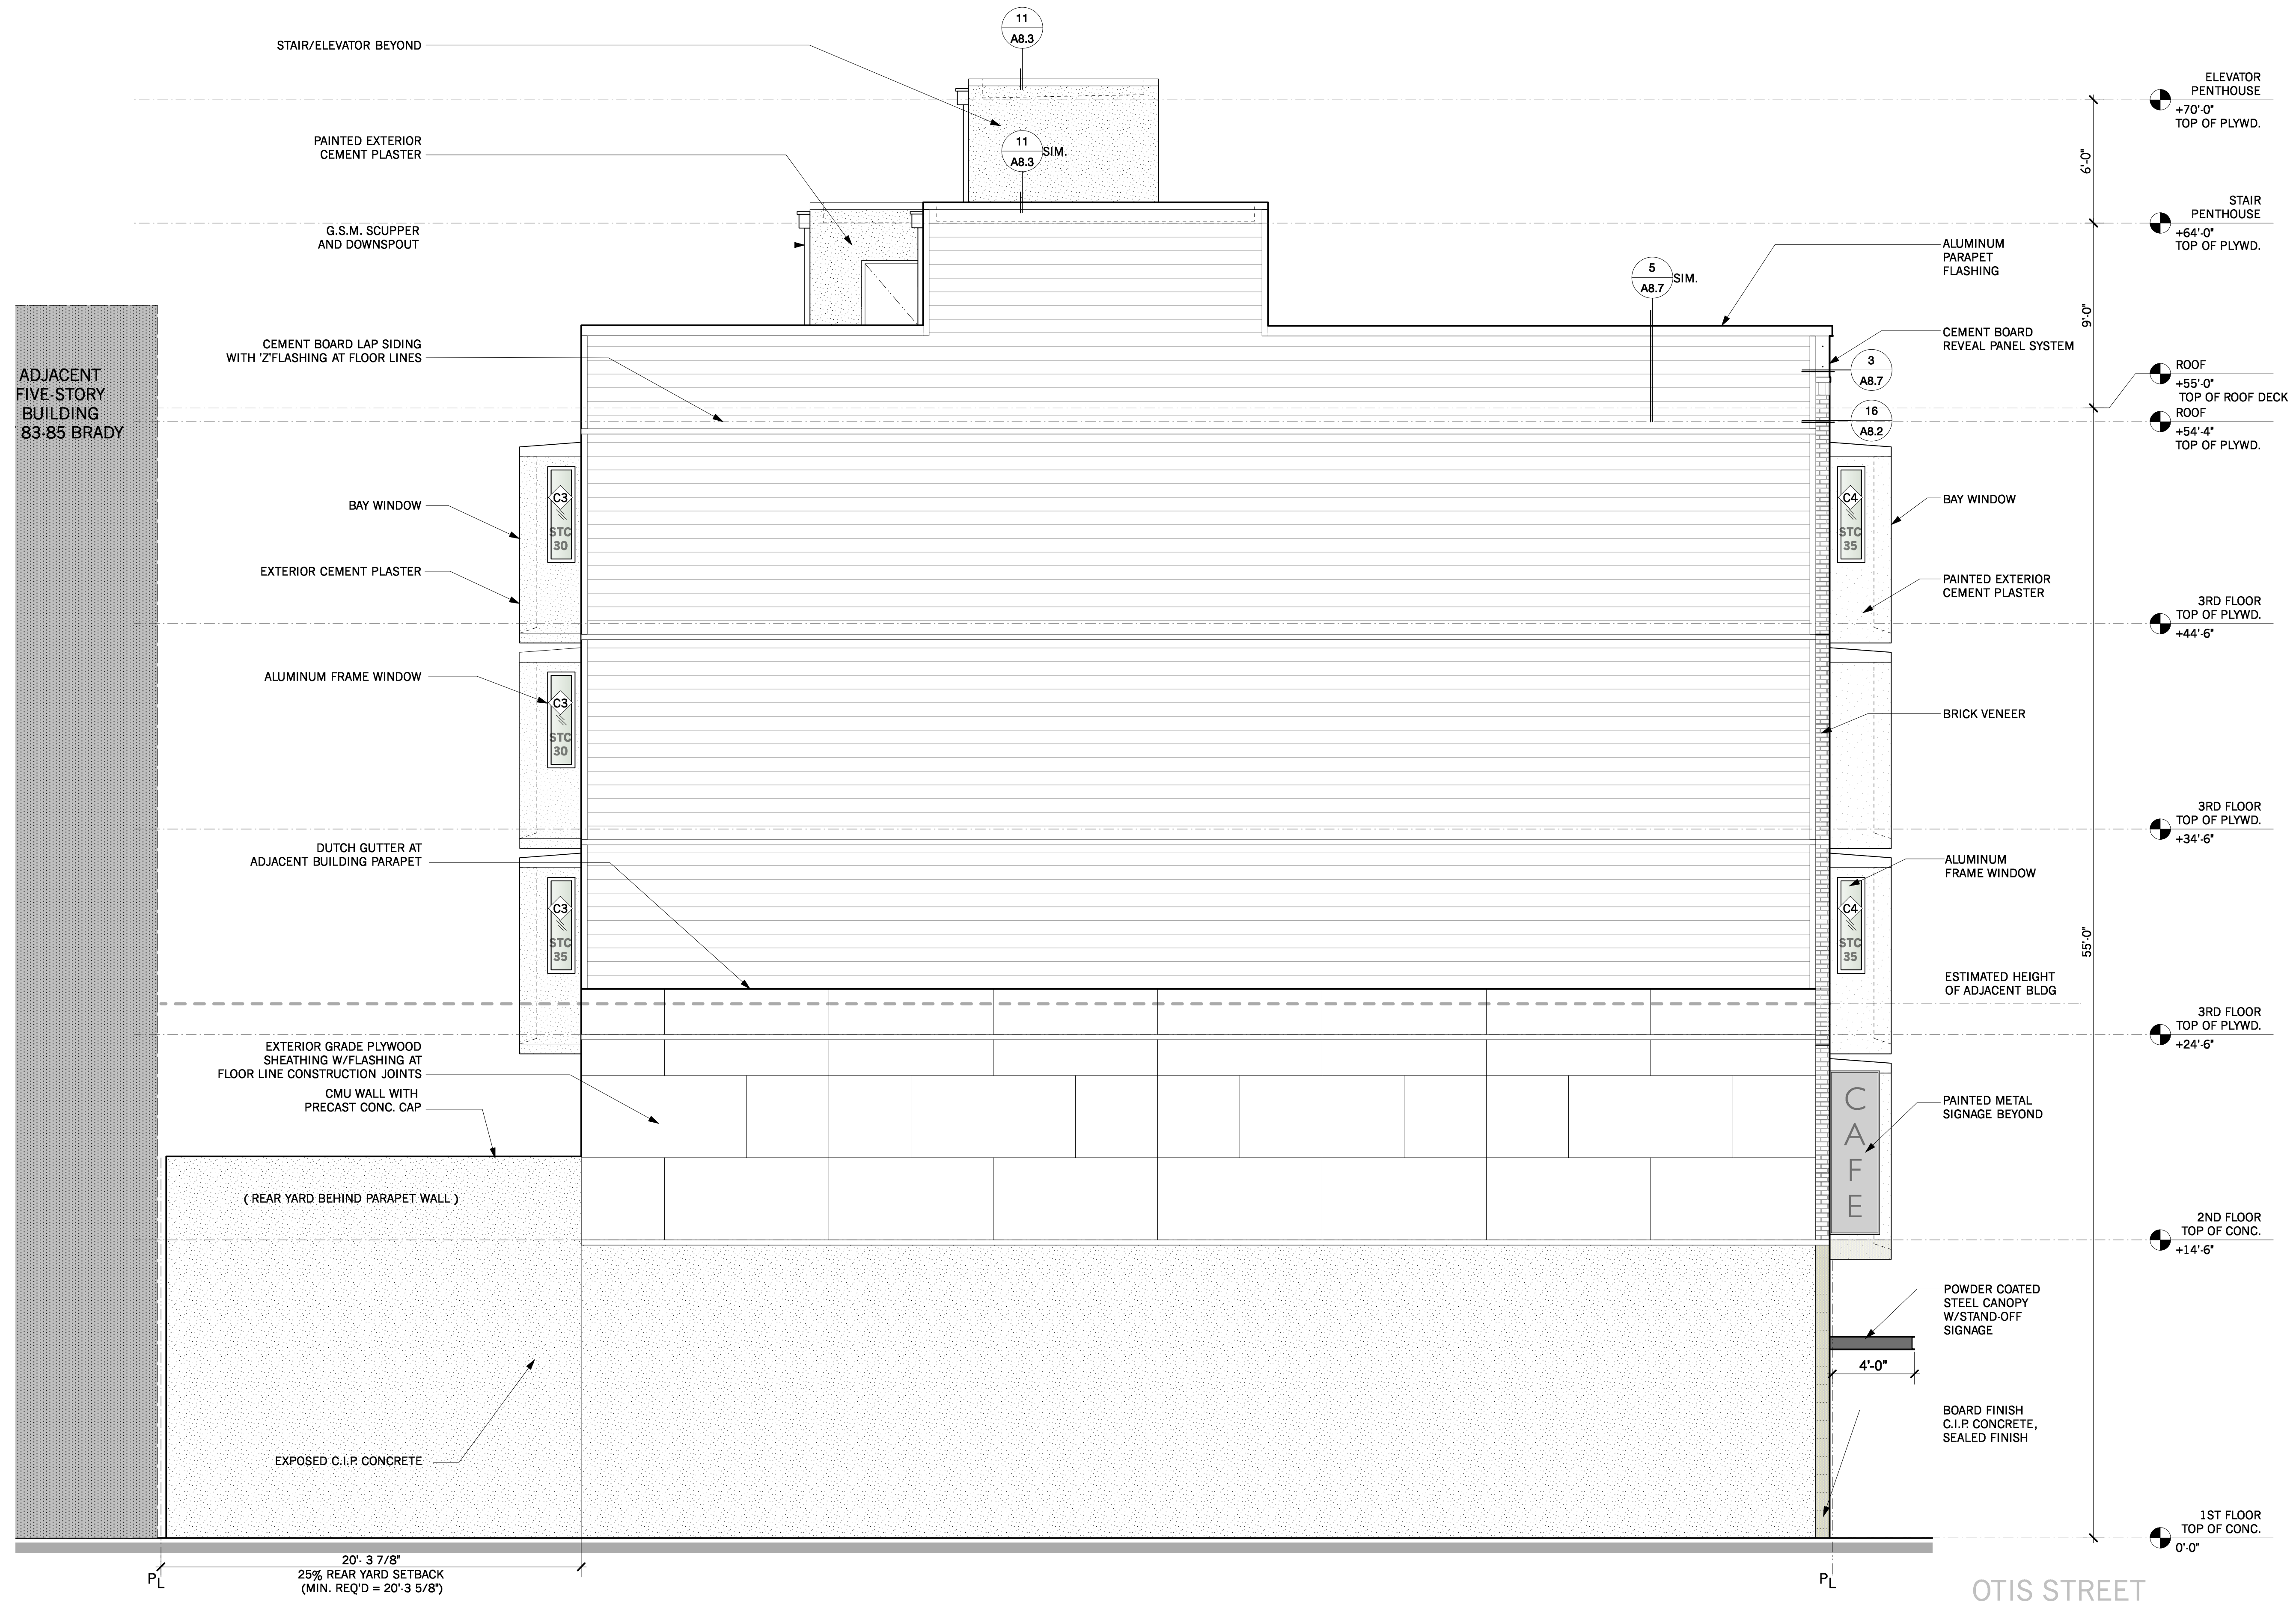



ADJACENT FIVE-STORY BUILDING 83-85 BRADY

(REAR YARD BEHIND PARAPET WALL)

20'-3 7/8"
25% REAR YARD SETBACK
(MIN. REQ'D = 20'-3 5/8")

OTIS STREET

1 WEST ELEVATION
Scale: 1/4" = 1'-0"

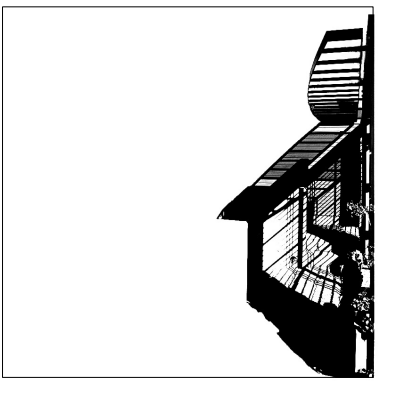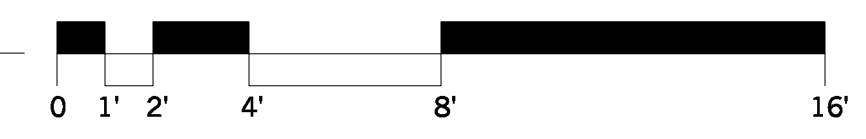

ELEVATIONarchitects
1159 Green Street, Suite 4
San Francisco, CA 94109
415.537.1125 :v
www.elevationarchitects.com :w



agency stamps:

Condominiums
42 Otis Street
San Francisco, CA 94103
Block / Lot : 3503 / 020

#	date	issue
2	4.15.20	Project Revision 2
3	4.27.20	Plan Check Response 2
4	8.17.20	Plan Check Response 3


sheet count 28/49

West Elevation


project: 16.15
drawn by: mka
checked by: jp
date: 01.21.19
scale: as noted

A-3.2

ALLOWABLE AREA OF UNPROTECTED OPENINGS AT REAR BAY WINDOWS:
 AS PER TABLE 705.8
 DISTANCE 15' TO LESS THAN 20'
 ALLOWABLE AREA OF UNPROTECTED OPENINGS 75% OF WALL AREA IN SPRINKLERED BLDG.
 TYPICAL WALL AREA AT BAY 85.87 SQ.FT.
 UNPROTECTED OPENINGS 56.86 SQ.FT.
 85.87 SQ.FT. x .75 = 64.40 SQ.FT.
 56.86 SQ.FT. < 64.40 SQ.FT.

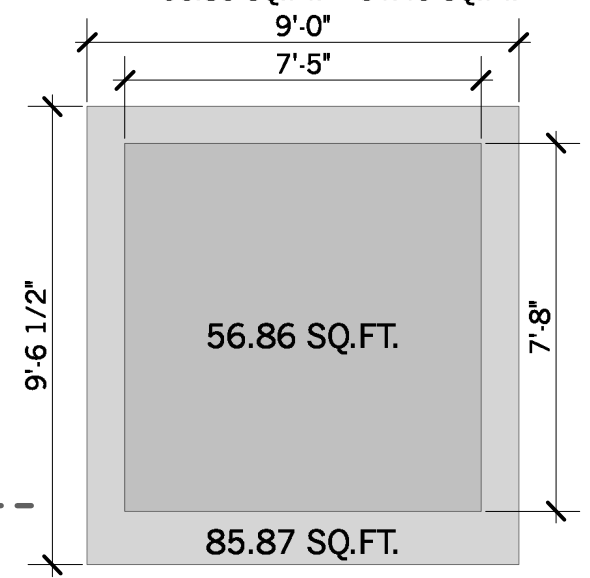

Elevationarchitects
 1159 Green Street, Suite 4
 San Francisco, CA 94109
 415.537.1125 :v
 www.elevationarchitects.com :w

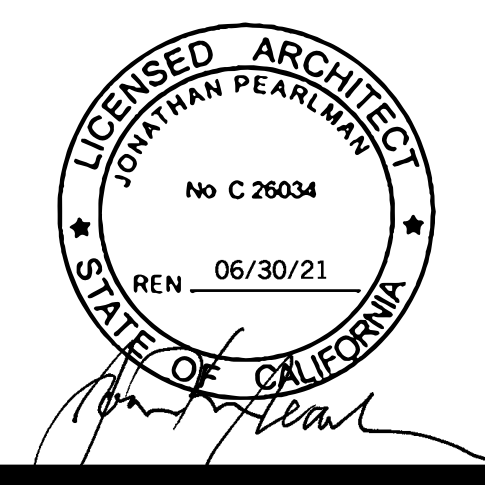

agency stamps:

Condominiums
 42 Otis Street
 San Francisco, CA 94103
 Block / Lot : 3503 / 020

#	date	issue
2	4.15.20	Project Revision 2
3	4.27.20	Plan Check Response 2
4	8.17.20	Plan Check Response 3

sheet count 29/49

North Elevation

project: 16.15
 drawn by: mka
 checked by: jp
 date: 01.21.19
 scale: as noted

A-3.3





NOTES:
 1. EMERGENCY EGRESS WINDOW TO HAVE:
 NET CLEAR OPENABLE AREA OF 5.7 SQ.FT.
 NET CLEAR HEIGHT 24" MINIMUM.
 NET CLEAR WIDTH 20" MINIMUM.
 SILL HEIGHT 44" MAXIMUM.

KEY

(N) UN-RATED ASSEMBLY
(N) 1-HR RATED ASSEMBLY
(N) 2-HR RATED ASSEMBLY
(N) 3-HR RATED ASSEMBLY

1 NORTH ELEVATION
 Scale: 1/4" = 1'-0"

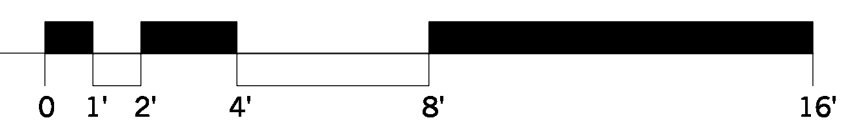

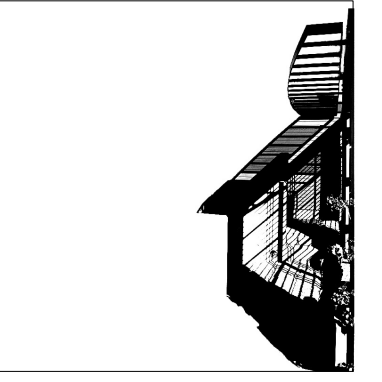

ELEVATIONarchitects
1159 Green Street, Suite 4
San Francisco, CA 94109

415.537.1125 :v
www.elevationarchitects.com :w



agency stamps:

Condominiums
42 Otis Street
San Francisco, CA 94103
Block / Lot : 3503 / 020


#	date	issue
2	4.15.20	Project Revision 2
3	4.27.20	Plan Check Response 2
4	8.17.20	Plan Check Response 3

sheet count 30/49


East Elevation

project: 16.15
drawn by: mka
checked by: jp
date: 01.21.19
scale: as noted

A-3.4

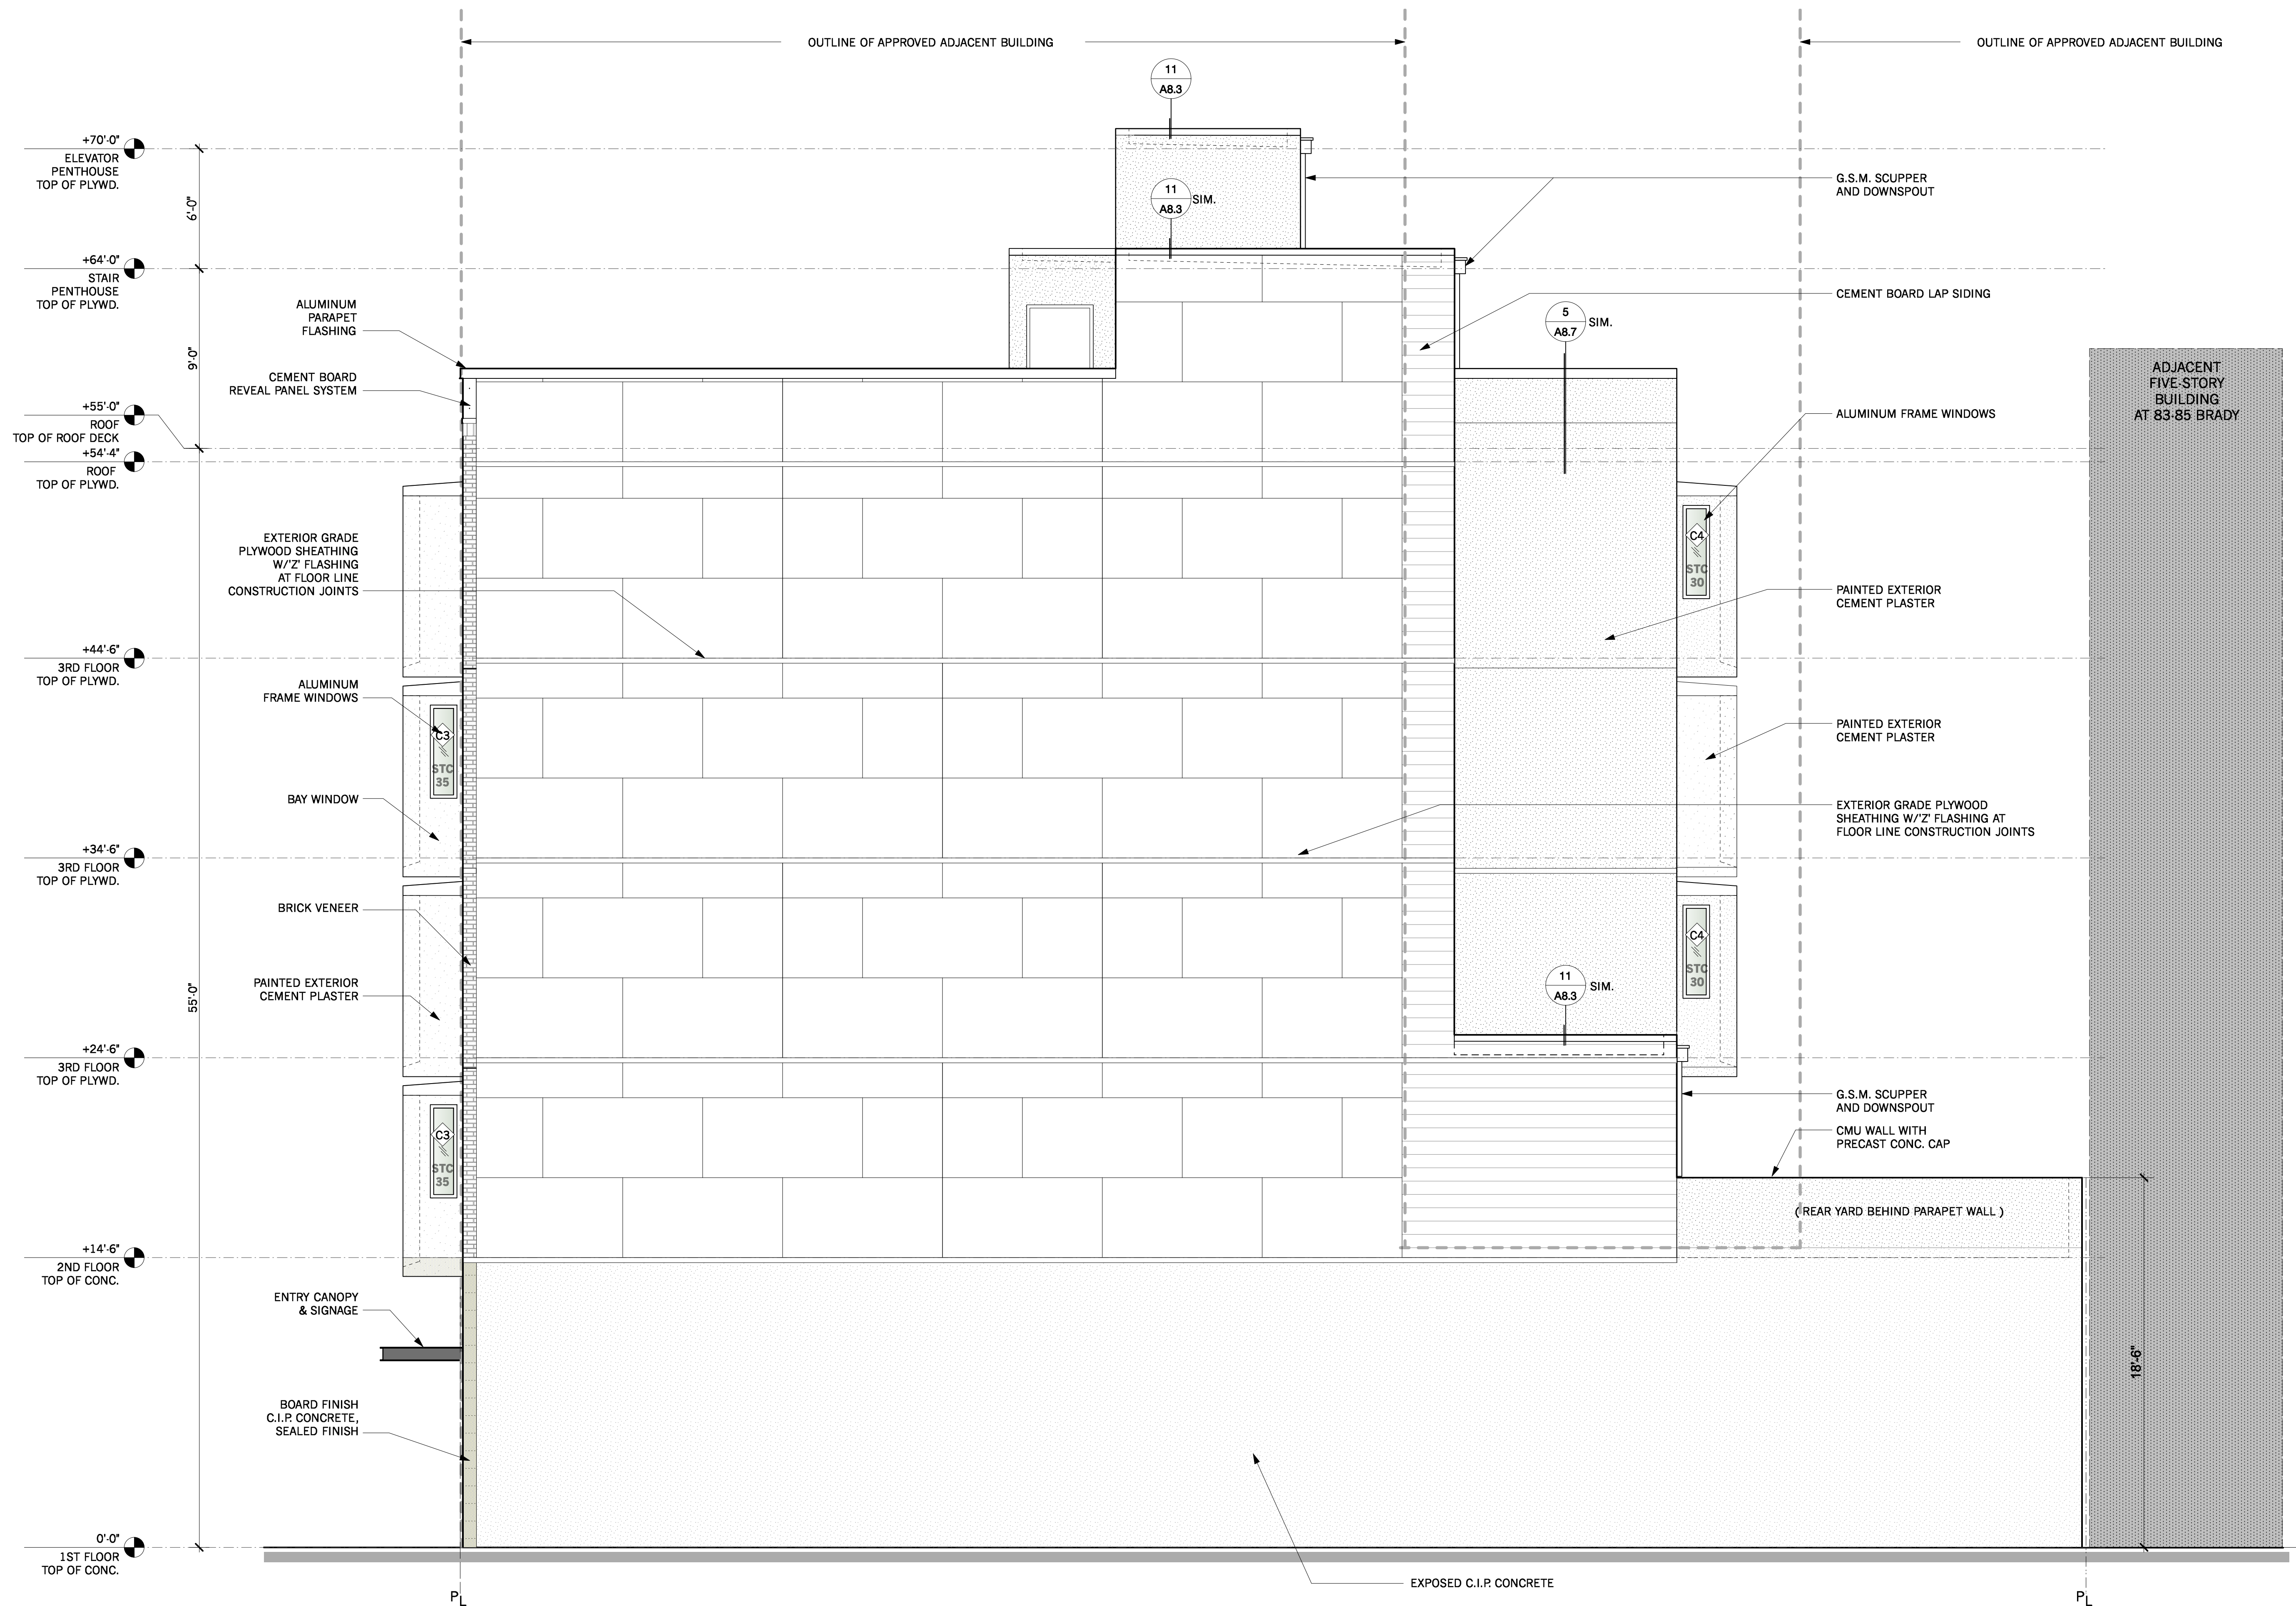

1 EAST ELEVATION
Scale: 1/4" = 1'-0"

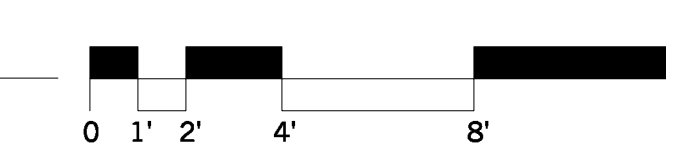




ELEVATIONarchitects

1159 Green Street, Suite 4
San Francisco, CA 94109

415.537.1125 :v
www.elevationarchitects.com :w

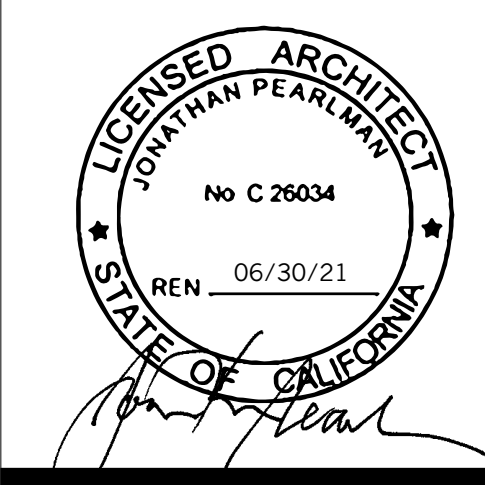

agency stamps:

Condominiums
42 Otis Street
San Francisco, CA 94103
Block / Lot : 3503 / 020


#	date	issue
2	4.15.20	Project Revision 2
3	4.27.20	Plan Check Response 2
4	8.17.20	Plan Check Response 3

sheet count 31/49

Section A-A

project: 16.15
 drawn by: mka
 checked by: jp
 date: 01.21.19
 scale:


A-3.5

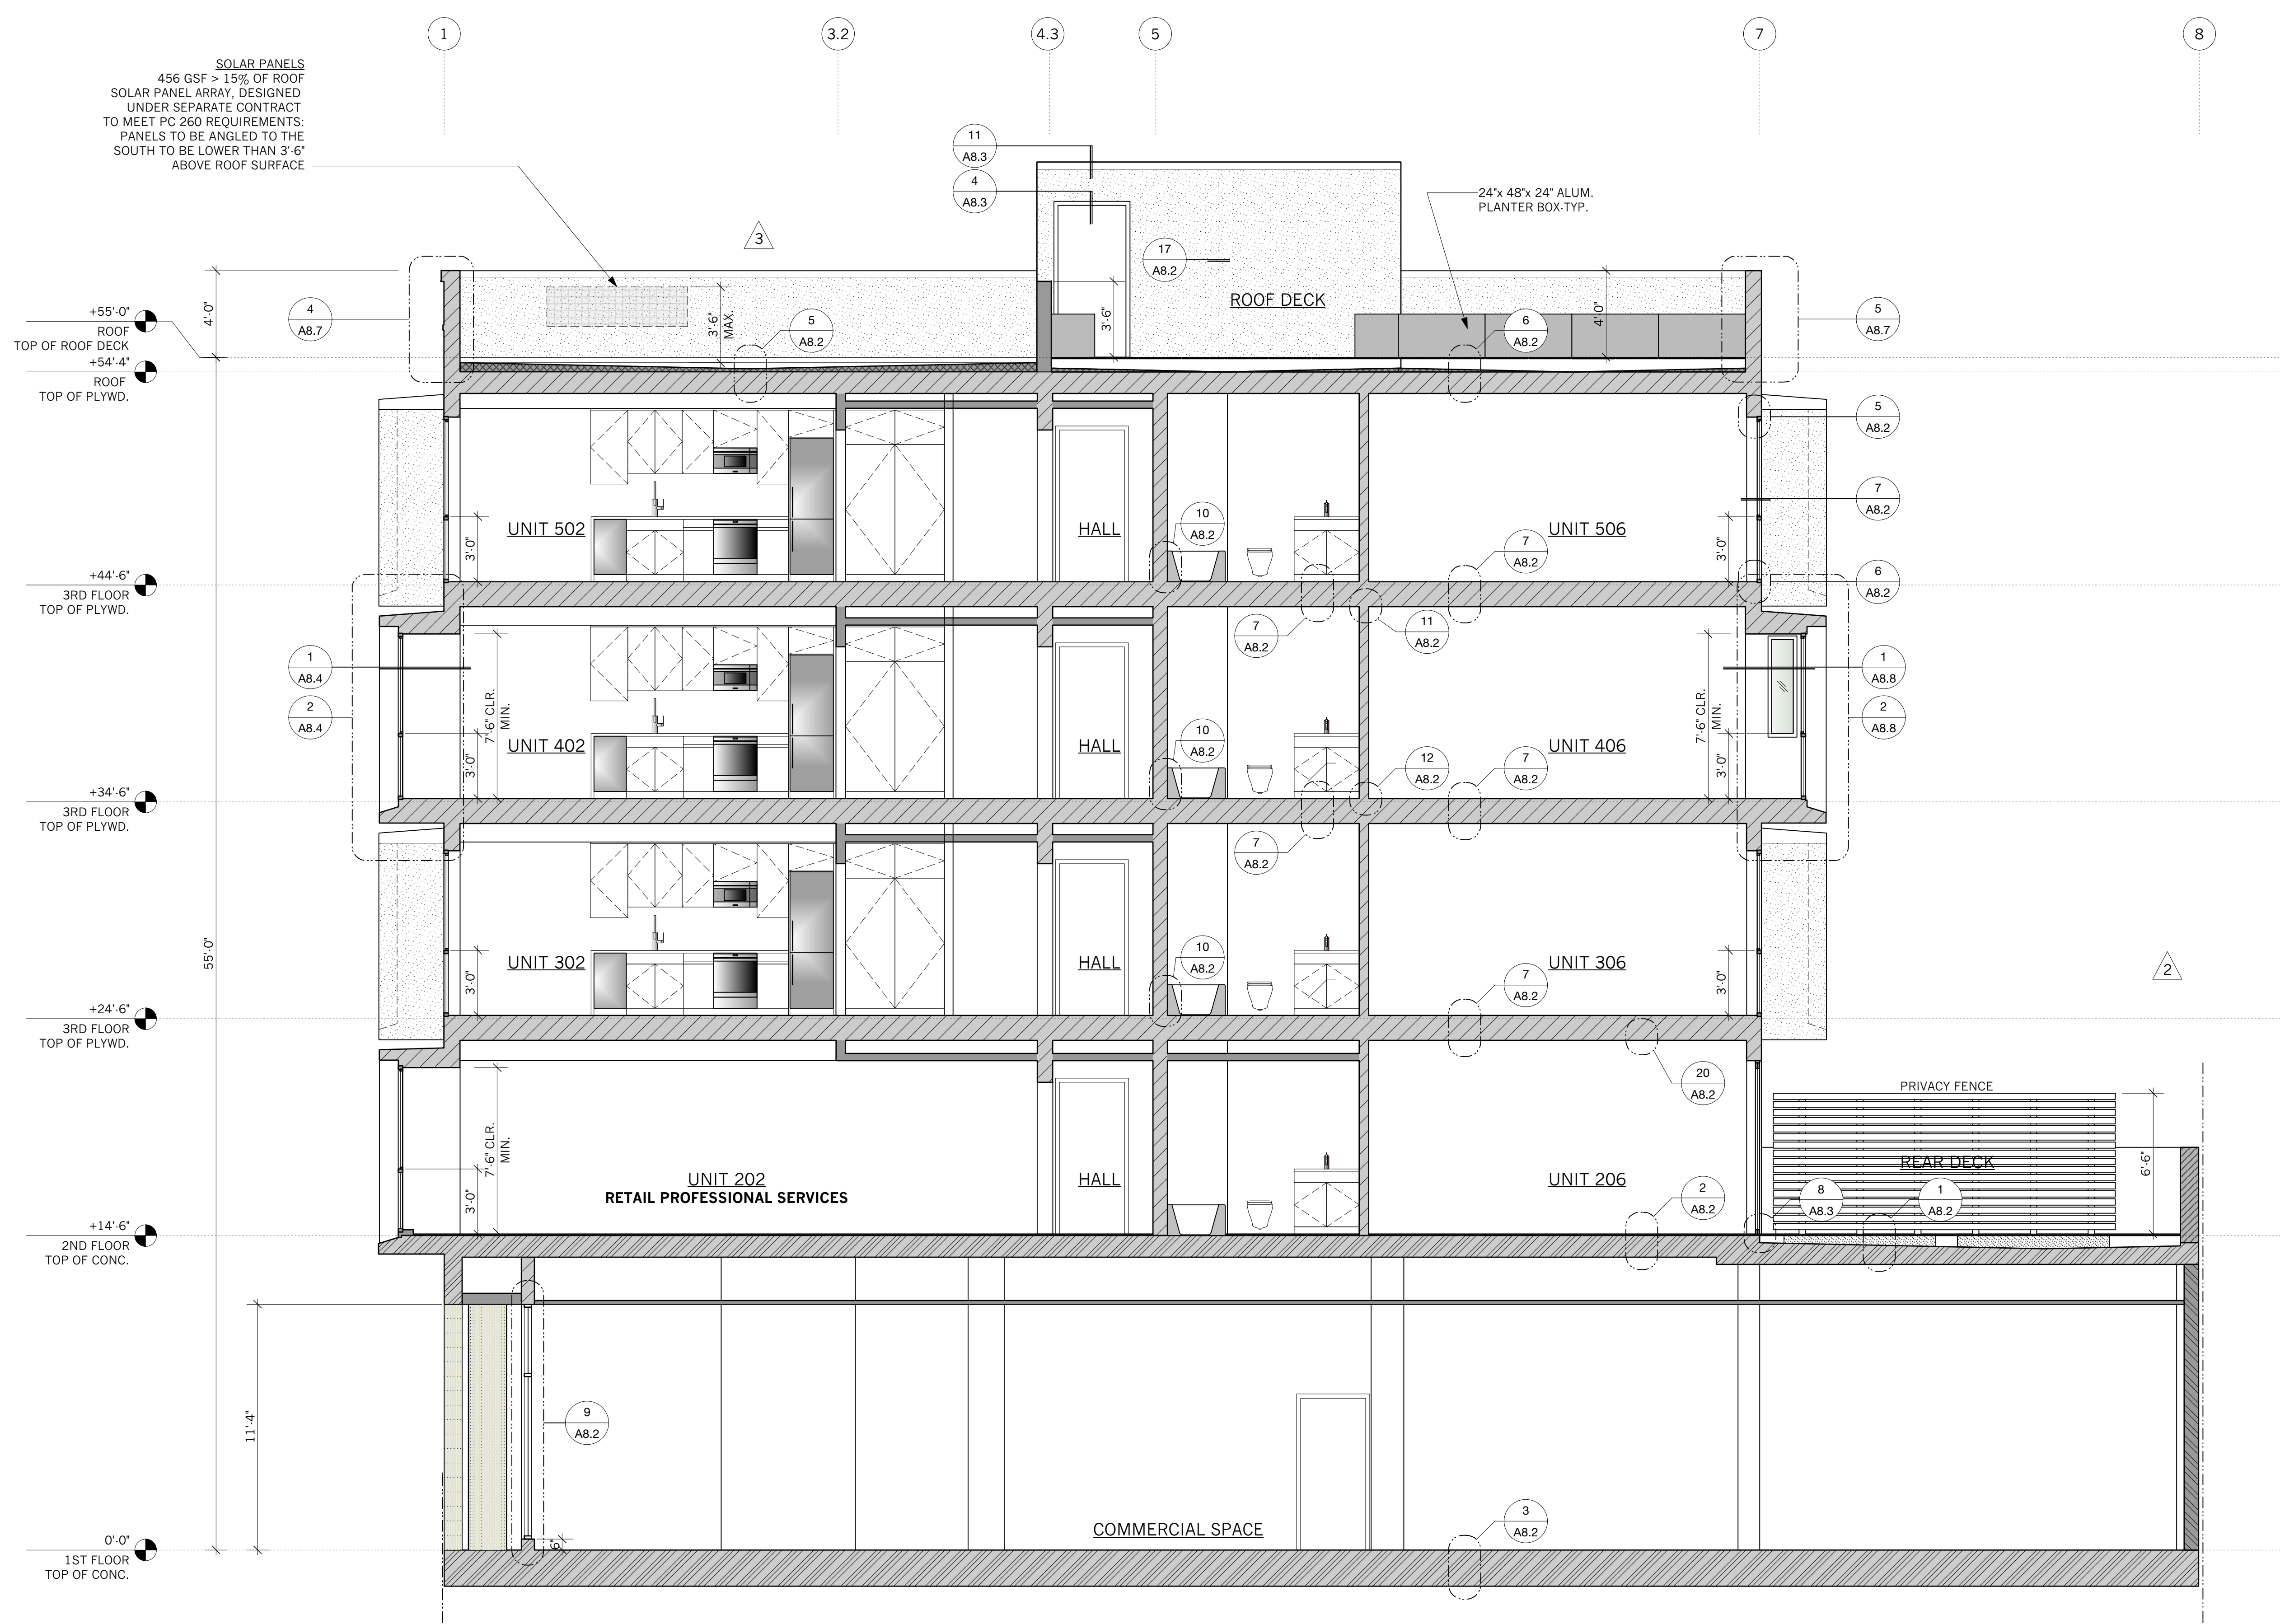


BUILDING SECTION A-A
Scale: 1/4" = 1'-0"

KEY



(N) UN-RATED ASSEMBLY
(N) 1-HR RATED ASSEMBLY
(N) 2-HR RATED ASSEMBLY
(N) 3-HR RATED ASSEMBLY

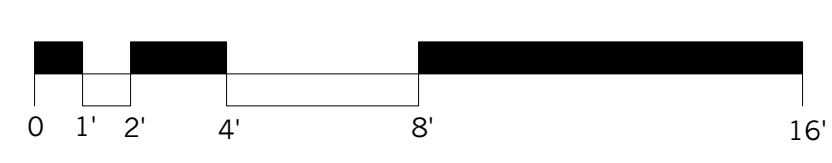

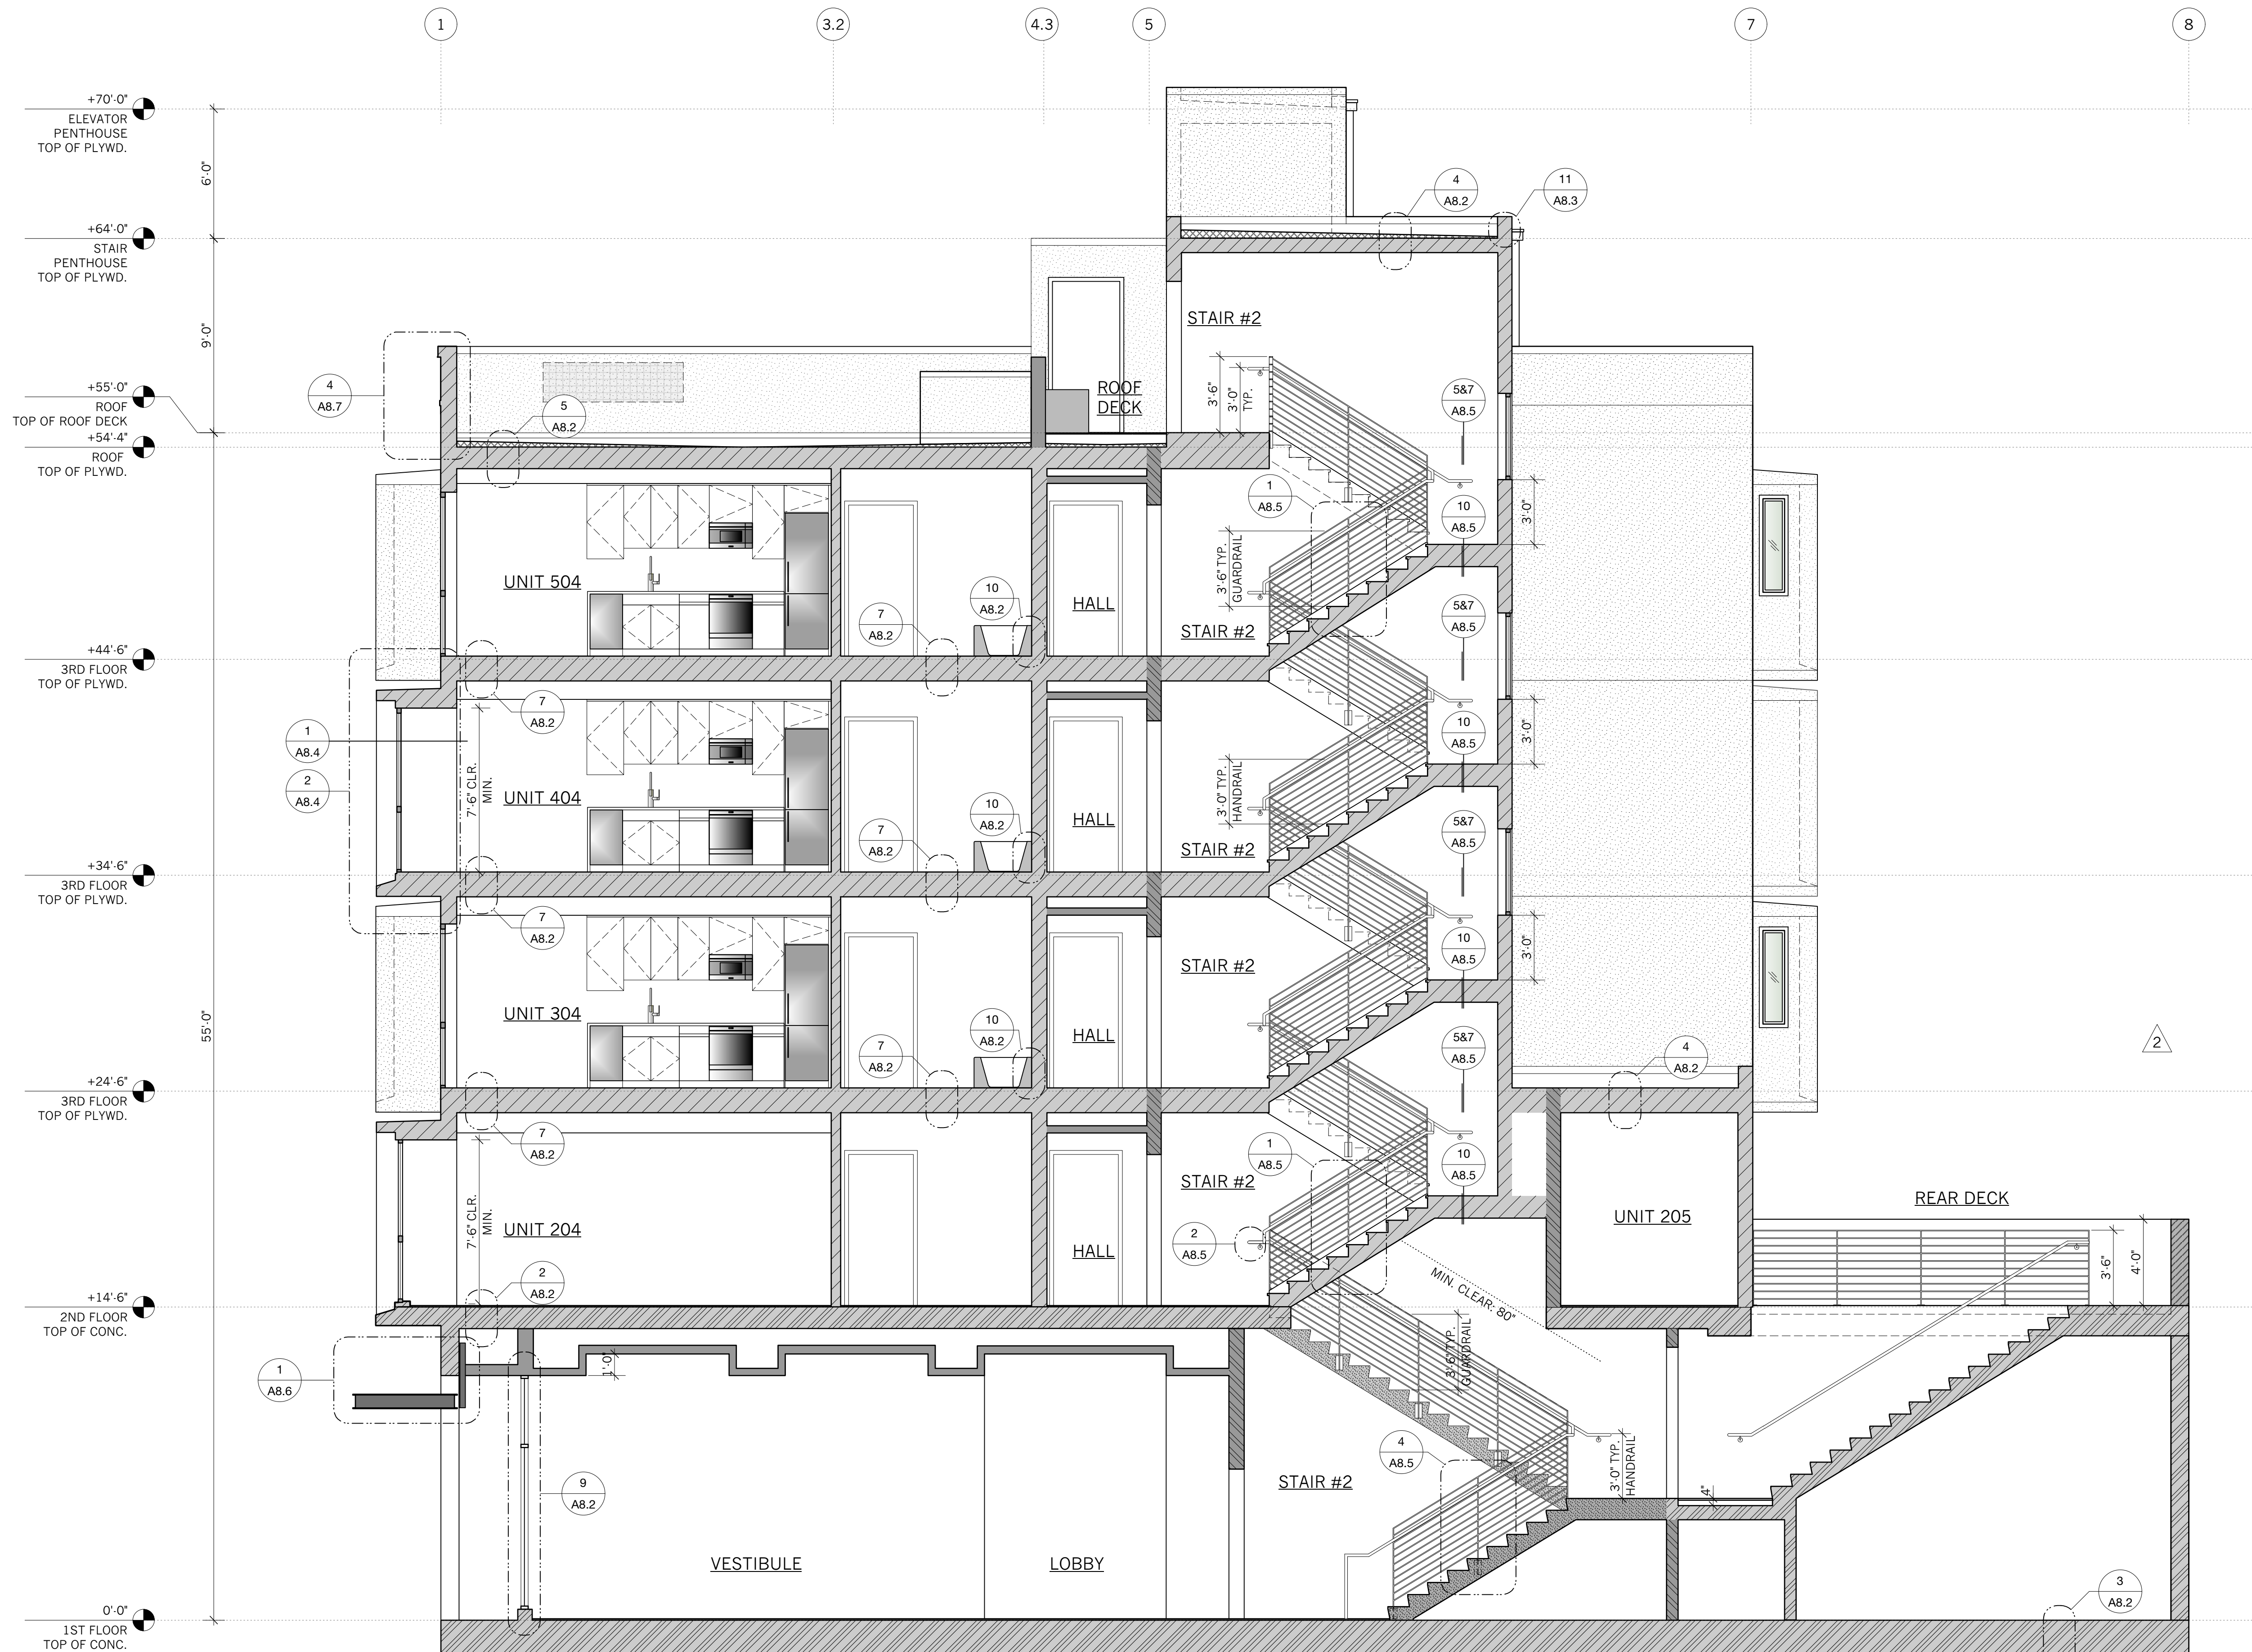


1 BUILDING SECTION B-B
Scale: 1/4" = 1'-0"

KEY	
	(N) UN-RATED ASSEMBLY
	(N) 1-HR RATED ASSEMBLY
	(N) 2-HR RATED ASSEMBLY
	(N) 3-HR RATED ASSEMBLY

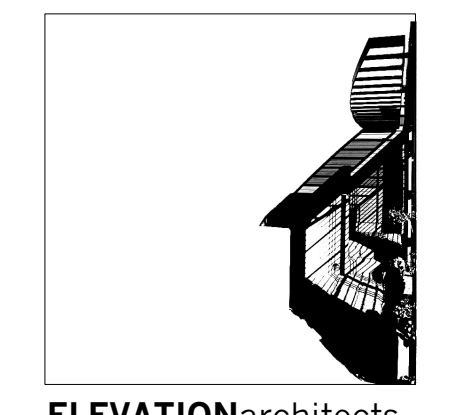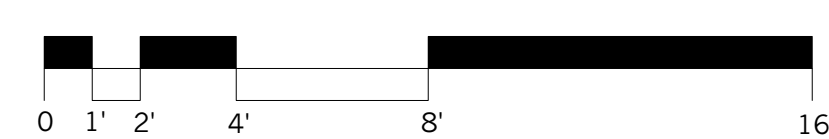

ELEVATIONarchitects
1159 Green Street, Suite 4
San Francisco, CA 94109
415.537.1125 v
www.elevationarchitects.com :w

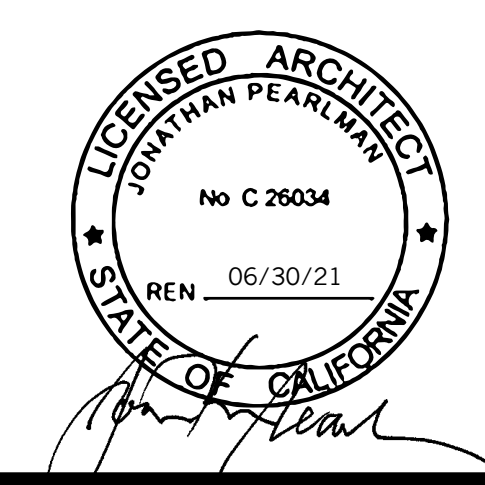

agency stamps:

Condominiums
42 Otis Street
San Francisco, CA 94103
Block / Lot : 3503 / 020

#	date	issue
2	4.15.20	Project Revision 2
3	4.27.20	Plan Check Response 2
4	8.17.20	Plan Check Response 3

sheet count 32/49

Section B-B

project: 16.15
drawn by: mka
checked by: jp
date: 01.21.19
scale:


A-3.6



1 BUILDING SECTION C-C
Scale: 1/4" = 1'-0"



ELEVATIONarchitects
1159 Green Street, Suite 4
San Francisco, CA 94109
415.537.1125 :v
www.elevationarchitects.com :w

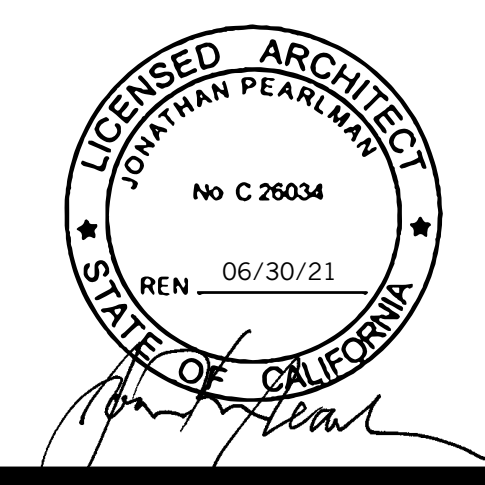

agency stamps:

Condominiums
42 Otis Street
San Francisco, CA 94103
Block / Lot : 3503 / 020

#	date	issue
2	4.15.20	Project Revision 2
3	4.27.20	Plan Check Response 2
4	8.17.20	Plan Check Response 3

sheet count 33/49

Section C-C


project: 16.15
drawn by: mka
checked by: jp
date: 01.21.19
scale:

A-3.7



ELEVATIONarchitects
1159 Green Street, Suite 4
San Francisco, CA 94109

415.537.1125 :v
www.elevationarchitects.com :w

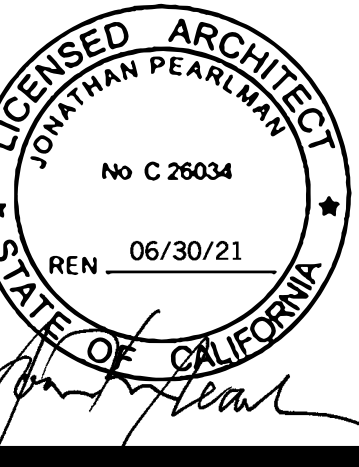

agency stamps:

Condominiums
42 Otis Street
San Francisco, CA 94103
Block / Lot : 3503 / 020


#	date	issue
2	4.15.20	Project Revision 2
3	4.27.20	Plan Check Response 2
4	8.17.20	Plan Check Response 3

sheet count 34/49

**1st Floor
Reflected Ceiling
& Electrical Plans**

project: 16.15
drawn by: mka
checked by: jp
date: 01.21.19
scale:

A-6.1

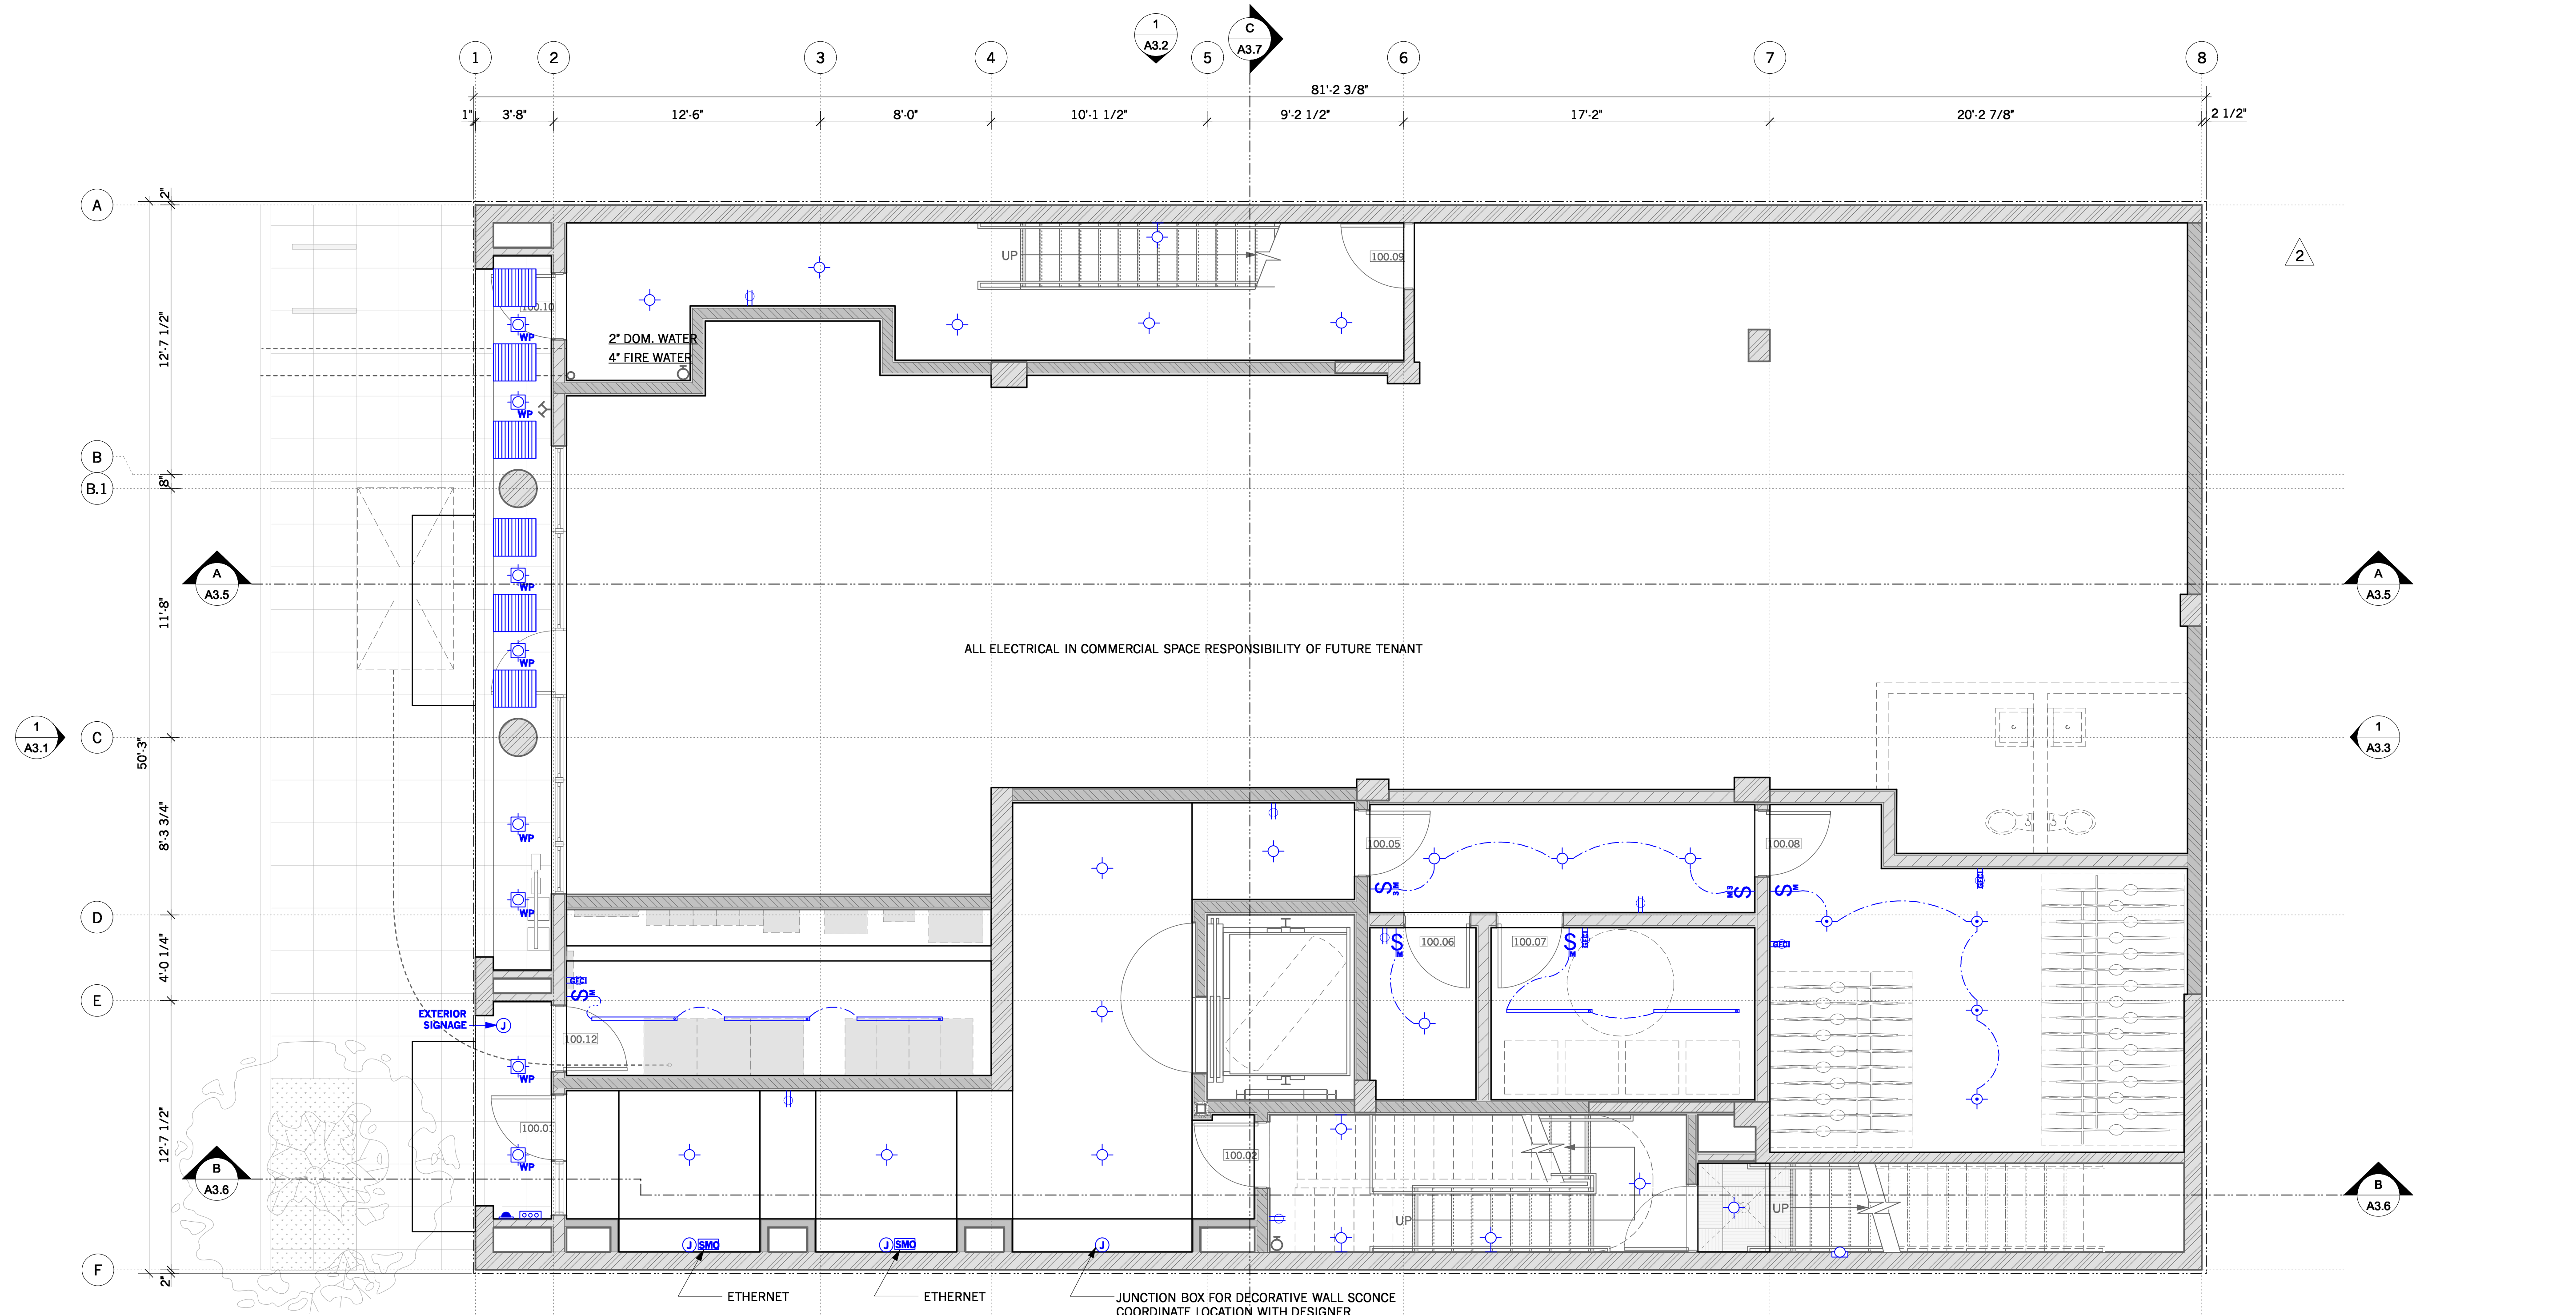


ALL ELECTRICAL IN COMMERCIAL SPACE RESPONSIBILITY OF FUTURE TENANT


NOTE:
ALL INSTALLED LIGHTING SHALL BE
HIGH EFFICACY.

ELECTRICAL & MECHANICAL SYMBOL LEGEND			
DUPLEX OUTLET		UNDER CABINET FIXTURE (FL OR LED)	
SWITCHED OUTLET "HALF-HOT"		EXHAUST FAN	
220 OUTLET		PRODUCT OF COMBUSTION DETECTOR*	
GROUND FAULT CIRCUIT INTERRUPTER		THERMOSTAT	
TWO WAY SWITCH		JUNCTION BOX	
THREE WAY SWITCH		"PLUCK" CABINET LIGHT	
FOUR WAY SWITCH		RECESSED LED STEP/AISLE FIXTURE	
DIMMER SWITCH		INTERCOM	
VACANCY SENSOR SWITCH		DOORBELL	
MOTION SENSOR		WEATHERPROOF FIXTURE	
PHOTOCELL MOTION SENSOR		DAMP LOCATION	
DOOR JAMB SWITCH		WATER LINE	
STRUCTURED MEDIA OUTLET		GAS SUPPLY	
FLUORESCENT LAMP		HOSE BIBB	
LED LAMP		TANKLESS GAS FIRED BOILER	
FLUORESCENT FIXTURE		CEILING FAN	
LED WALL SCENCE		CEILING MTD SPEAKER	
LED SCENCE W/MOTION SENSOR		ELECTRICAL SUB-PANEL	
SPECIALTY RECESSED LED FIXTURE		TAMPER RESISTANT	
RECESSED LED FIXTURE		EMERGENCY LIGHTING	
ADJUSTABLE RECESSED LED FIXTURE		EXIT SIGN	
PENDANT LED FIXTURE		DIRECTIONAL EXIT SIGN	
CEILING MTD. LED FIXTURE		STROBE ALARM	
LED STRIP FIXTURE		OVERHEAD LED "STRING" LIGHT	
MONOPOINT PENDANT LIGHT		LED LANDSCAPE LIGHT	

KEY
 SOFFIT

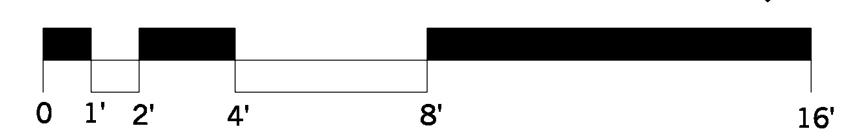

*SMOKE + CO₂

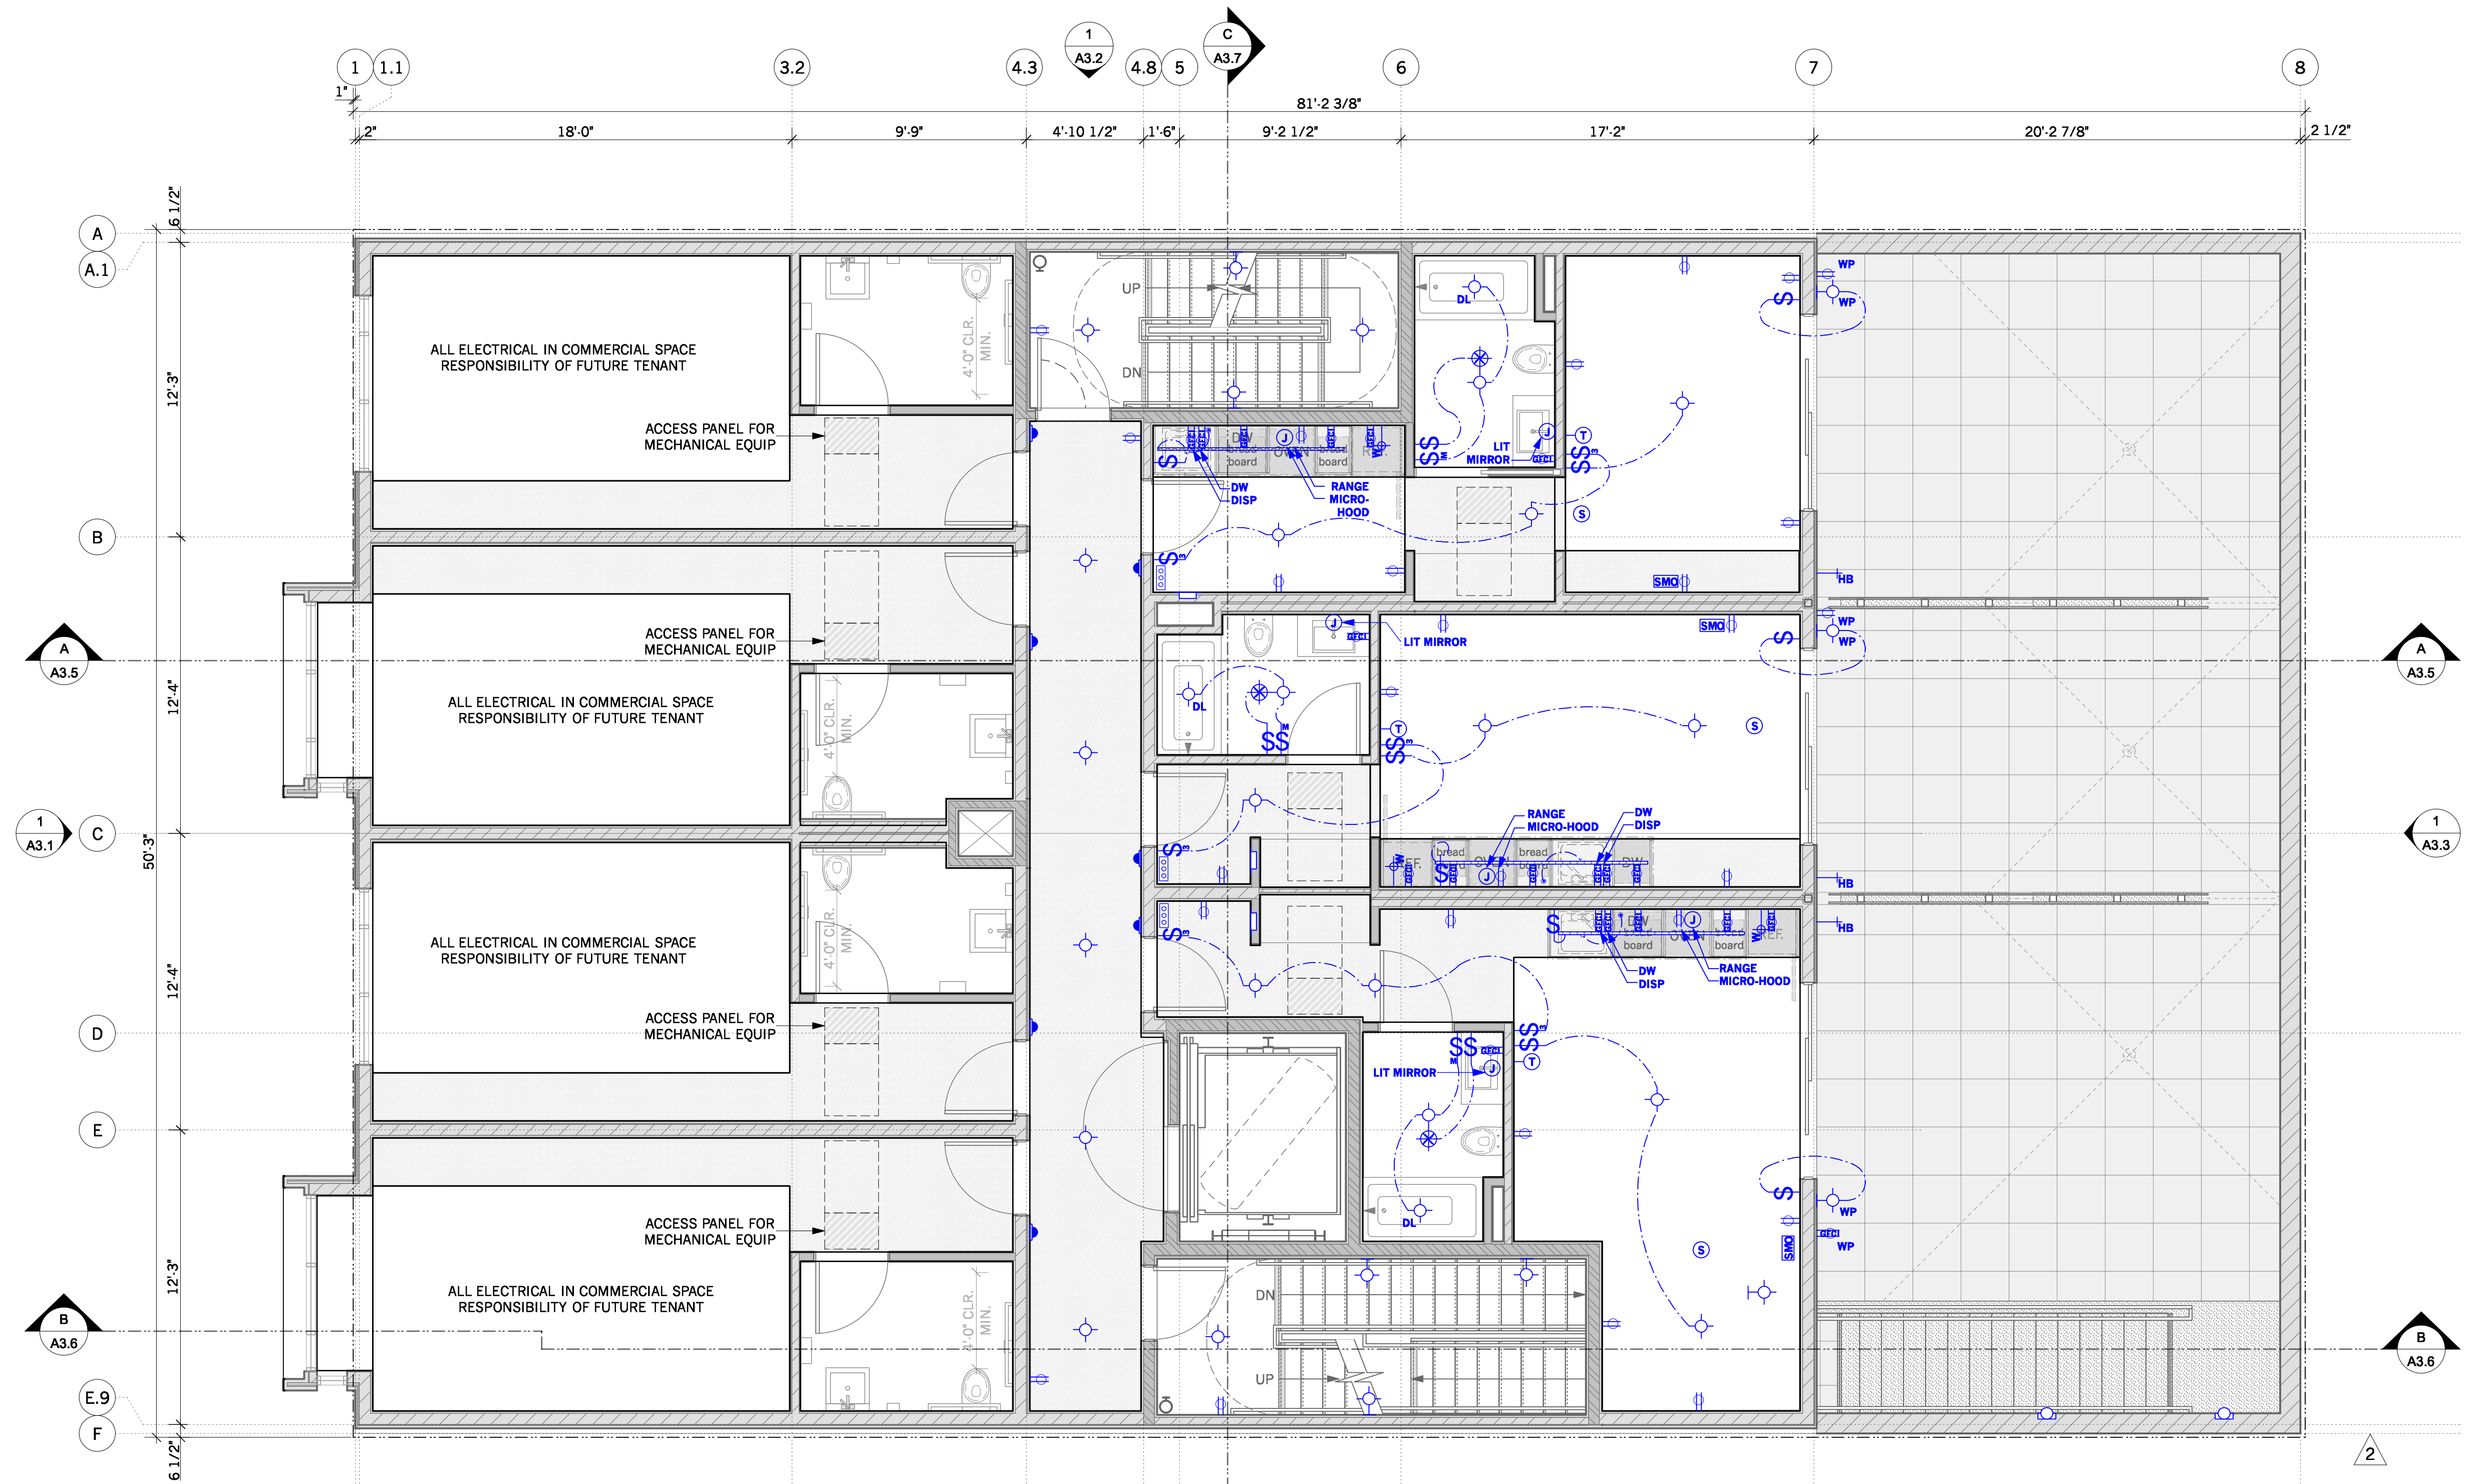

1
A3.4



C
A3.7

4 NOTE: ALL INSTALLED LIGHTING SHALL BE HIGH EFFICACY.


ELECTRICAL & MECHANICAL SYMBOL LEGEND			
DUPLX OUTLET		UNDER CABINET FIXTURE (FL OR LED)	
SWITCHED OUTLET "HALF-HOT"		EXHAUST FAN	
220 OUTLET		PRODUCT OF COMBUSTION DETECTOR*	
GROUND FAULT CIRCUIT INTERRUPTER		THERMOSTAT	
TWO WAY SWITCH		JUNCTION BOX	
THREE WAY SWITCH		"PUCK" CABINET LIGHT	
FOUR WAY SWITCH		RECESSED LED STEP/AISLE FIXTURE	
DIMMER SWITCH		INTERCOM	
VACANCY SENSOR SWITCH		DOORBELL	
MOTION SENSOR		WEATHERPROOF FIXTURE	
PHOTOCELL MOTION SENSOR		DAMP LOCATION	
DOOR JAMB SWITCH		WATER LINE	
STRUCTURED MEDIA OUTLET		GAS SUPPLY	
FLUORESCENT LAMP		HOSE BIBB	
LED LAMP		TANKLESS GAS FIRED BOILER	
FLUORESCENT FIXTURE		CEILING FAN	
LED WALL SCOSCE		CEILING MTD SPEAKER	
LED SCOSCE W/MOTION SENSOR		ELECTRICAL SUB-PANEL	
SPECIALTY RECESSED LED FIXTURE		TAMPER RESISTANT	
RECESSED LED FIXTURE		EMERGENCY LIGHTING	
ADJUSTABLE RECESSED LED FIXTURE		EXIT SIGN	
PENDANT LED FIXTURE		DIRECTIONAL EXIT SIGN	
CEILING MTD. LED FIXTURE		STROBE ALARM	
LED STRIP FIXTURE		OVERHEAD LED "STRING" LIGHT	
MONOPOINT PENDANT LIGHT		LED LANDSCAPE LIGHT	

KEY

SOFFIT

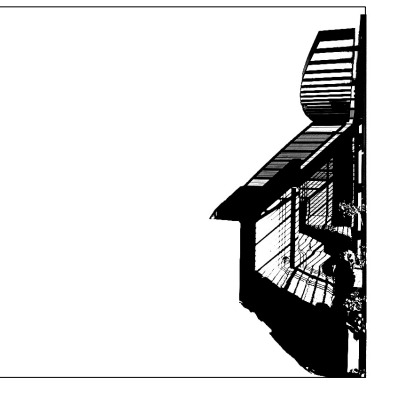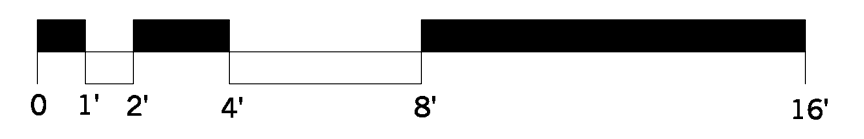

ELEVATIONarchitects
 1159 Green Street, Suite 4
 San Francisco, CA 94109
 415.537.1125 :v
 www.elevationarchitects.com :w

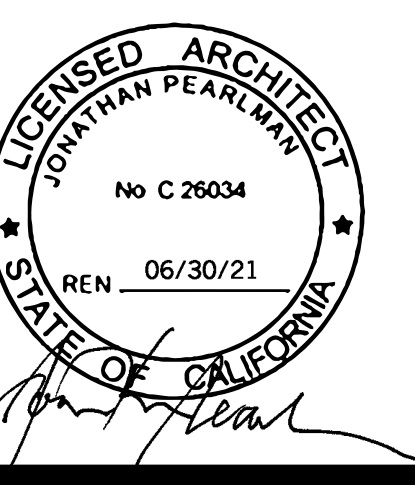

agency stamps:

Condominiums
 42 Otis Street
 San Francisco, CA 94103
 Block / Lot : 3503 / 020


#	date	issue
2	4.15.20	Project Revision 2
3	4.27.20	Plan Check Response 2
4	8.17.20	Plan Check Response 3

sheet count 35/49

**2nd Floor
 Reflected Ceiling
 & Electrical Plans**

project: 16.15
 drawn by: mka
 checked by: jp
 date: 01.21.19
 scale:

A-6.2


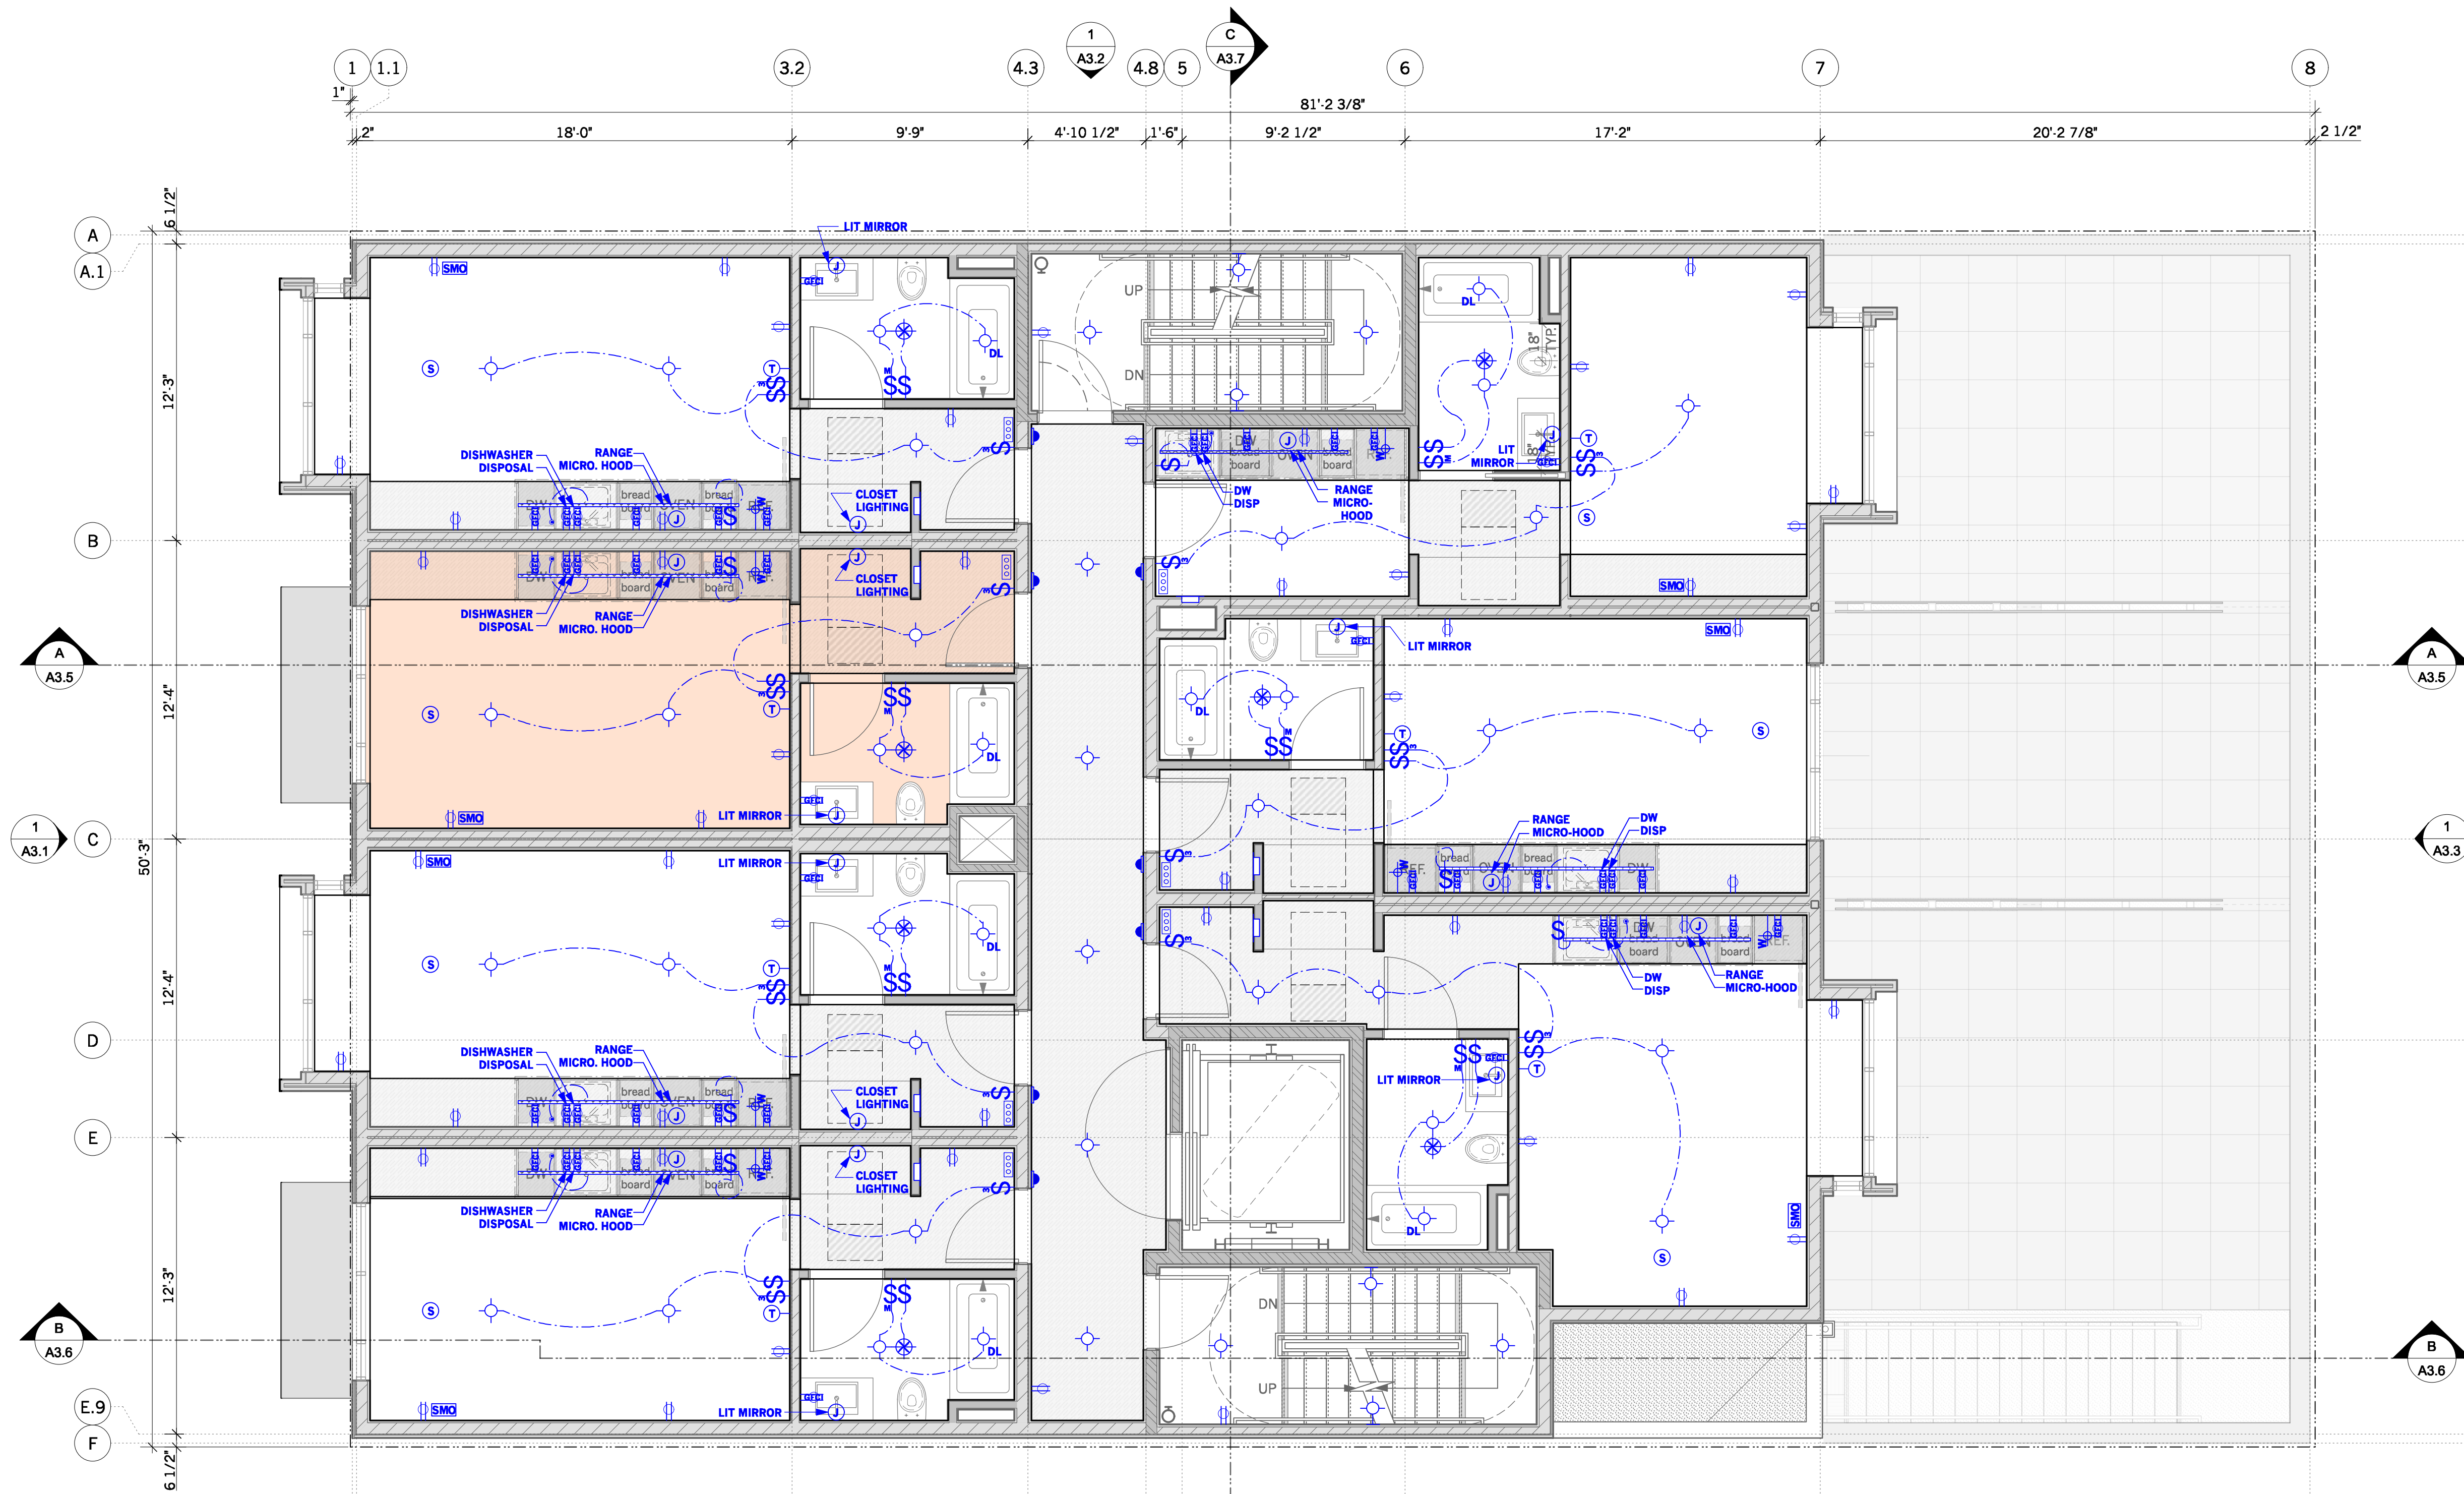


1 A3.4
C A3.7

4 NOTE: ALL INSTALLED LIGHTING SHALL BE HIGH EFFICACY.

ELECTRICAL & MECHANICAL SYMBOL LEGEND			
DUPLX OUTLET		UNDER CABINET FIXTURE (FL OR LED)	
SWITCHED OUTLET "HALF-HOT"		EXHAUST FAN	
220 OUTLET		PRODUCT OF COMBUSTION DETECTOR*	
GROUND FAULT CIRCUIT INTERRUPTER		THERMOSTAT	
TWO WAY SWITCH		JUNCTION BOX	
THREE WAY SWITCH		"PUCK" CABINET LIGHT	
FOUR WAY SWITCH		RECESSED LED STEP/AISLE FIXTURE	
DIMMER SWITCH		INTERCOM	
4 VACANCY SENSOR SWITCH		DOORBELL	
MOTION SENSOR		WEATHERPROOF FIXTURE	
PHOTOCELL MOTION SENSOR		DAMP LOCATION	
DOOR JAMB SWITCH		WATER LINE	
STRUCTURED MEDIA OUTLET		GAS SUPPLY	
FLUORESCENT LAMP		HOSE BIBB	
LED LAMP		TANKLESS GAS FIRED BOILER	
FLUORESCENT FIXTURE		CEILING FAN	
LED WALL SCONCE		CEILING MTD SPEAKER	
LED SCONCE W/MOTION SENSOR		ELECTRICAL SUB-PANEL	
SPECIALTY RECESSED LED FIXTURE		TAMPER RESISTANT	
RECESSED LED FIXTURE		EMERGENCY LIGHTING	
ADJUSTABLE RECESSED LED FIXTURE		EXIT SIGN	
PENDANT LED FIXTURE		DIRECTIONAL EXIT SIGN	
CEILING MTD. LED FIXTURE		STROBE ALARM	
LED STRIP FIXTURE		OVERHEAD LED "STRING" LIGHT	
MONOPOINT PENDANT LIGHT		LED LANDSCAPE LIGHT	

KEY
SOFFIT

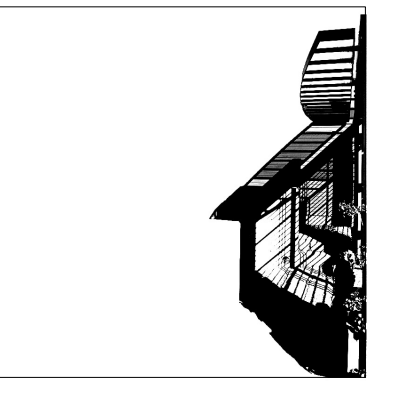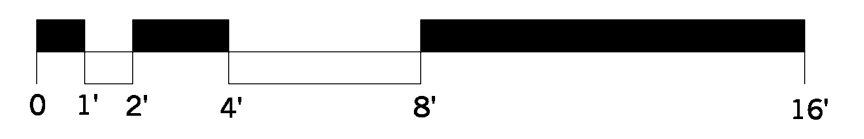

ELEVATIONarchitects
1159 Green Street, Suite 4
San Francisco, CA 94109
415.537.1125 :v
www.elevationarchitects.com :w



agency stamps:

Condominiums
42 Otis Street
San Francisco, CA 94103
Block / Lot : 3503 / 020


#	date	issue
2	4.15.20	Project Revision 2
3	4.27.20	Plan Check Response 2
4	8.17.20	Plan Check Response 3

sheet count 36/49


**3rd Floor
Reflected Ceiling
& Electrical Plans**

project: 16.15
drawn by: mka
checked by: jp
date: 01.21.19
scale:




A-6.3

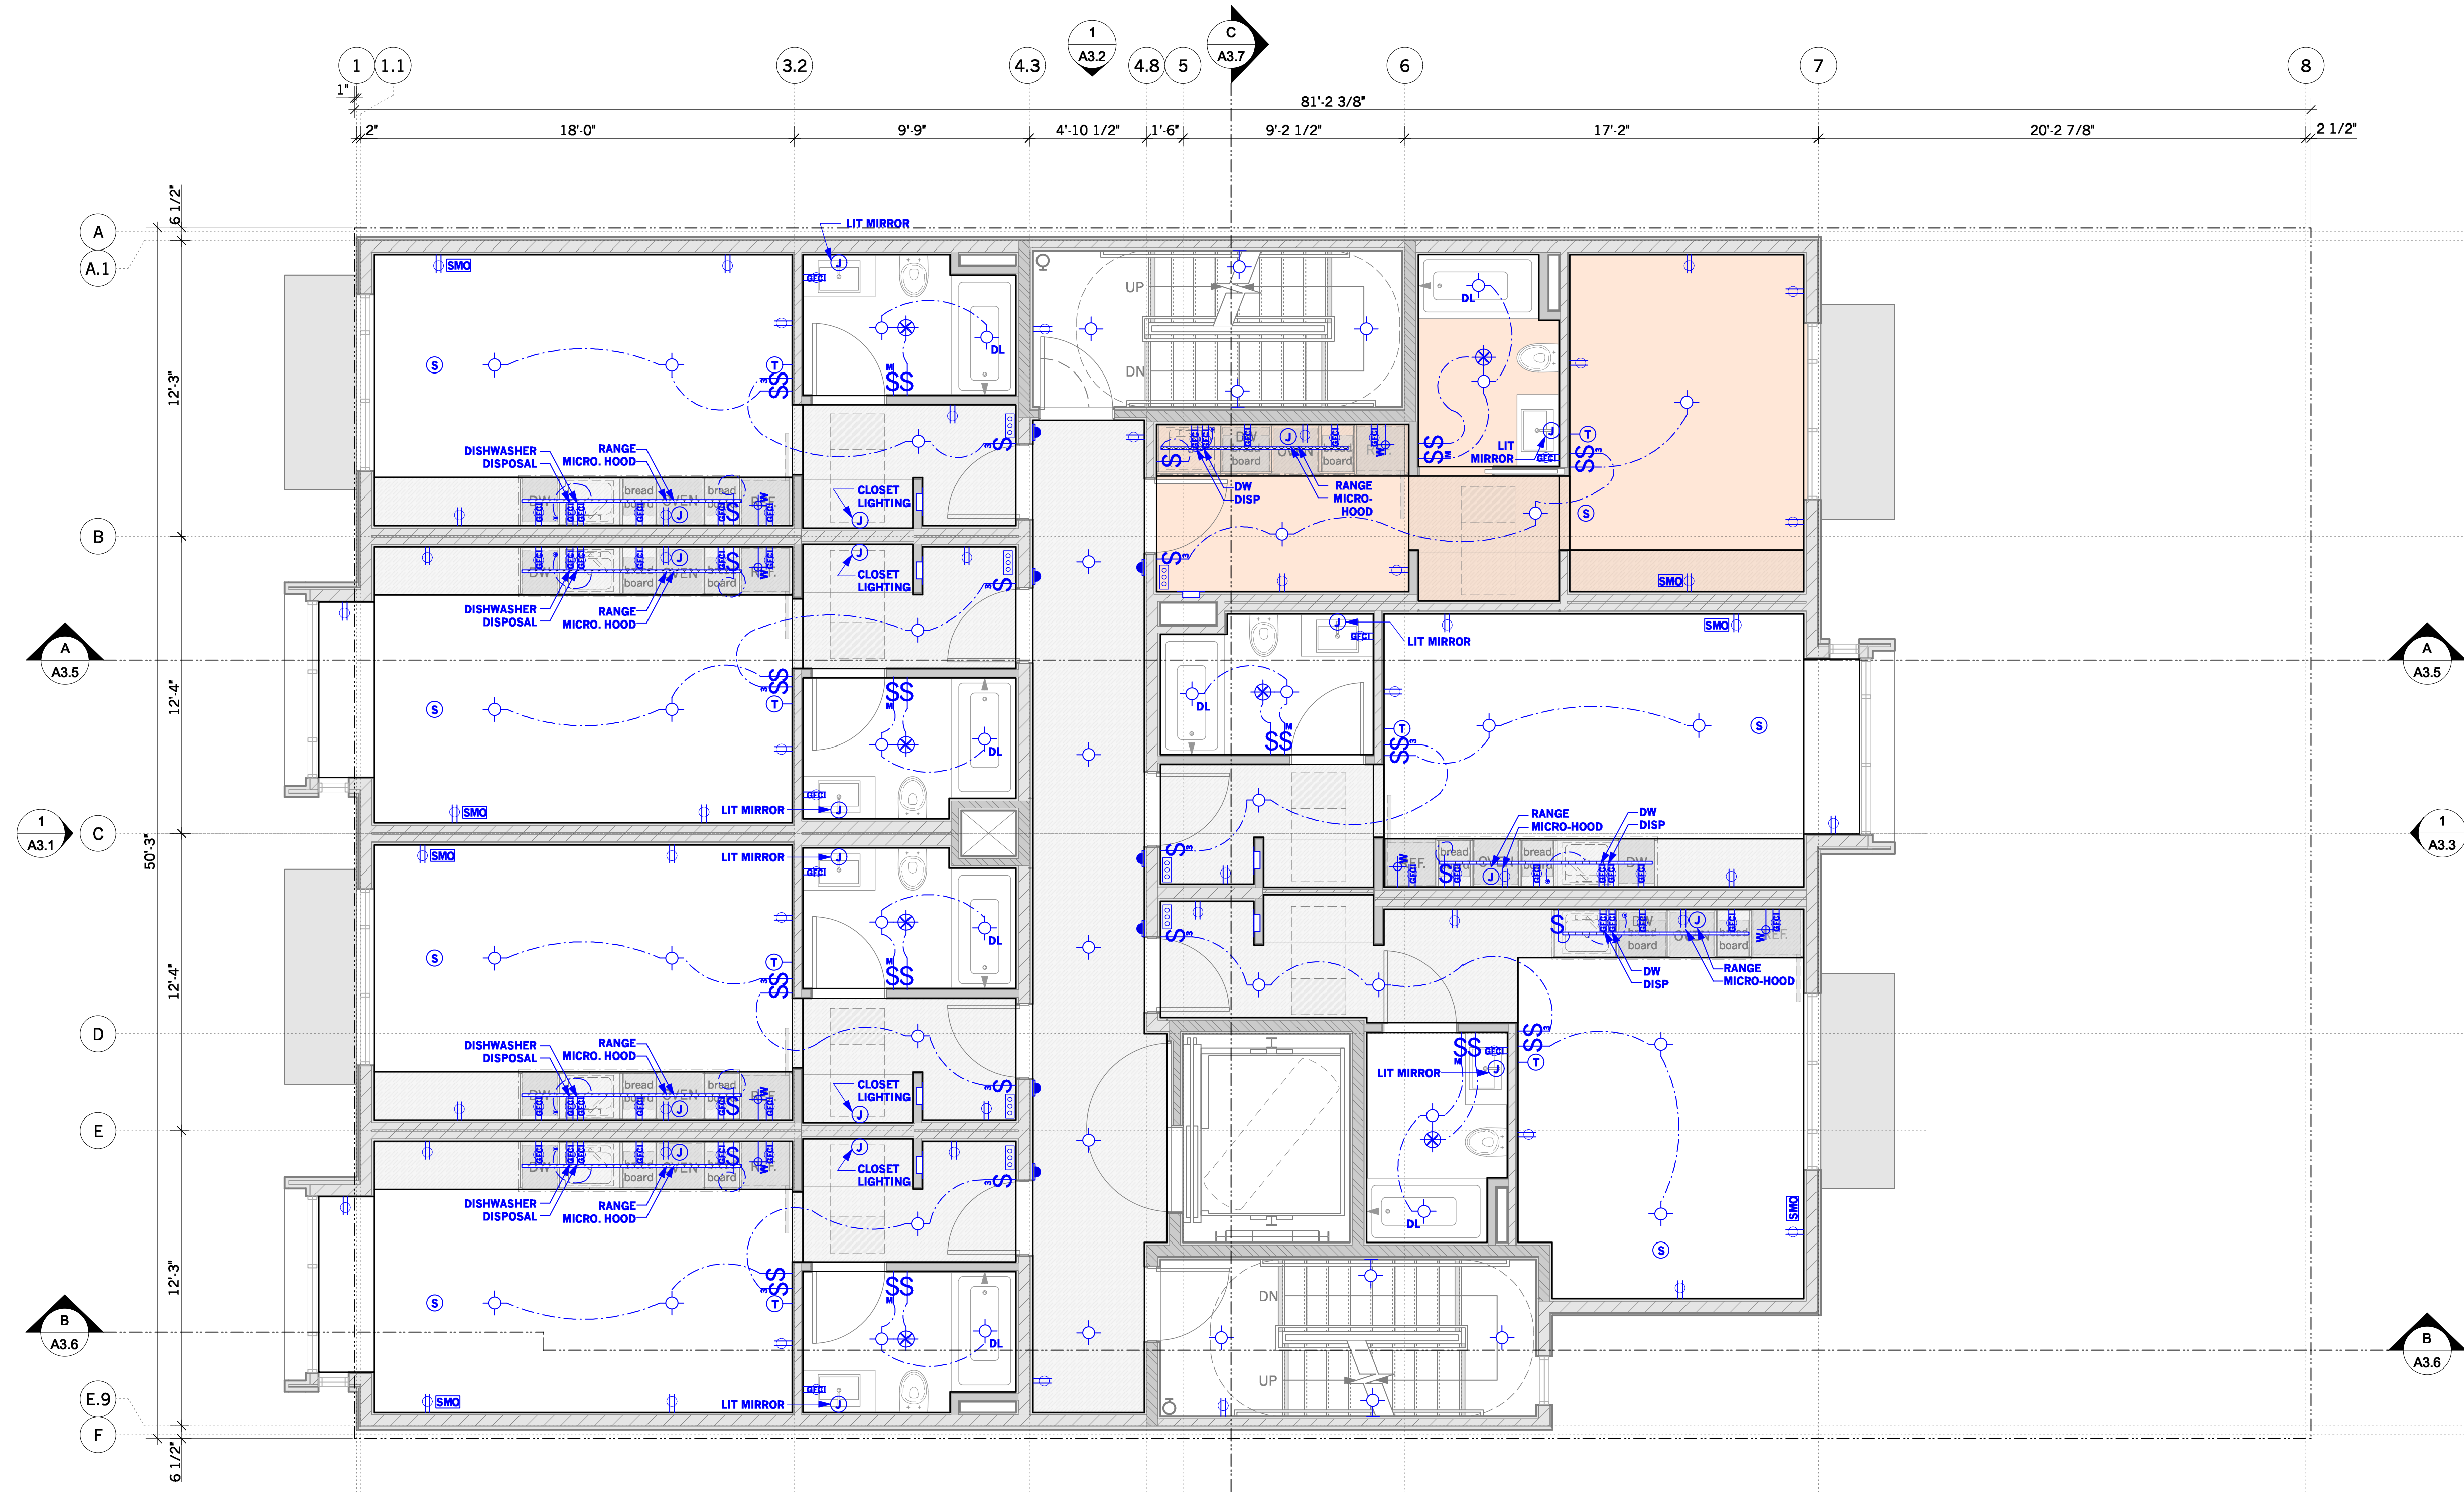

ELECTRICAL & MECHANICAL SYMBOL LEGEND			
DUPLEX OUTLET		UNDER CABINET FIXTURE (FL OR LED)	
SWITCHED OUTLET "HALF-HOT"		EXHAUST FAN	
220 OUTLET		PRODUCT OF COMBUSTION DETECTOR*	
GROUND FAULT CIRCUIT INTERRUPTER		THERMOSTAT	
TWO WAY SWITCH		JUNCTION BOX	
THREE WAY SWITCH		"PUCK" CABINET LIGHT	
FOUR WAY SWITCH		RECESSED LED STEP/AISLE FIXTURE	
DIMMER SWITCH		INTERCOM	
4 VACANCY SENSOR SWITCH		DOORBELL	
MOTION SENSOR		WEATHERPROOF FIXTURE	
PHOTOCELL MOTION SENSOR		DAMP LOCATION	
DOOR JAMB SWITCH		WATER LINE	
STRUCTURED MEDIA OUTLET		GAS SUPPLY	
FLUORESCENT LAMP		HOSE BIBB	
LED LAMP		TANKLESS GAS FIRED BOILER	
FLUORESCENT FIXTURE		CEILING FAN	
LED WALL SCONCE		CEILING MTD SPEAKER	
LED SCONCE W/MOTION SENSOR		ELECTRICAL SUB-PANEL	
SPECIALTY RECESSED LED FIXTURE		TAMPER RESISTANT	
RECESSED LED FIXTURE		EMERGENCY LIGHTING	
ADJUSTABLE RECESSED LED FIXTURE		EXIT SIGN	
PENDANT LED FIXTURE		DIRECTIONAL EXIT SIGN	
CEILING MTD. LED FIXTURE		STROBE ALARM	
LED STRIP FIXTURE		OVERHEAD LED "STRING" LIGHT	
MONOPOINT PENDANT LIGHT		LED LANDSCAPE LIGHT	

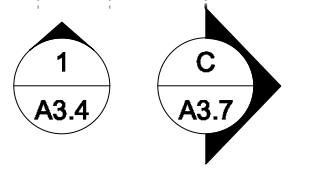

NOTE:
ALL INSTALLED LIGHTING SHALL BE
HIGH EFFICACY.

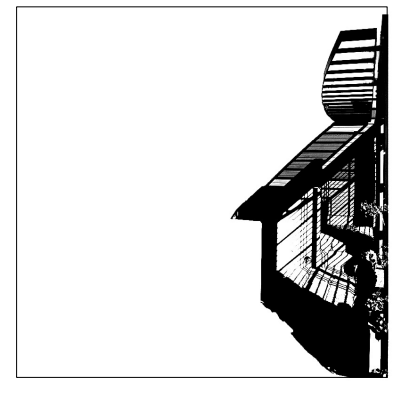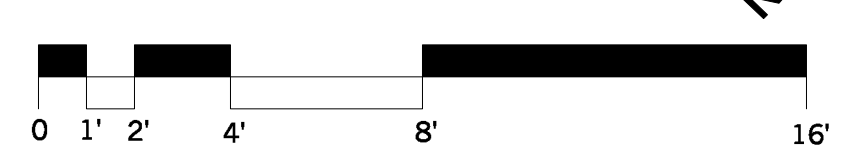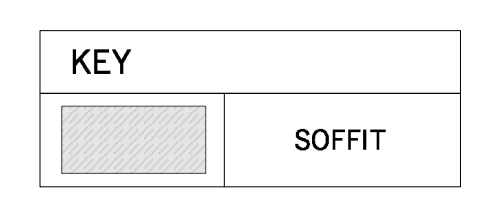

ELEVATIONarchitects
1159 Green Street, Suite 4
San Francisco, CA 94109
415.537.1125 :v
www.elevationarchitects.com :w



agency stamps:

Condominiums
42 Otis Street
San Francisco, CA 94103
Block / Lot : 3503 / 020



#	date	issue
2	4.15.20	Project Revision 2
3	4.27.20	Plan Check Response 2
4	8.17.20	Plan Check Response 3

sheet count 37/49

**4th Floor
Reflected Ceiling
& Electrical Plans**




project: 16.15
drawn by: mka
checked by: jp
date: 01.21.19
scale:

A-6.4

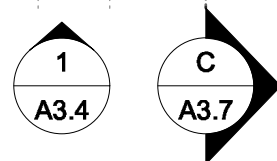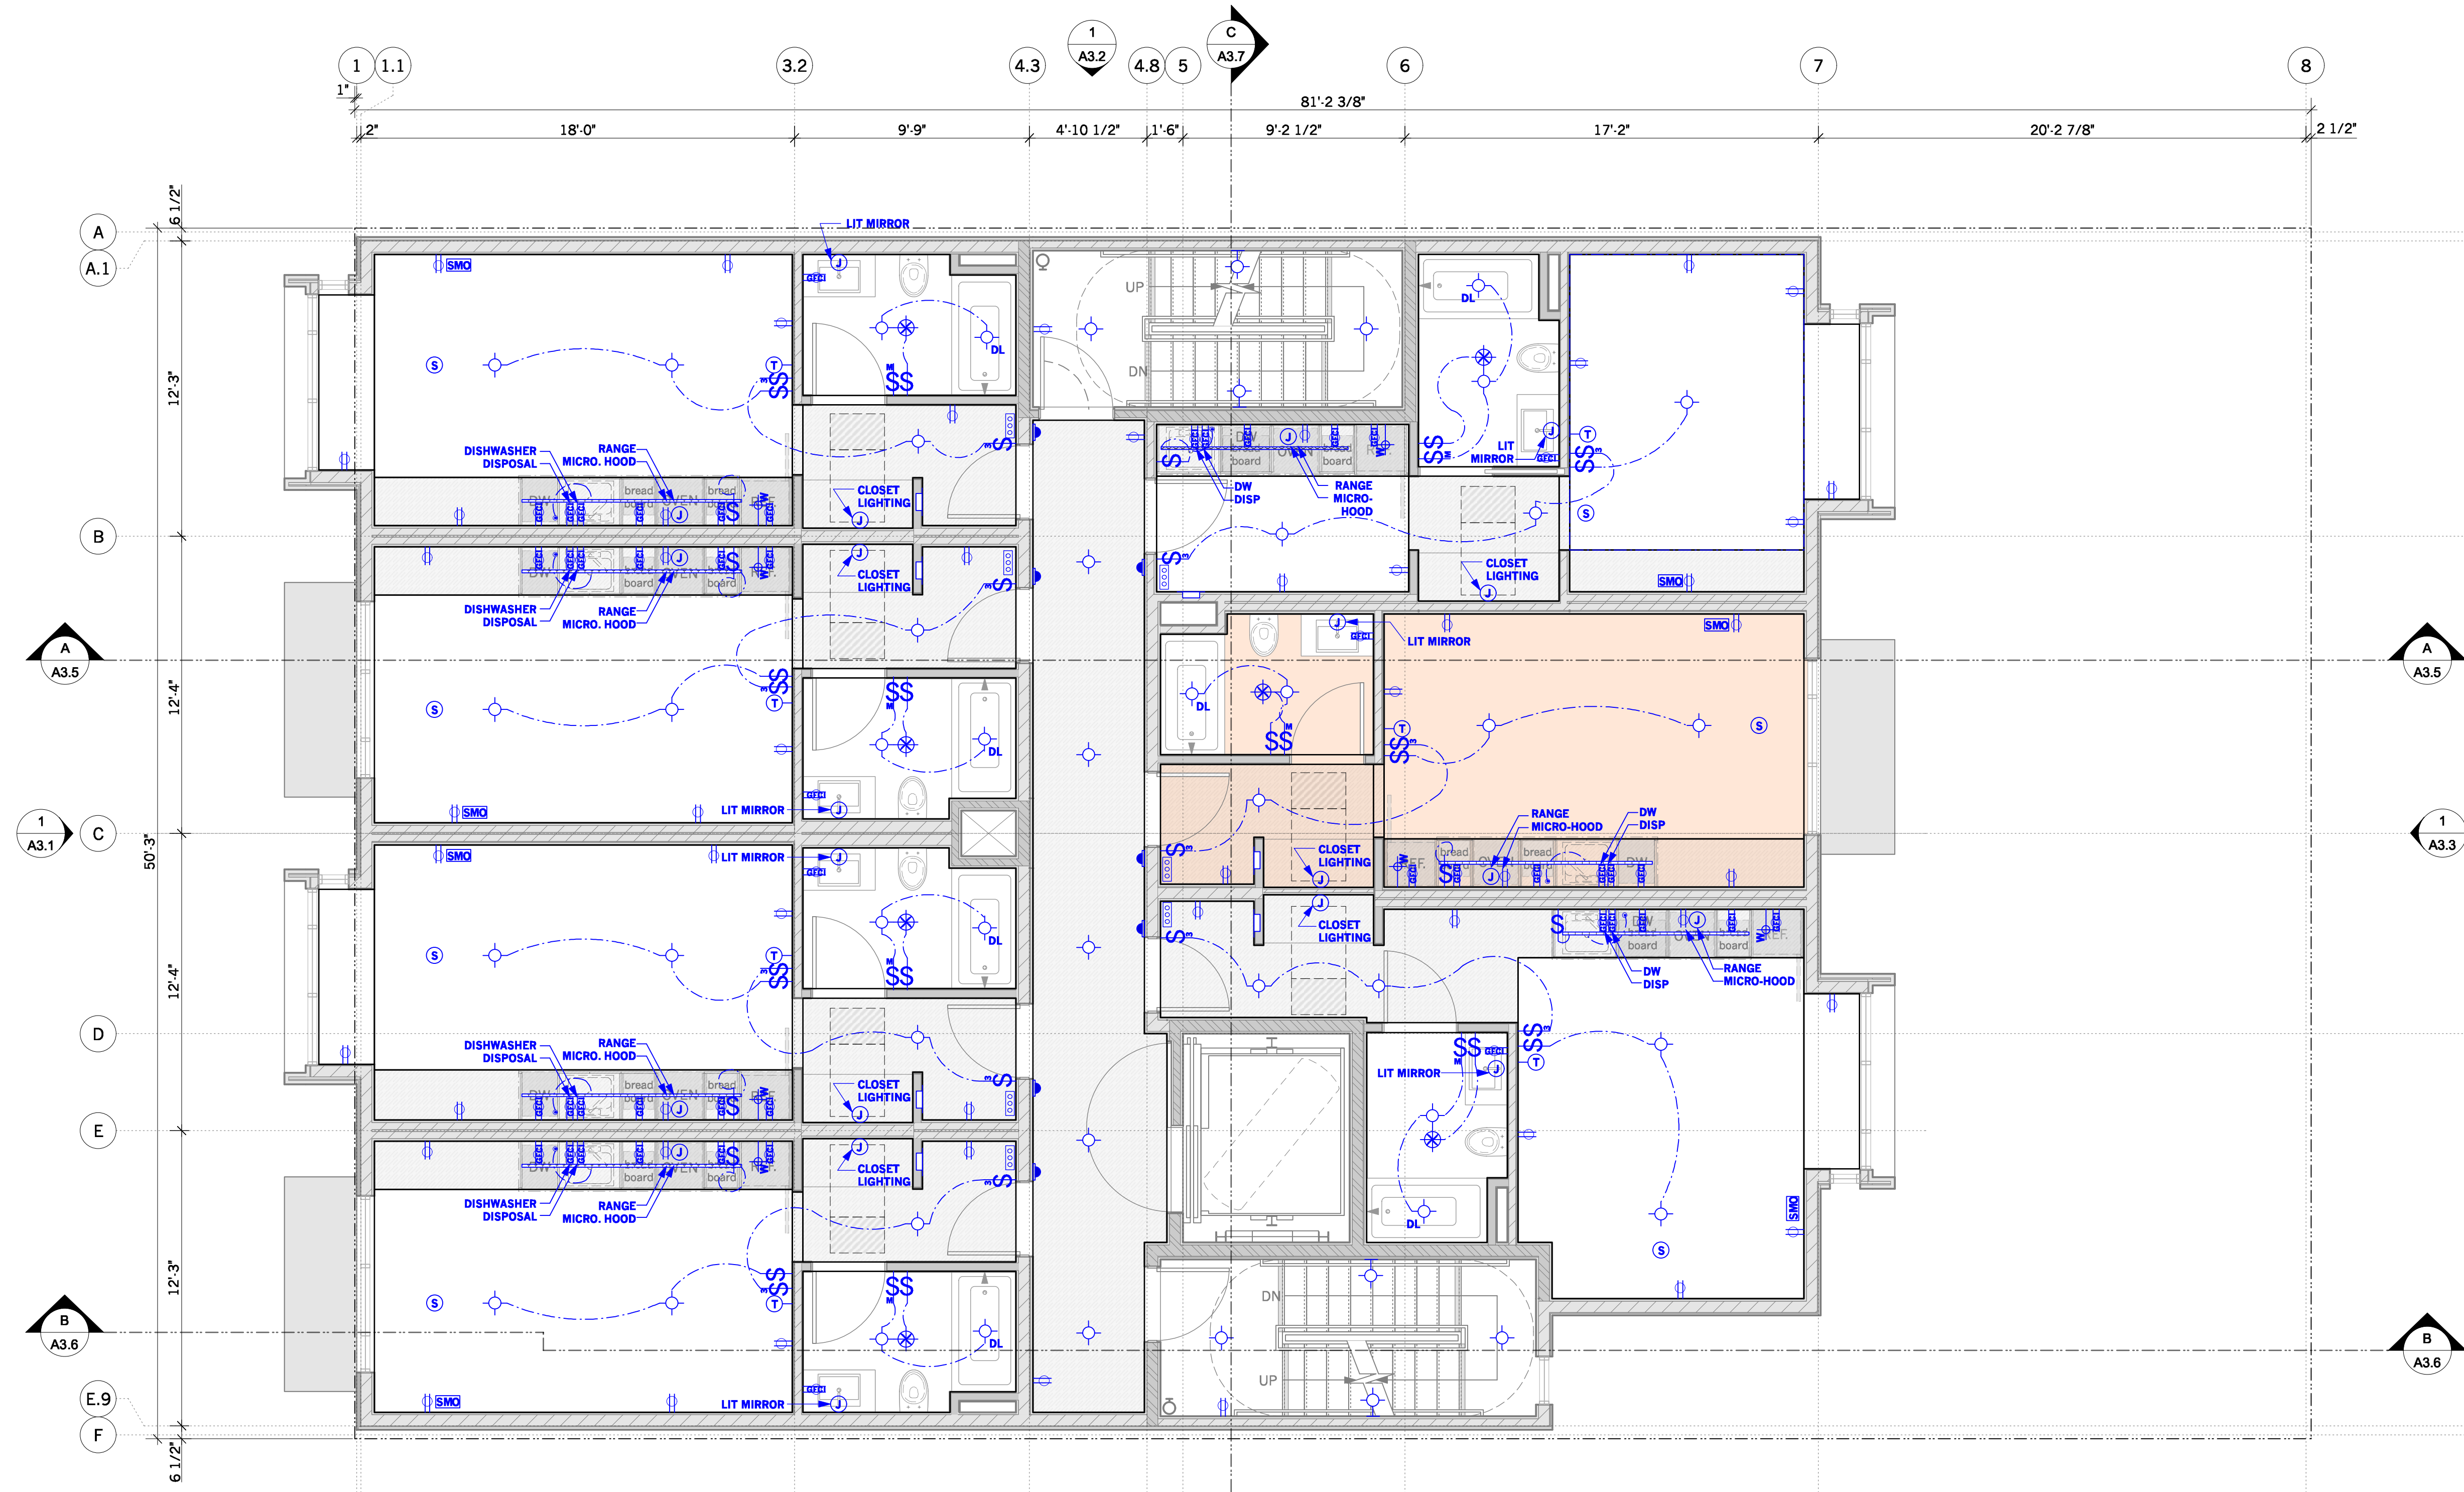

4 NOTE:
ALL INSTALLED LIGHTING SHALL BE
HIGH EFFICACY.

ELECTRICAL & MECHANICAL SYMBOL LEGEND			
DUPLICATE OUTLET		UNDER CABINET FIXTURE (FL OR LED)	
SWITCHED OUTLET "HALF-HOT"		EXHAUST FAN	
220 OUTLET		PRODUCT OF COMBUSTION DETECTOR*	
GROUND FAULT CIRCUIT INTERRUPTER		THERMOSTAT	
TWO WAY SWITCH		JUNCTION BOX	
THREE WAY SWITCH		"PUCK" CABINET LIGHT	
FOUR WAY SWITCH		RECESSED LED STEP/AISLE FIXTURE	
DIMMER SWITCH		INTERCOM	
4 VACANCY SENSOR SWITCH		DOORBELL	
MOTION SENSOR		WEATHERPROOF FIXTURE	
PHOTOCELL MOTION SENSOR		DAMP LOCATION	
DOOR JAMB SWITCH		WATER LINE	
STRUCTURED MEDIA OUTLET		GAS SUPPLY	
FLUORESCENT LAMP		HOSE BIBB	
LED LAMP		TANKLESS GAS FIRED BOILER	
FLUORESCENT FIXTURE		CEILING FAN	
LED WALL SCONCE		CEILING MTD SPEAKER	
LED SCONCE W/MOTION SENSOR		ELECTRICAL SUB-PANEL	
SPECIALTY RECESSED LED FIXTURE		TAMPER RESISTANT	
RECESSED LED FIXTURE		EMERGENCY LIGHTING	
ADJUSTABLE RECESSED LED FIXTURE		EXIT SIGN	
PENDANT LED FIXTURE		DIRECTIONAL EXIT SIGN	
CEILING MTD. LED FIXTURE		STROBE ALARM	
LED STRIP FIXTURE		OVERHEAD LED "STRING" LIGHT	
MONOPOINT PENDANT LIGHT		LED LANDSCAPE LIGHT	

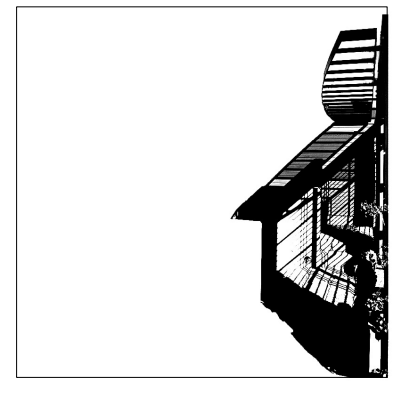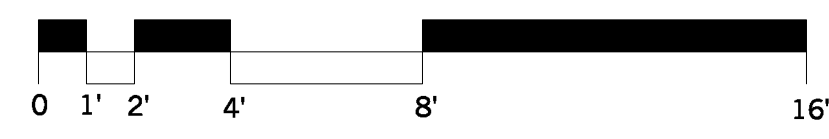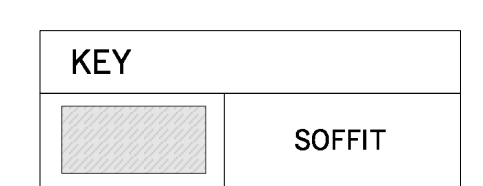

ELEVATIONarchitects
1159 Green Street, Suite 4
San Francisco, CA 94109
415.537.1125 · v
www.elevationarchitects.com · w



agency stamps:

Condominiums
42 Otis Street
San Francisco, CA 94103
Block / Lot : 3503 / 020

#	date	issue
2	4.15.20	Project Revision 2
3	4.27.20	Plan Check Response 2
4	8.17.20	Plan Check Response 3


sheet count 38/49

**5th Floor
Reflected Ceiling
& Electrical Plans**

project: 16.15
drawn by: mka
checked by: jp
date: 01.21.19
scale:

A-6.5

*SMOKE + CO₂

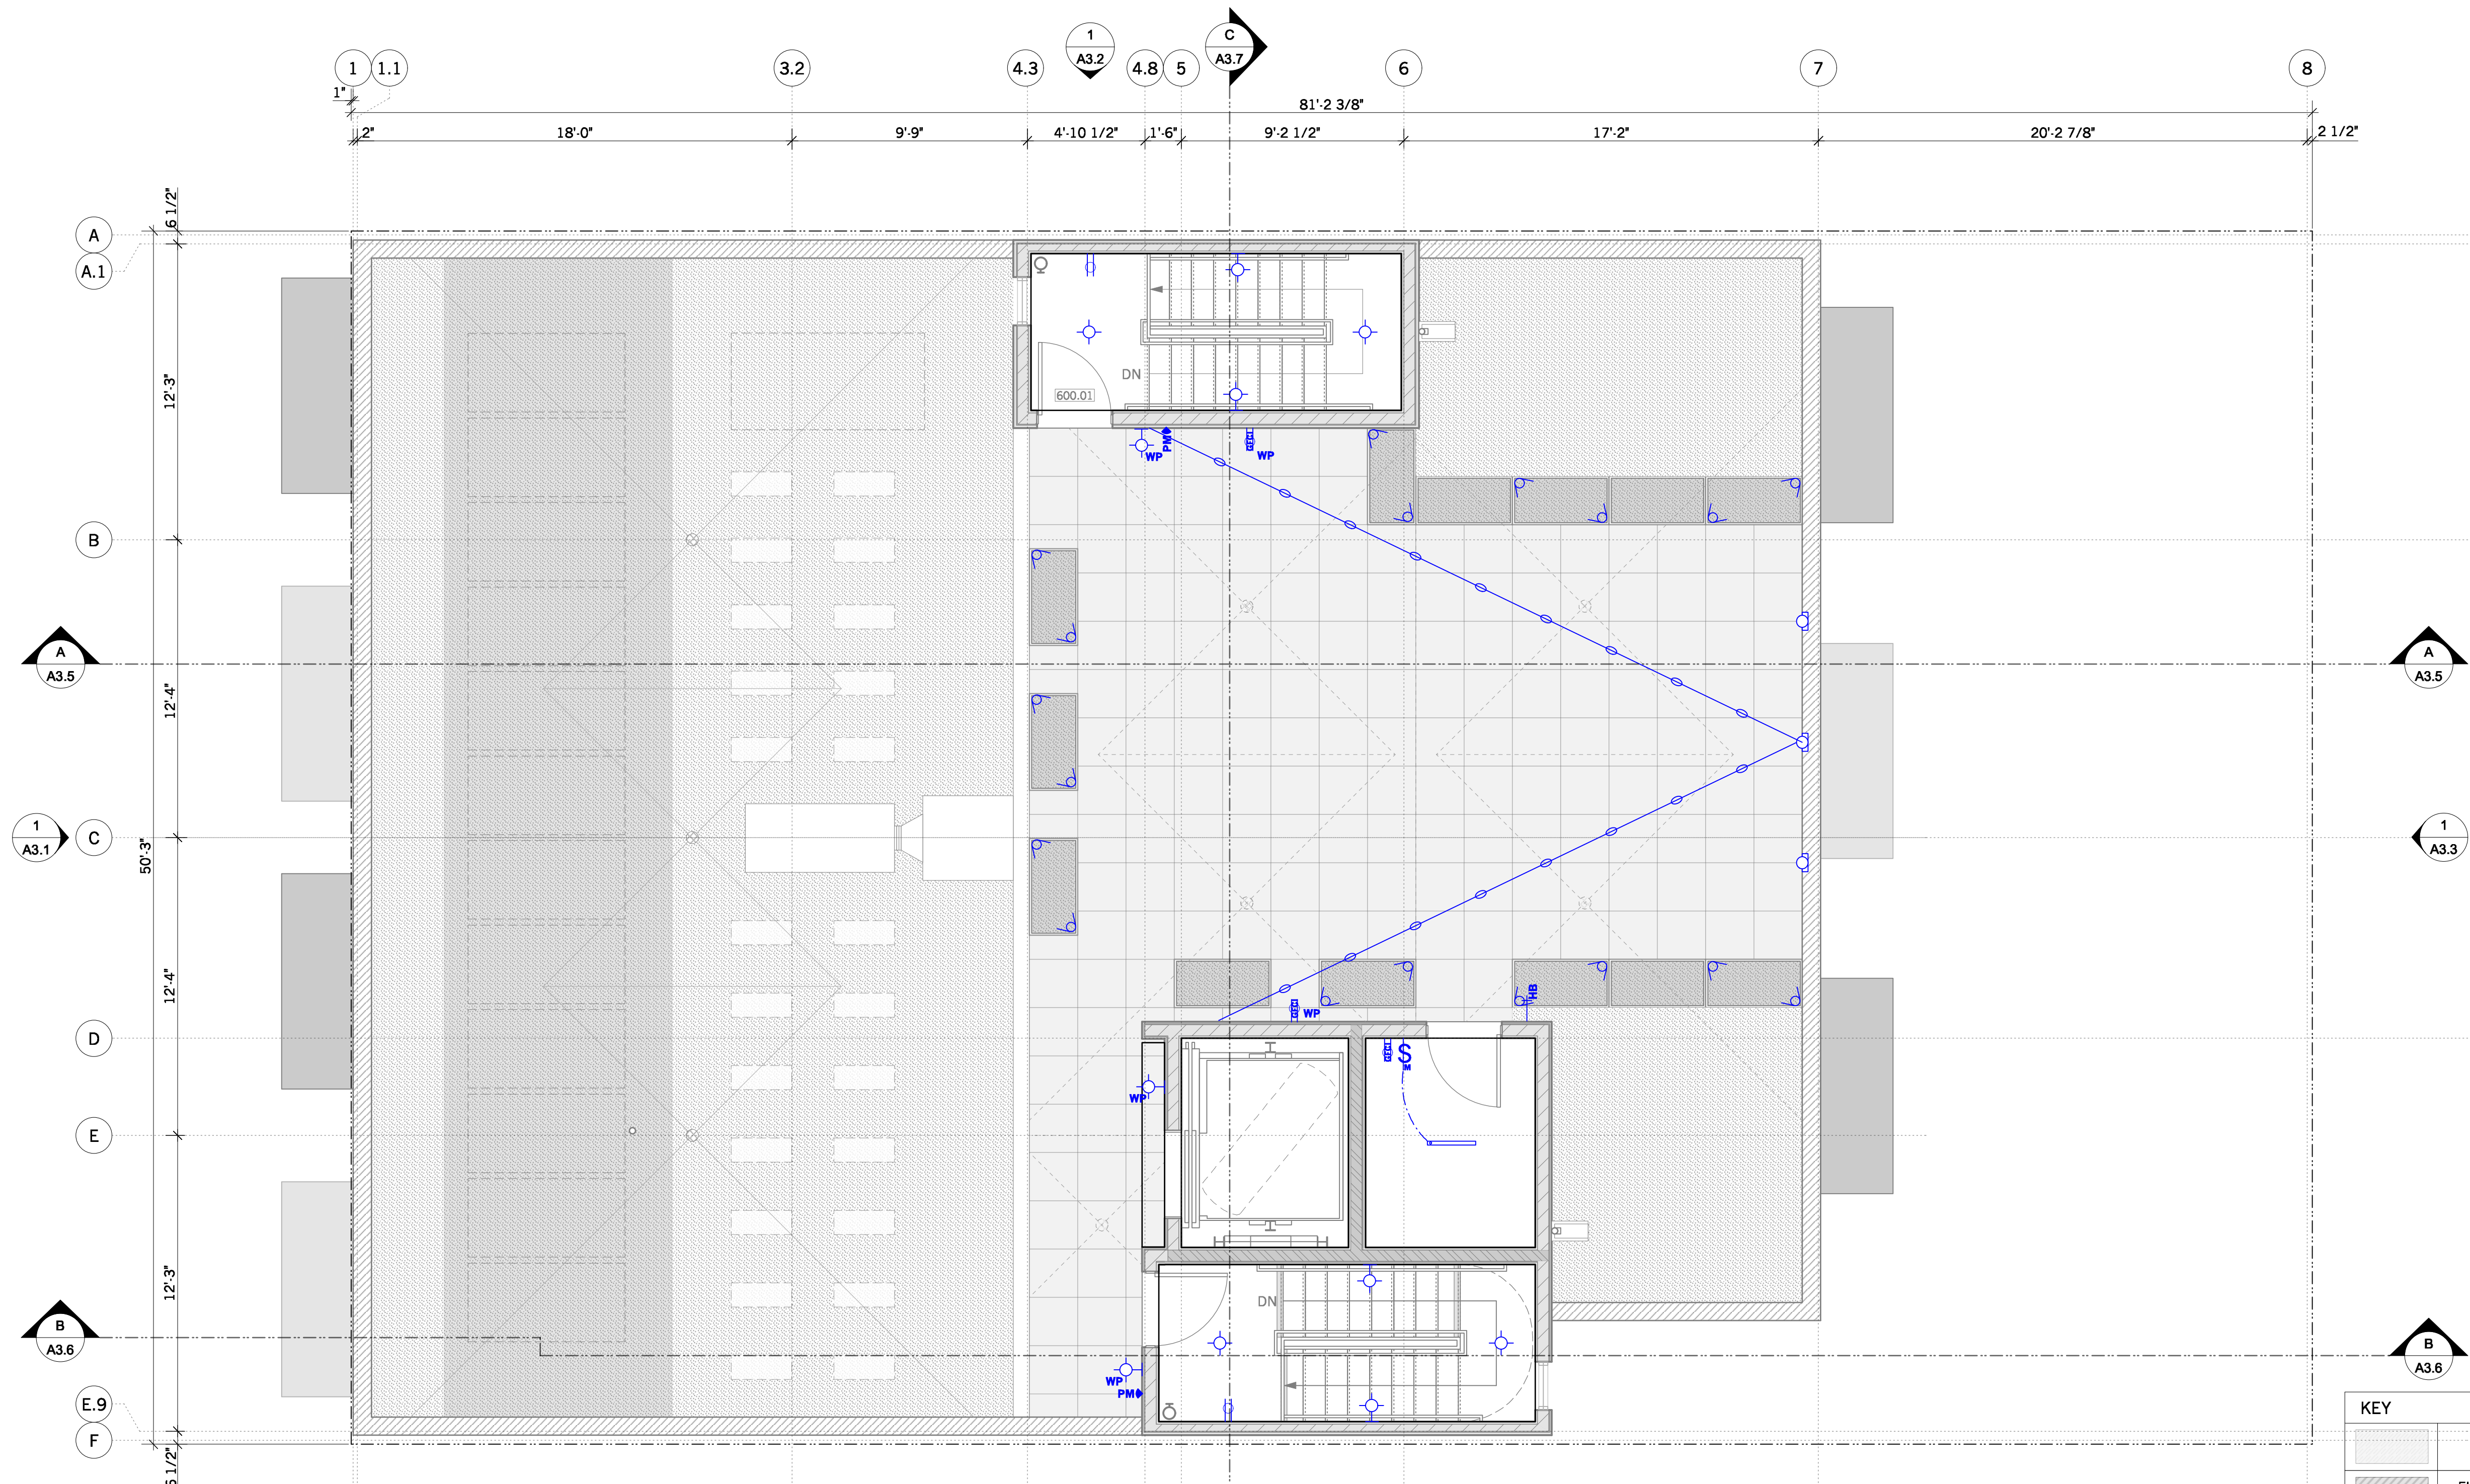


ELECTRICAL & MECHANICAL SYMBOL LEGEND	
DUPLX OUTLET	UNDER CABINET FIXTURE (FL OR LED)
SWITCHED OUTLET "HALF-HOT"	EXHAUST FAN
220 OUTLET	PRODUCT OF COMBUSTION DETECTOR*
GROUND FAULT CIRCUIT INTERRUPTER	THERMOSTAT
TWO WAY SWITCH	JUNCTION BOX
THREE WAY SWITCH	"PUCK" CABINET LIGHT
FOUR WAY SWITCH	RECESSED LED STEP/AISLE FIXTURE
DIMMER SWITCH	INTERCOM
4 VACANCY SENSOR SWITCH	DOORBELL
MOTION SENSOR	WEATHERPROOF FIXTURE
PHOTOCELL MOTION SENSOR	DAMP LOCATION
DOOR JAMB SWITCH	WATER LINE
STRUCTURED MEDIA OUTLET	GAS SUPPLY
FLUORESCENT LAMP	HOSE BIBB
LED LAMP	TANKLESS GAS FIRED BOILER
FLUORESCENT FIXTURE	CEILING FAN
LED WALL SCONCE	CEILING MTD SPEAKER
LED SCONCE W/MOTION SENSOR	ELECTRICAL SUB-PANEL
SPECIALTY RECESSED LED FIXTURE	TAMPER RESISTANT
RECESSED LED FIXTURE	EMERGENCY LIGHTING
ADJUSTABLE RECESSED LED FIXTURE	EXIT SIGN
PENDANT LED FIXTURE	DIRECTIONAL EXIT SIGN
CEILING MTD. LED FIXTURE	STROBE ALARM
LED STRIP FIXTURE	OVERHEAD LED "STRING" LIGHT
MONOPOINT PENDANT LIGHT	LED LANDSCAPE LIGHT

NOTE:
ALL INSTALLED LIGHTING SHALL BE
HIGH EFFICACY.

KEY	
[Pattern]	SOFFIT
[Pattern]	FIRE-RATED SOFFIT

KEY	
[Pattern]	SOFFIT

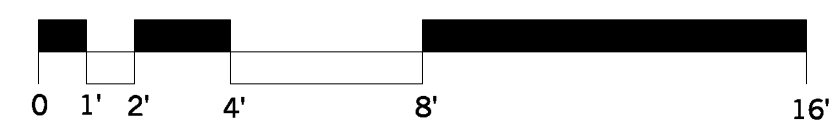

ELEVATIONarchitects
1159 Green Street, Suite 4
San Francisco, CA 94109
415.537.1125 :v
www.elevationarchitects.com :w



agency stamps:

Condominiums
42 Otis Street
San Francisco, CA 94103
Block / Lot : 3503 / 020


#	date	issue
2	4.15.20	Project Revision 2
3	4.27.20	Plan Check Response 2
4	8.17.20	Plan Check Response 3

sheet count 39/49


Roof Reflected Ceiling & Electrical Plans

project: 16.15
drawn by: mka
checked by: jp
date: 01.21.19
scale:


A-6.6

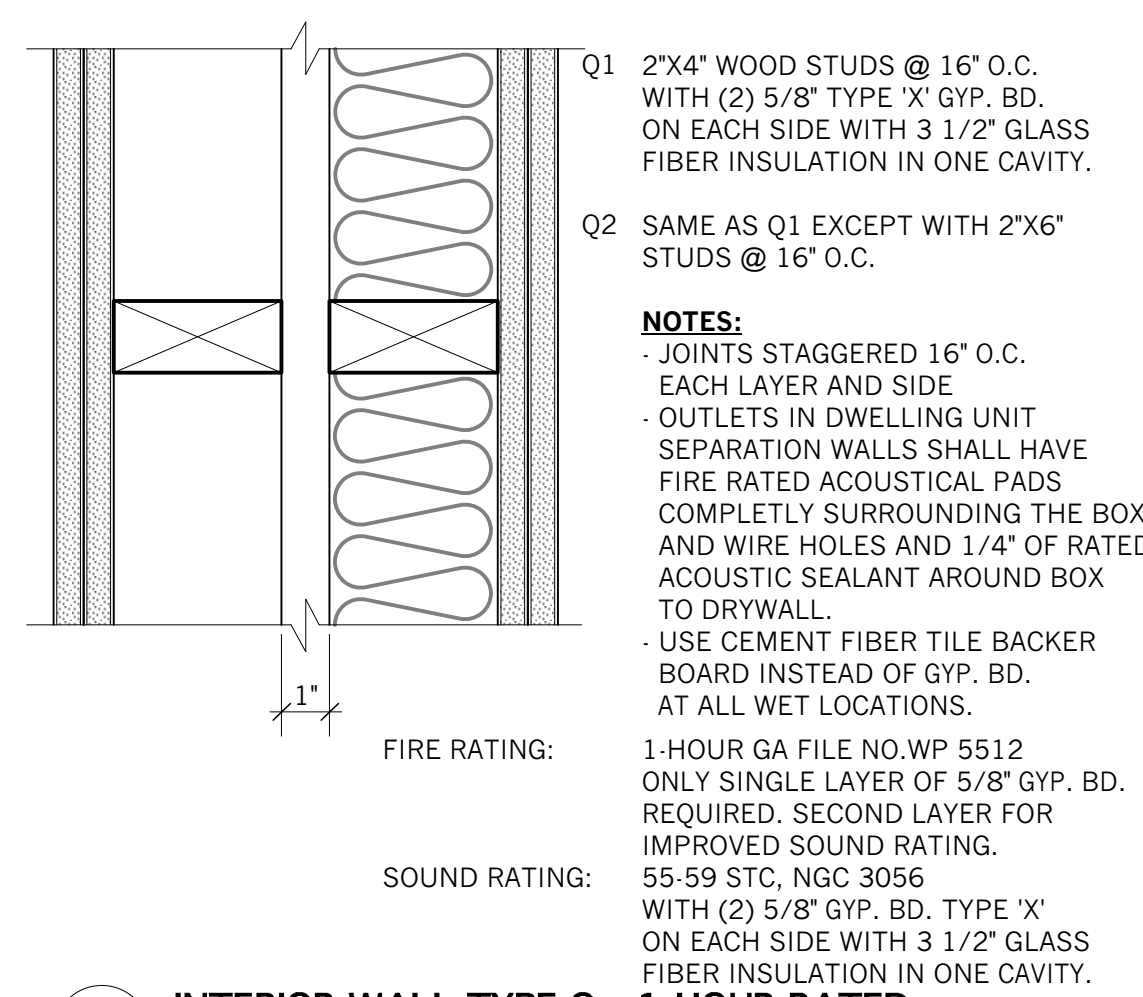


17 INTERIOR WALL TYPE Q - 1-HOUR RATED
Scale: 3" = 1'-0"

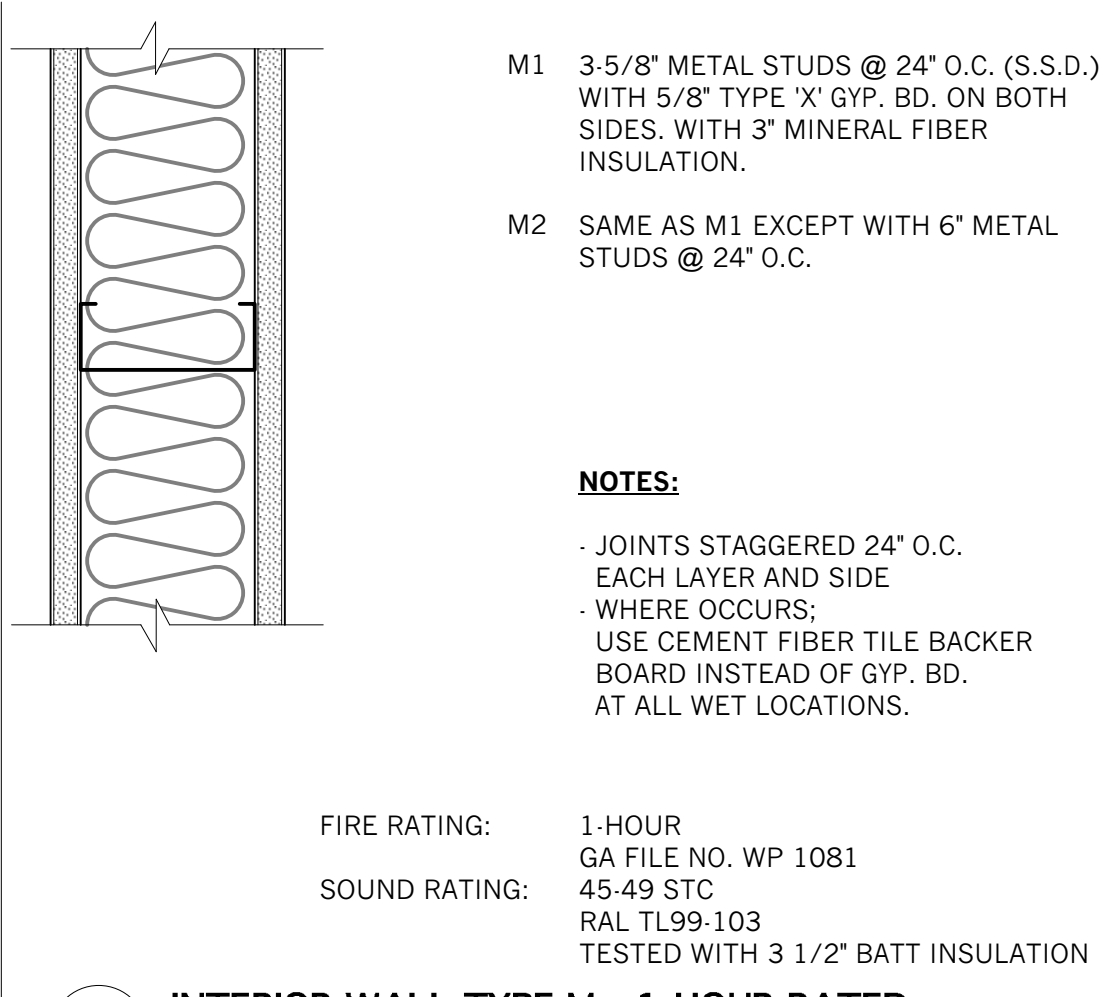


13 INTERIOR WALL TYPE M - 1-HOUR RATED
Scale: 3" = 1'-0"

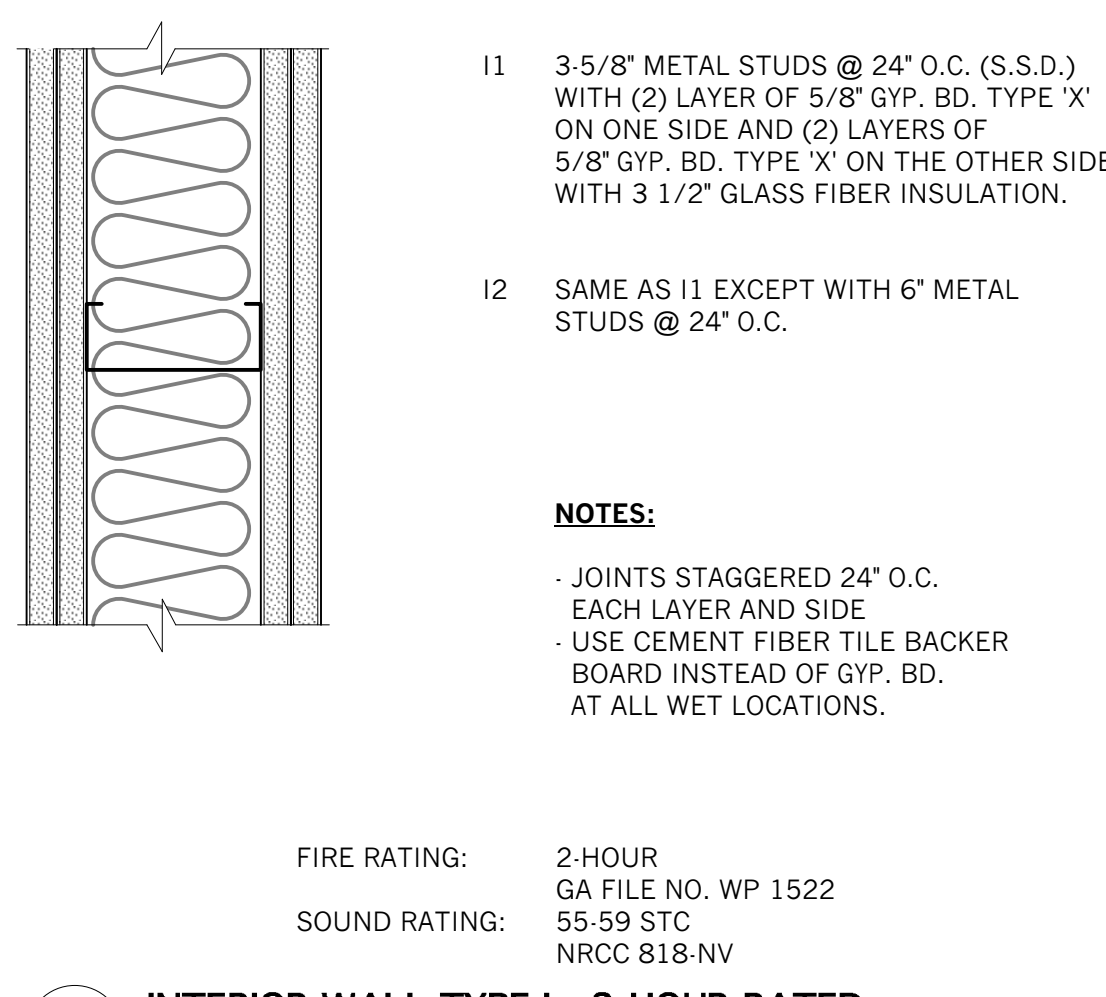


9 INTERIOR WALL TYPE I - 2-HOUR RATED
Scale: 3" = 1'-0"

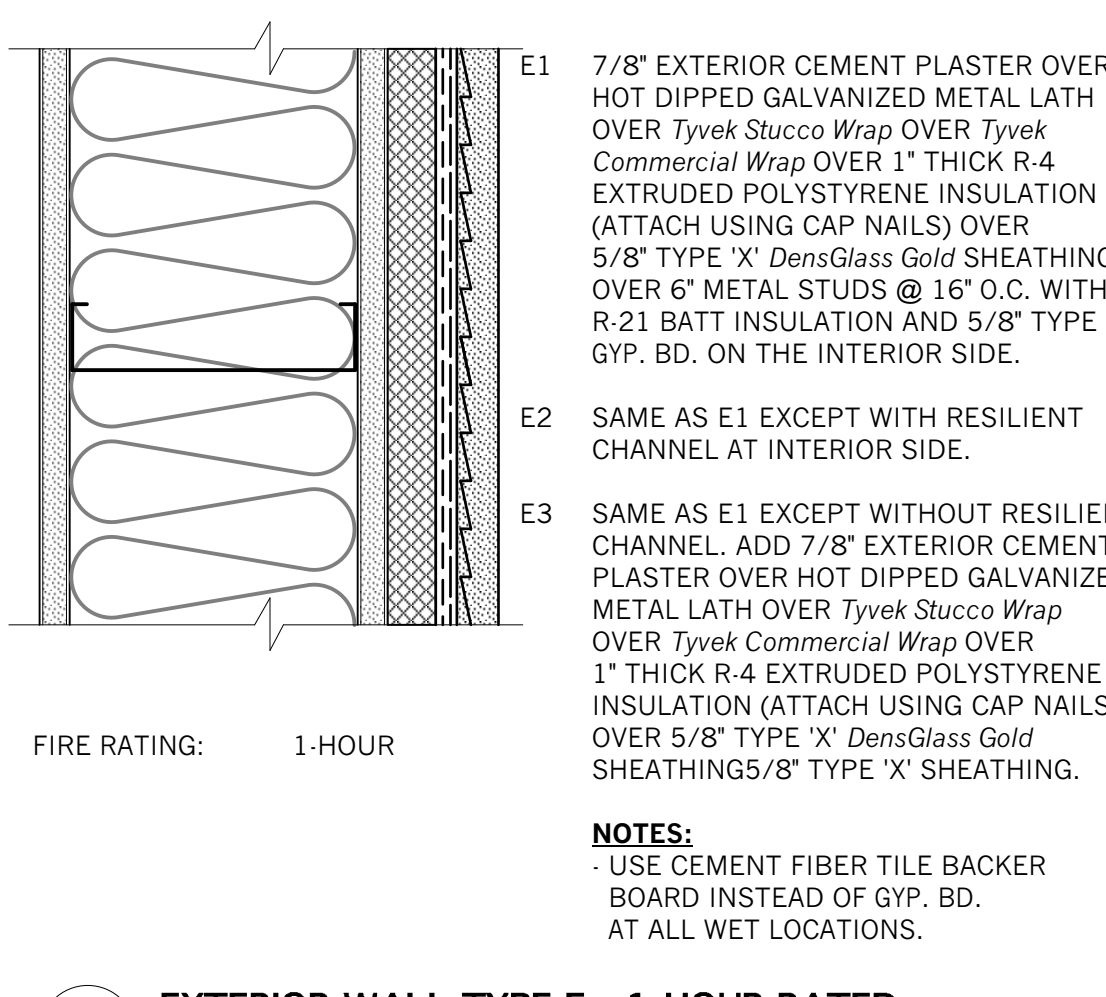


5 EXTERIOR WALL TYPE E - 1-HOUR RATED
Scale: 3" = 1'-0"

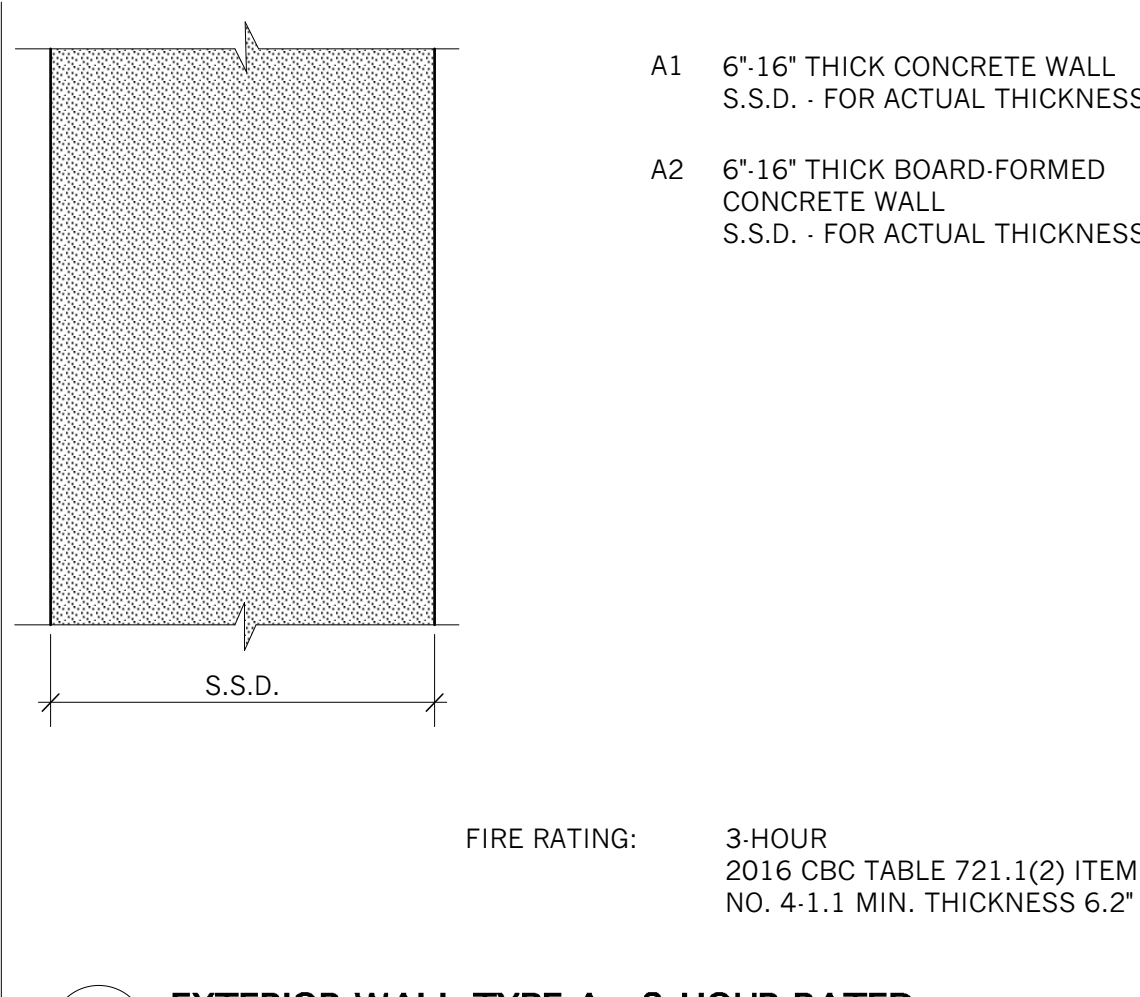


1 EXTERIOR WALL TYPE A - 3-HOUR RATED
Scale: 3" = 1'-0"

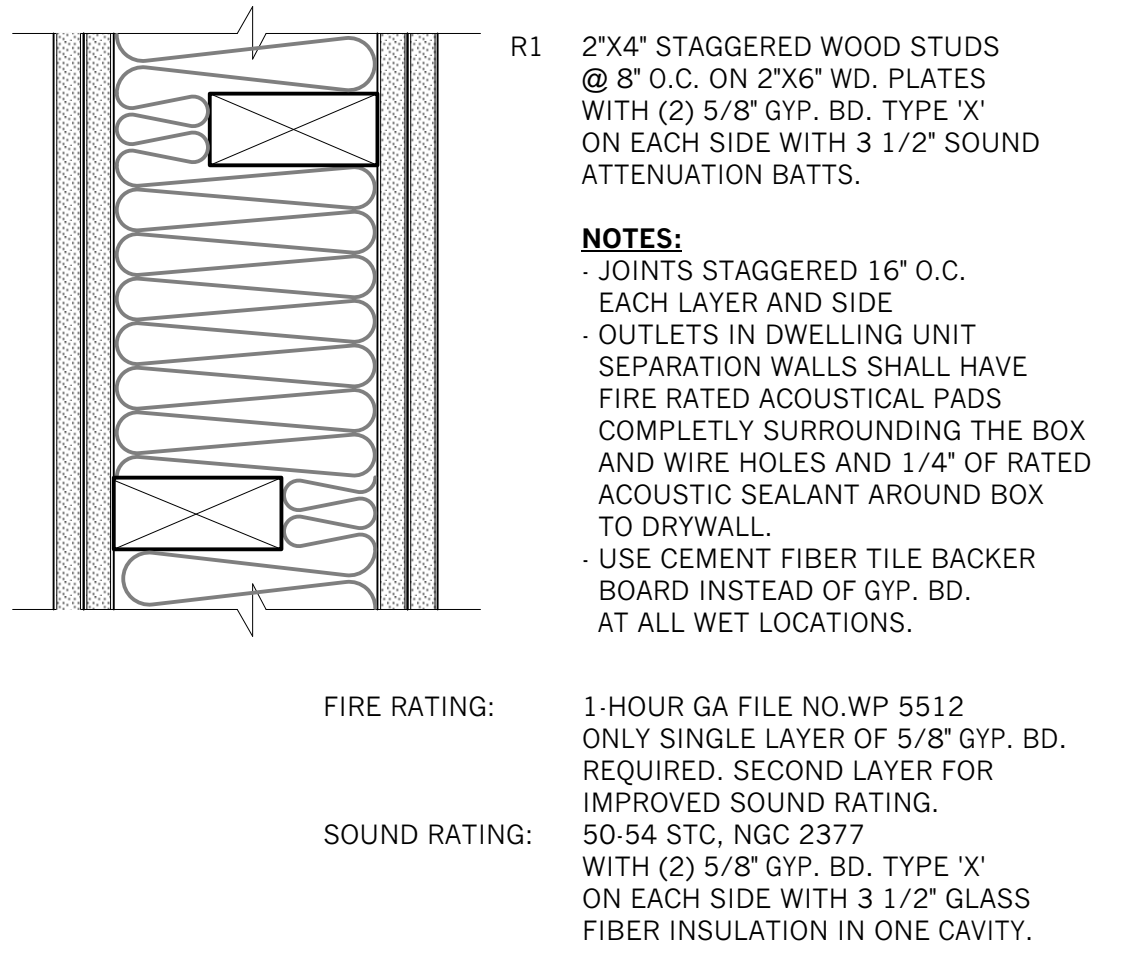


18 INTERIOR WALL TYPE R - 1-HOUR RATED
Scale: 3" = 1'-0"

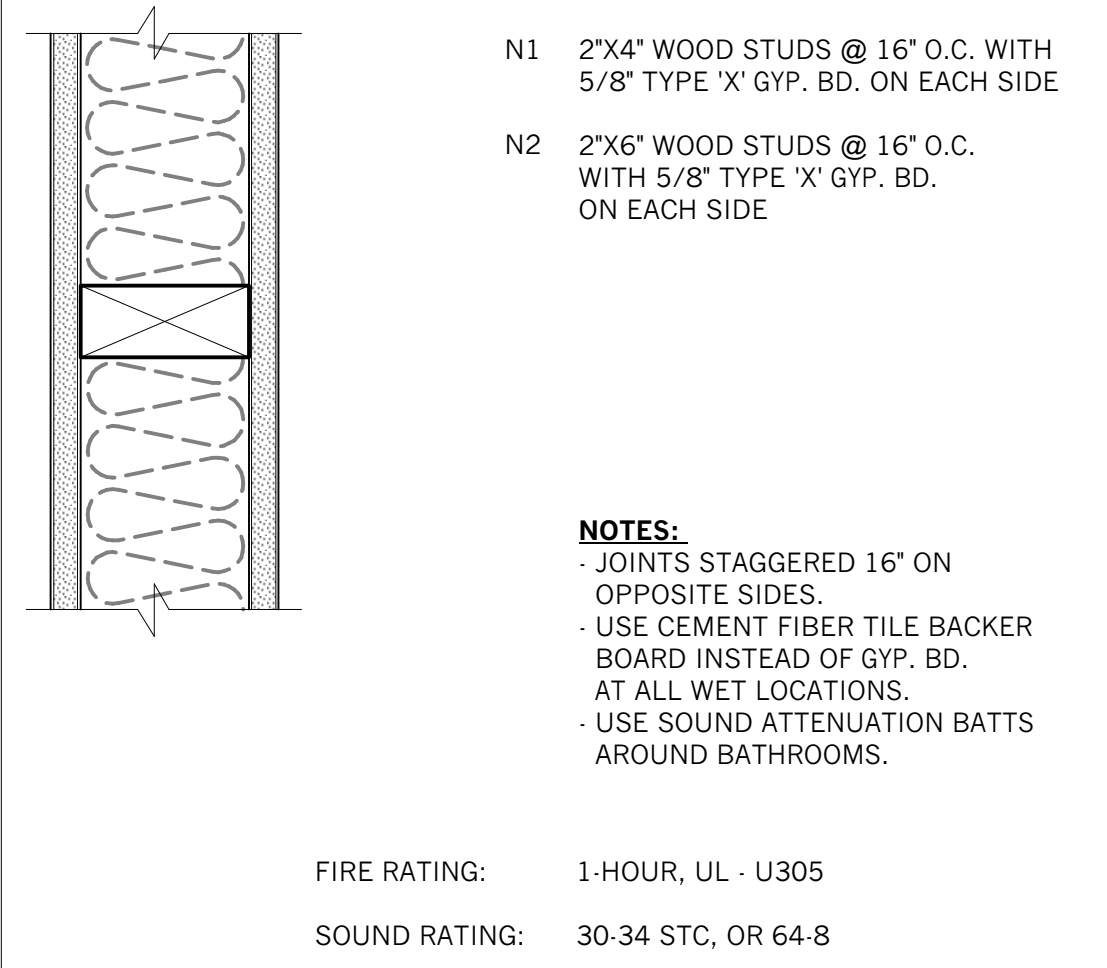


14 INTERIOR WALL TYPE N - 1-HOUR RATED
Scale: 3" = 1'-0"

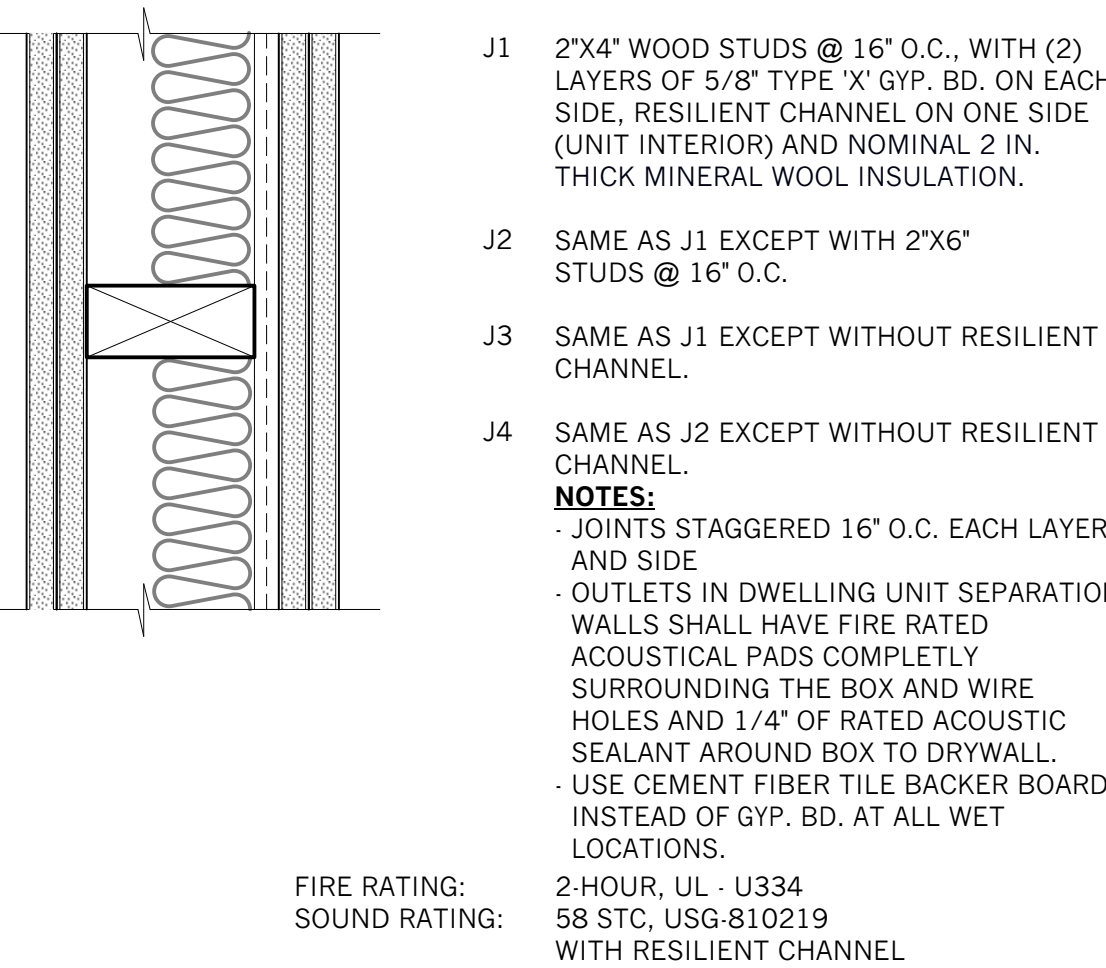


10 INTERIOR WALL TYPE J - 2-HOUR RATED
Scale: 3" = 1'-0"

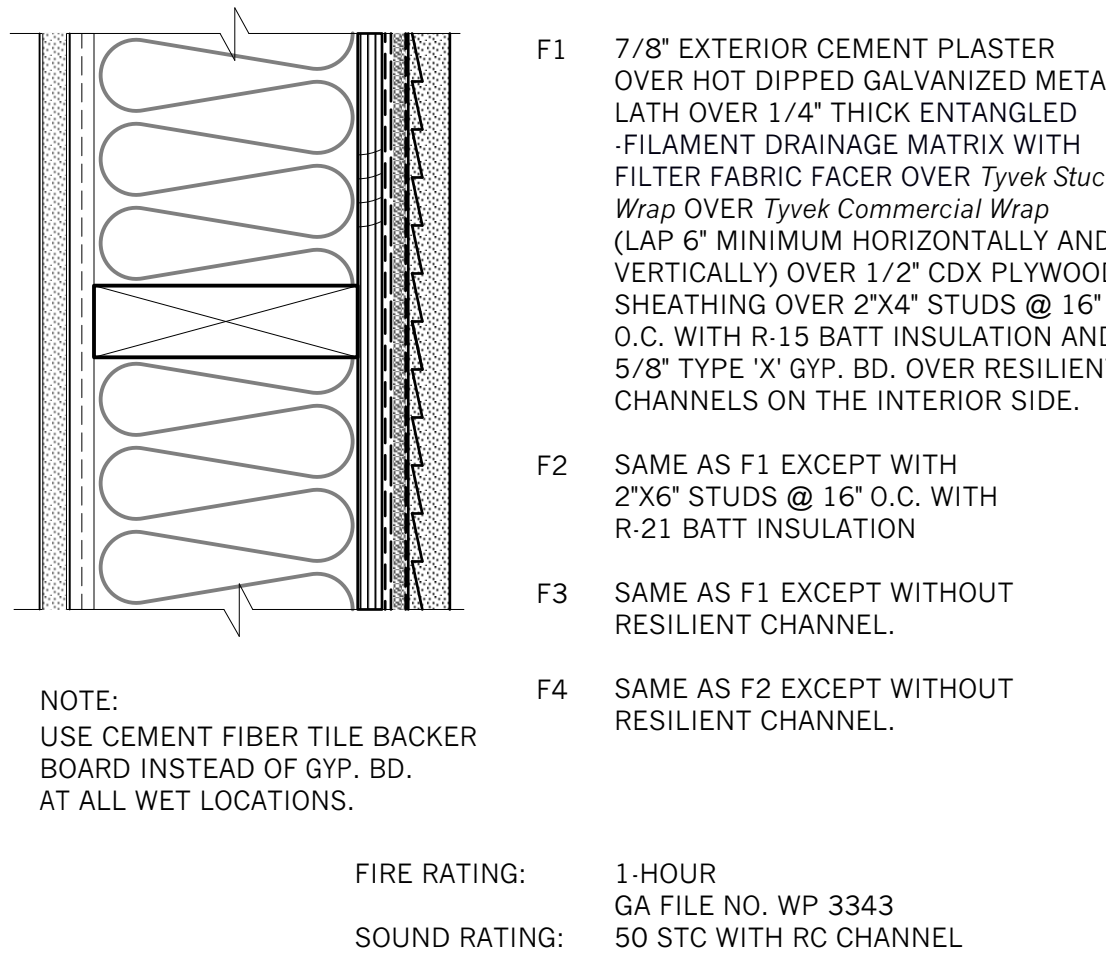


6 EXTERIOR WALL TYPE F - 1-HOUR RATED
3" = 1'-0"

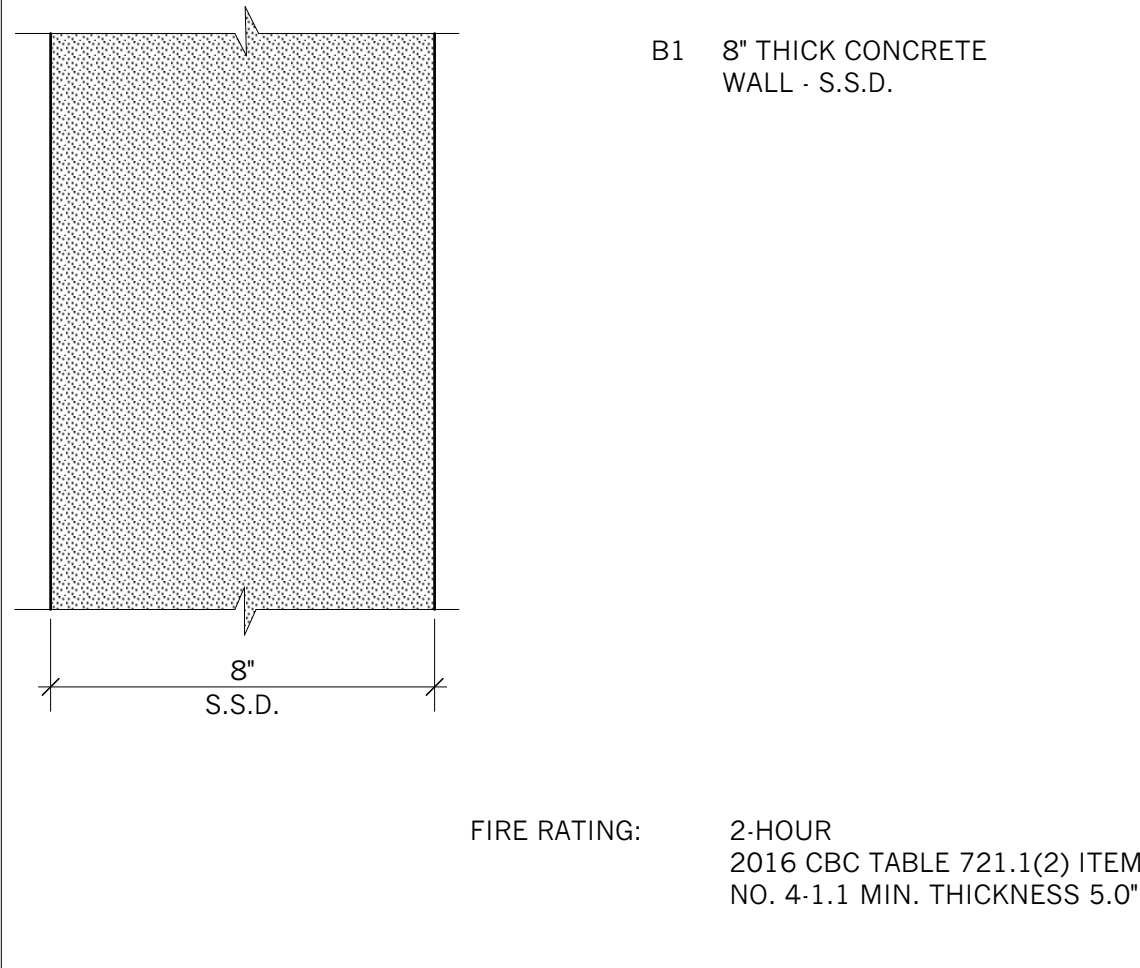


2 EXTERIOR WALL TYPE B - 2-HOUR RATED
Scale: 3" = 1'-0"

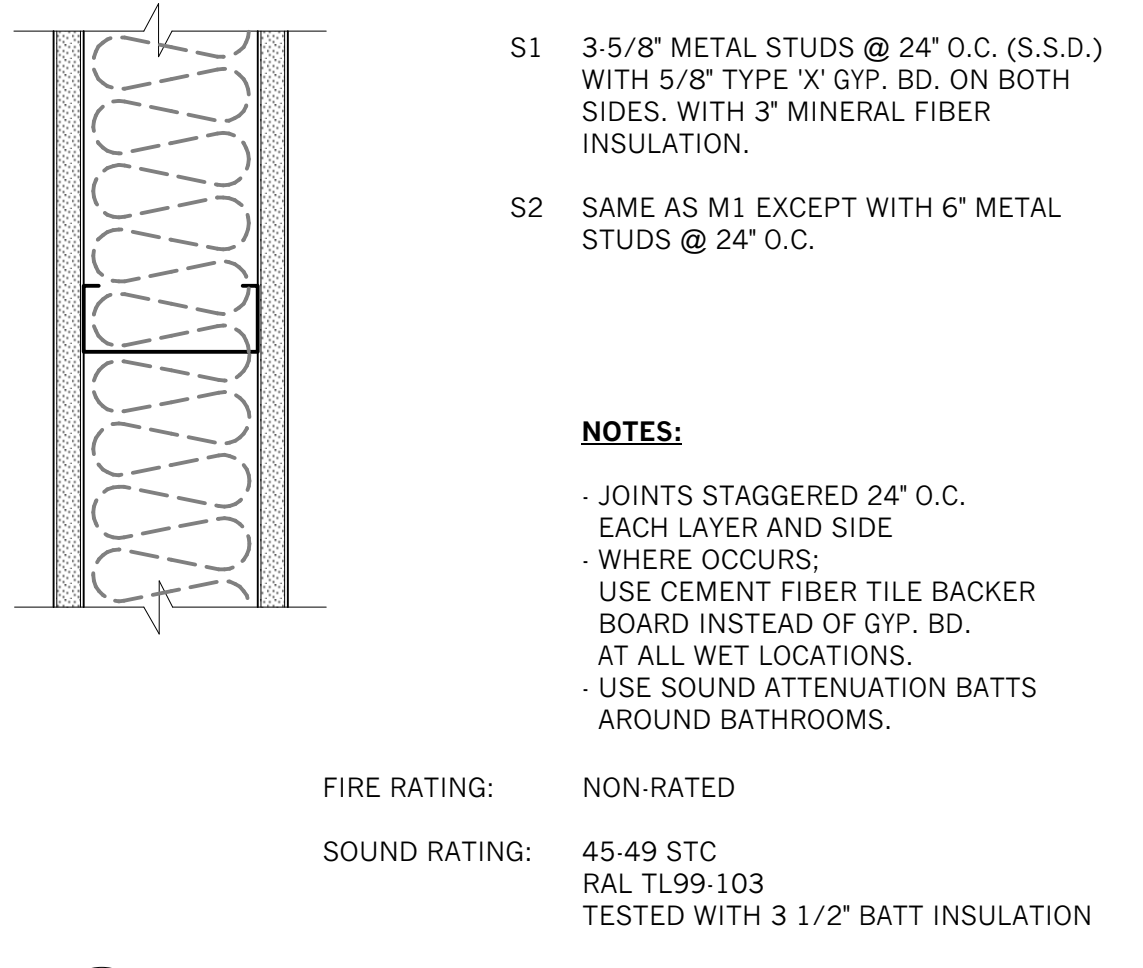


19 INTERIOR WALL TYPE S - NON-RATED
Scale: 3" = 1'-0"

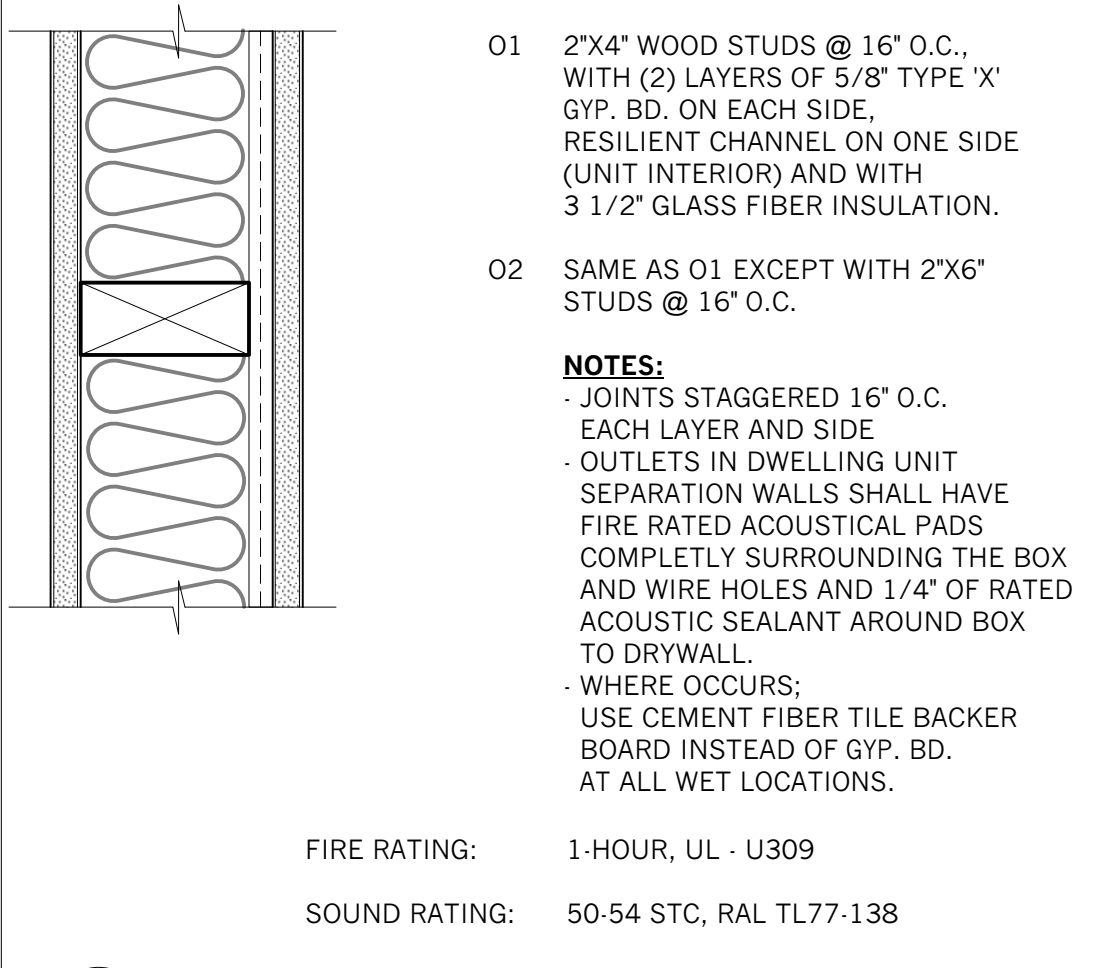


15 INTERIOR WALL TYPE O - 1-HOUR RATED
Scale: 3" = 1'-0"

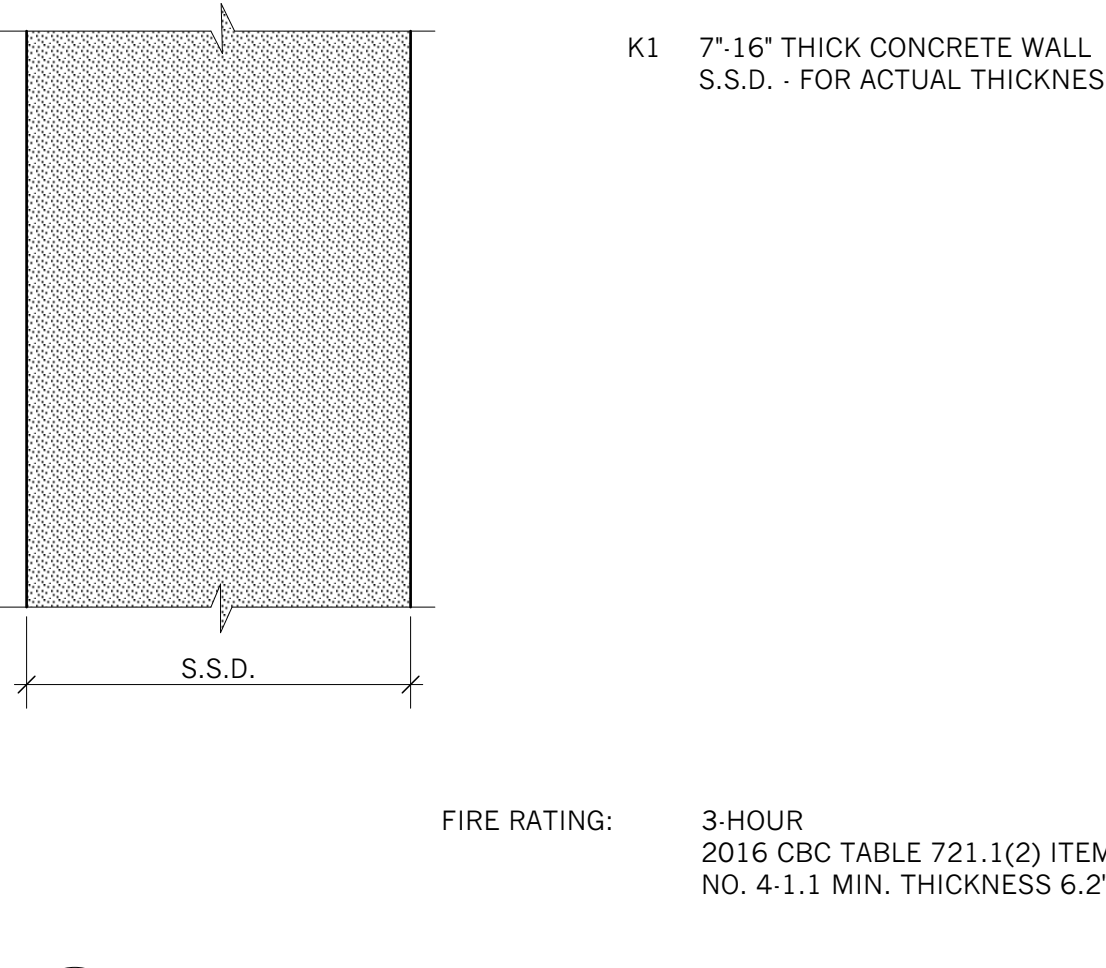


11 INTERIOR WALL TYPE K - 3-HOUR RATED
Scale: 3" = 1'-0"

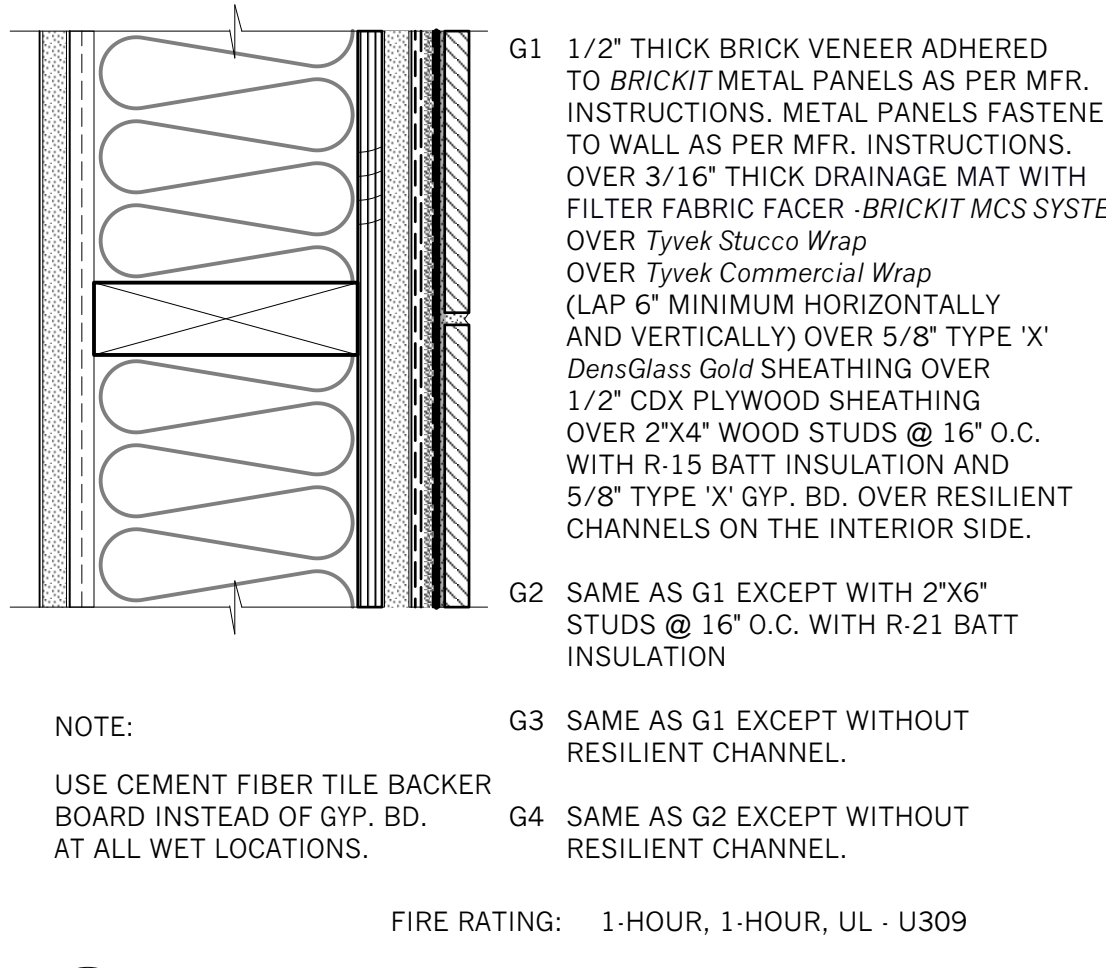


7 EXTERIOR WALL TYPE G - 1-HOUR RATED
3" = 1'-0"

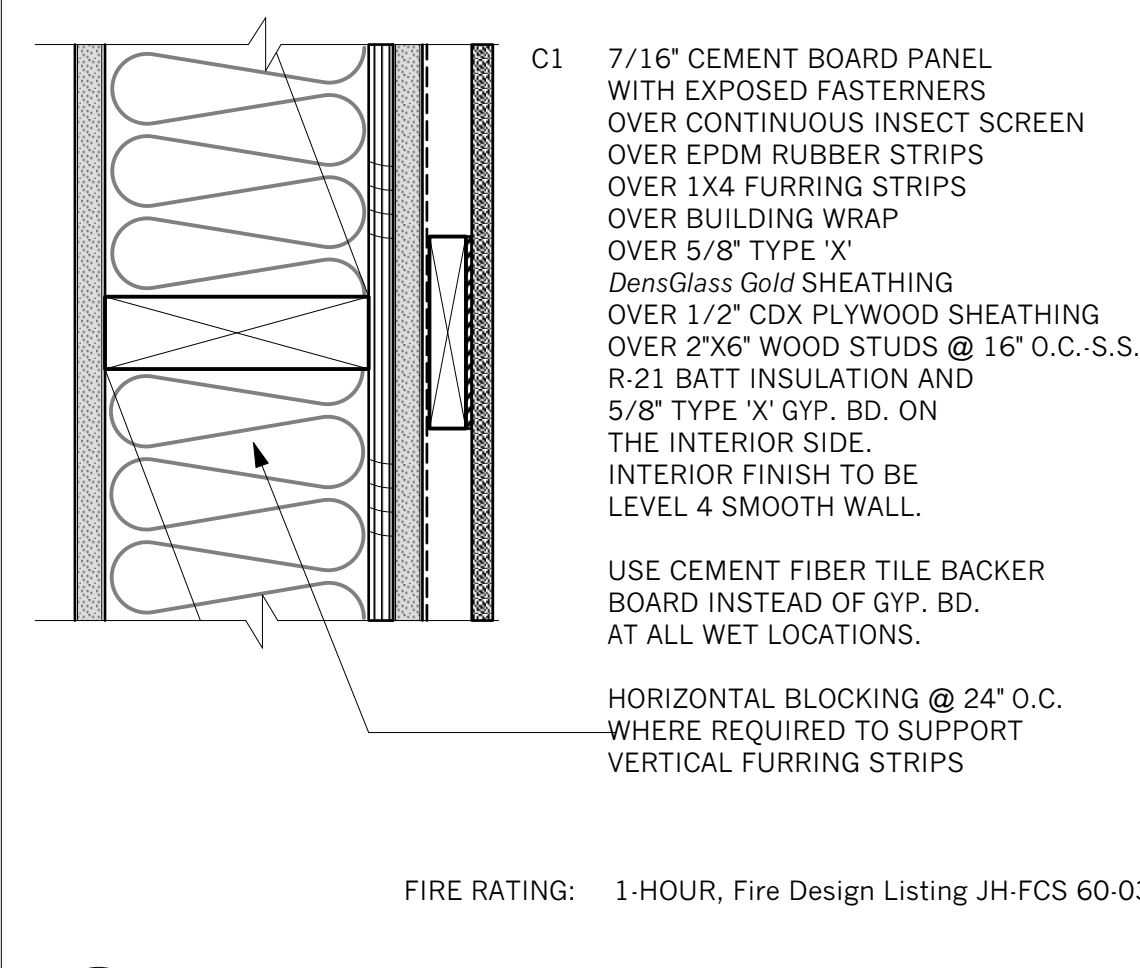


3 EXTERIOR WALL TYPE C - 1-HOUR RATED
3" = 1'-0"

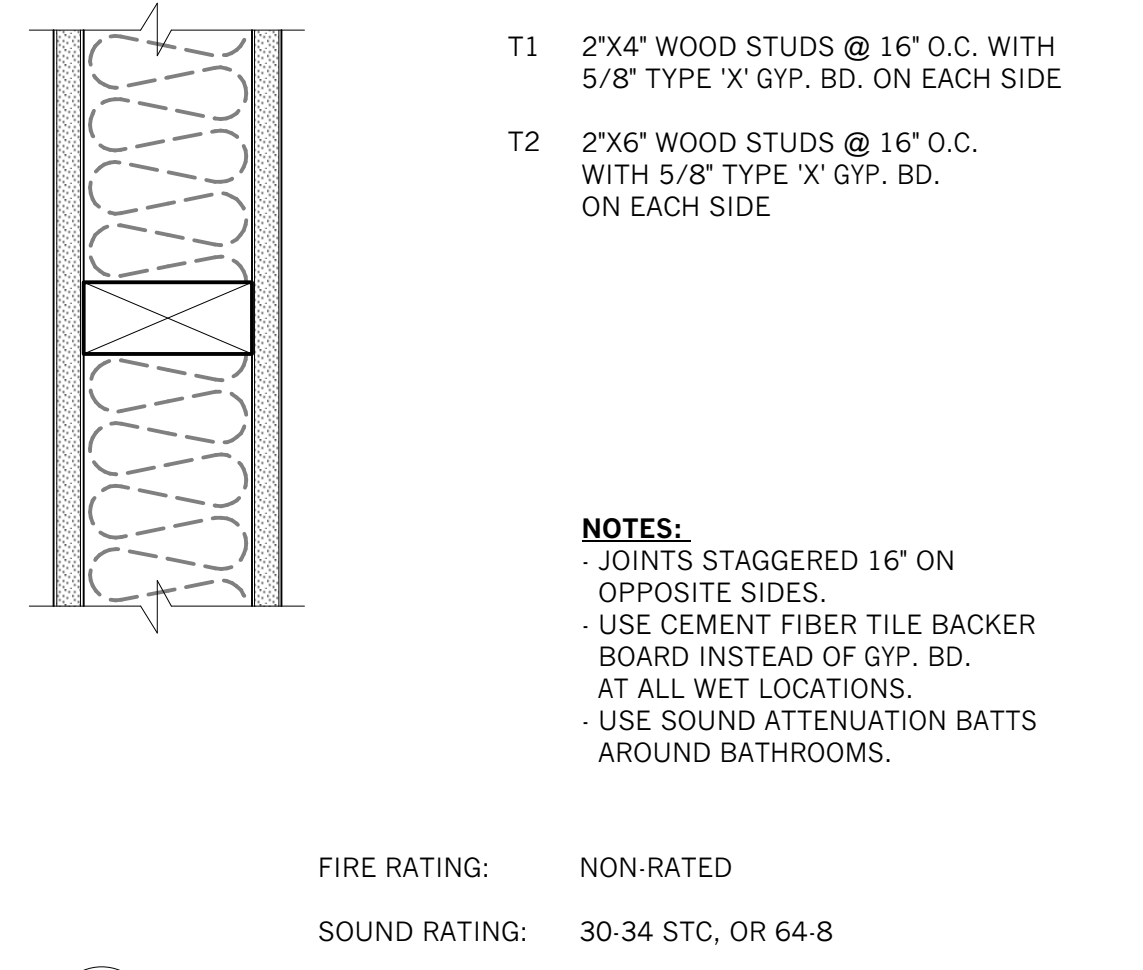


20 INTERIOR WALL TYPE T - NON-RATED
Scale: 3" = 1'-0"

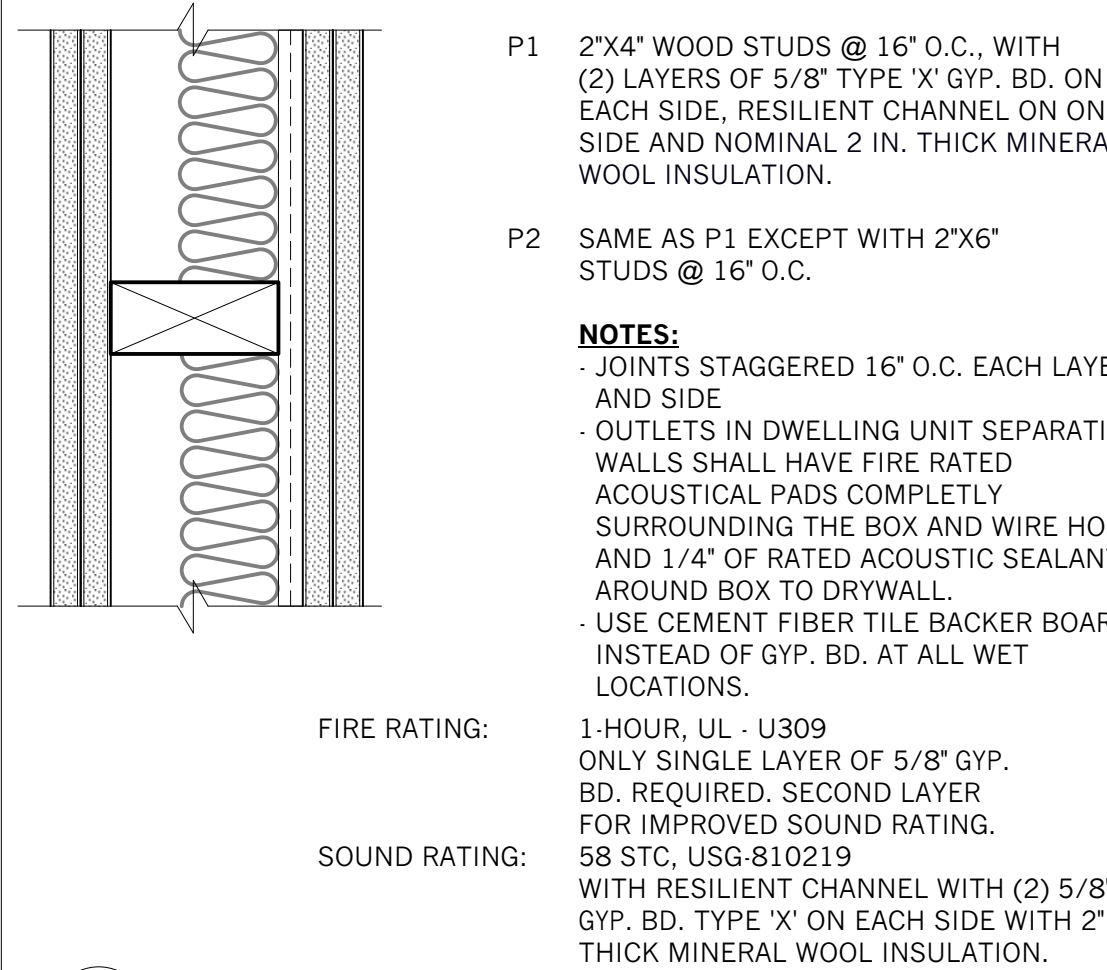


16 INTERIOR WALL TYPE P - 1-HOUR RATED
Scale: 3" = 1'-0"

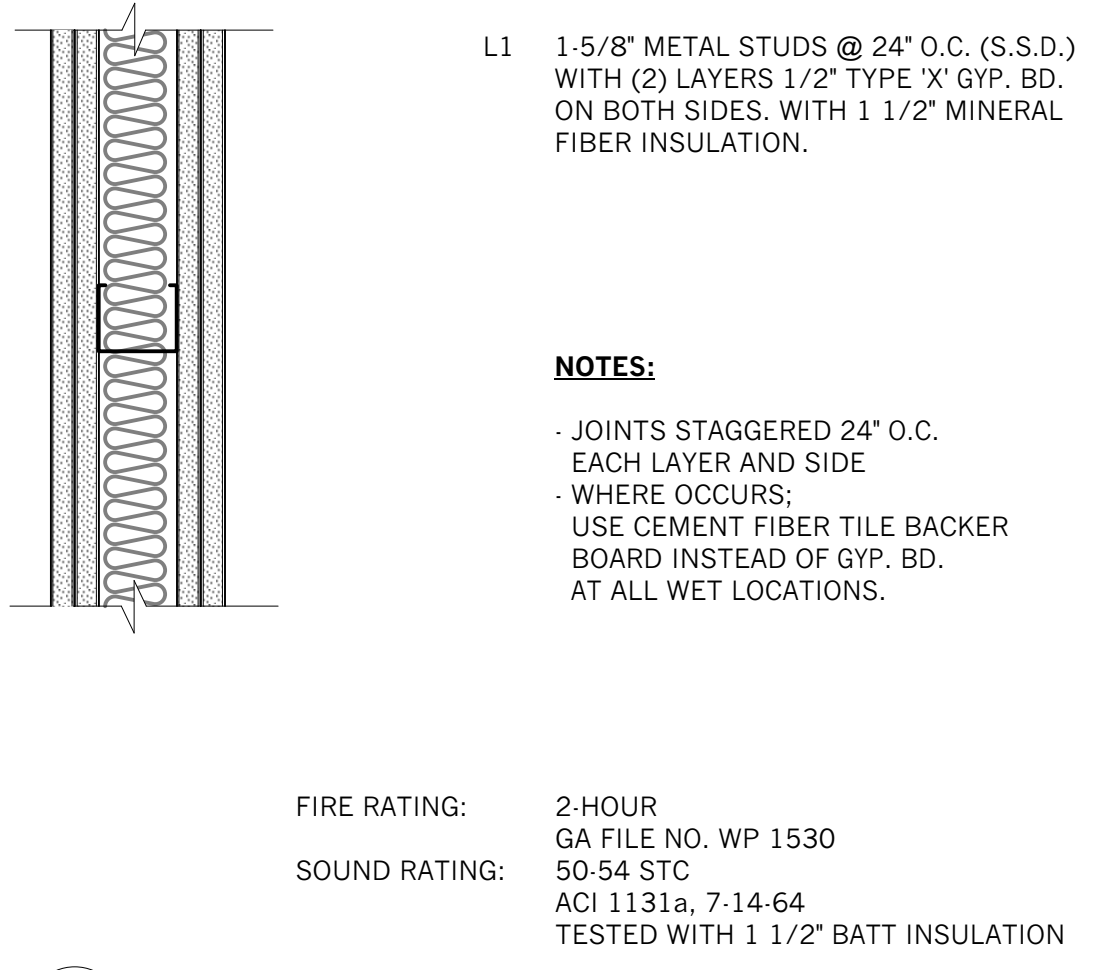

12 INTERIOR WALL TYPE L - 1-HOUR RATED
Scale: 3" = 1'-0"

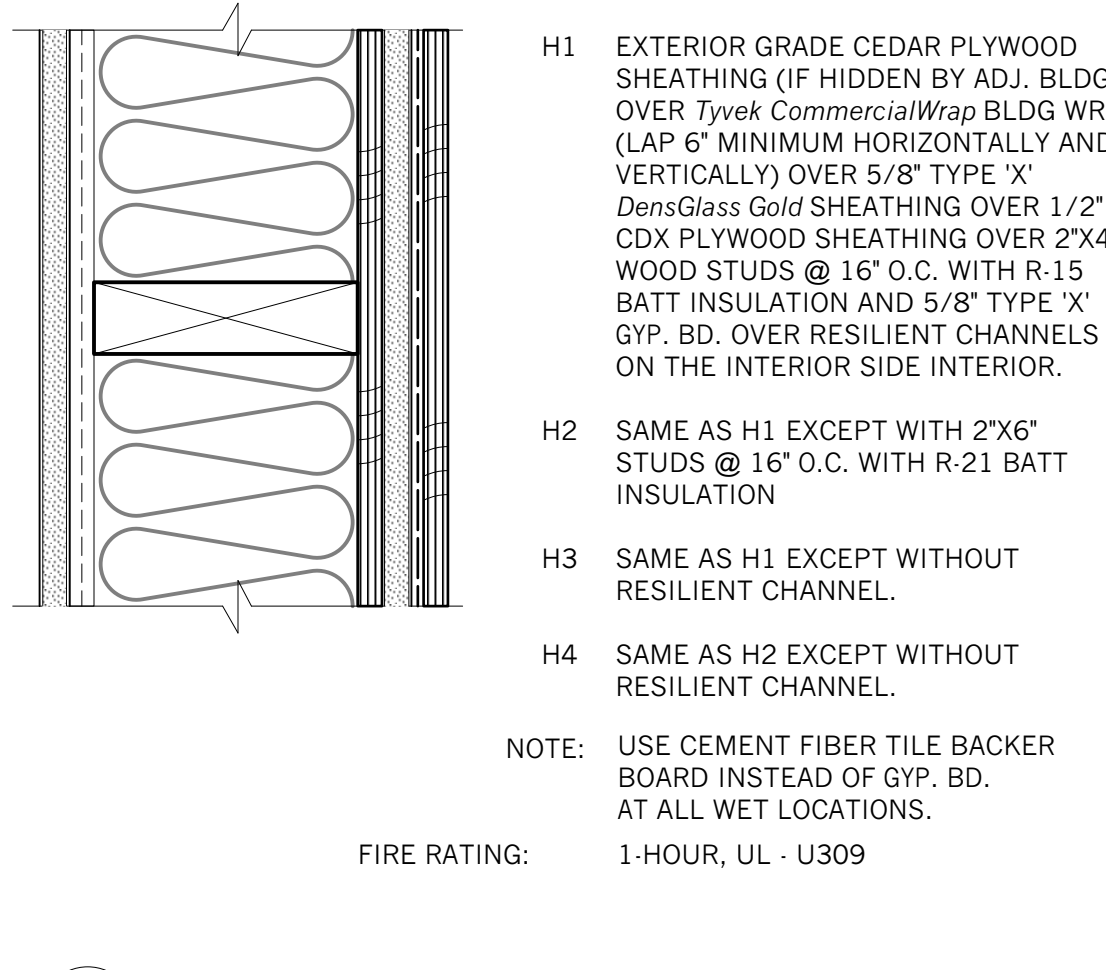


8 EXTERIOR WALL TYPE H - 1-HOUR RATED
Scale: 3" = 1'-0"

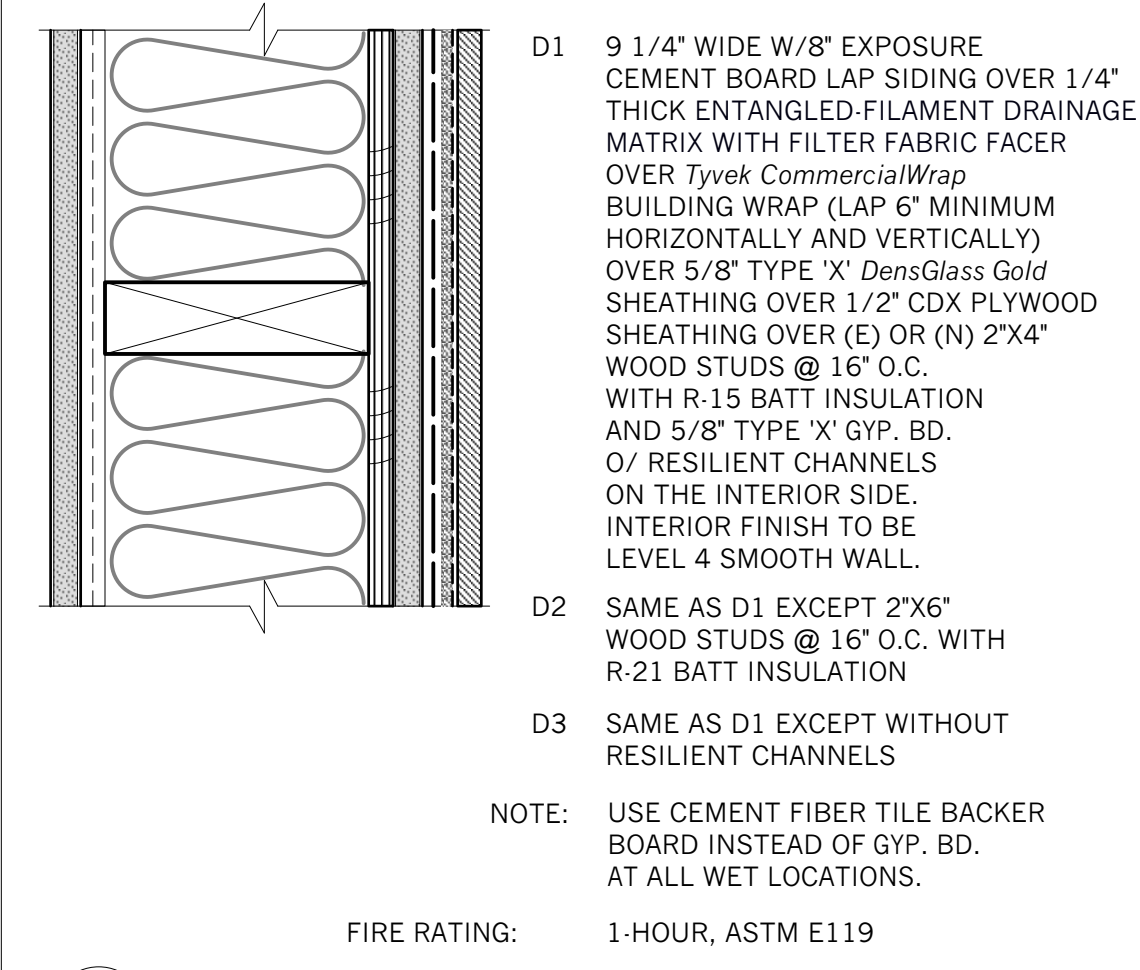

4 EXTERIOR WALL TYPE D - 1-HOUR RATED
Scale: 3" = 1'-0"



ELEVATIONarchitects
 1159 Green Street, Suite 4
 San Francisco, CA 94109
 415.537.1125 v
 www.elevationarchitects.com w

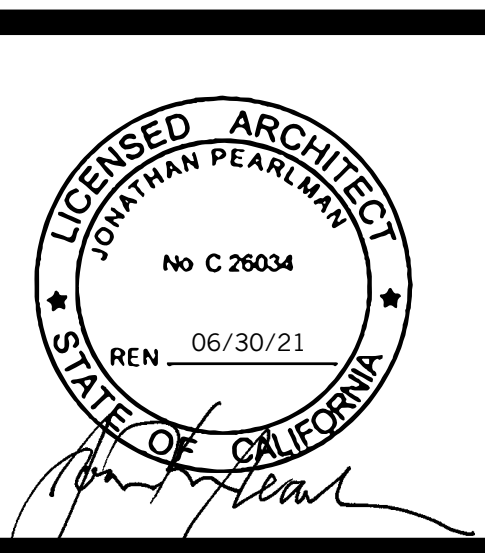

agency stamps:

Condominiums
 42 Otis Street
 San Francisco, CA 94103
 Block / Lot : 3503 / 020


#	date	issue
2	4.15.20	Project Revision 2
3	4.27.20	Plan Check Response 2
4	8.17.20	Plan Check Response 3

sheet count 40/49


Wall Assemblies

project: 16.15
 drawn by: mka
 checked by: jp
 date: 08.13.20
 scale:


A-8.1

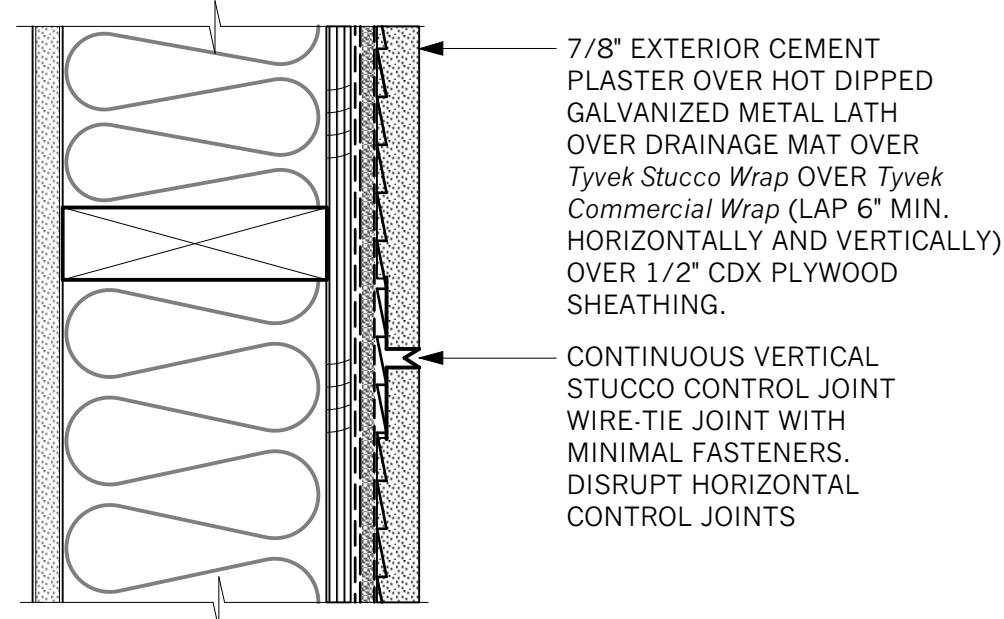


17 VERTICAL STUCCO CONTROL JOINT
Scale: 3" = 1'-0"

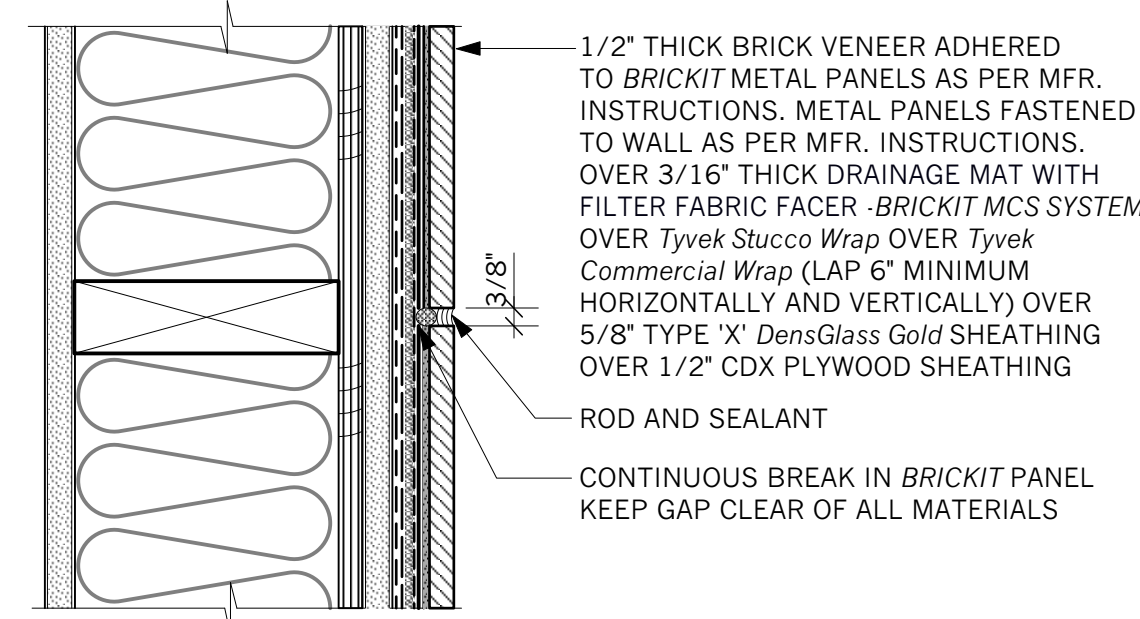


13 VERTICAL BRICK VENEER CONTROL JOINT
Scale: 3" = 1'-0"

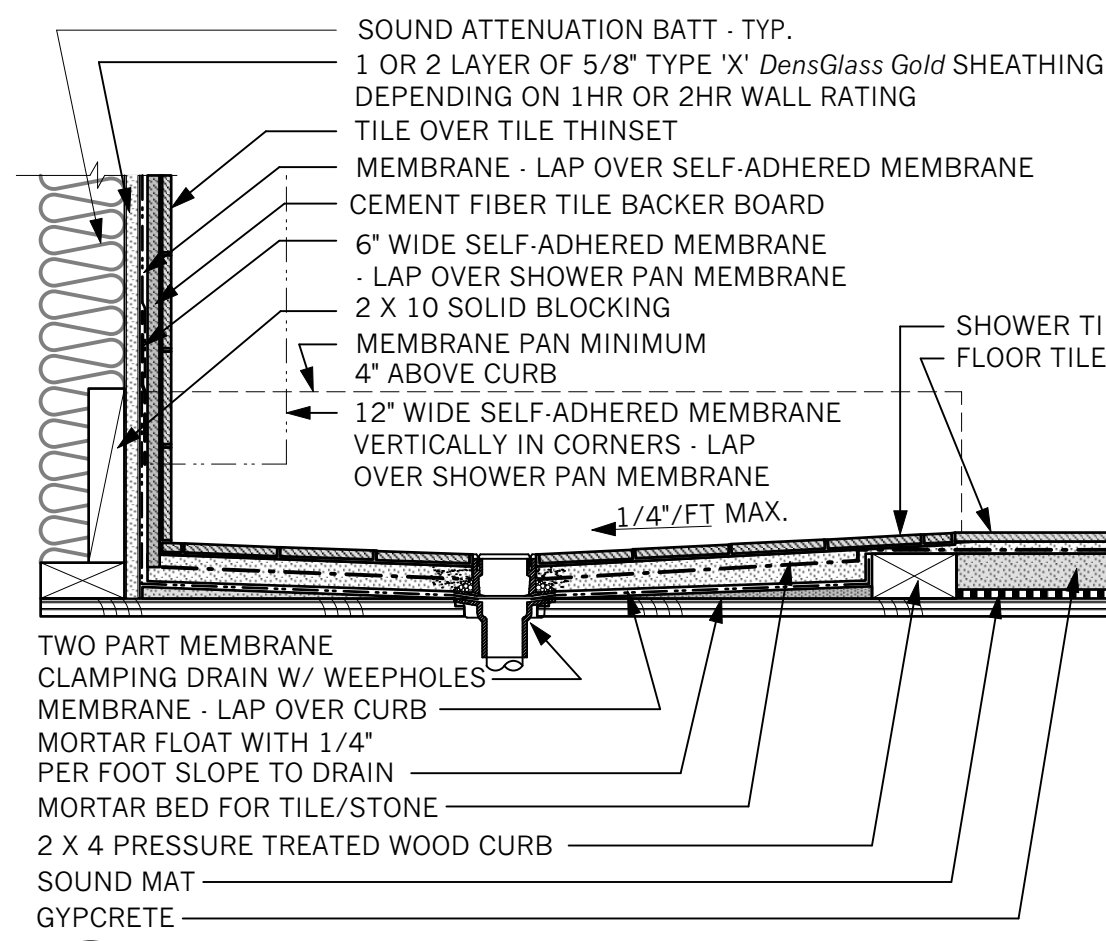


9 SHOWER PAN w/o CURB
Scale: 1 1/2" = 1'-0"

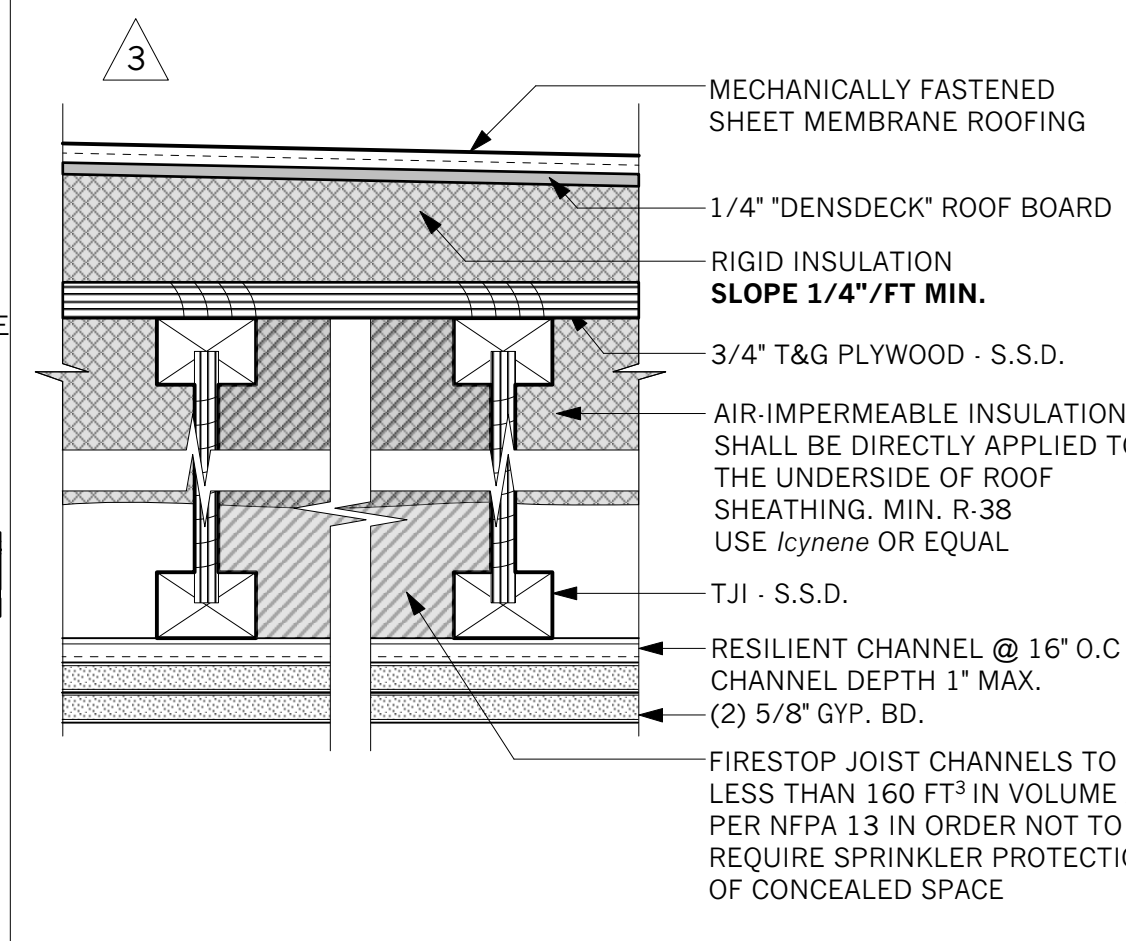


5 ROOF ASSEMBLY - 1-HOUR RATED
3" = 1'-0"

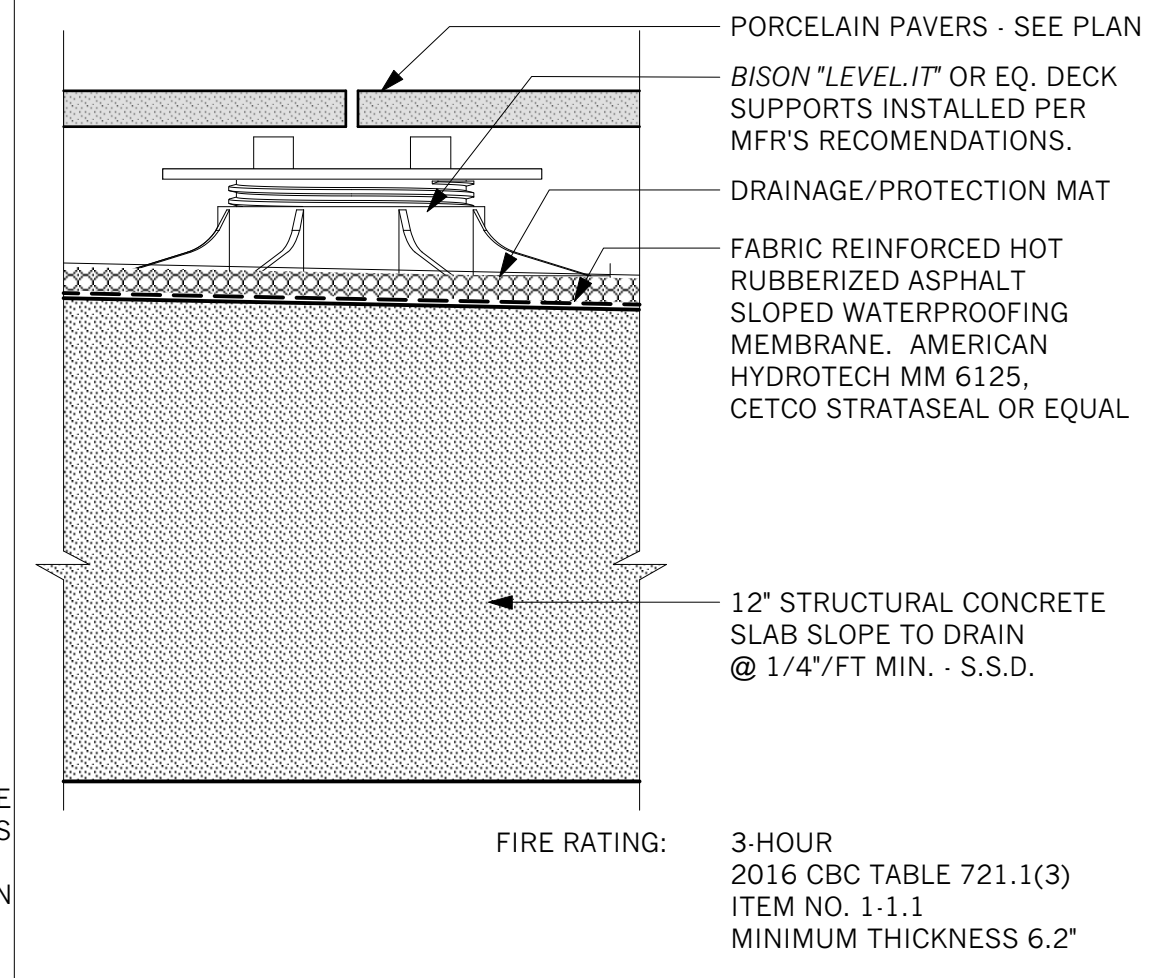


1 COURTYARD FLOOR/CEILING ASSEMBLY
Scale: 3" = 1'-0"

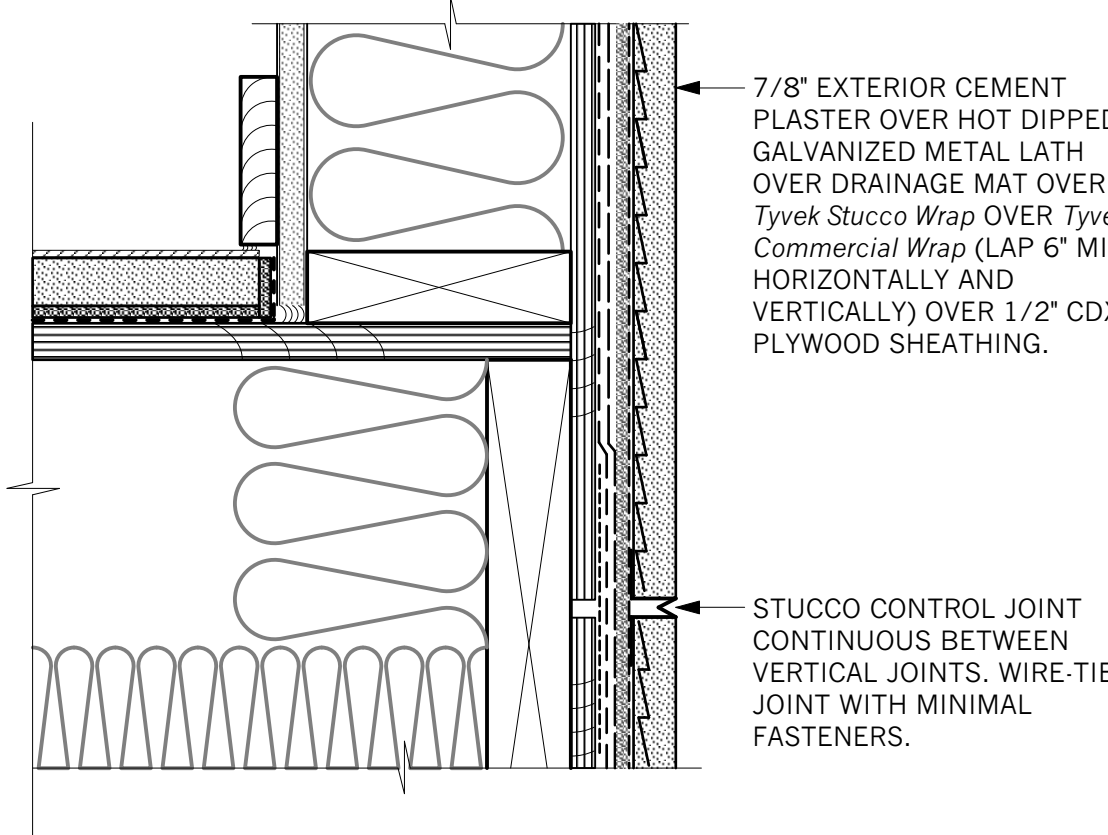


18 HORIZONTAL STUCCO CONTROL JOINT
Scale: 3" = 1'-0"

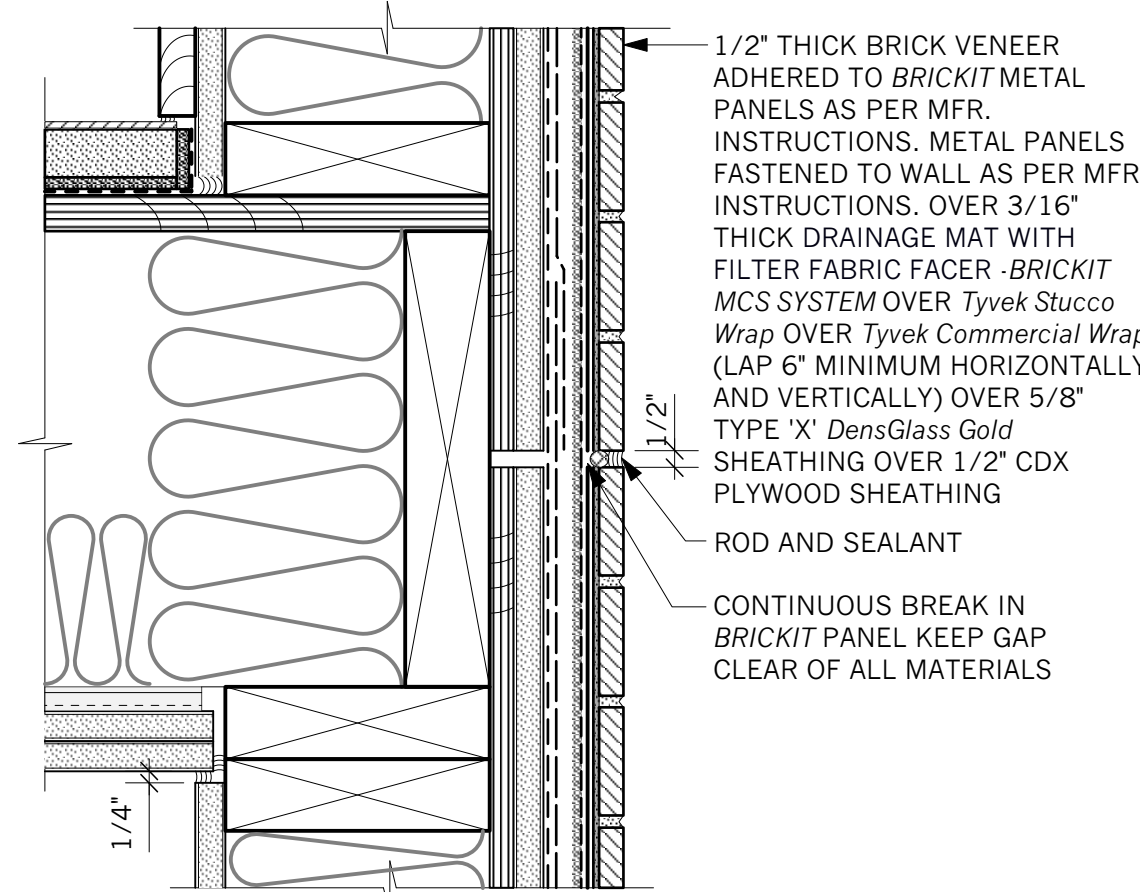


14 HORIZONTAL BRICK VENEER JOINT
Scale: 3" = 1'-0"

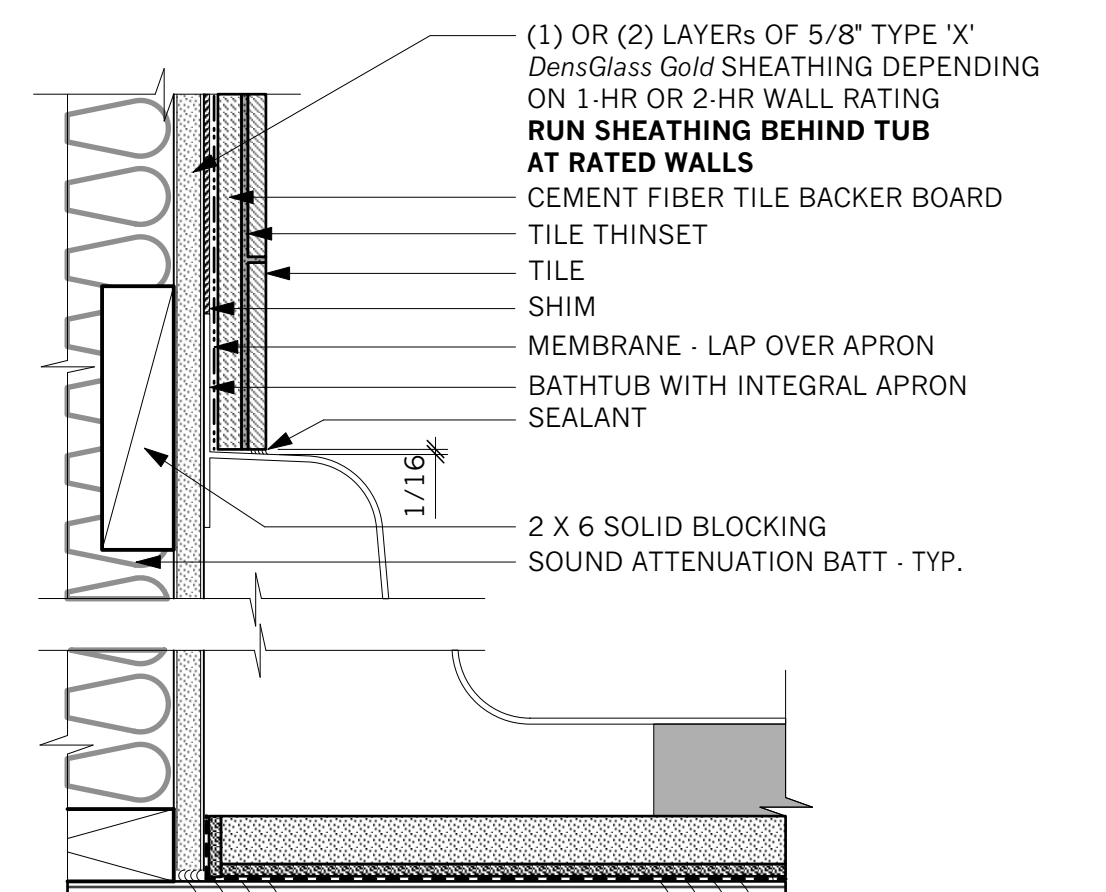


10 BATHTUB WALL
Scale: 3" = 1'-0"

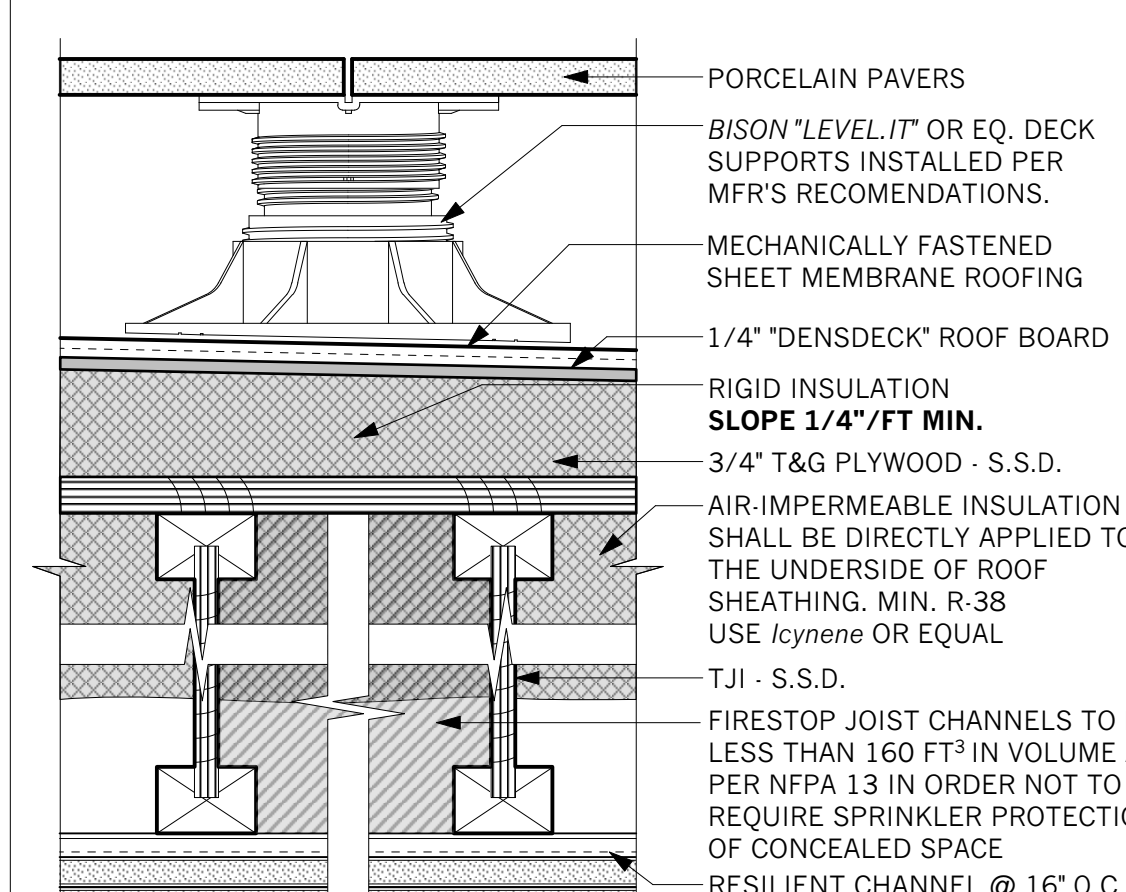


6 ROOF DECK ASSEMBLY
3" = 1'-0"

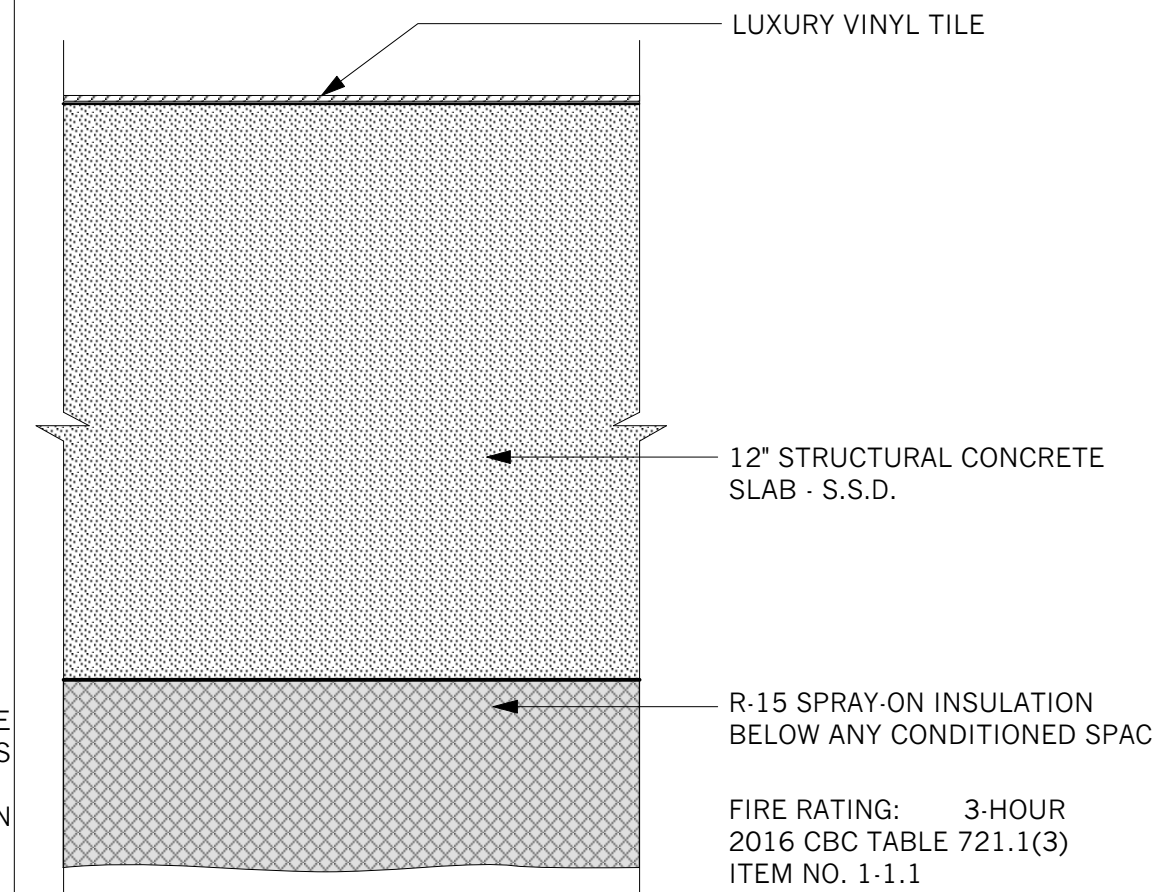


2 FLOOR CEILING ASSEMBLY - INTERIOR
Scale: 3" = 1'-0"

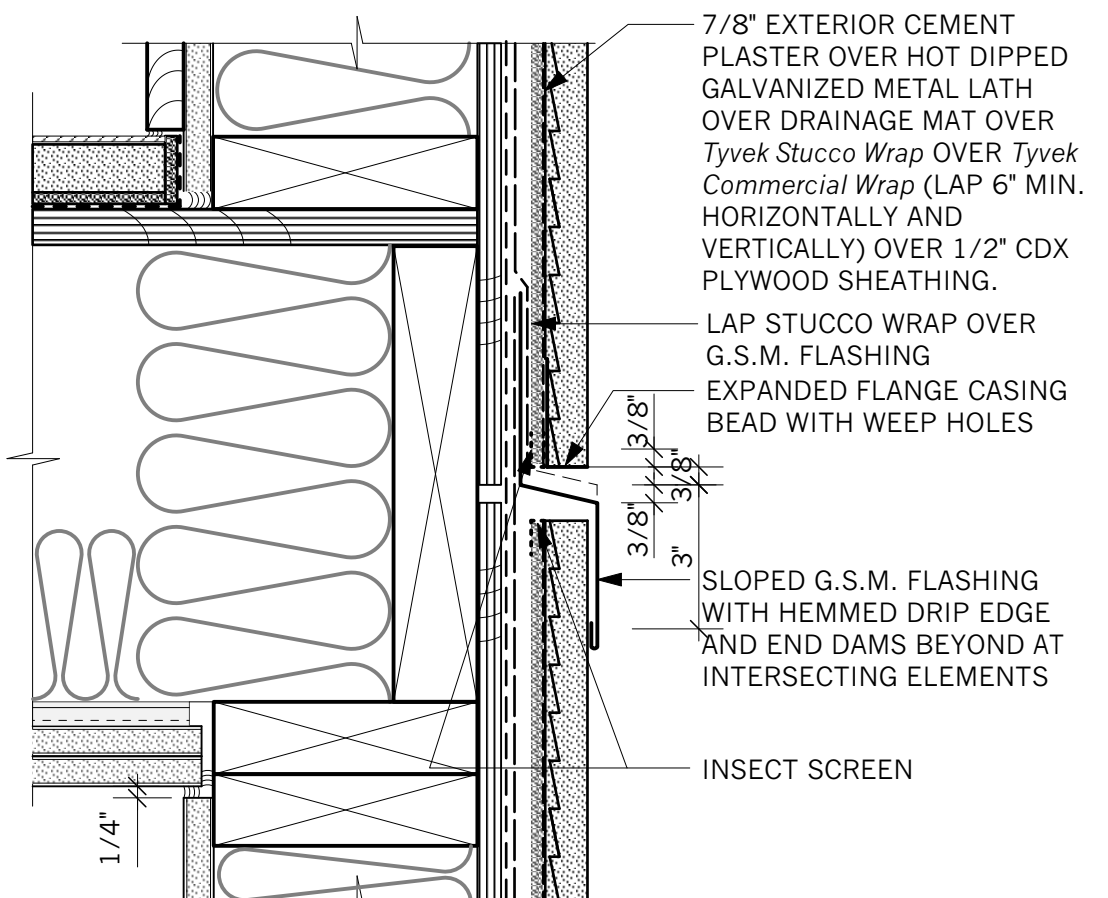


19 HORIZONTAL STUCCO EXPANSION JOINT
Scale: 3" = 1'-0"

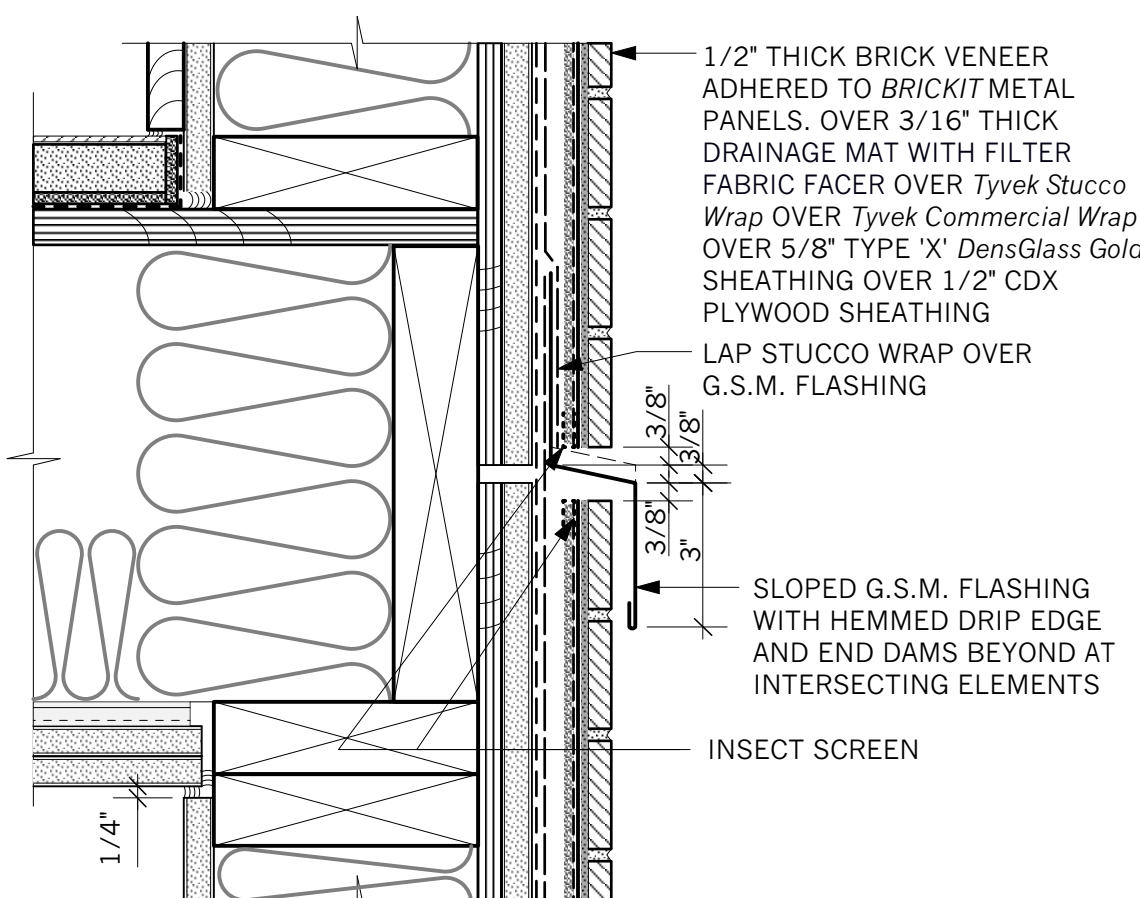


15 HORIZONTAL BRICK VENEER EXPANSION JOINT
Scale: 3" = 1'-0"

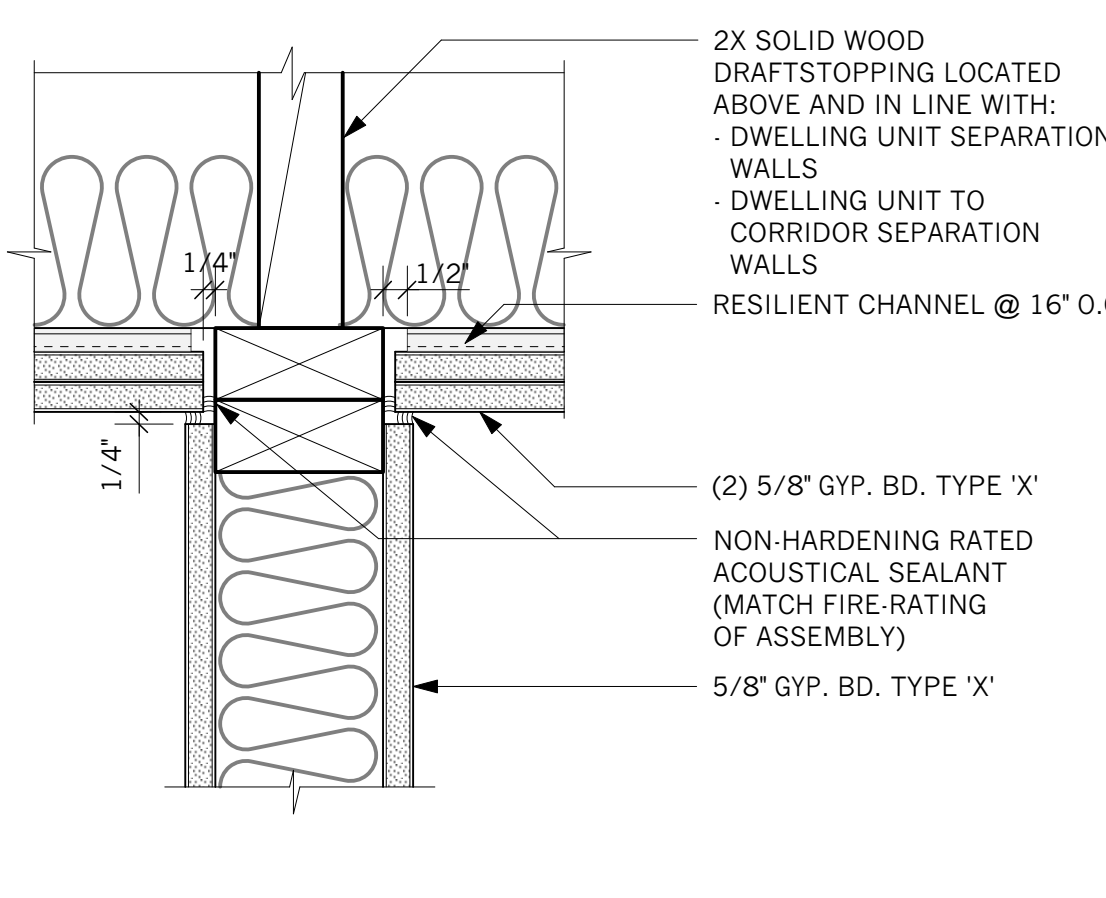


11 TYP. WALL/CEILING INTERSECTION
Scale: 3" = 1'-0"

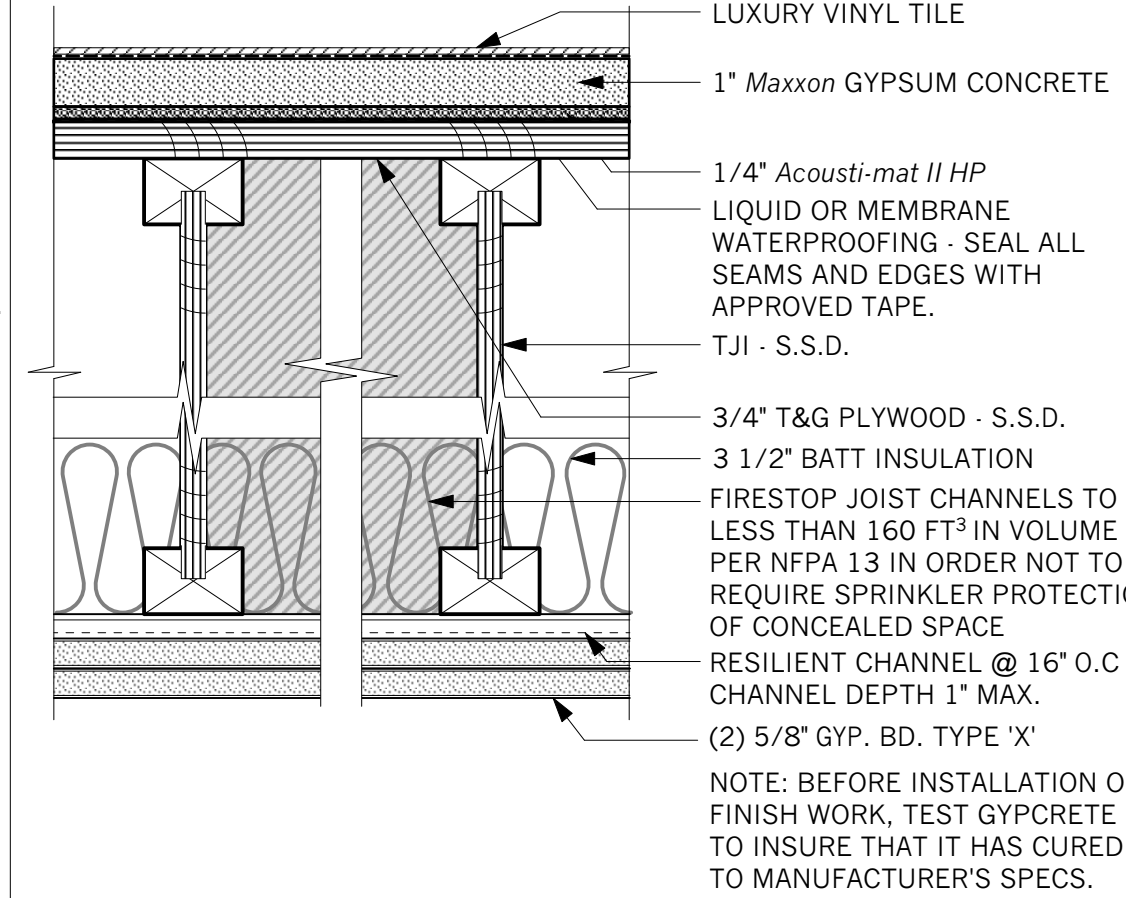


7 FLOOR CEILING ASSEMBLY - 1-HOUR RATED
Scale: 3" = 1'-0"

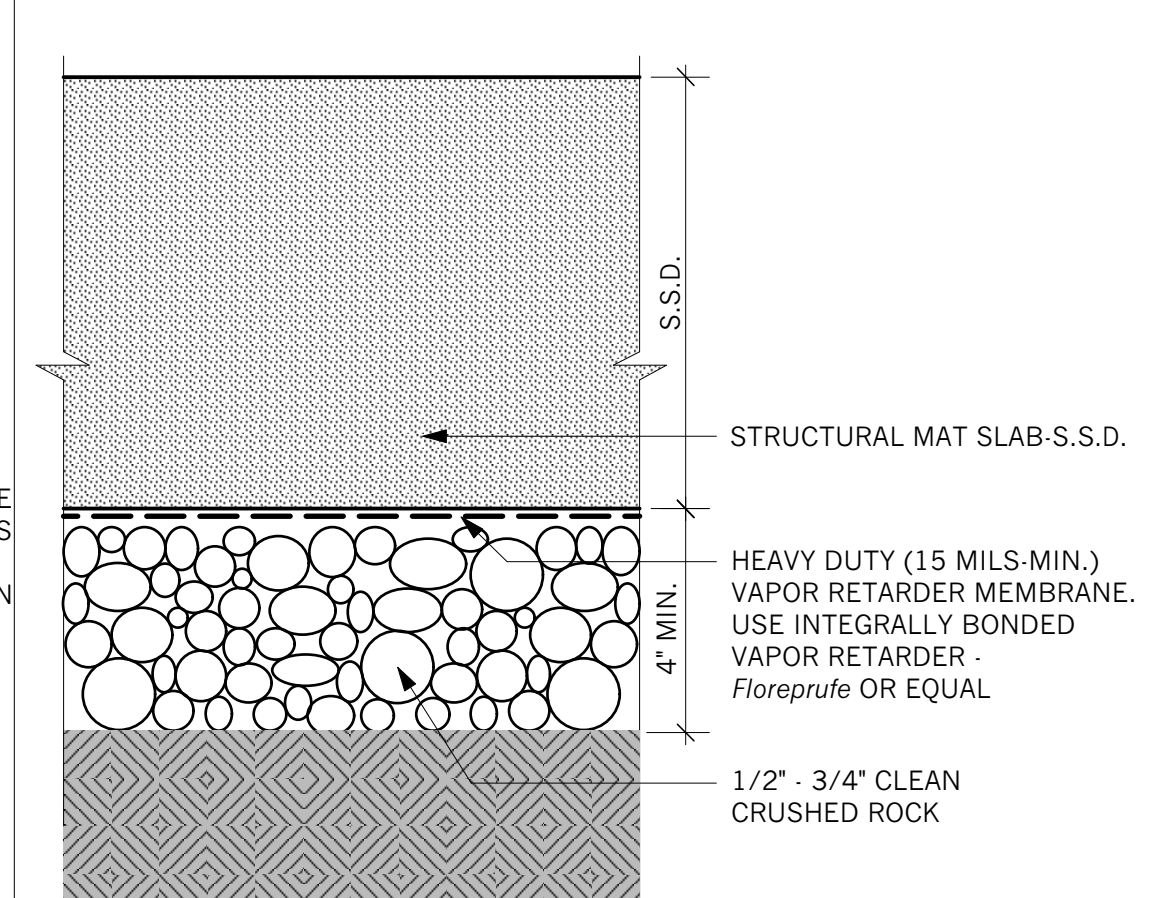


3 FIRST FLOOR SLAB
3" = 1'-0"

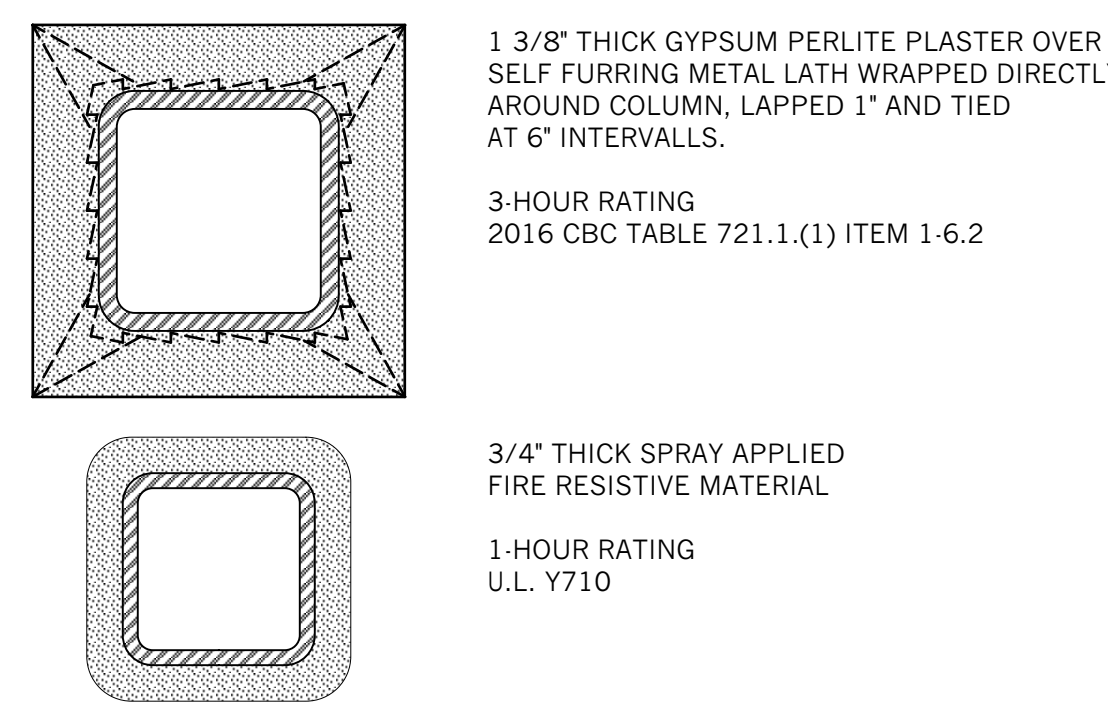


20 FIRE PROTECTION OF STRUCTURAL MEMBERS
Scale: 3" = 1'-0"

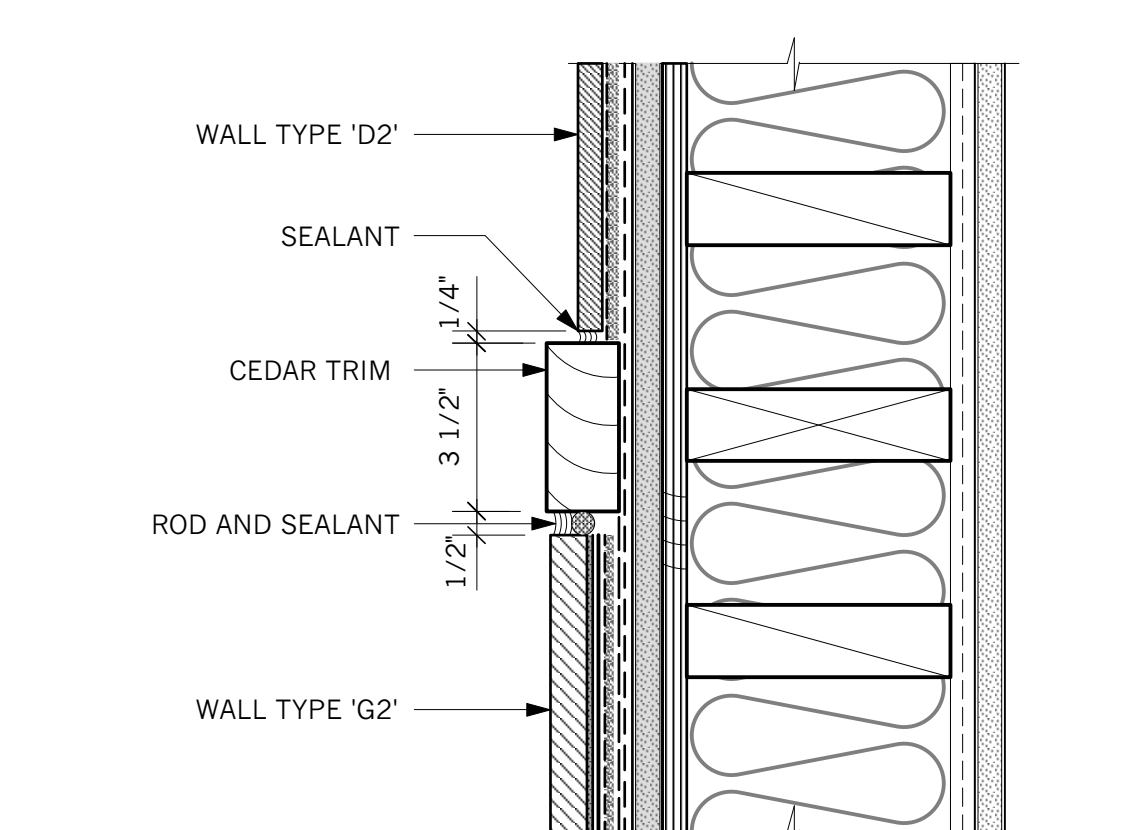


16 PLAN SECTION: BRICK/SIDING TRANSITION
3" = 1'-0"

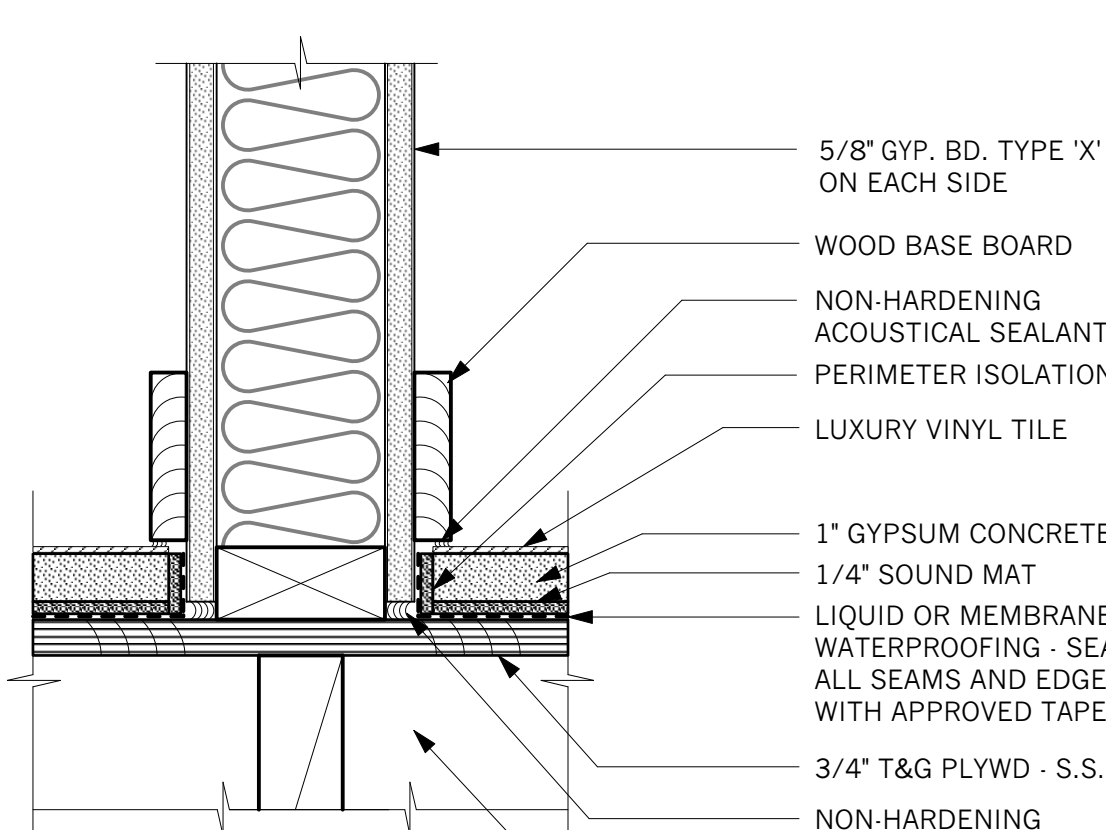

12 TYP. WALL/FLOOR INTERSECTION
Scale: 3" = 1'-0"

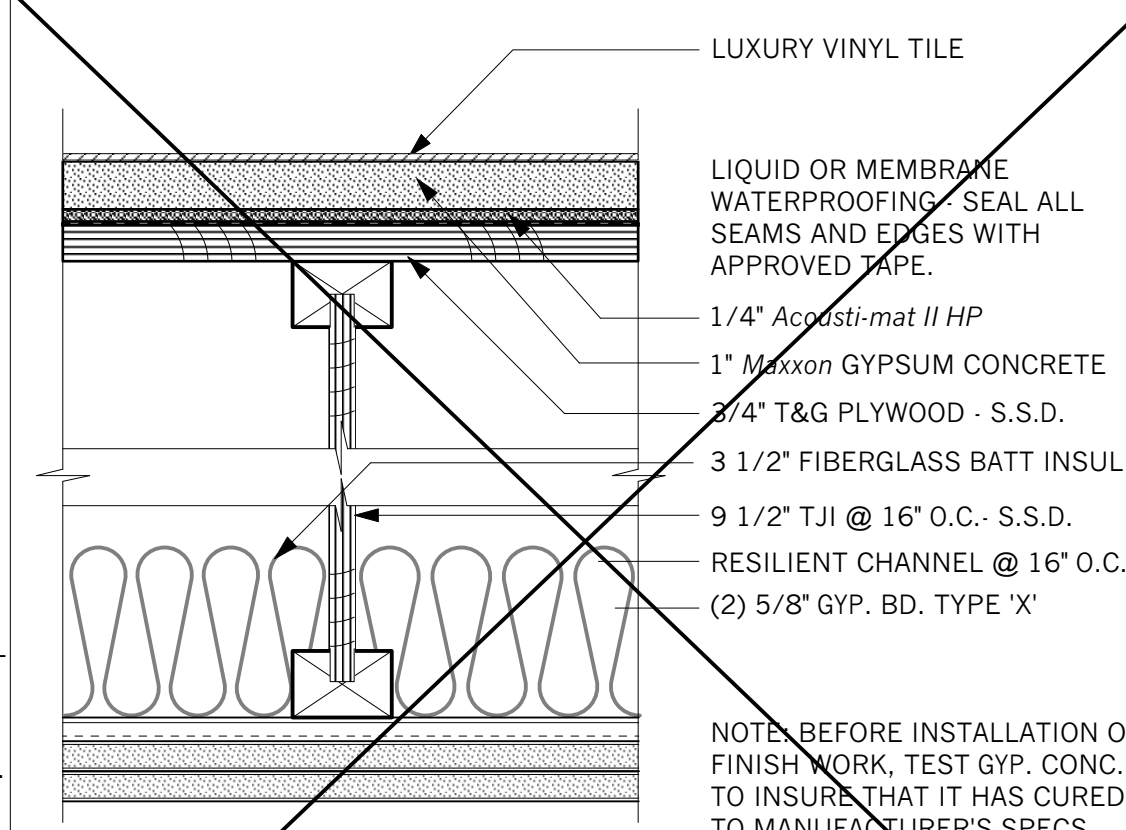

8 FLOOR/CEILING ASSEMBLY - 1-HOUR RATED
3" = 1'-0"

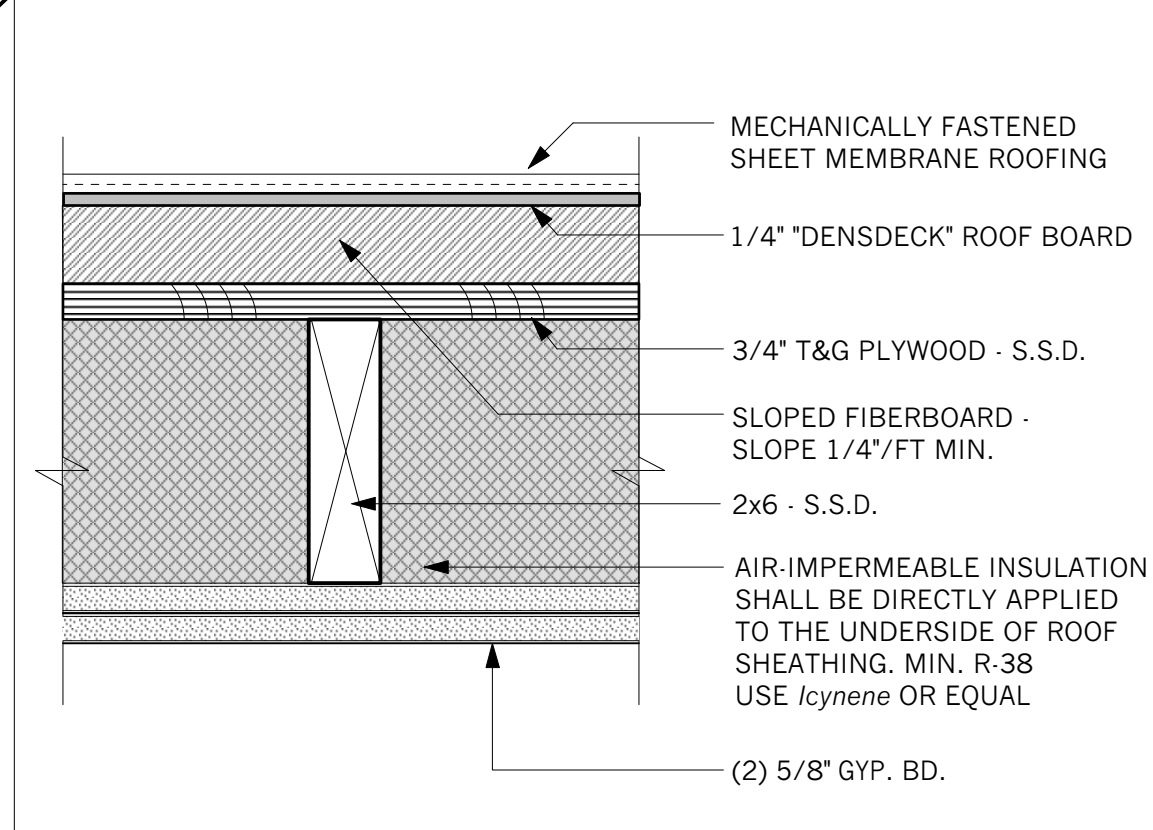

4 PENTHOUSE ROOF ASSEMBLY - 1-HOUR RATED
3" = 1'-0"



ELEVATIONarchitects
1159 Green Street, Suite 4
San Francisco, CA 94109
415.537.1125 v
www.elevationarchitects.com w



agency stamps:


Condominiums
42 Otis Street
San Francisco, CA 94103
Block / Lot : 3503 / 020

#	date	issue
2	4.15.20	Project Revision 2
3	4.27.20	Plan Check Response 2
4	8.17.20	Plan Check Response 3


sheet count 41/49

Floor/Ceiling Assemblies


project: 16.15
drawn by: mka
checked by: jp
date: 08.13.20
scale:

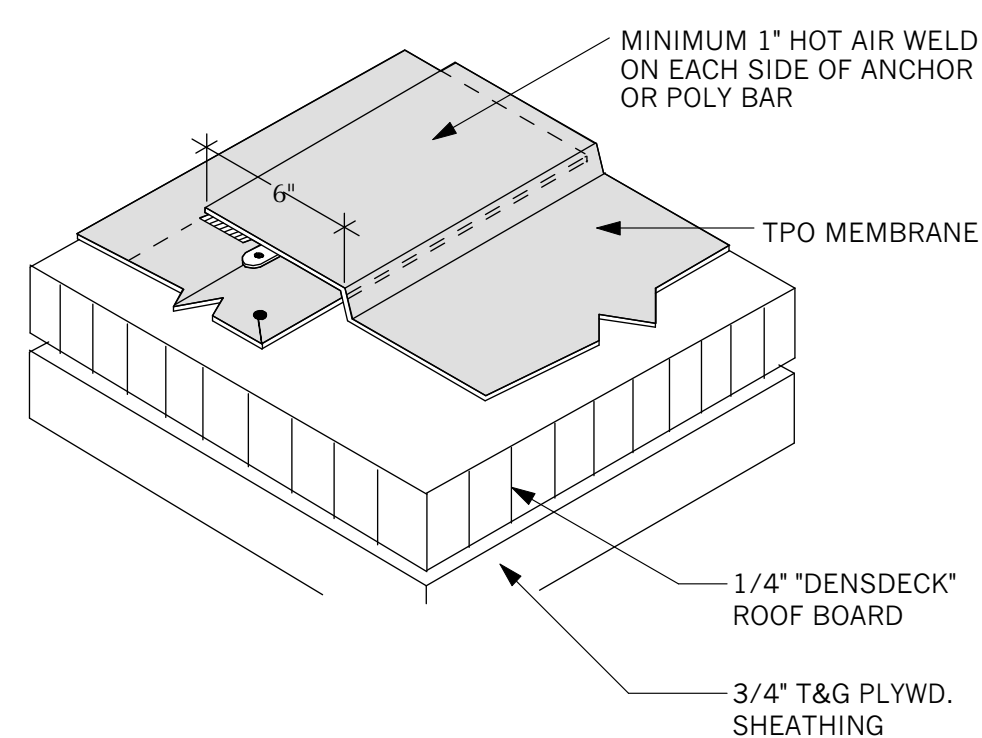


17 MECHANICALLY ATTACHED SEAM W/ SINGLE WELD

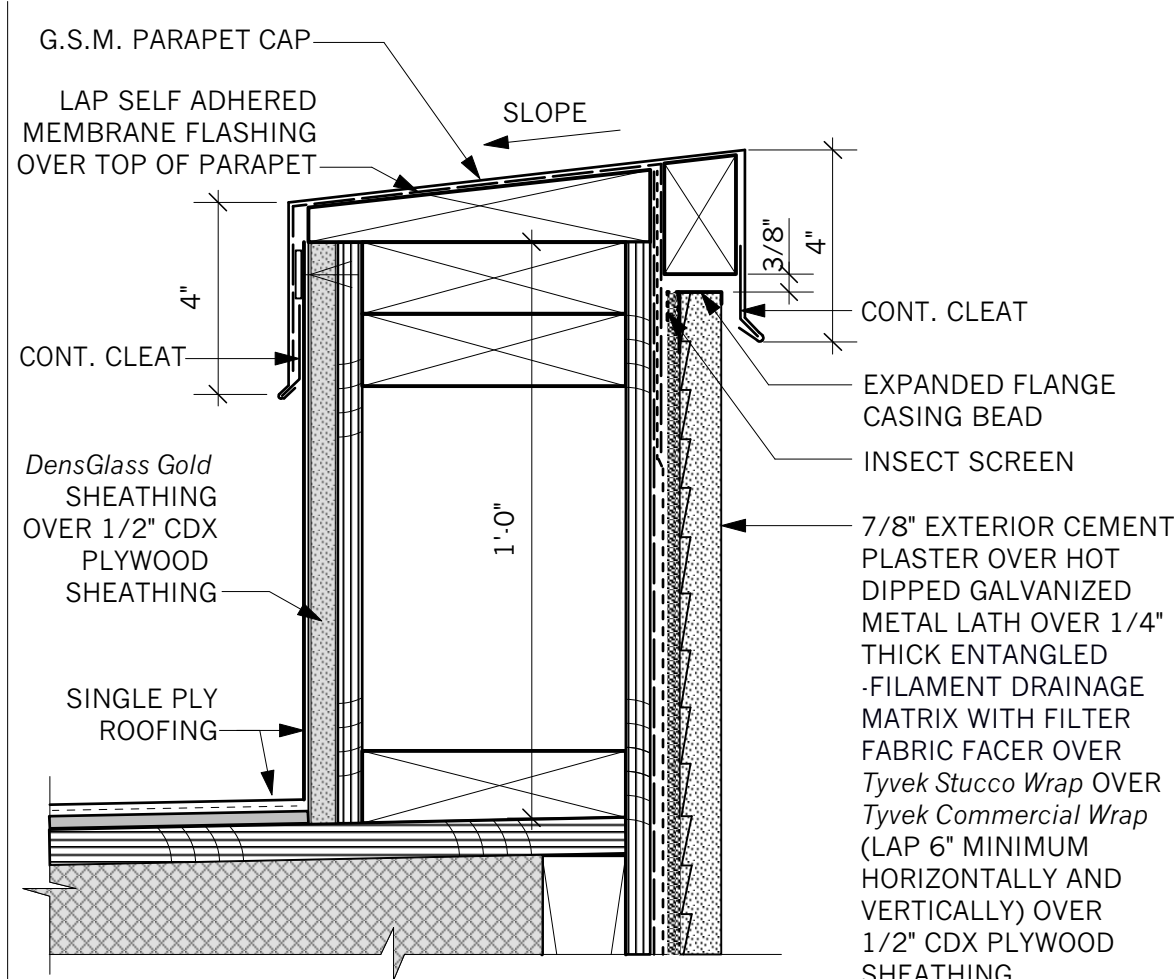


11 SECTION: PARAPET @ PENTHOUSE
Scale: 3" = 1'-0"

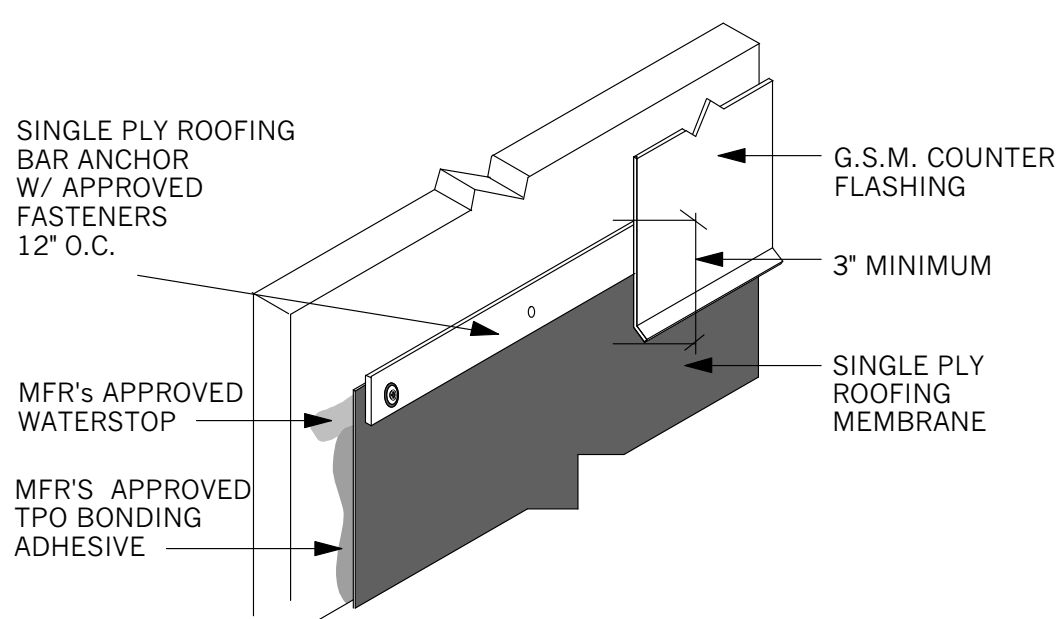


18 VERTICAL ATTACHMENT
not to scale

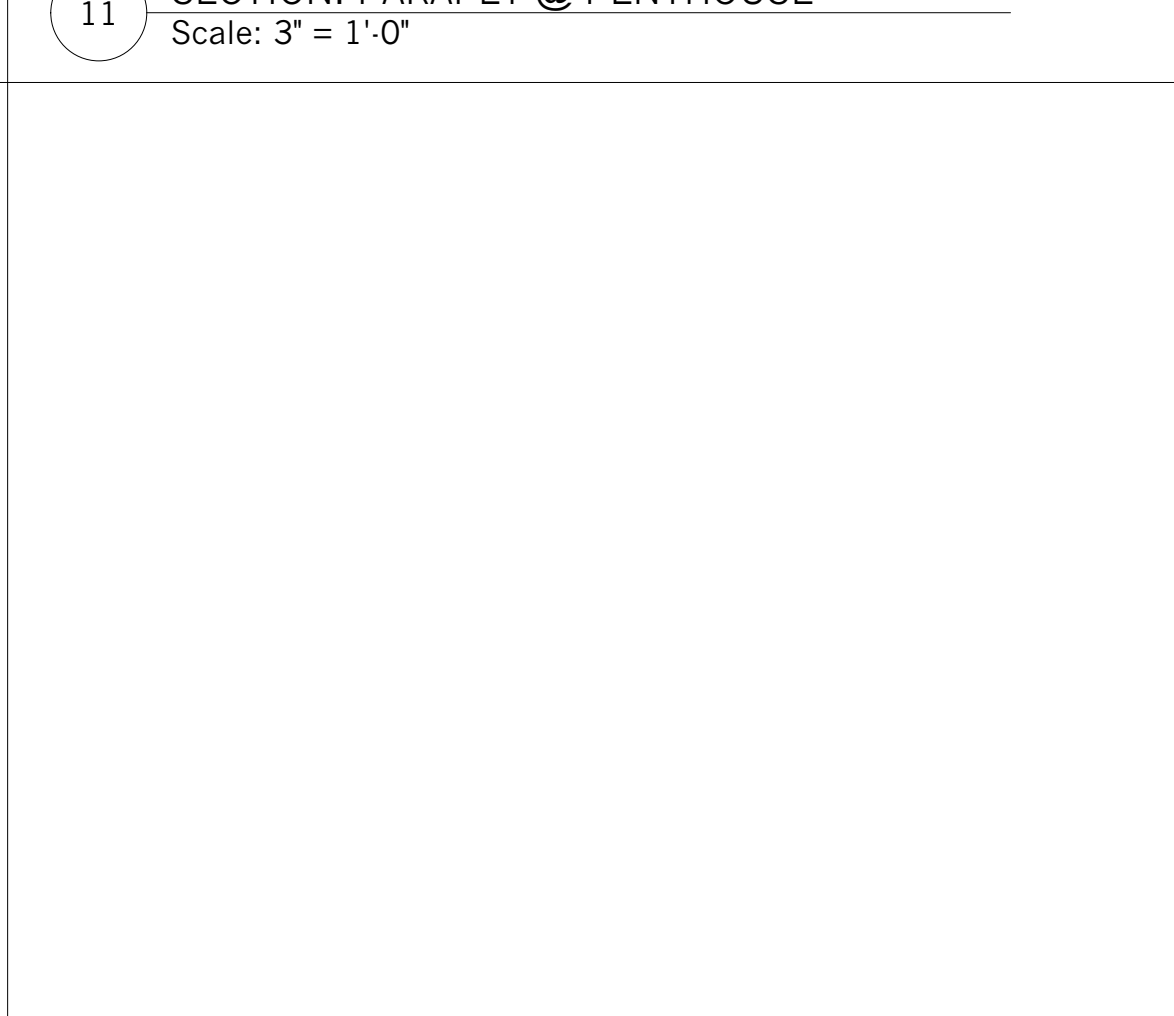


9 HEAD AND SILL AT ALUMINUM STOREFRONT
Scale: 3" = 1'-0"

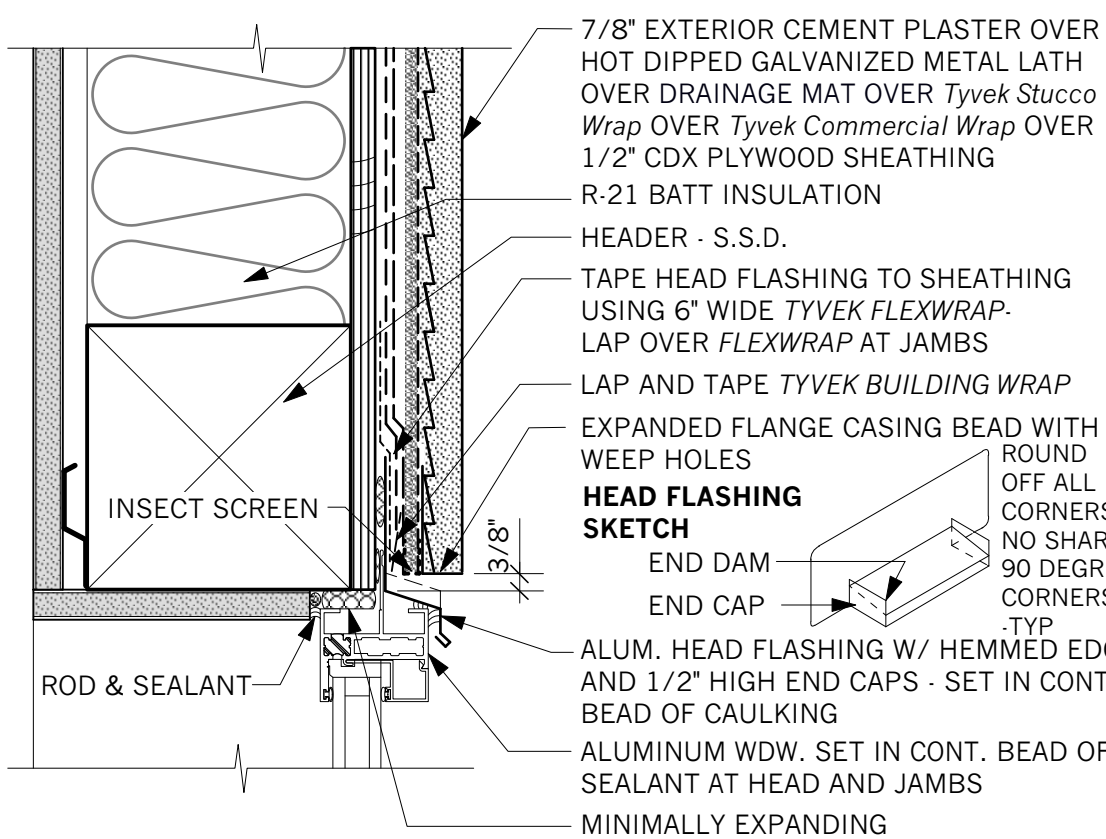


5 WINDOW HEAD AT STUCCO
Scale: 3" = 1'-0"

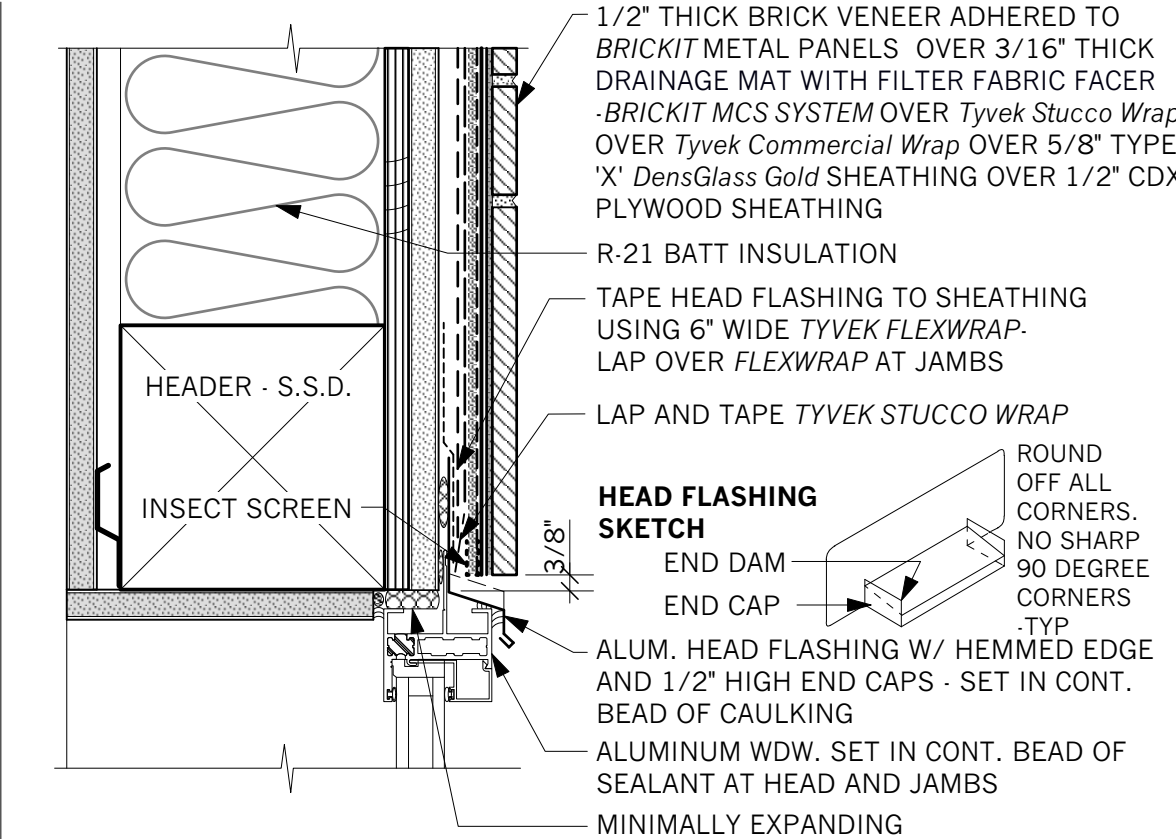


1 WINDOW HEAD AT BRICK VENEER
Scale: 3" = 1'-0"

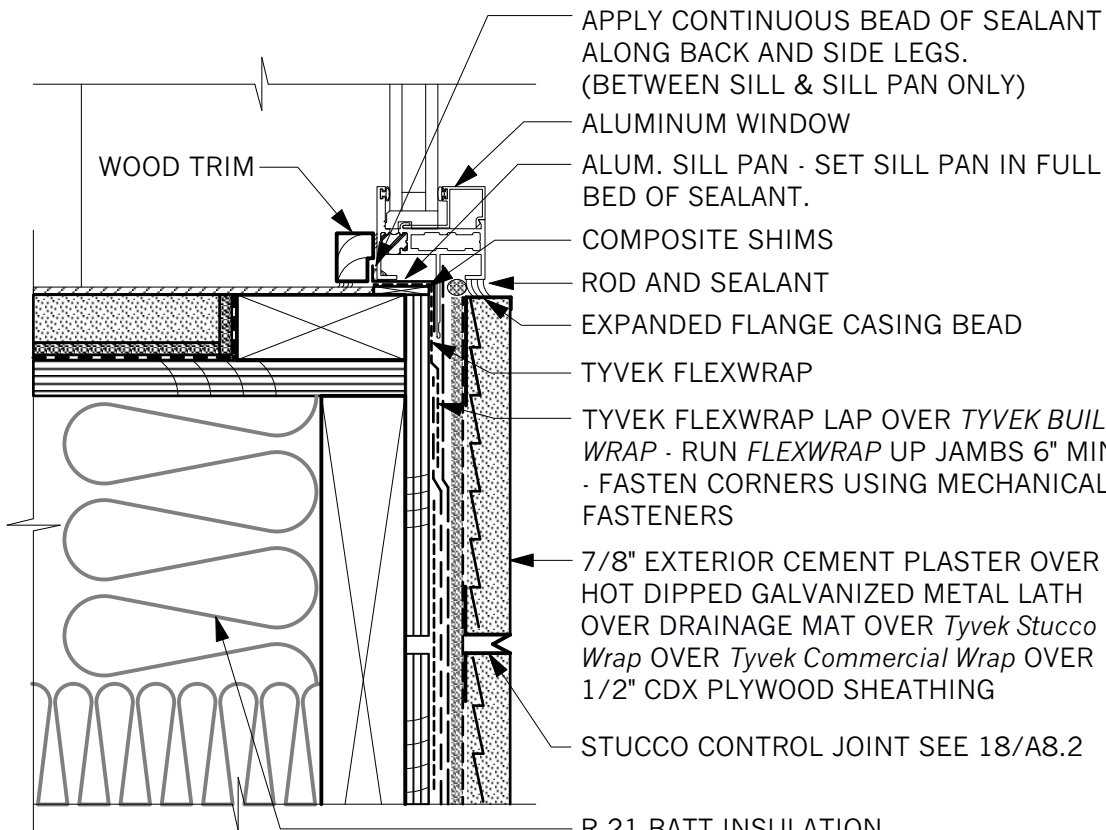


6 WINDOW SILL AT STUCCO
Scale: 3" = 1'-0"

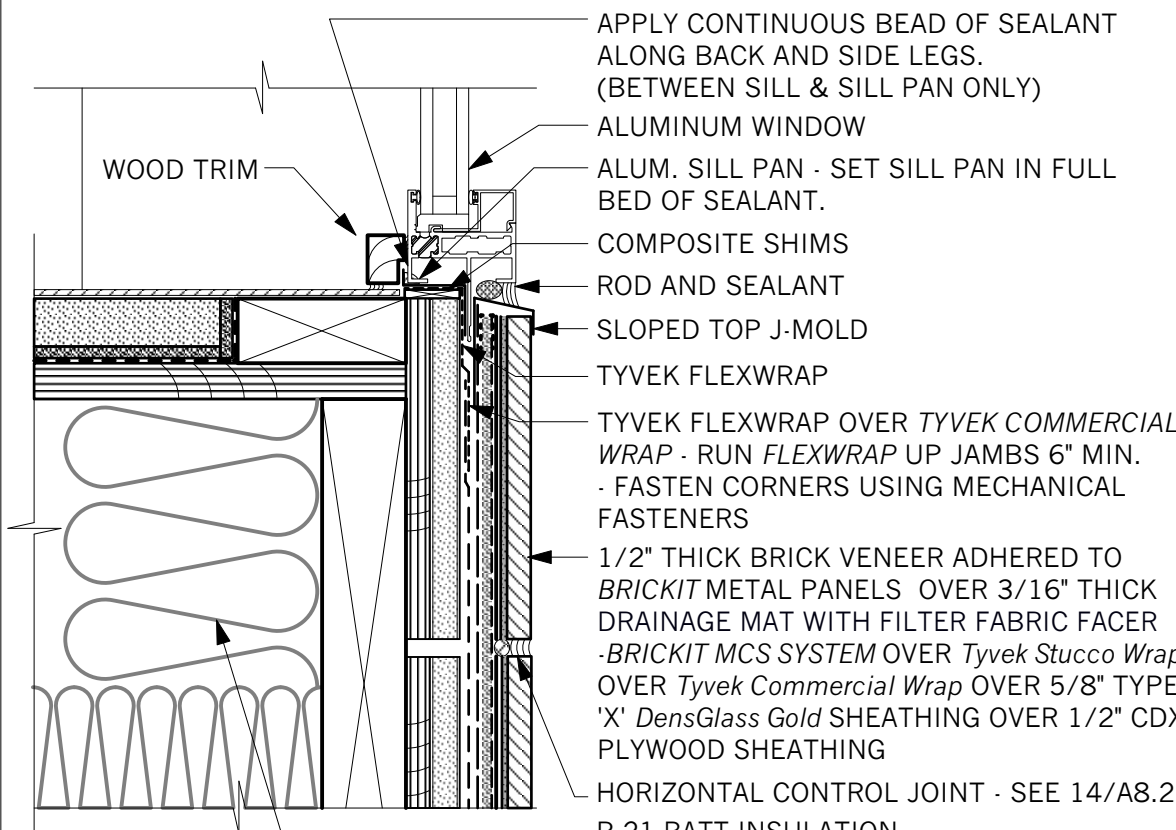


2 WINDOW SILL AT BRICK VENEER
Scale: 3" = 1'-0"

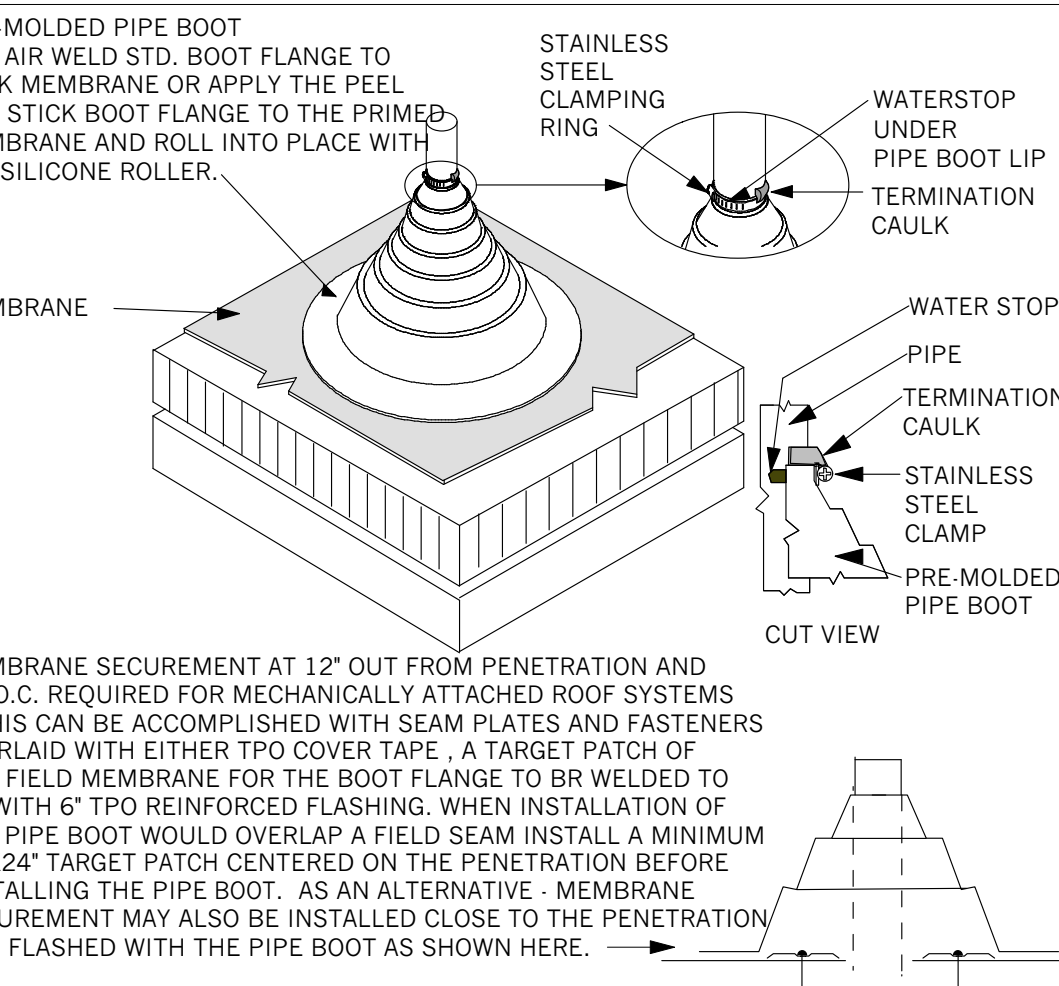


19 PRE-FABRICATED PIPE BOOT
not to scale

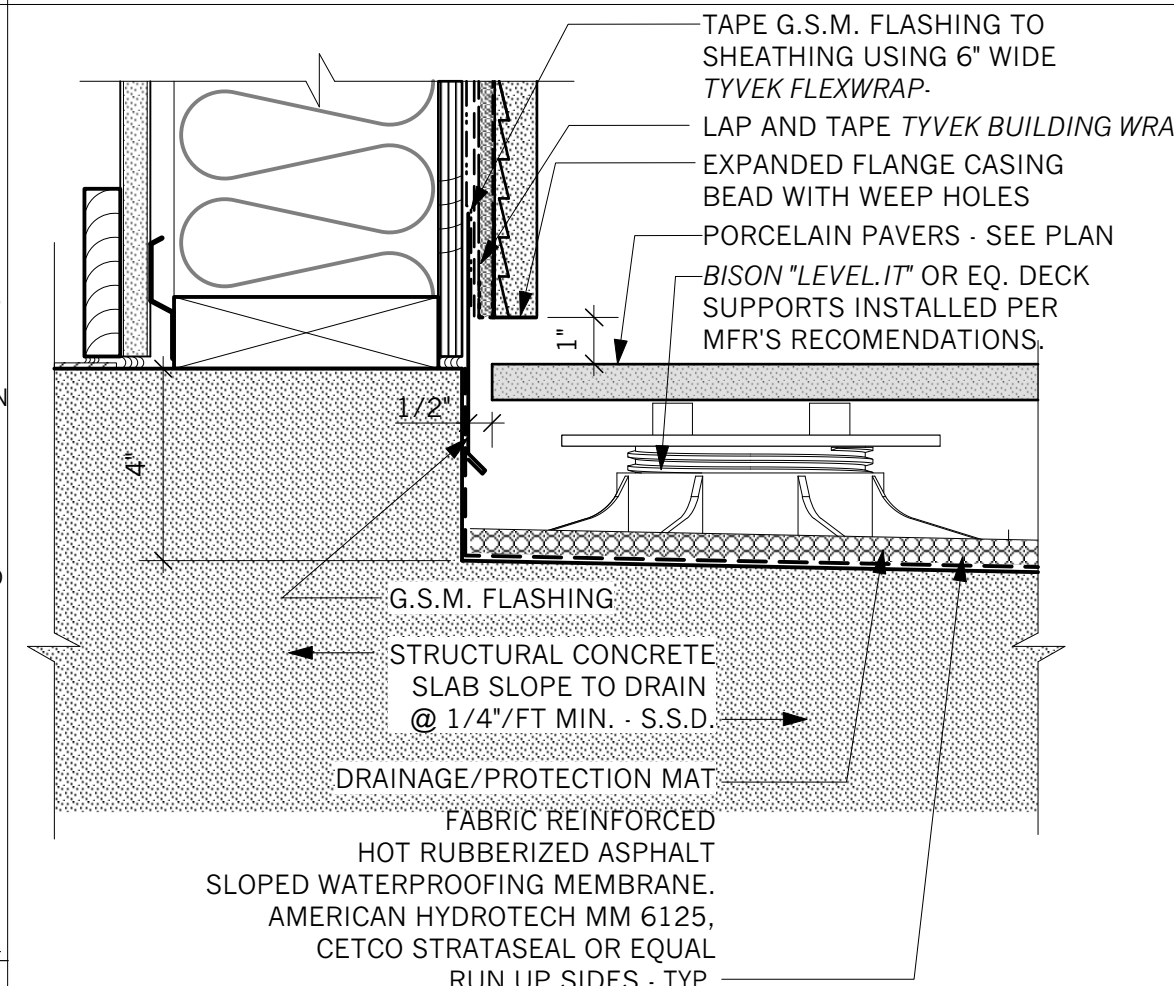


13 WALL AT COURTYARD
Scale: 3" = 1'-0"

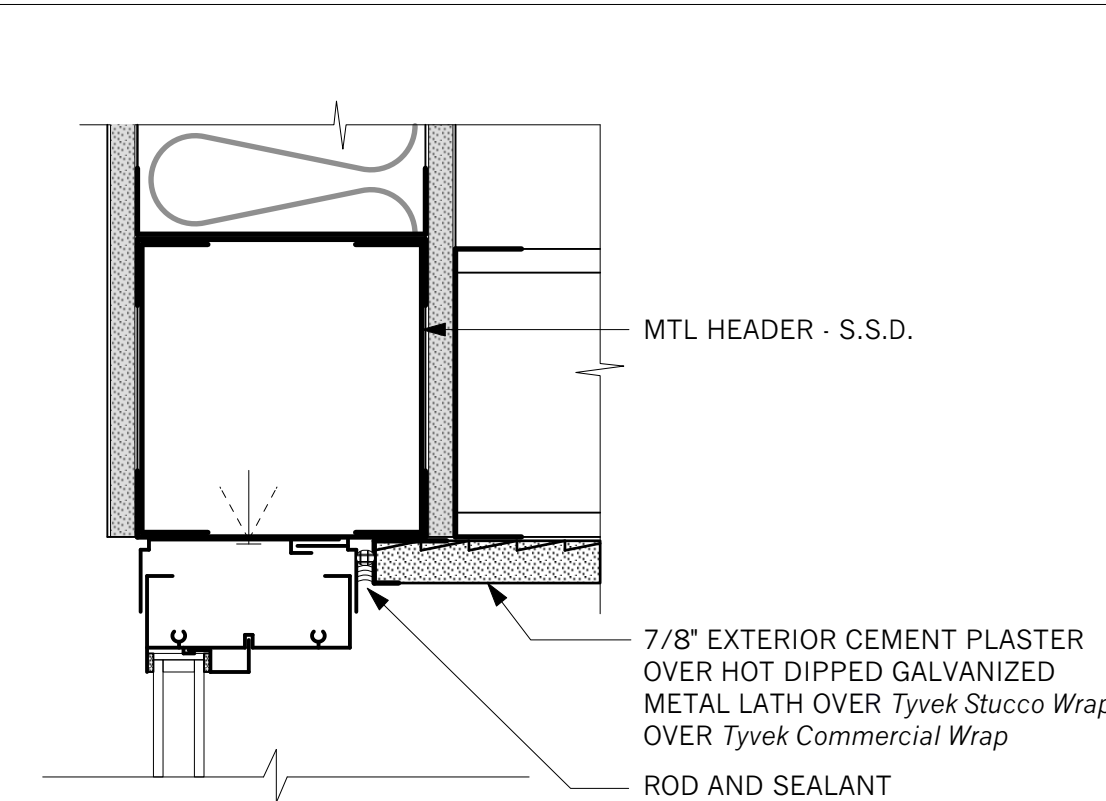


10 THRESHOLD & HEAD @ ALUMINUM STOREFRONT
Scale: 3" = 1'-0"

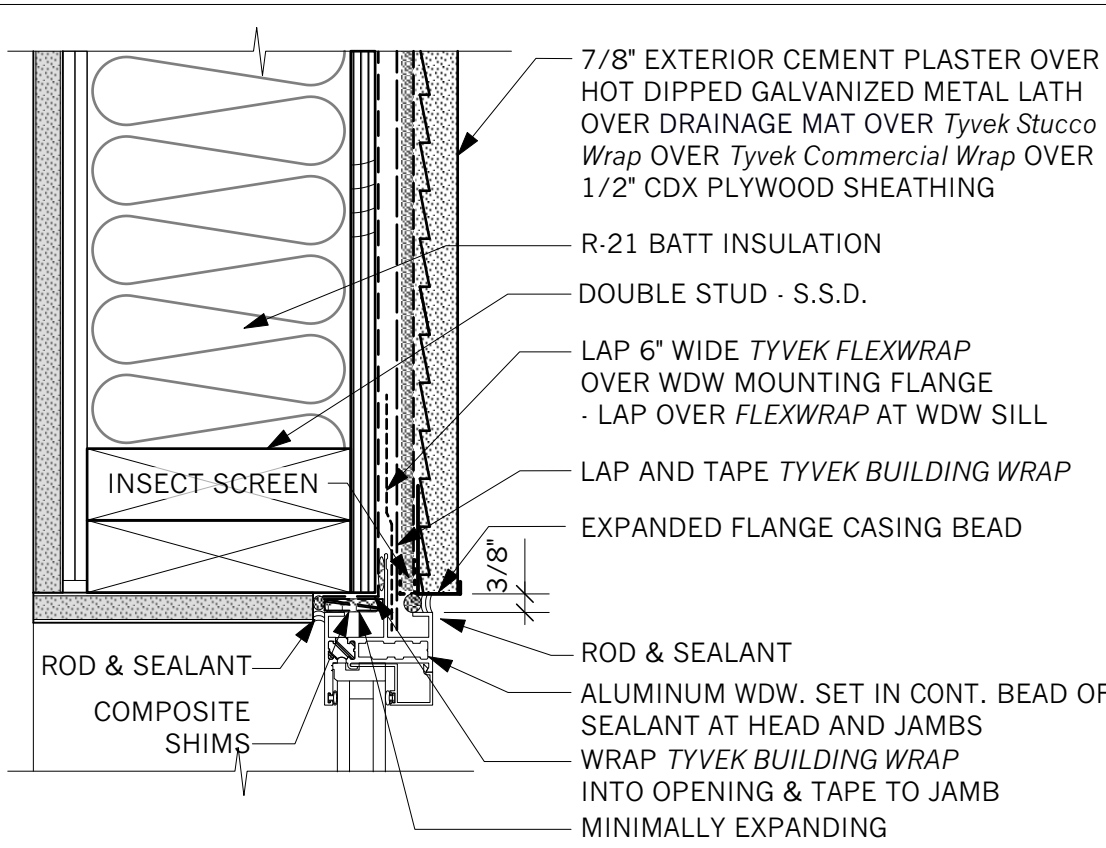


7 WINDOW JAMB AT STUCCO
Scale: 3" = 1'-0"

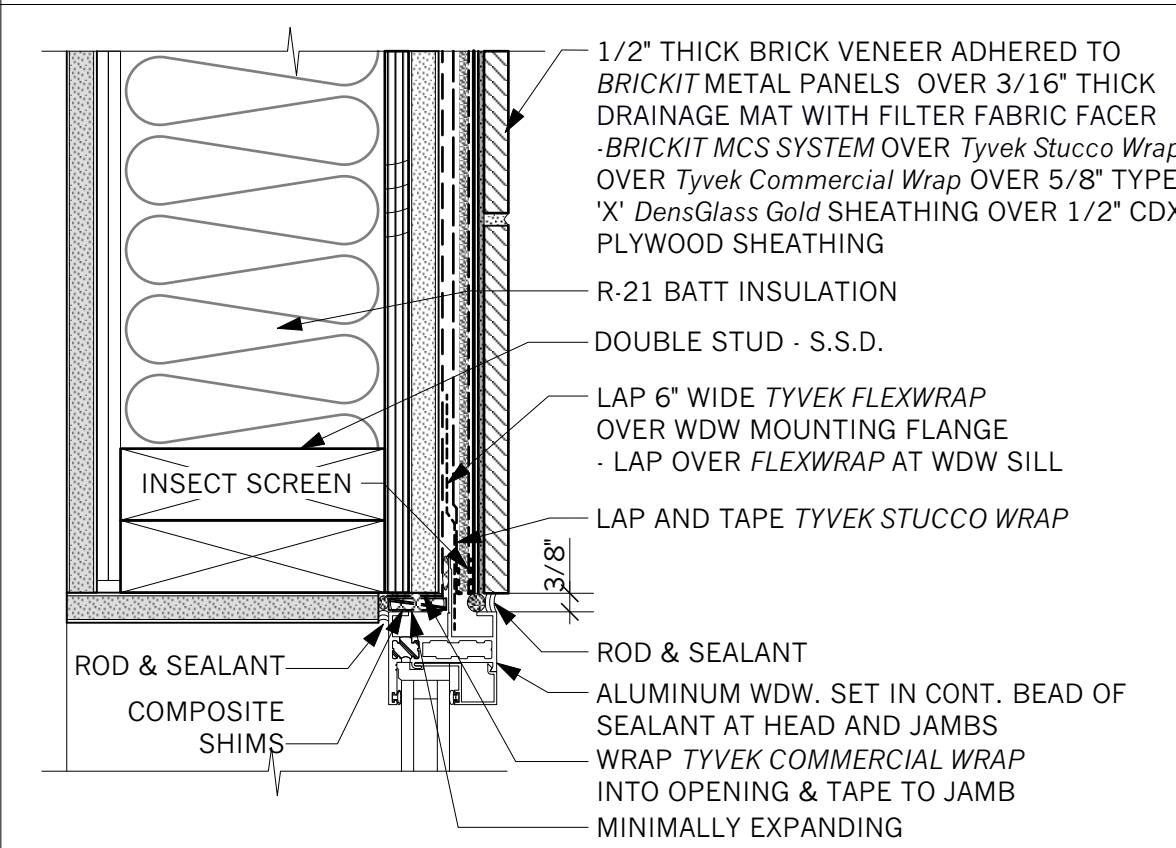


3 WINDOW JAMB AT BRICK VENEER
Scale: 3" = 1'-0"

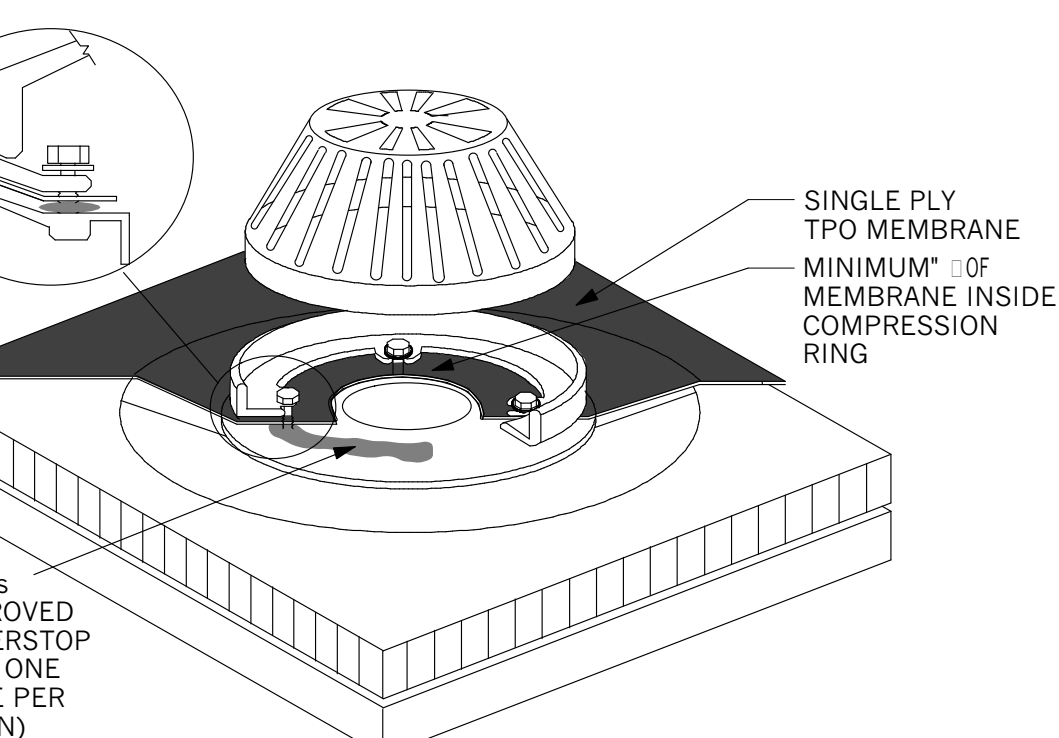


20 ROOF DRAINS
not to scale

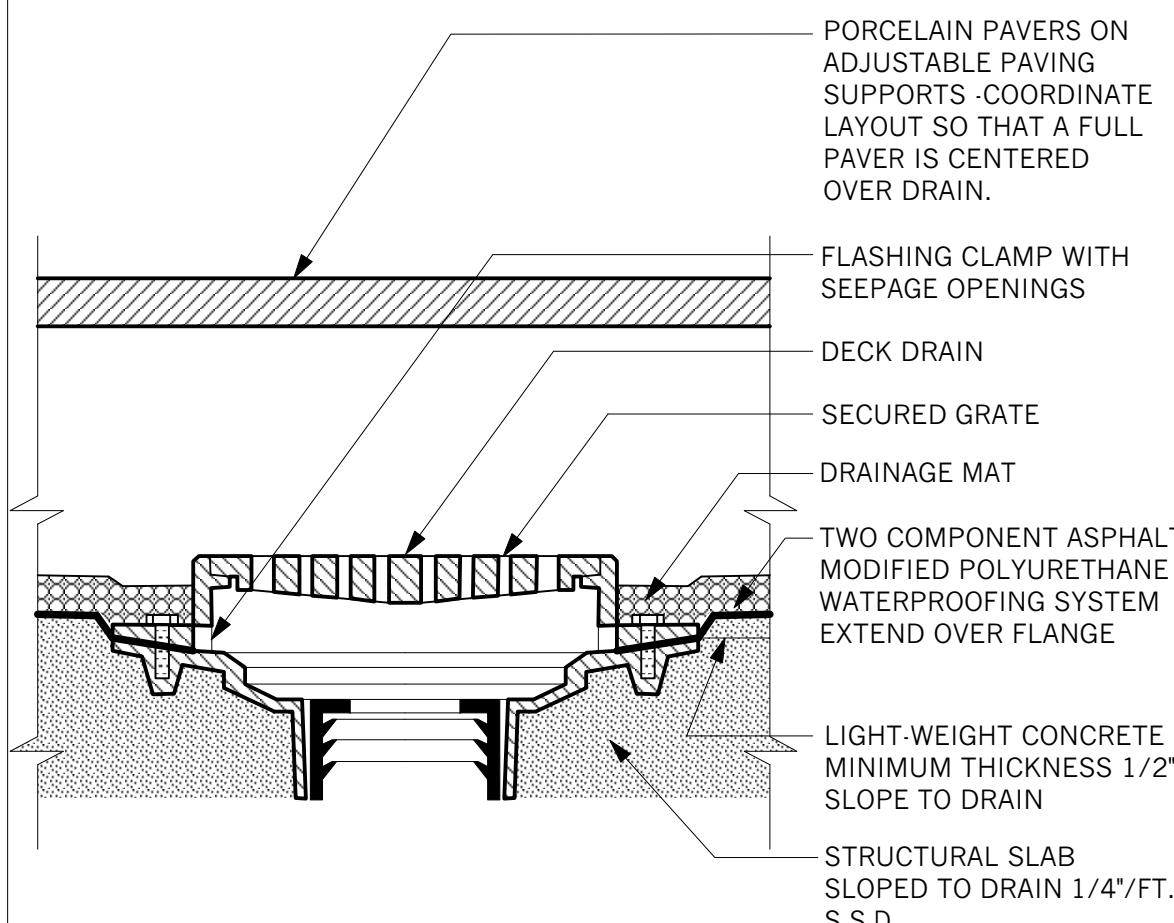

14 TYP. DECK DRAIN
Scale: 3" = 1'-0"

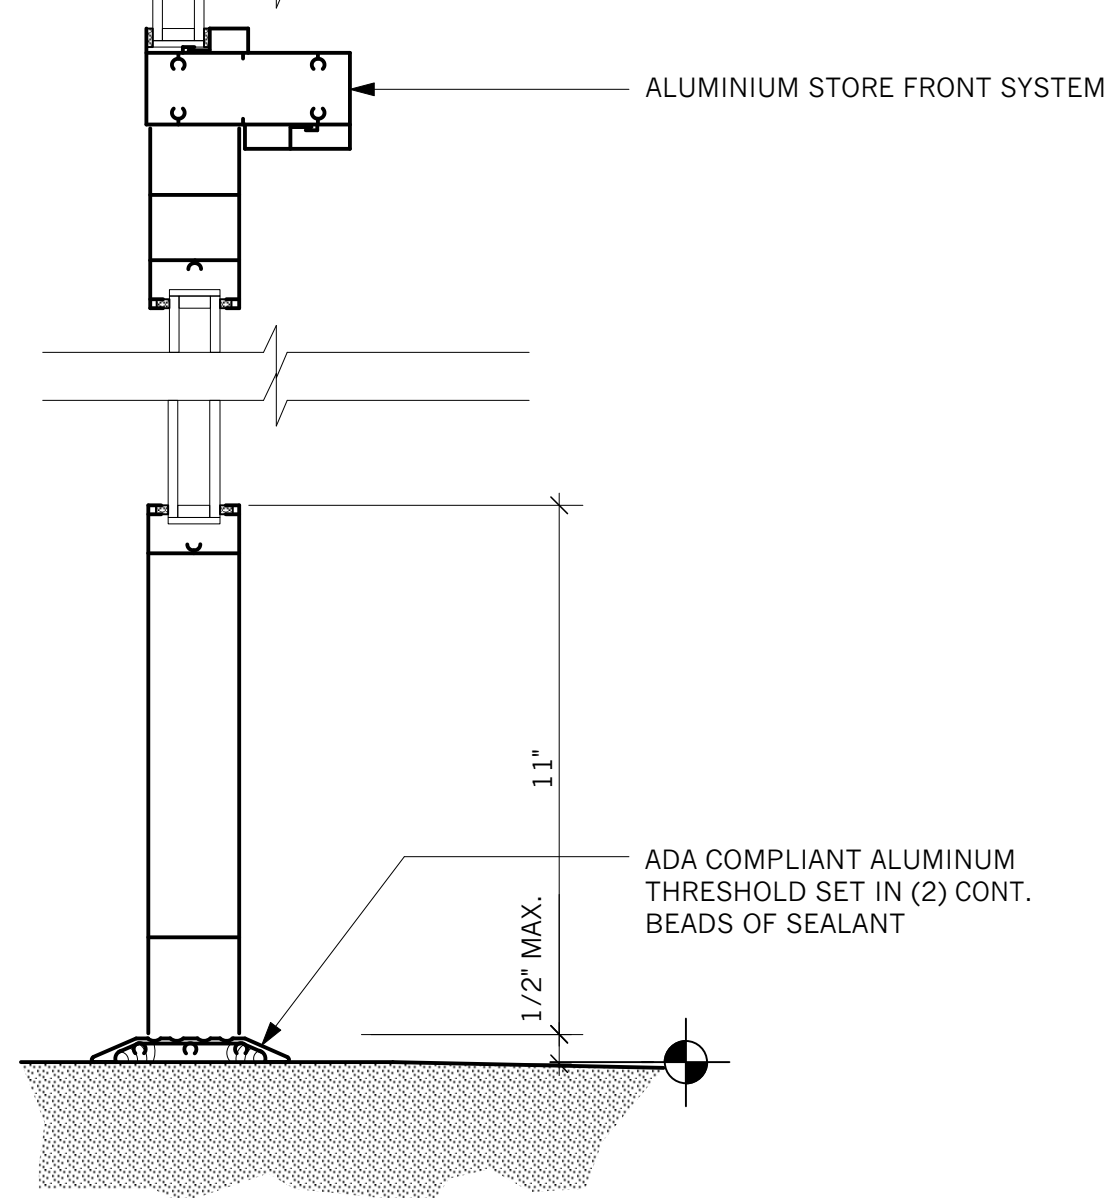

8 SLIDING DOOR THRESHOLD AT COURTYARD
Scale: 3" = 1'-0"

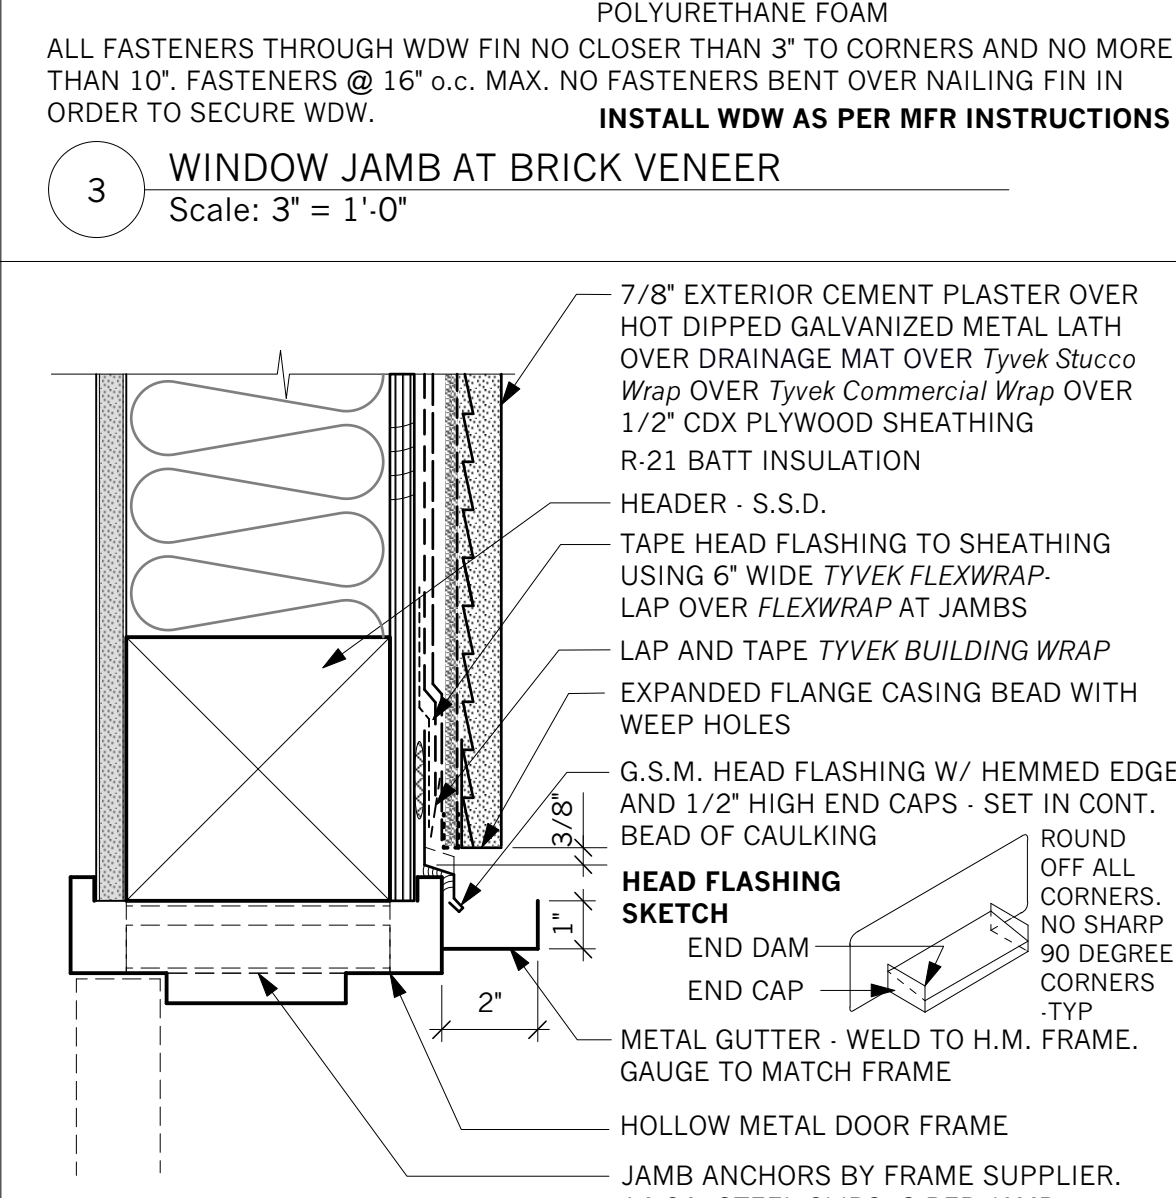

4 EXTERIOR H.M. DOOR FRAME HEAD - JAMB SIM.
Scale: 3" = 1'-0"

ELEVATIONarchitects
1159 Green Street, Suite 4
San Francisco, CA 94109
415.537.1125
www.elevationarchitects.com

LICENSED ARCHITECT
JOHNATHAN PEARLMAN
No C 26034
REN 06/30/21
STATE OF CALIFORNIA

agency stamps:

Condominiums
42 Otis Street
San Francisco, CA 94103
Block / Lot : 3503 / 020


#	date	issue
2	4.15.20	Project Revision 2
3	4.27.20	Plan Check Response 2
4	8.17.20	Plan Check Response 3

sheet count 42/49

Details


project: 16.15
drawn by: mka
checked by: jp
date: 08.13.20
scale:

A-8.3

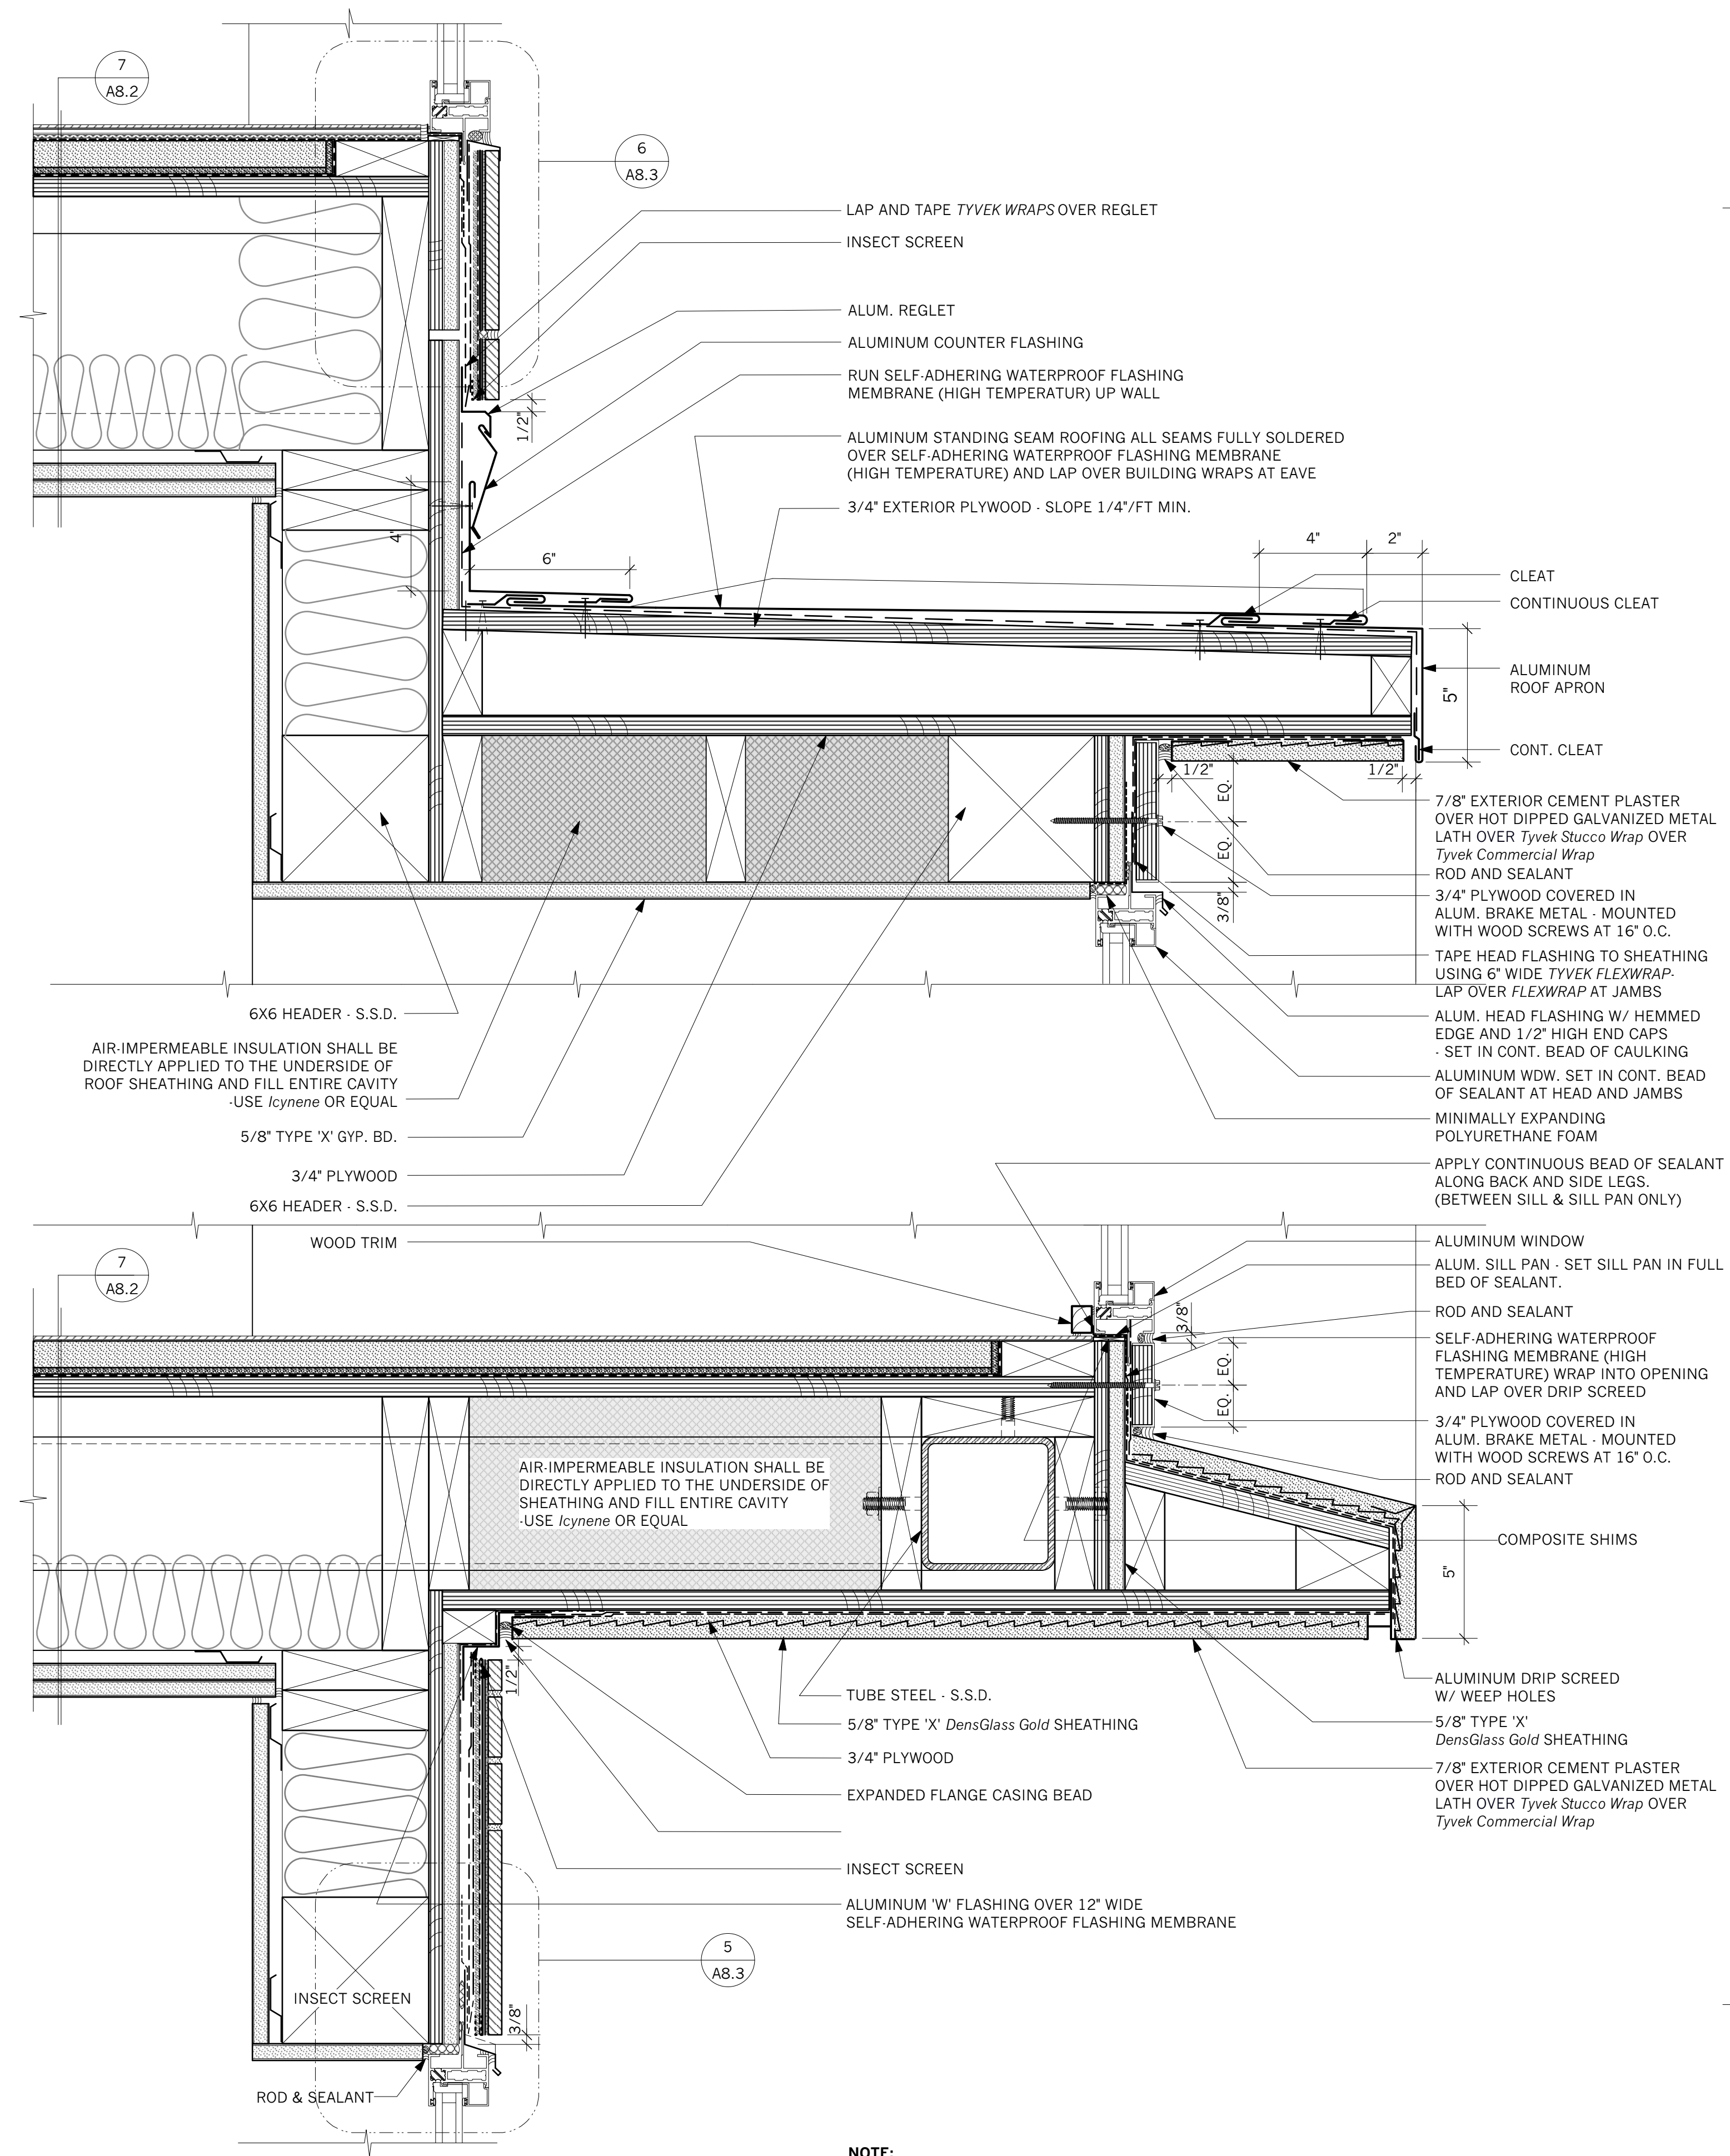

2 SECTION: BAY WINDOW HEAD AND SILL
Scale: 3" = 1'-0"

NOTE:
ALL FASTENERS THROUGH WDW FIN NO CLOSER THAN 3" TO CORNERS AND NO MORE THAN 10". FASTENERS @ 16" o.c. MAX. NO FASTENERS BENT OVER NAILING FIN IN ORDER TO SECURE WDW.
INSTALL WDW AS PER MFR INSTRUCTIONS

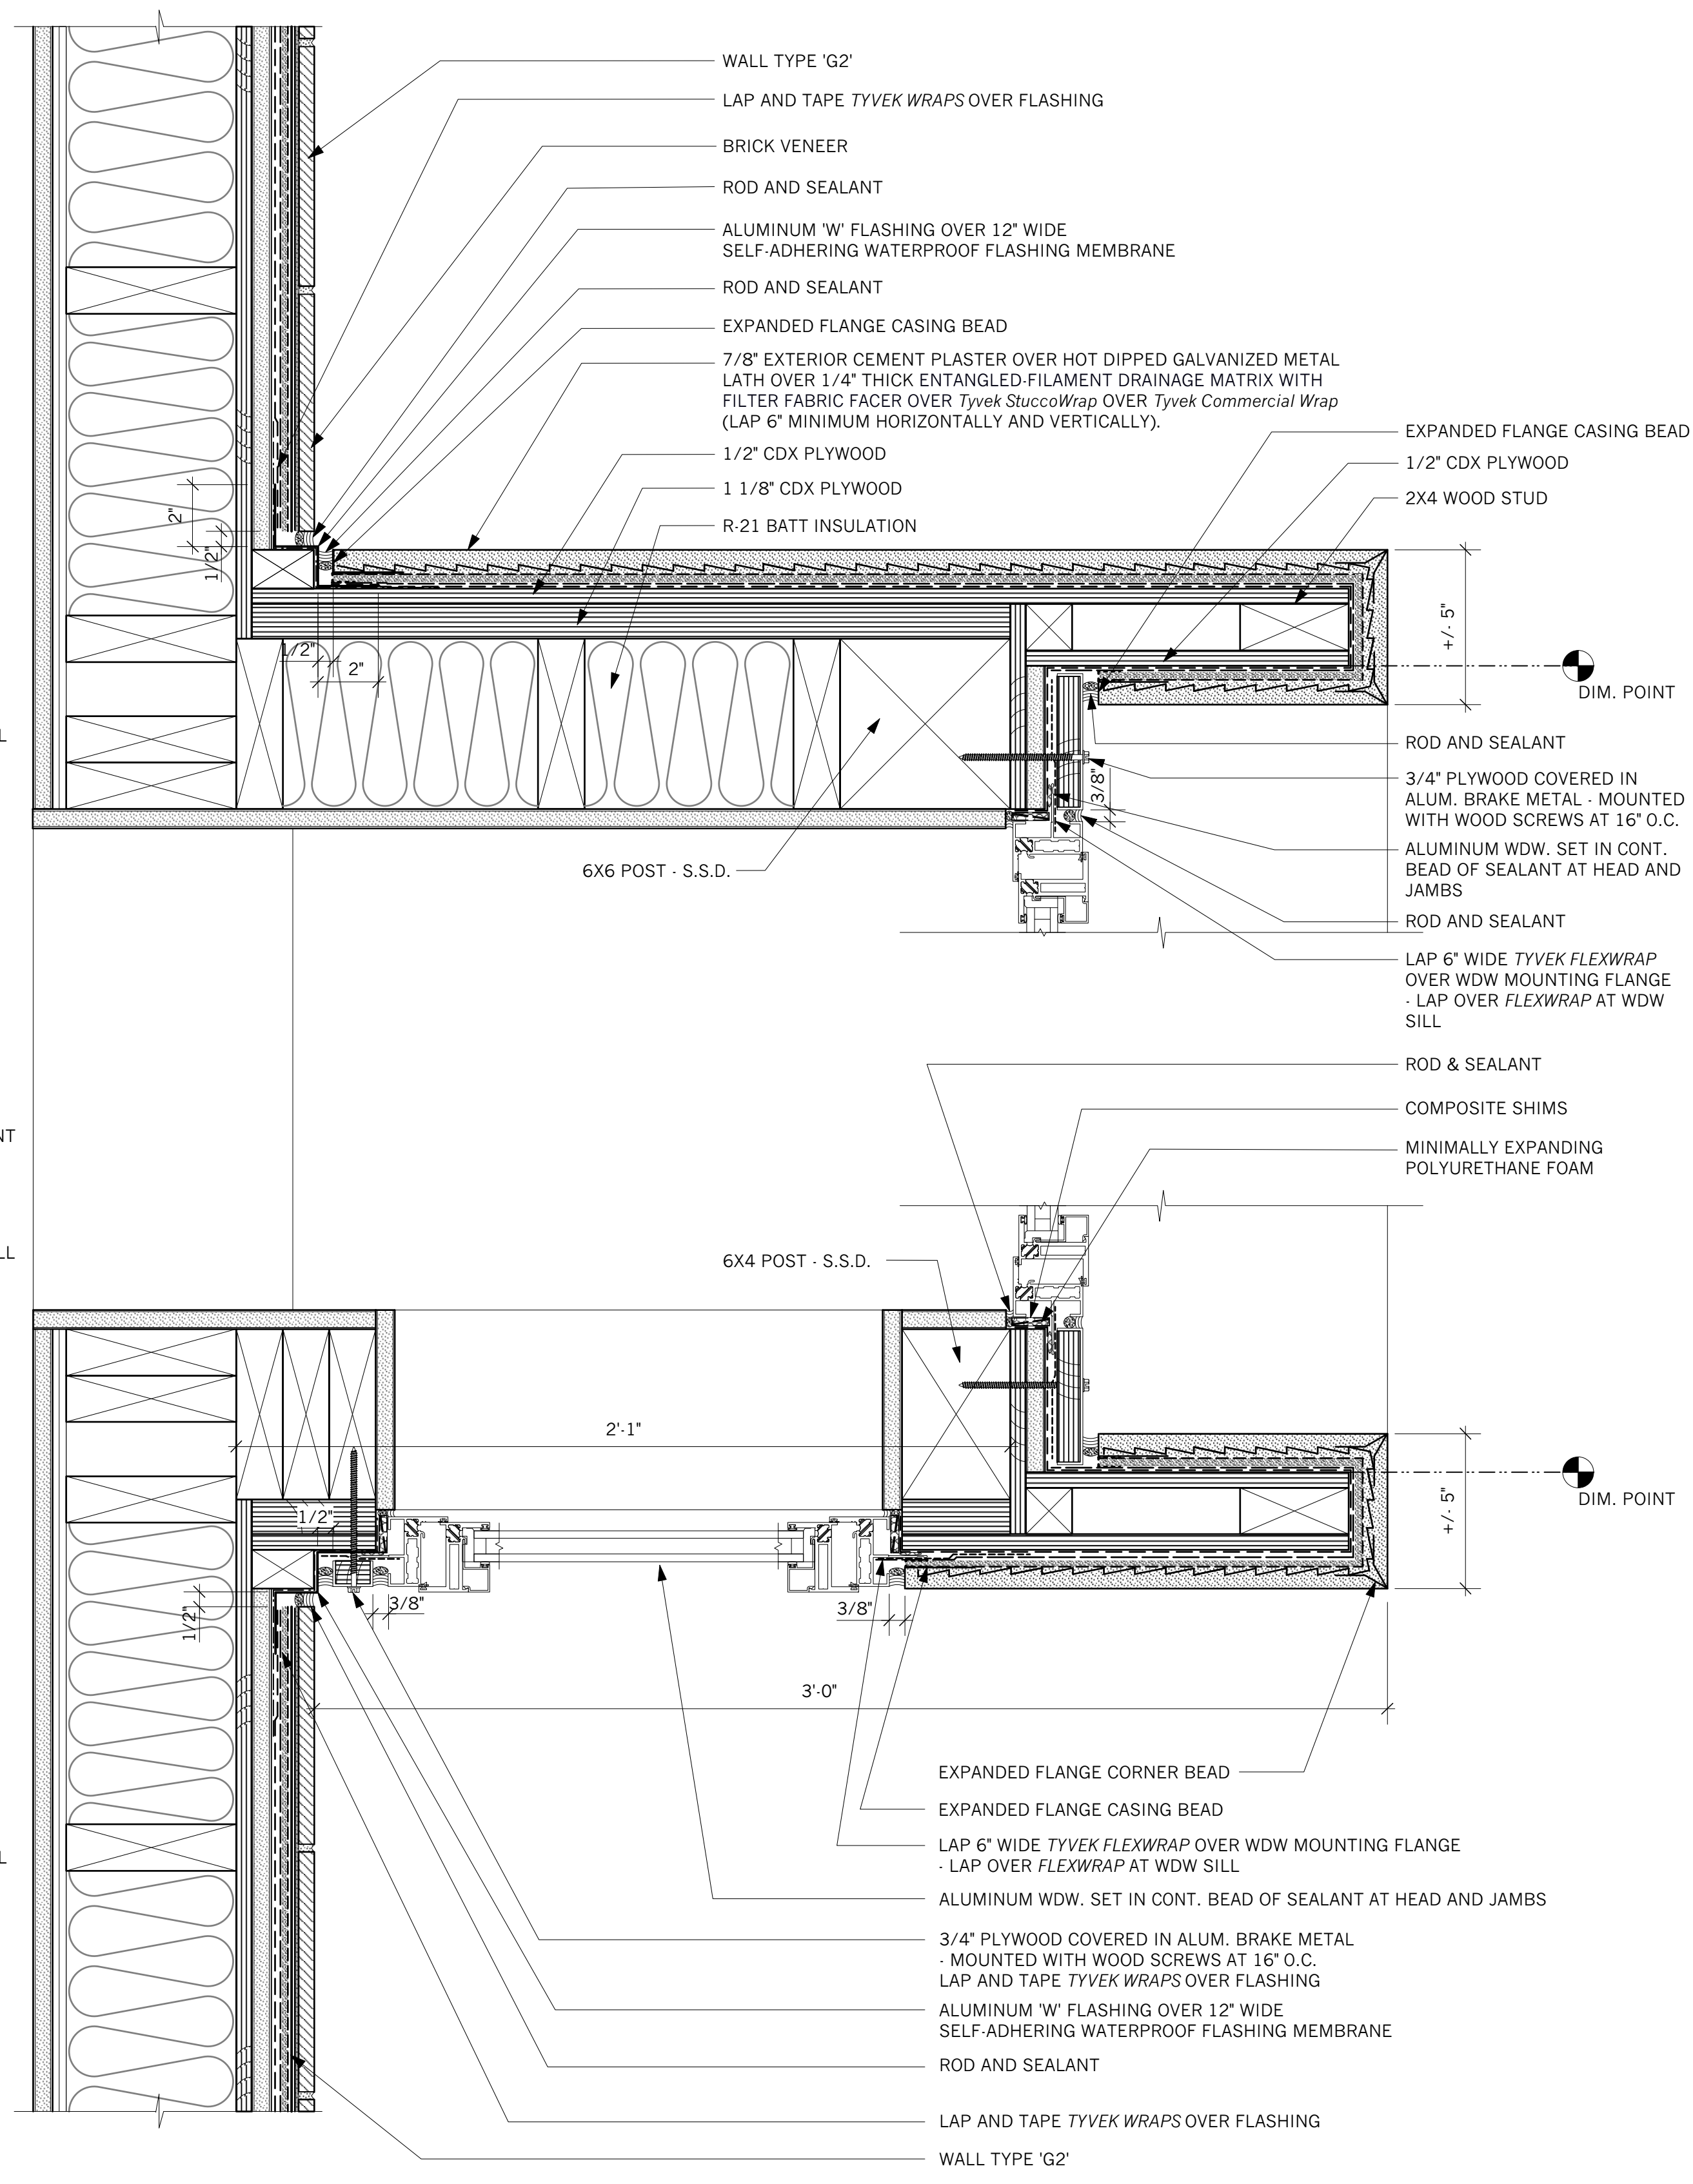

1 PLAN SECTION: BAY WINDOW JAMBS
Scale: 3" = 1'-0"

FOR REMAINDER OF NOTES SEE OPPOSITE HAND

NOTE:
ALL FASTENERS THROUGH WDW FIN NO CLOSER THAN 3" TO CORNERS AND NO MORE THAN 10". FASTENERS @ 16" o.c. MAX. NO FASTENERS BENT OVER NAILING FIN IN ORDER TO SECURE WDW.
INSTALL WDW AS PER MFR INSTRUCTIONS



ELEVATIONarchitects
1159 Green Street, Suite 4
San Francisco, CA 94109
415.537.1125 v
www.elevationarchitects.com w



agency stamps:

Condominiums
42 Otis Street
San Francisco, CA 94103
Block / Lot : 3503 / 020


#	date	issue
2	4.15.20	Project Revision 2
3	4.27.20	Plan Check Response 2
4	8.17.20	Plan Check Response 3

sheet count 43/49


Bay Window Details - South Elevation

project: 16.15
drawn by: mka
checked by: jp
date: 08.13.20
scale:


A-8.4

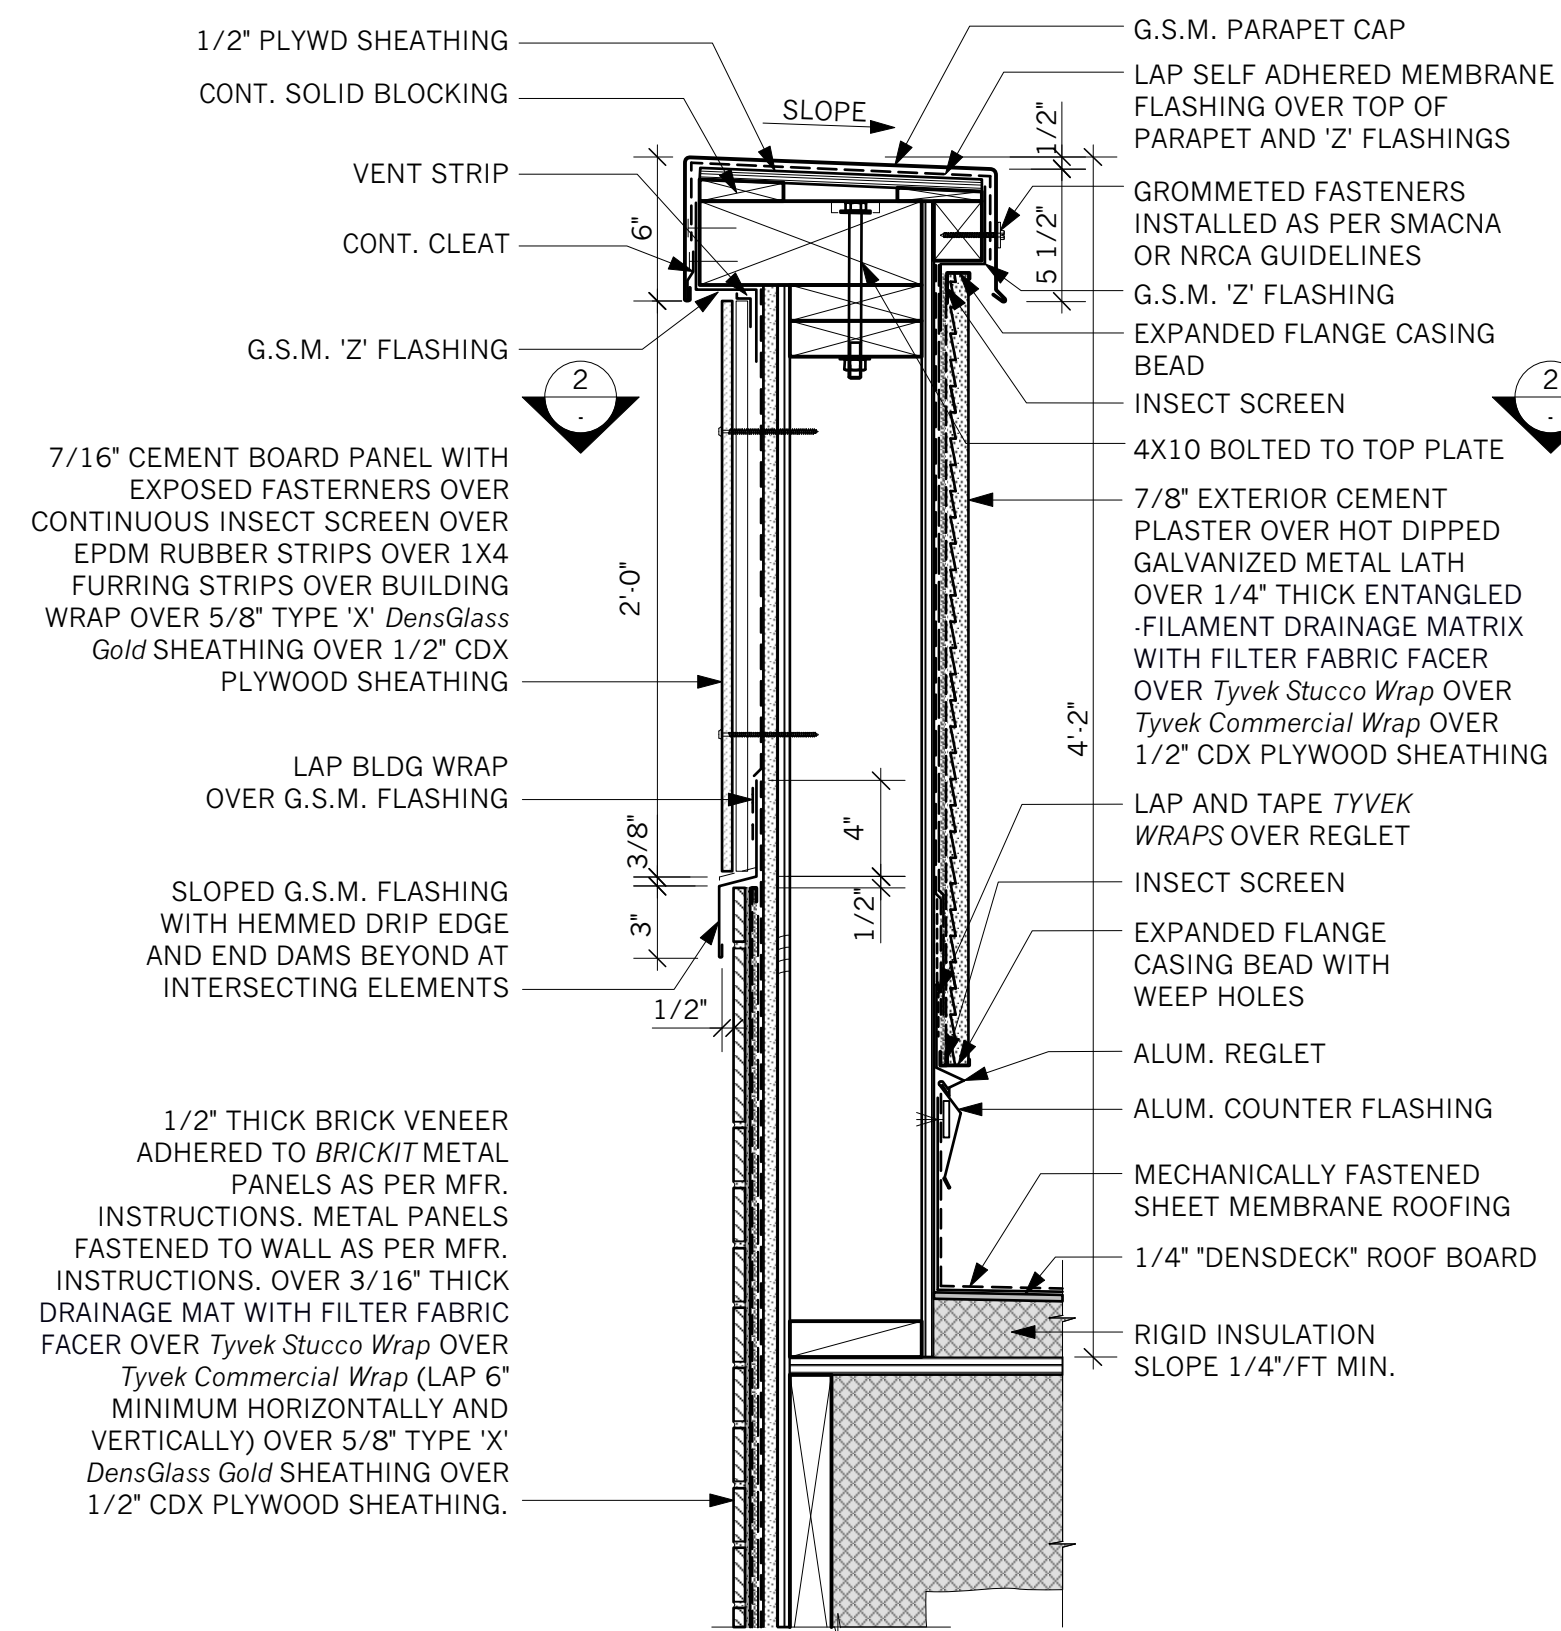


4 SECTION: SOUTHERN CORNICE
Scale: 1 1/2" = 1'-0"

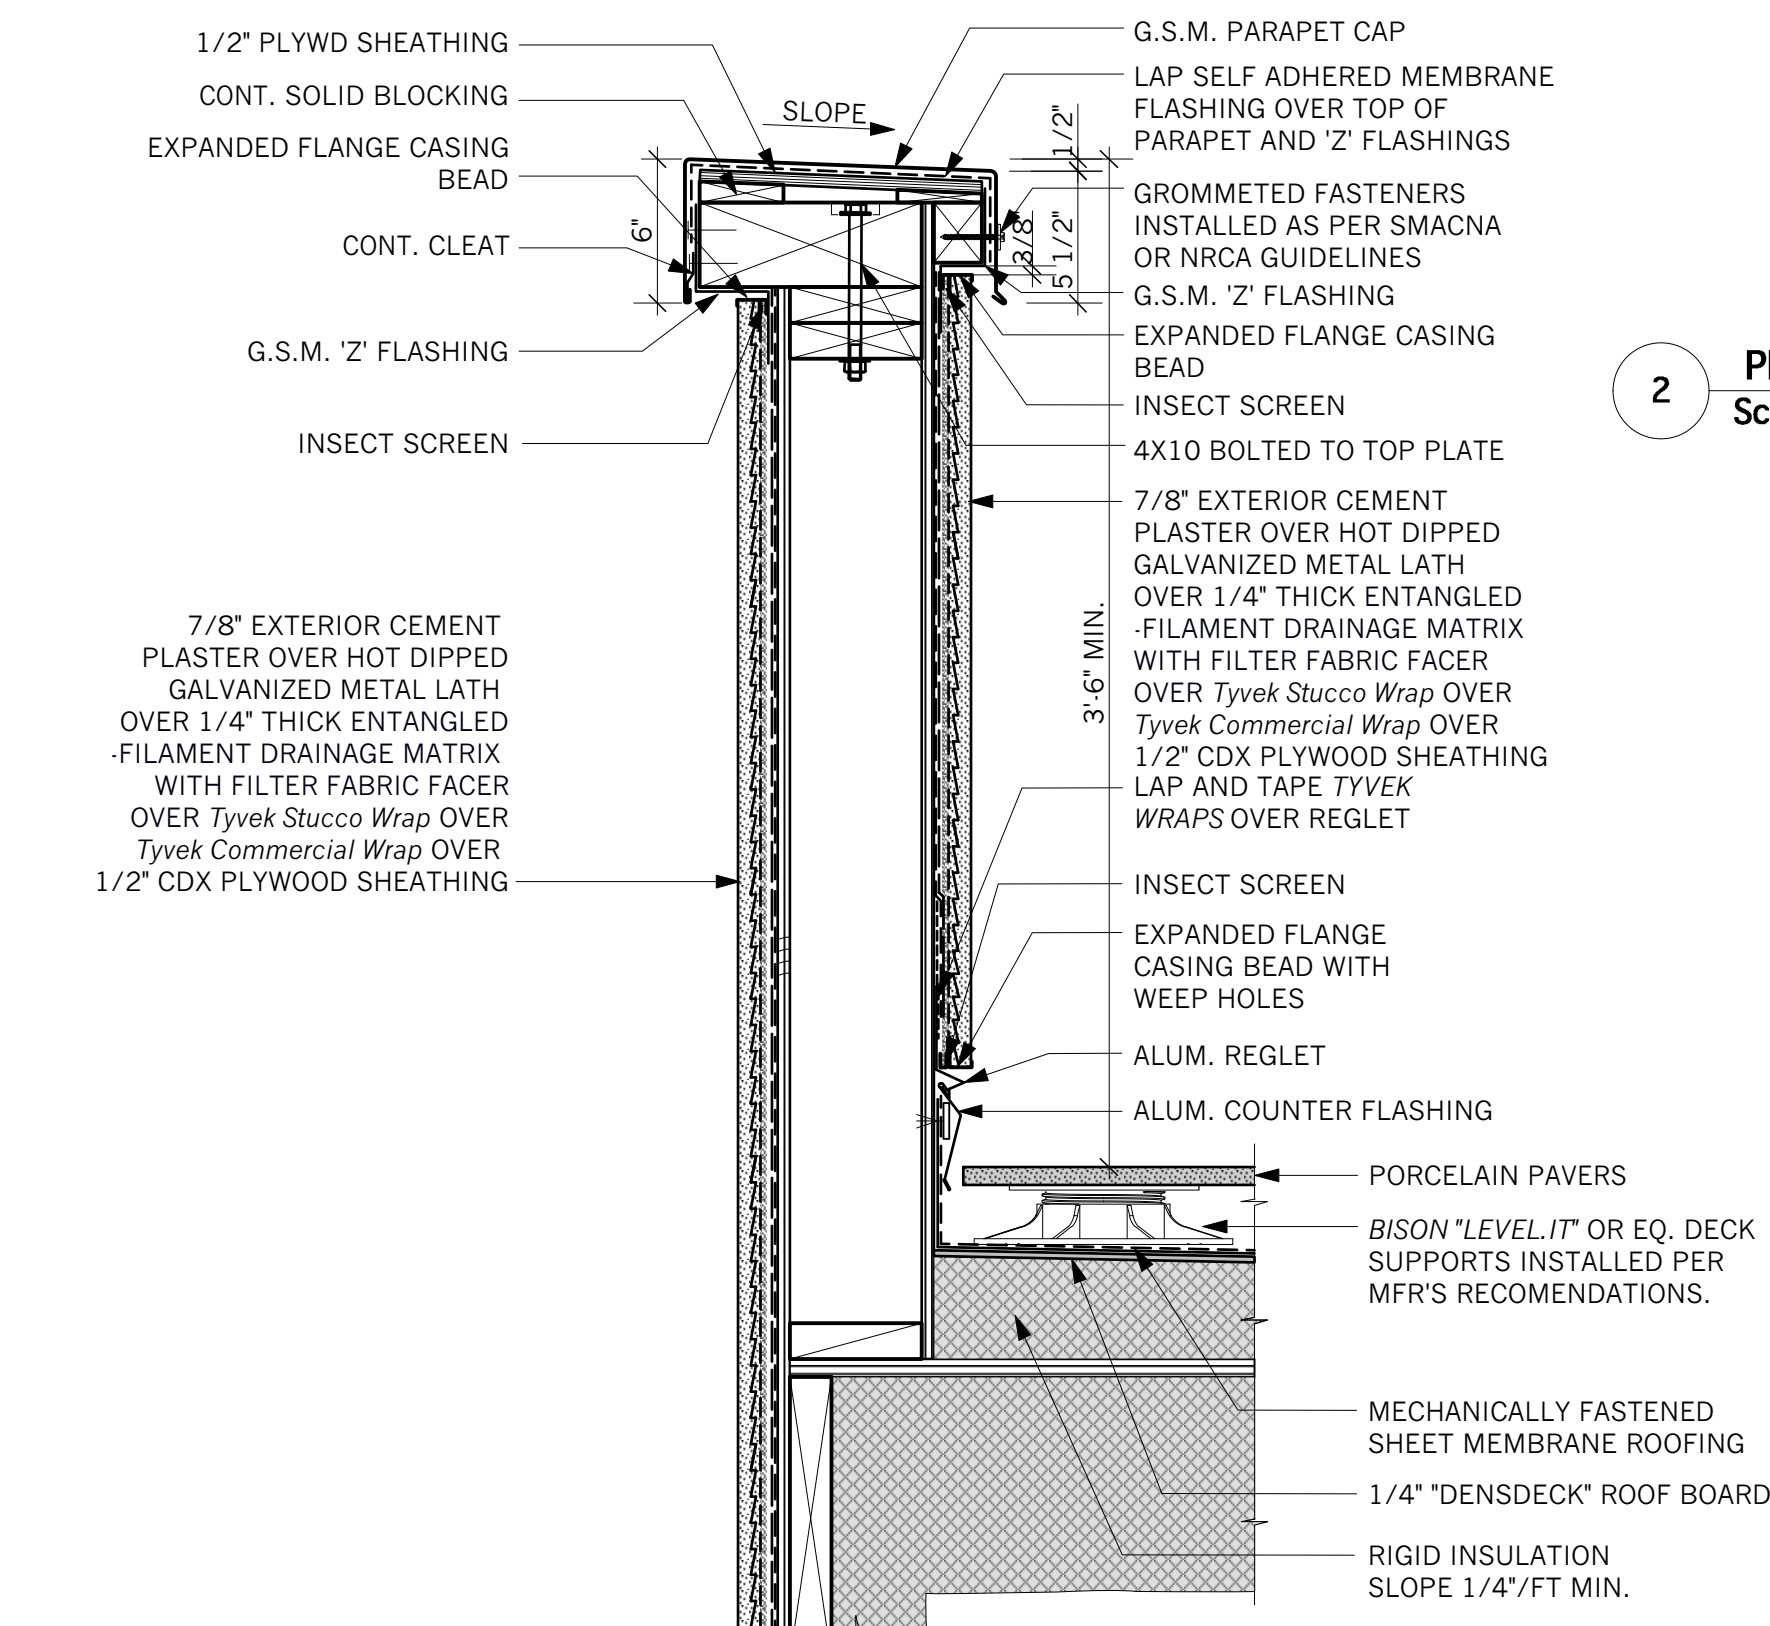


5 SECTION: NORTHERN CORNICE
Scale: 1 1/2" = 1'-0"

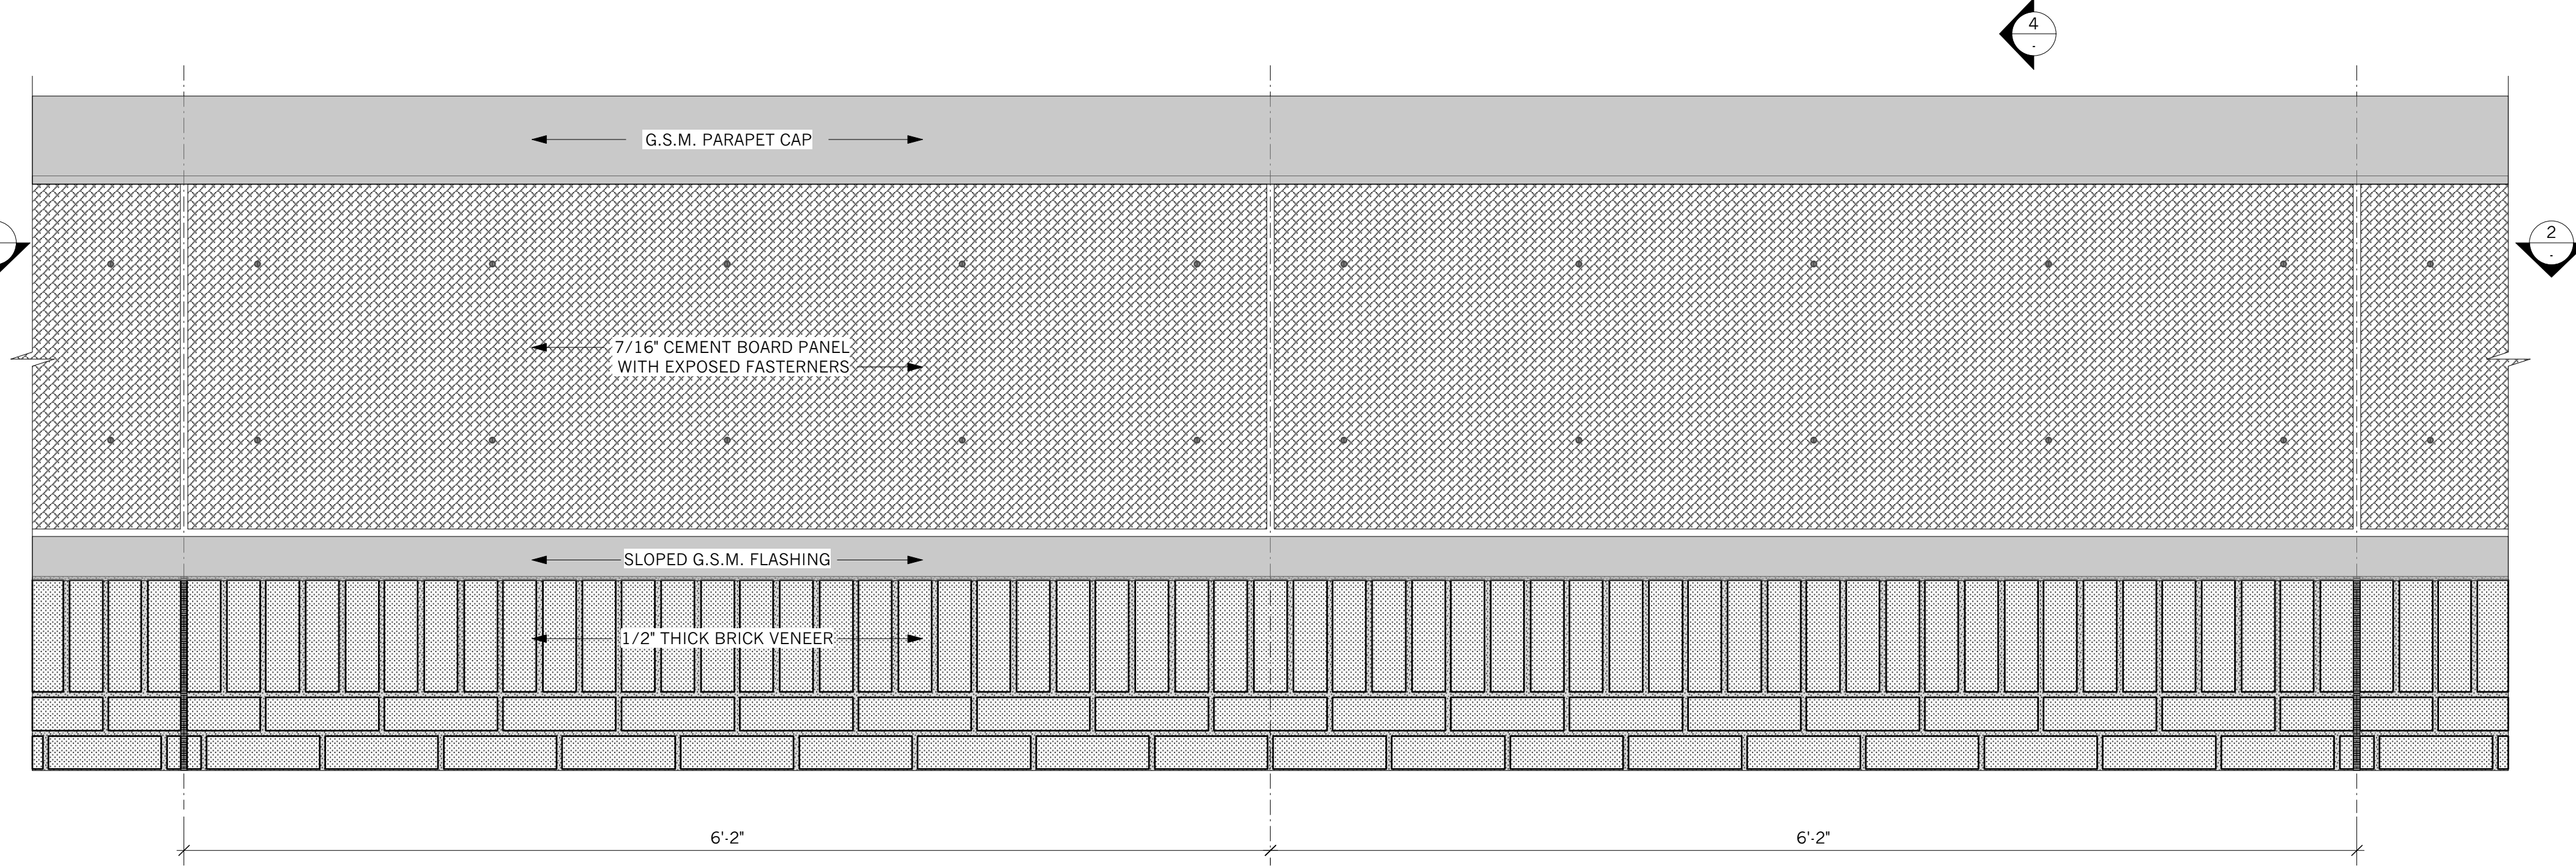

1 ELEVATION: CORNICE @ SOUTH ELEVATION
Scale: 1 1/2" = 1'-0"

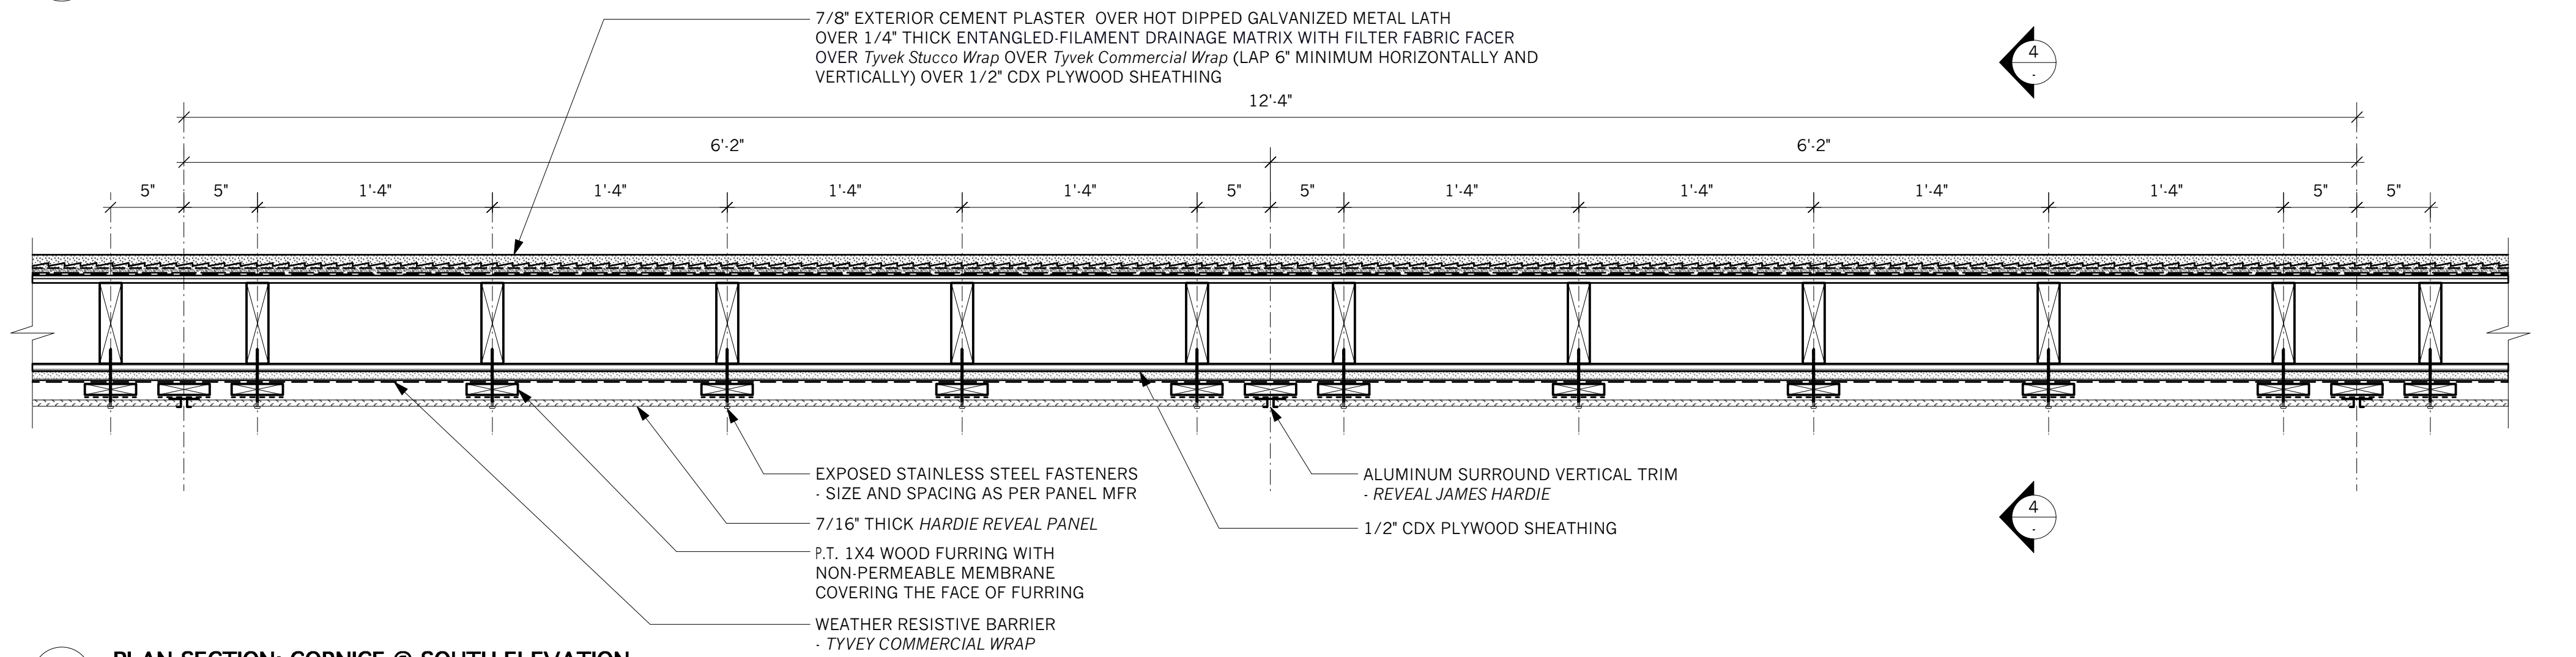


2 PLAN SECTION: CORNICE @ SOUTH ELEVATION
Scale: 1 1/2" = 1'-0"

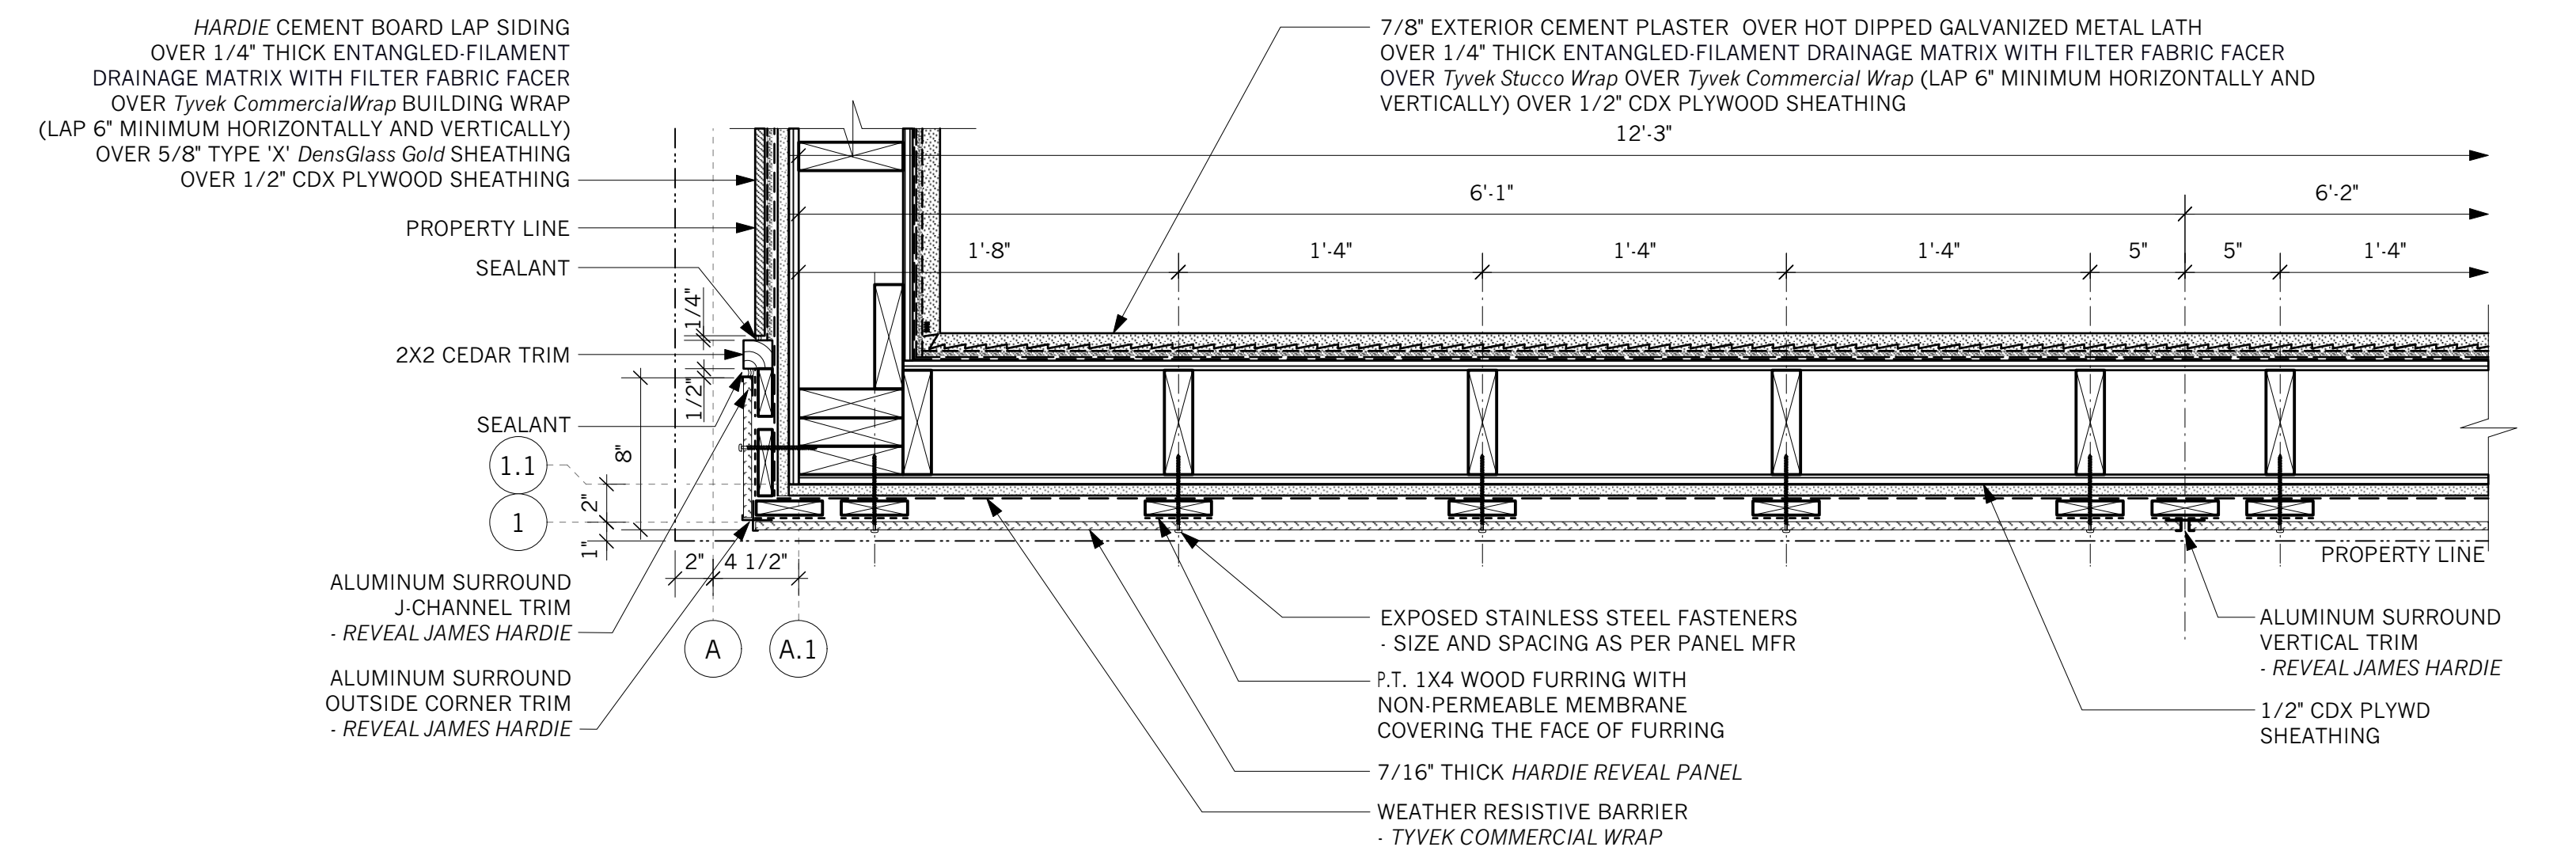

3 PLAN SECTION: CORNER AT CORNICE @ SOUTH ELEVATION
Scale: 1 1/2" = 1'-0"



ELEVATIONarchitects
1159 Green Street, Suite 4
San Francisco, CA 94109
415.537.1125
www.elevationarchitects.com

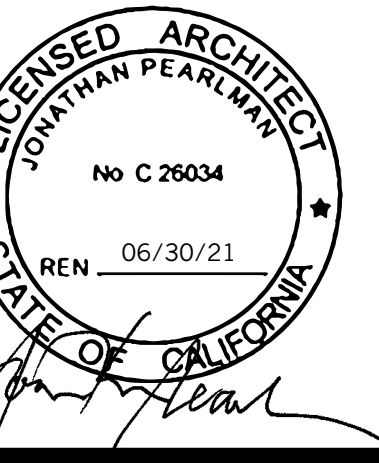

agency stamps:


Condominiums
42 Otis Street
San Francisco, CA 94103
Block / Lot : 3503 / 020

#	date	issue
2	4.15.20	Project Revision 2
3	4.27.20	Plan Check Response 2
4	8.17.20	Plan Check Response 3

sheet count 46/49

Cornice Details
project: 16.15
drawn by: mka
checked by: jp
date: 08.13.20
scale:


A-8.7

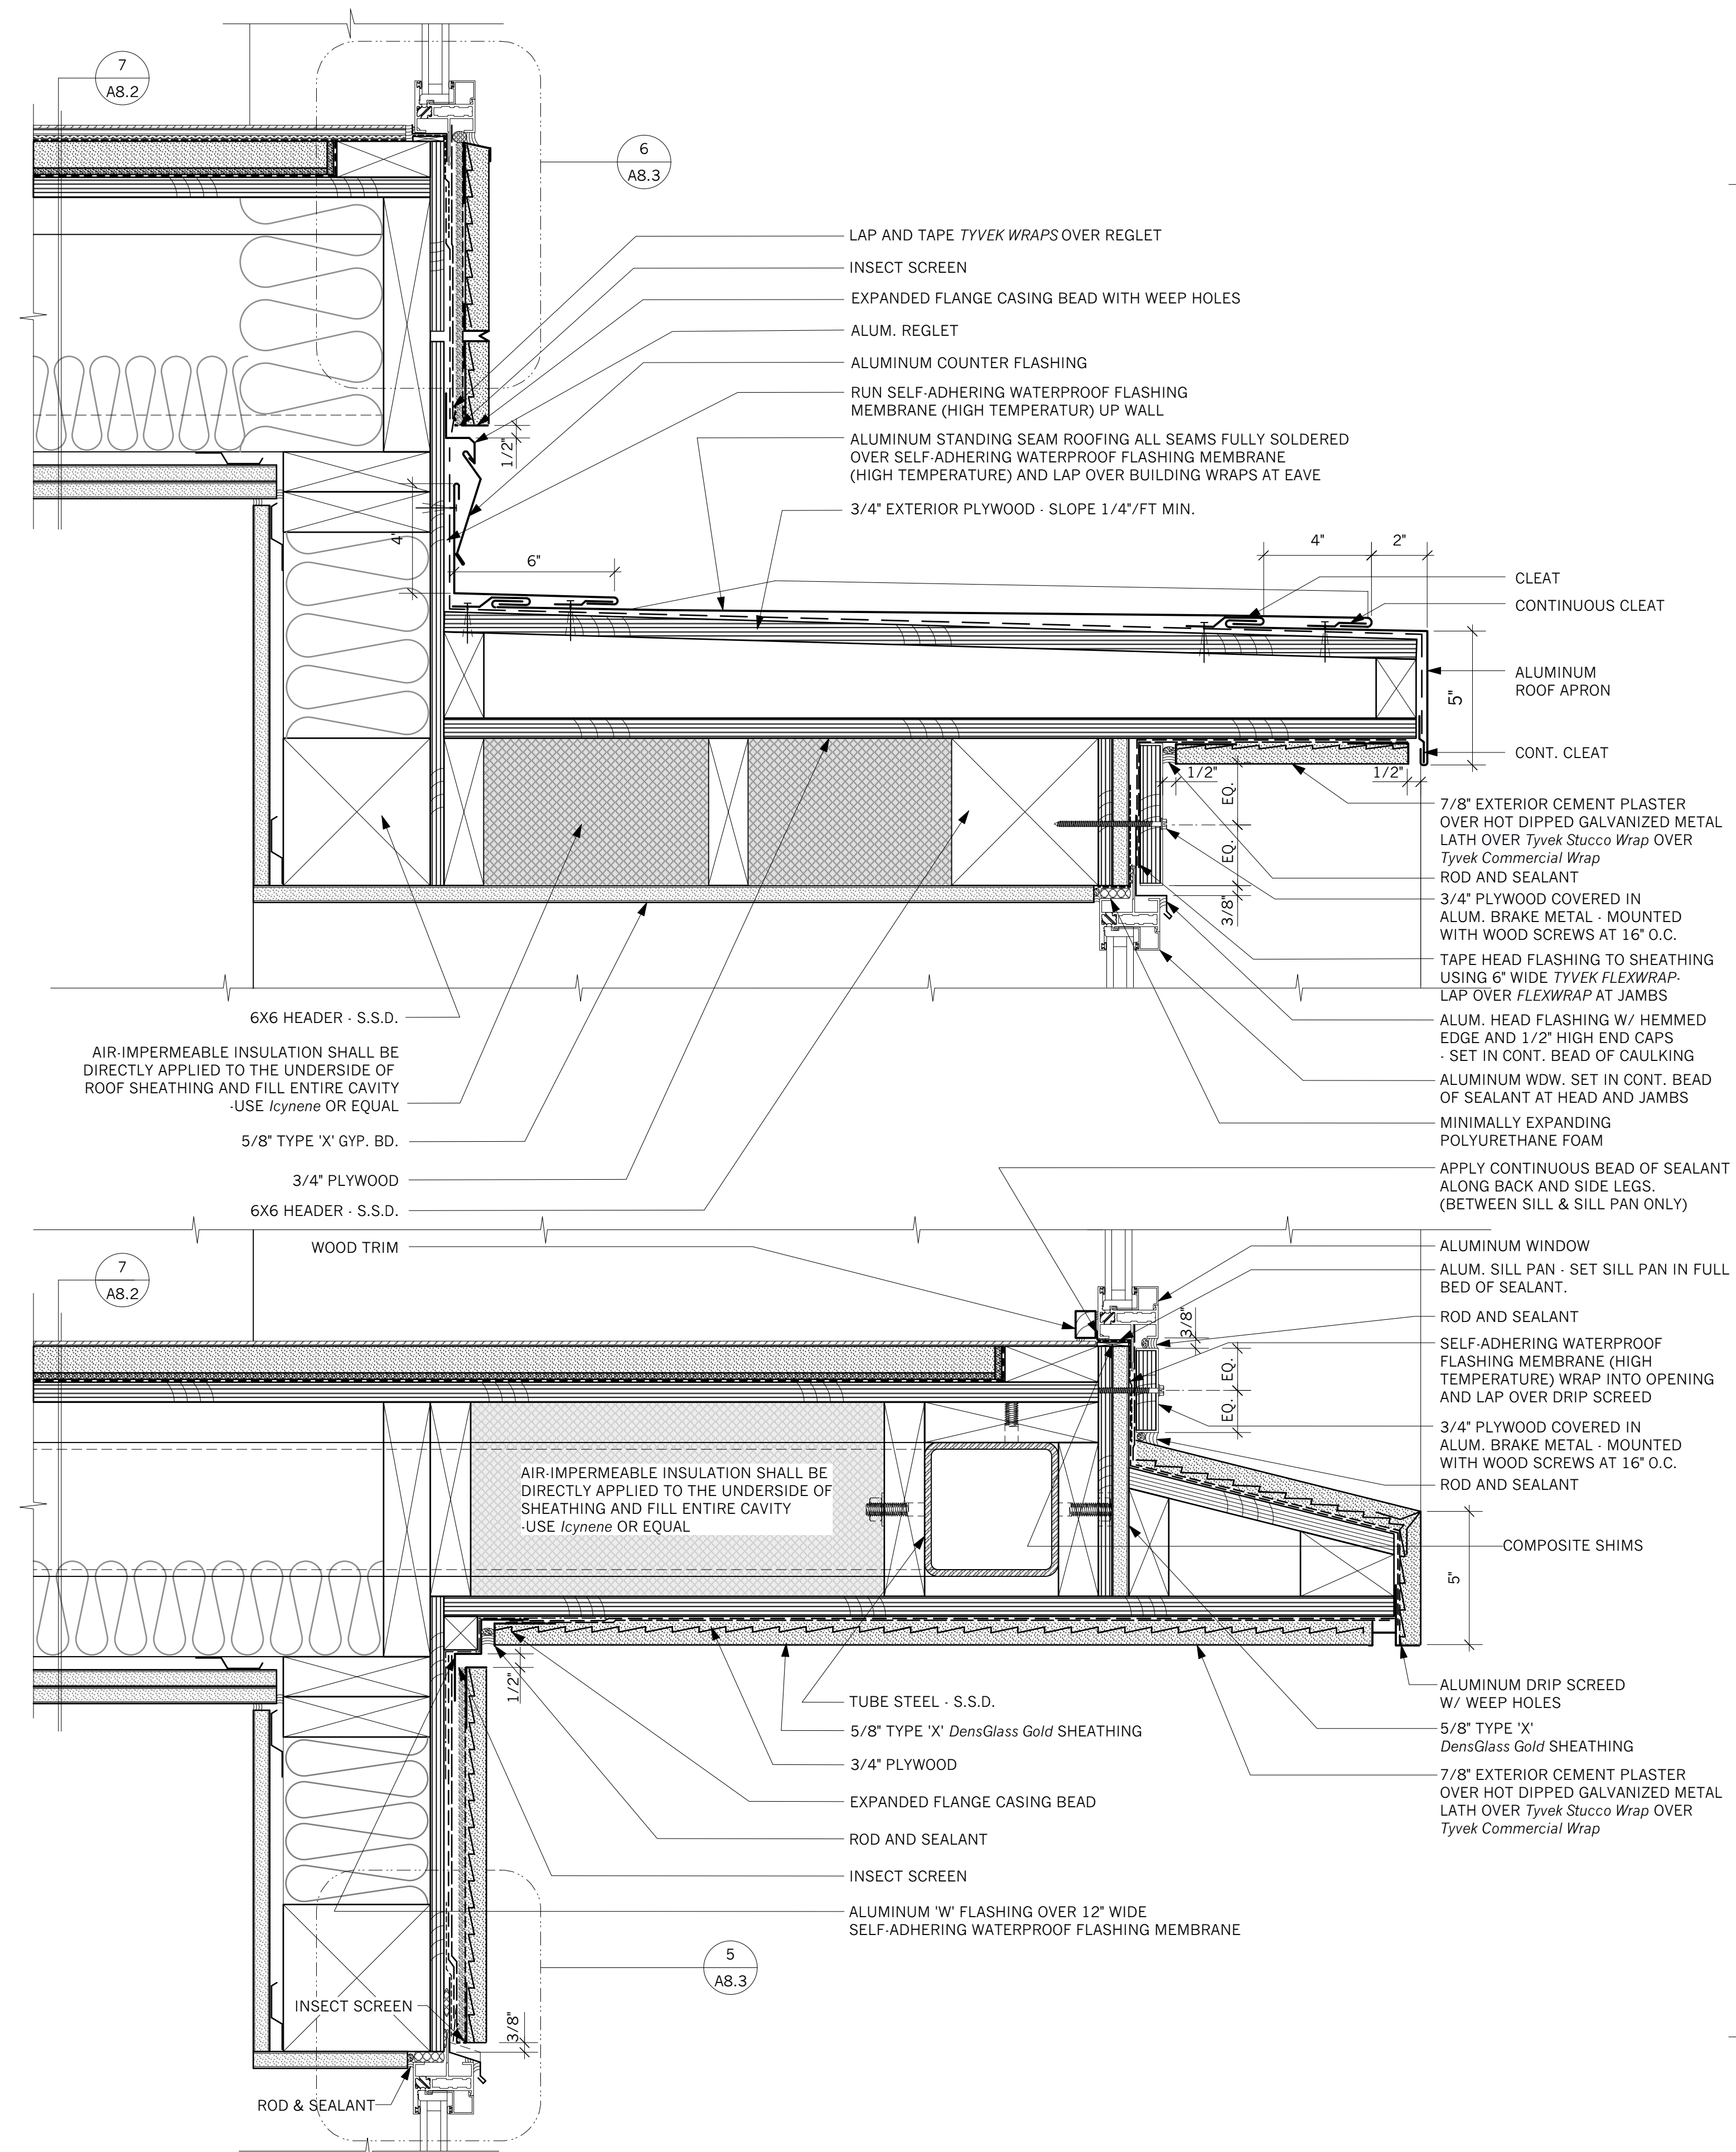

2 SECTION: BAY WINDOW HEAD AND SILL
Scale: 3" = 1'-0"

NOTE:
ALL FASTENERS THROUGH WDW FIN NO CLOSER THAN 3" TO CORNERS AND NO MORE THAN 10". FASTENERS @ 16" o.c. MAX. NO FASTENERS BENT OVER NAILING FIN IN ORDER TO SECURE WDW.

INSTALL WDW AS PER MFR INSTRUCTIONS

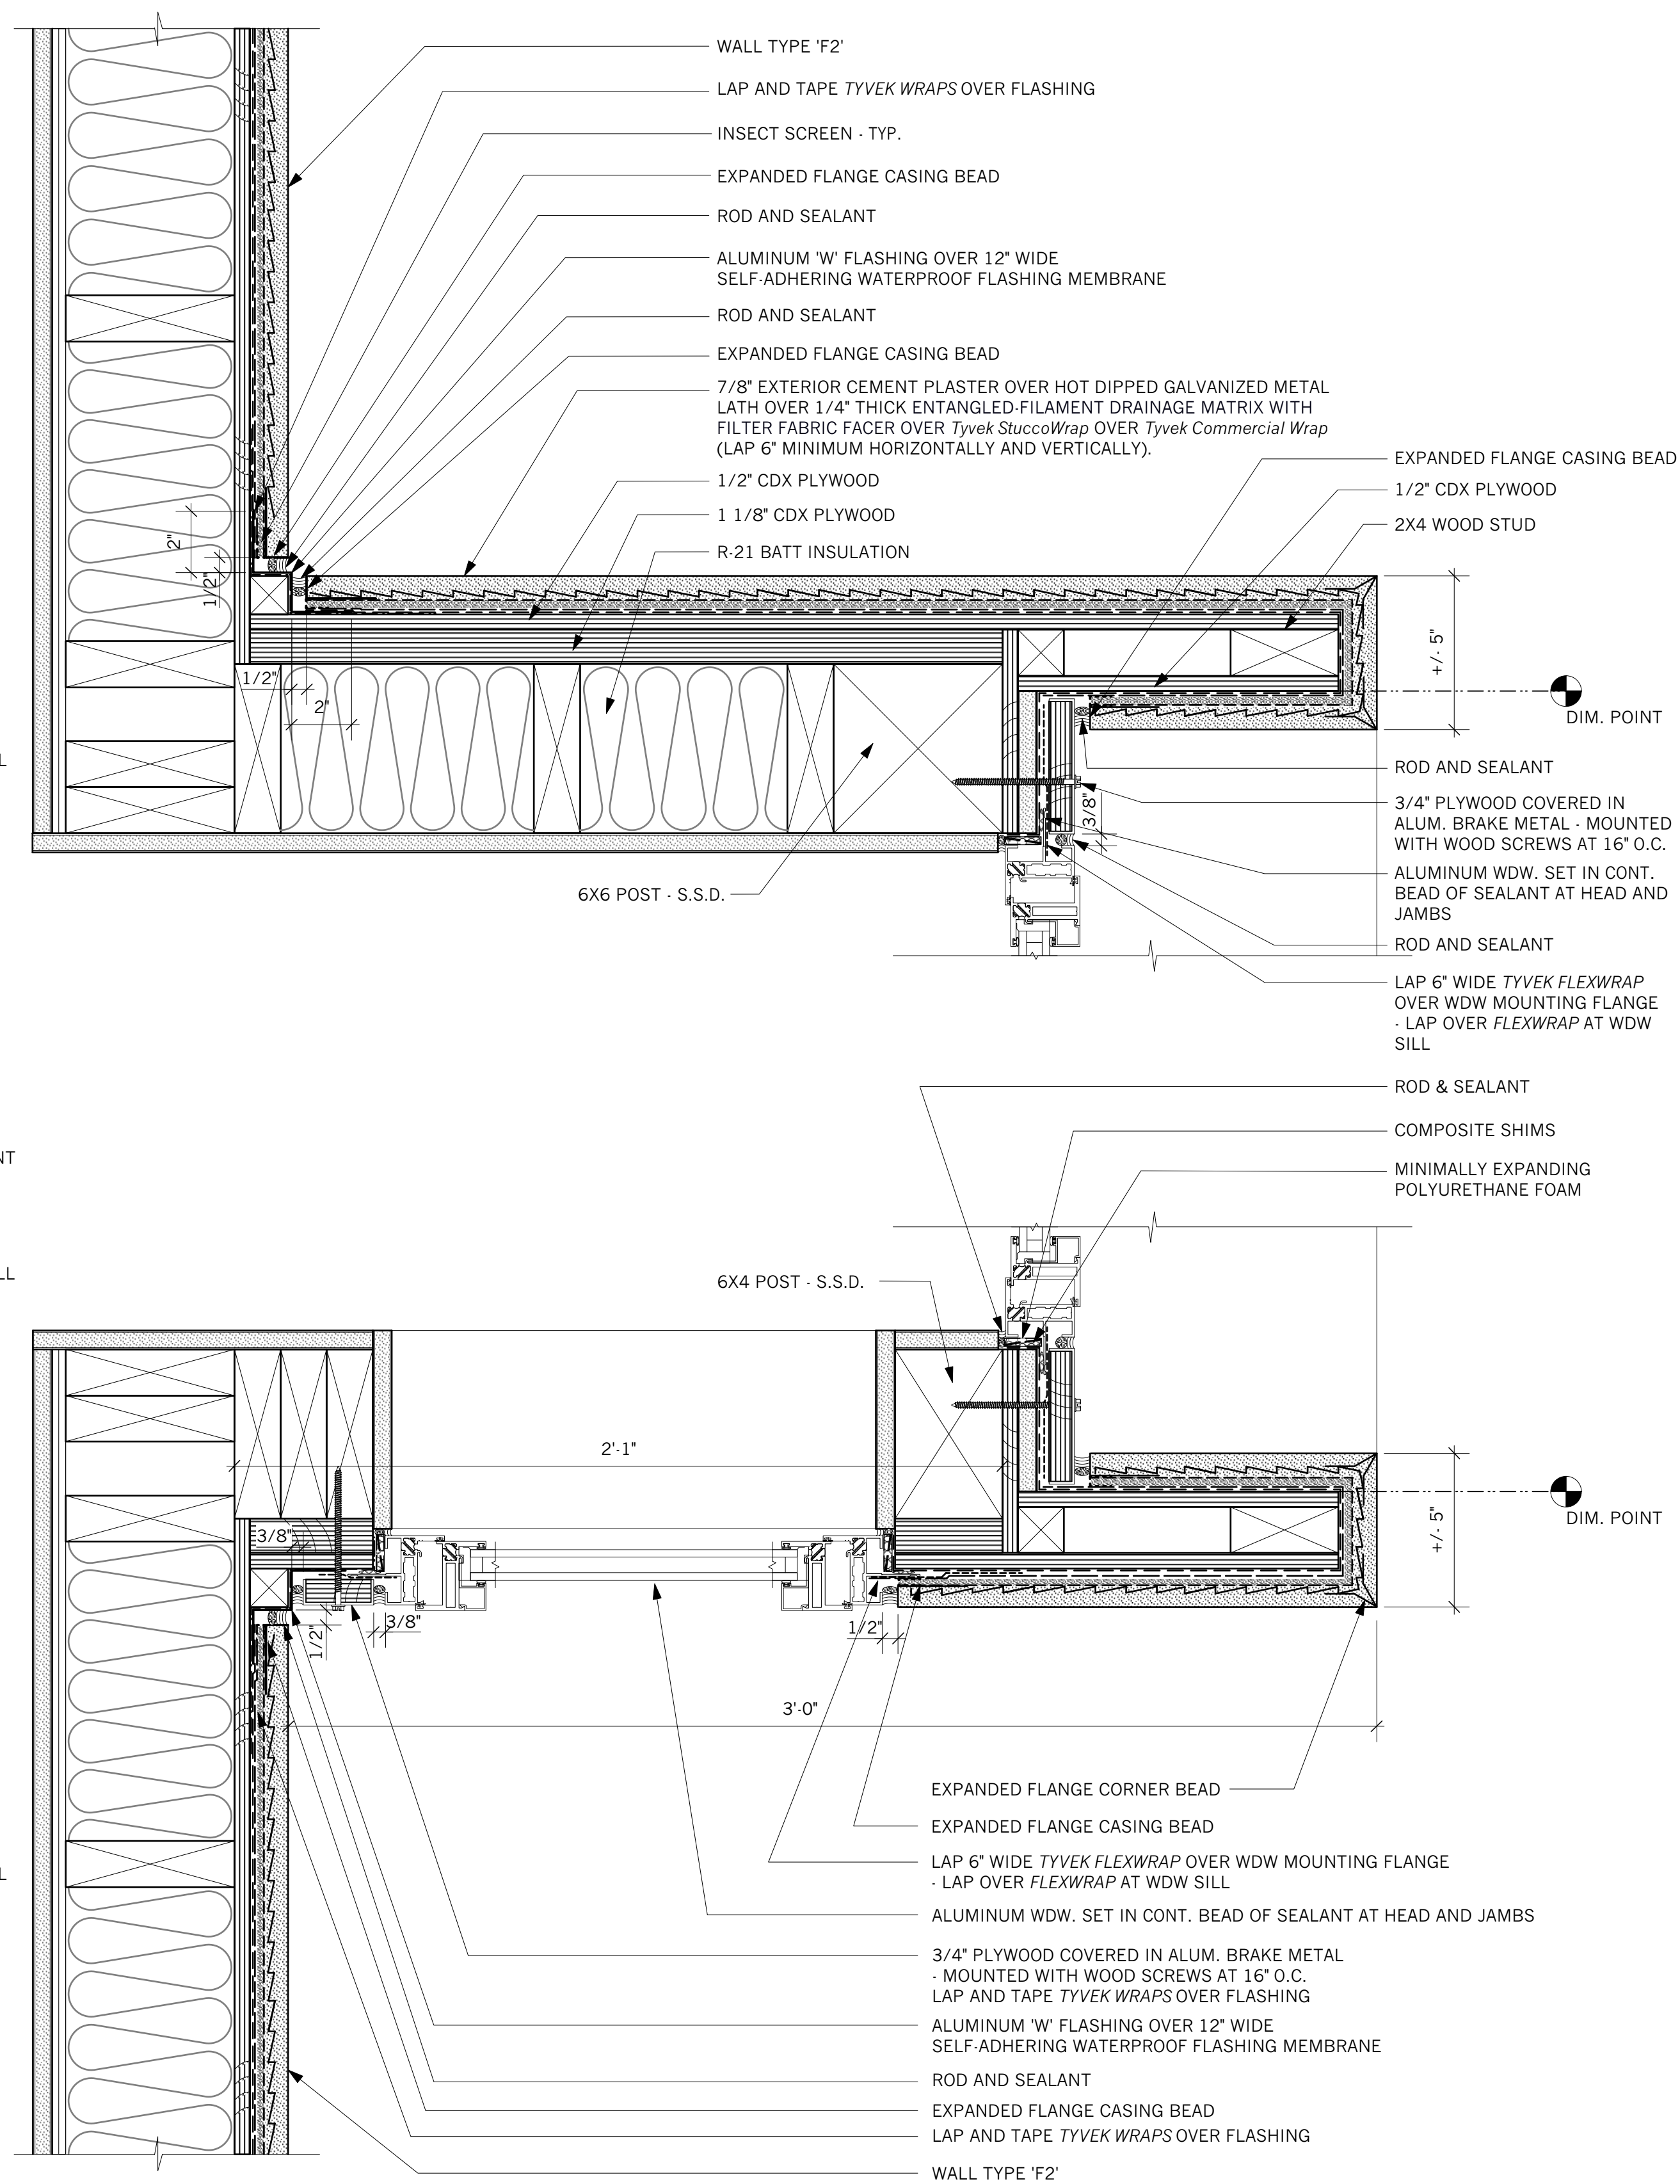

1 PLAN SECTION: BAY WINDOW JAMBS
Scale: 3" = 1'-0"

NOTE:
ALL FASTENERS THROUGH WDW FIN NO CLOSER THAN 3" TO CORNERS AND NO MORE THAN 10". FASTENERS @ 16" o.c. MAX. NO FASTENERS BENT OVER NAILING FIN IN ORDER TO SECURE WDW.

INSTALL WDW AS PER MFR INSTRUCTIONS

FOR REMAINDER OF NOTES SEE OPPOSITE HAND



ELEVATIONarchitects
1159 Green Street, Suite 4
San Francisco, CA 94109
415.537.1125 v
www.elevationarchitects.com w



agency stamps:

Condominiums
42 Otis Street
San Francisco, CA 94103
Block / Lot : 3503 / 020




#	date	issue
2	4.15.20	Project Revision 2
3	4.27.20	Plan Check Response 2
4	8.17.20	Plan Check Response 3

sheet count 47/49

Bay Window Details - North Elevation

project: 16.15
drawn by: mka
checked by: jp
date: 08.13.20
scale:

A-8.8

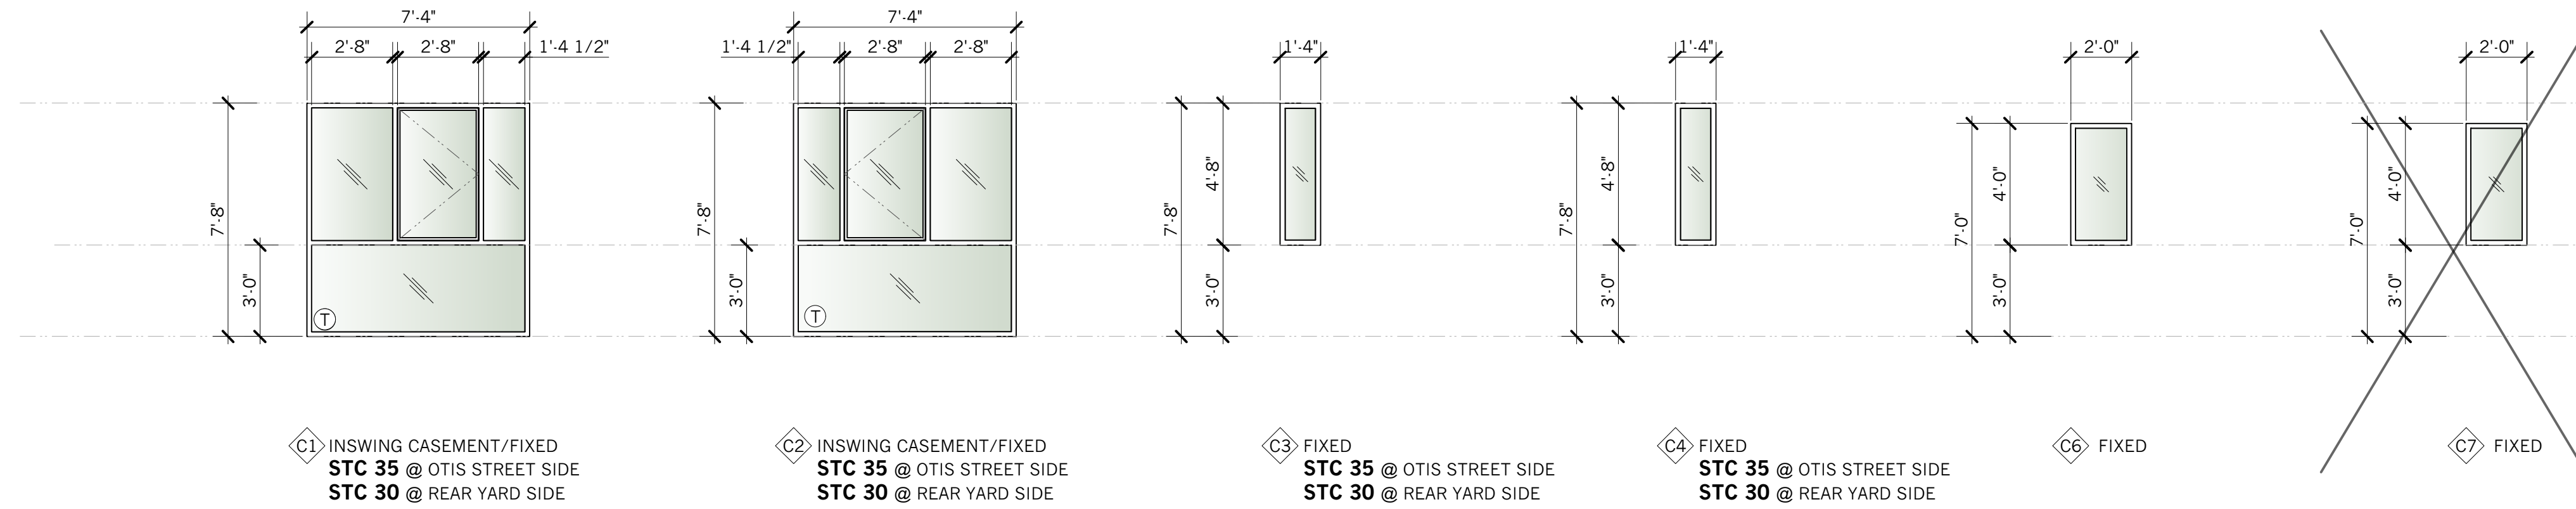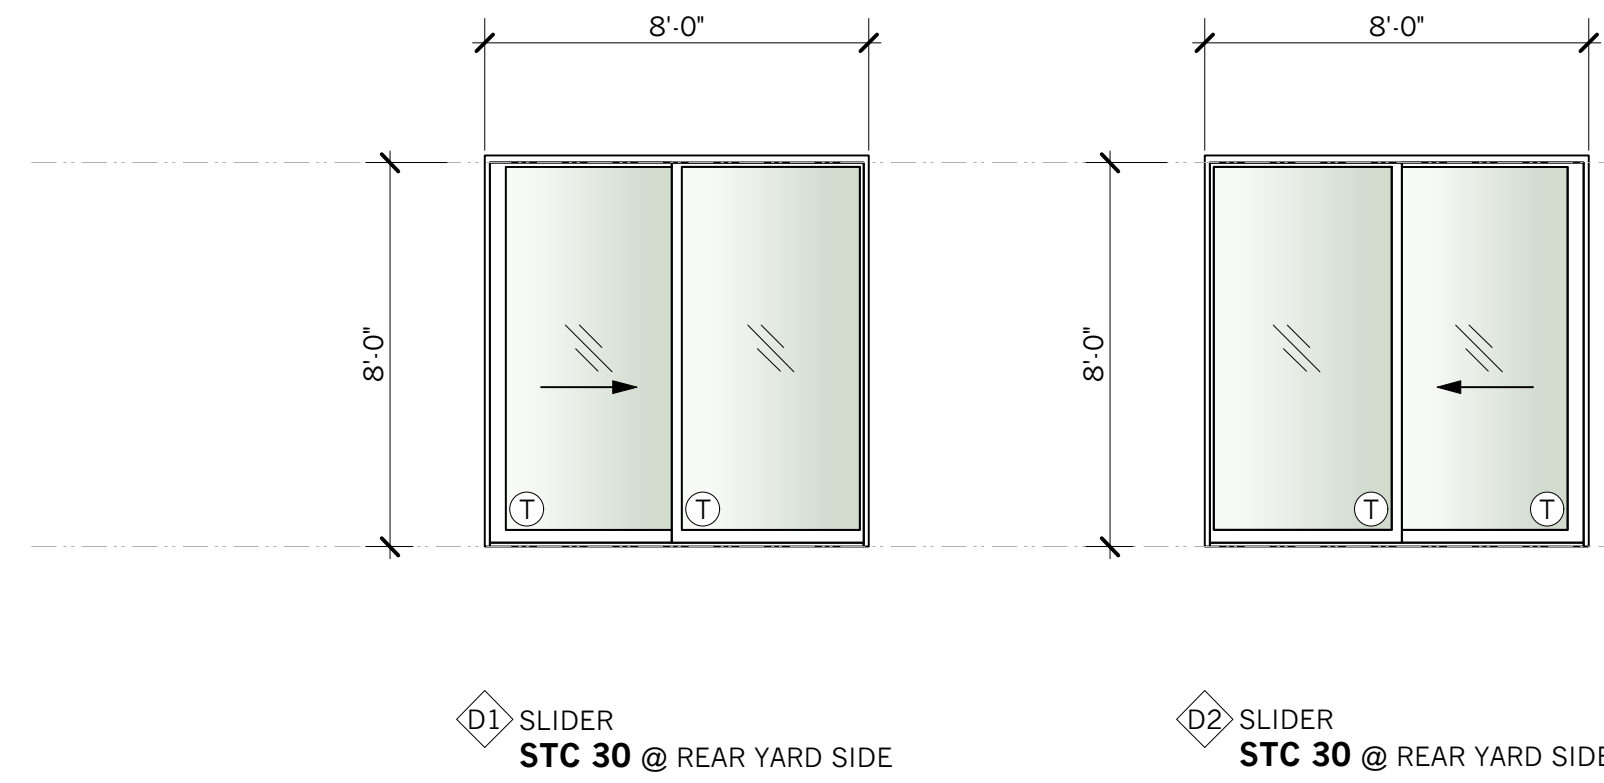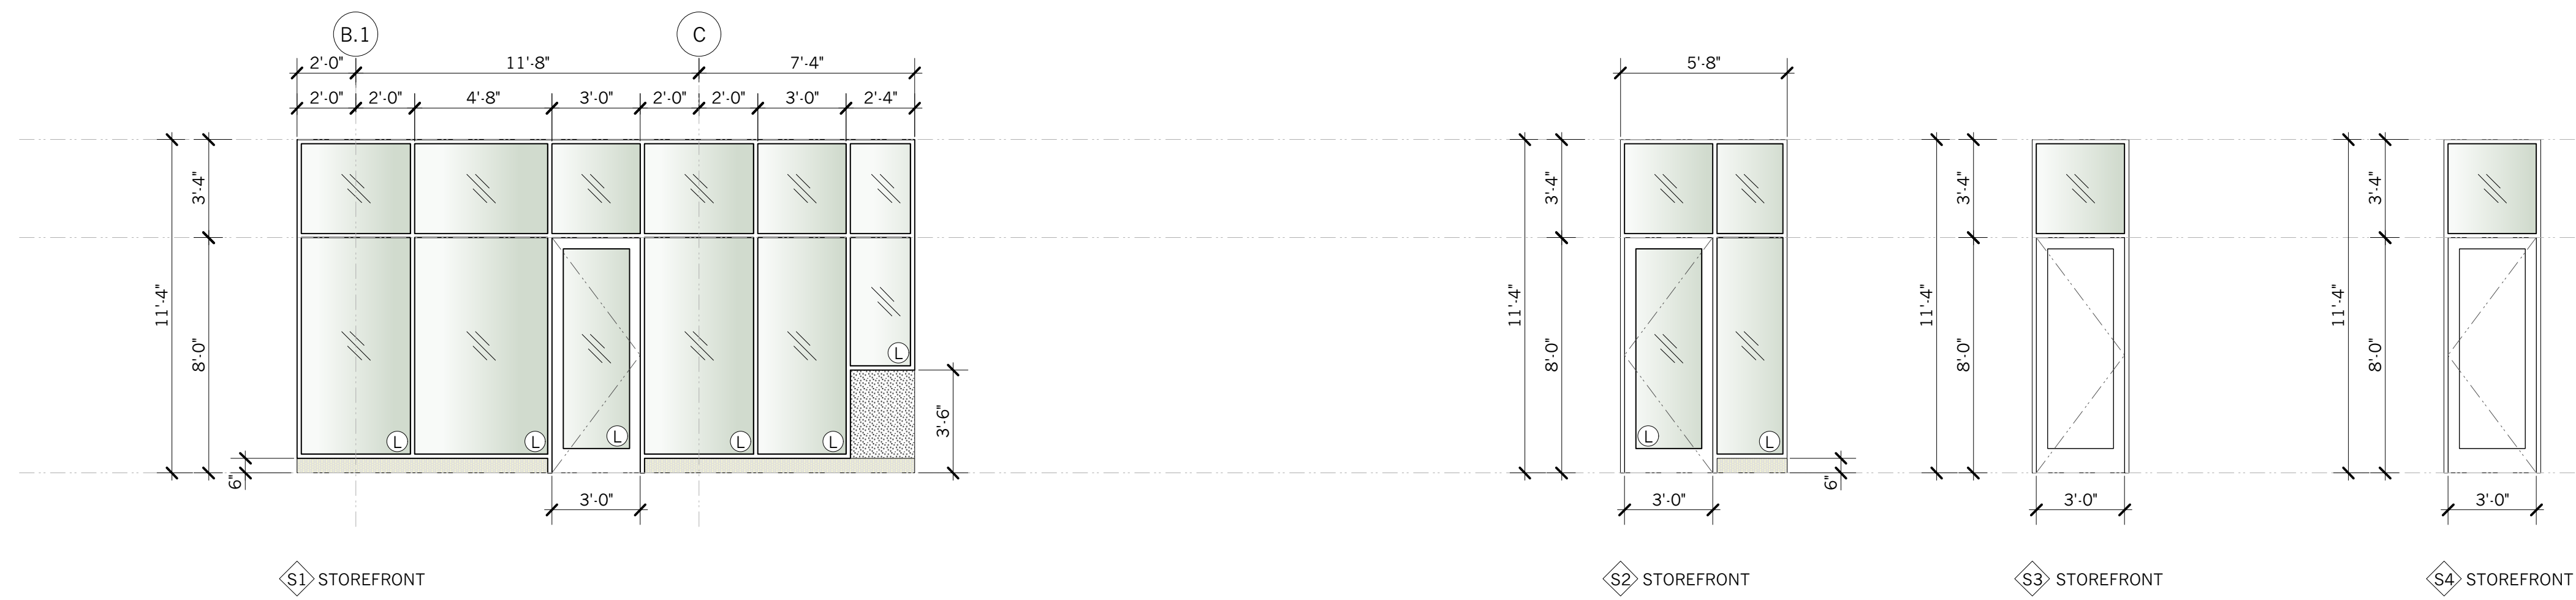


SHEET NOTES:

- ALL WINDOWS AND DOORS TO BE FLEETWOOD LOW-E, DOUBLE GLAZED, THERMAL BREAK ALUMINUM FRAME WINDOWS AND DOORS, U.O.N.
- MINIMUM PERFORMANCE REQUIREMENTS:
 WINDOWS: U-FACTOR SEE MEP DRWGS SHGC SEE MEP DRWGS
 SLIDING OR SWING FRENCH DOORS: U-FACTOR SEE MEP DRWGS SHGC SEE MEP DRWGS
- MINIMUM REQUIRED SOUND RATING (STC) NOTED BELOW INDIVIDUAL WINDOW AND DOOR REPRESENTATIONS AND ON EXTERIOR ELEVATIONS.
- CONTRACTOR TO VERIFY ALL UNIT SIZES, R.O.'S & HEAD/SILL HEIGHTS IN FIELD & NOTIFY ARCHITECT OF DISCREPANCIES;** REVIEW ALL WINDOW SIZES & SPECIFICATIONS W/ ARCHITECT PRIOR TO PURCHASE OF WINDOWS. ARCHITECT TO REVIEW WINDOW ORDER.
- PROVIDE SAFETY GLAZING PER CBC 2406.3
 T = TEMPERED GLASS
 L = LAMINATED GLASS
 O = OBSCURE GLASS



ELEVATIONarchitects
 1159 Green Street, Suite 4
 San Francisco, CA 94109
 415.537.1125 :v
 www.elevationarchitects.com :w

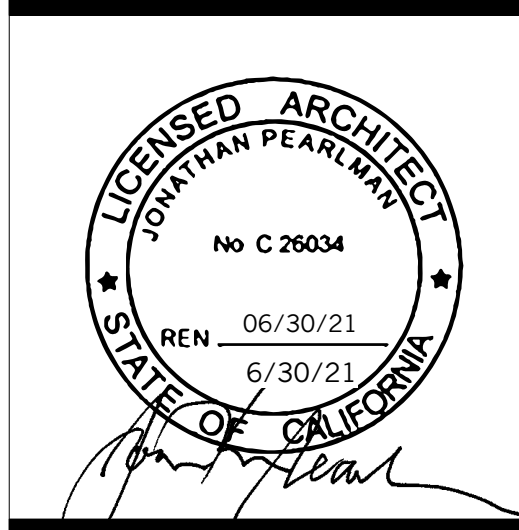

agency stamps:

Condominiums
 42 Otis Street
 San Francisco, CA 94103
 Block / Lot : 3503 / 020

SECTION 1003A – GENERAL REQUIREMENTS FOR SECURITY

1003A.1 CLEARANCES. THE CLEARANCE BETWEEN THE DOOR AND THE FRAME AND BETWEEN MEETING EDGES OF DOORS SWINGING IN PAIRS SHALL NOT EXCEED 1/8 INCH (3.2 MM). THE CLEARANCE BETWEEN THE DOOR AND THE FLOOR WITH EITHER FLUSH OR RAISED SILL SHALL BE NOT MORE THAN 3/4 INCH (19.1 MM).

1003A.2 DOOR ASSEMBLIES. EXCLUDING MAIN ENTRY DOORS, ALL EXTERIOR SWINGING DOORS, AND SWINGING INTERIOR AND EXTERIOR ENTRY DOORS, INCLUDING ASSEMBLIES AND RELATED HARDWARE, WHICH ARE DIRECTLY ACCESSIBLE FROM THE GROUND LEVEL OR BY STAIRS OR BY RAMP, OR FROM ROOF AREAS, OR PARKING LOT, OR GARAGE AREAS, SHALL MEET THE REQUIREMENTS OF GRADE 20 OF ANSI/ASTM F476, STANDARD TEST METHODS FOR SECURITY OF SWINGING DOOR ASSEMBLIES.

ALL SUCH DOORS SHALL BE SELF-CLOSING CONTINUOUSLY LOCKED, AND OPENABLE FROM THE INTERIOR WITH NO SPECIAL EFFORT OR KNOWLEDGE OR KEY. WHERE ELECTRICALLY OPERATED LOCKS ARE USED, THEY MUST BE SELF-LATCHING AND LOCKING AND SHALL HAVE MANUAL RELEASE CAPABILITY FROM THE INTERIOR REQUIRING NO SPECIAL EFFORT OR KNOWLEDGE OR KEY.

1003A.2.1 MAIN ENTRANCE. ALL MAIN ENTRY DOORS, INCLUDING ELECTRICALLY OPERATED MAIN ENTRY DOORS, SHALL BE PROVIDED WITH A PRIMARY LOCKING DEVICE. "MAIN ENTRY DOORS" SHALL BE DEFINED AS EXTERIOR DOORS LEADING DIRECTLY INTO THE LOBBY, REGISTRATION AREAS OR EMPLOYEE ENTRANCES.

1003A.2.2 VIEWER. EACH DOOR SHALL BE PROVIDED WITH A MINIMUM 135-DEGREE VIEWER WHICH DOES NOT HAVE SIGHTING CAPABILITY WHEN VIEWED FROM THE OUTSIDE. MOUNTING HEIGHT SHALL NOT EXCEED 58 INCHES (1473 MM).

1003A.3 FIRE-RATED DOOR ASSEMBLIES. FIRE-RATED DOOR ASSEMBLIES SHALL MEET THE REQUIREMENTS OF GRADE 20, ANSI/ASTM F476.

1003A.4 GLAZING. ALL GLAZING WITHIN 40 INCHES (1016 MM) OF ANY LOCKING MECHANISM OF EXTERIOR AND INTERIOR DWELLING UNIT DOORS SHALL BE OF SAFETY GLASS OR BURGLAR-RESISTANT GLAZING. THIS REQUIREMENT SHALL NOT EXEMPT THE SWINGING DOOR ASSEMBLY STANDARDS OF GRADE 20 OF ANSI/ ASTM F476.

1003A.5 METAL GATES. METAL GATES SHALL CONFORM TO THE FOLLOWING:
 1. LATCH BOLT PROTECTED BY A SECURITY PLATE.
 2. HINGES, BOLTS, SCREWS SHALL BE NONREMOVABLE.
 3. AREAS WITHIN 40 INCHES (1016 MM) OF LATCH MECHANISM PROTECTED BY MESH SCREEN OR APPROVED EQUAL.
 4. INTERIOR RELEASE MECHANISM PROTECTED WITH COVER.
 5. FOR ELECTRICALLY OPERATED LOCKS, SEE SECTION 1003A.2.

1003A.6 SLIDING GLASS DOORS. SLIDING GLASS DOOR ASSEMBLIES SHALL BE SO DESIGNED THAT THE DOOR CANNOT BE LIFTED FROM THE TRACK WHEN THE DOOR IS IN A LOCKED POSITION. IN ADDITION TO THE PRIMARY LOCKING DEVICE, ALL SLIDING GLASS DOORS SHALL HAVE AN AUXILIARY LOCKING DEVICE PERMANENTLY MOUNTED AND NOT ACCESSIBLE FROM THE EXTERIOR OF THE BUILDING BUT EASILY ACCESSIBLE FROM THE INTERIOR.

1003A.7 SLIDING GLASS WINDOWS. SLIDING GLASS WINDOW ASSEMBLIES SHALL BE SO DESIGNED THAT THE MOVING PANEL CANNOT BE LIFTED FROM THE TRACK WHILE IN A CLOSED POSITION.

1003A.8 PARKING AREAS. PARKING SPACE NUMBERING SHALL NOT CORRESPOND TO THE GUEST ROOM OR DWELLING UNIT NUMBER.
 EXTERIOR PARKING AREAS AND ACCESS THERETO SHALL BE PROVIDED WITH A MINIMUM OF 1/2 FOOT-CANDLE (5.38 LX) OF LIGHT ON THE PARKING SURFACE WHEN THE AREA IS UNOCCUPIED. LIGHTING DEVICES SHALL BE PROTECTED BY WEATHER- AND VANDALISM-RESISTANT

SECTION 1005A – SPECIAL APARTMENT HOUSE AND CONDOMINIUM SECURITY REQUIREMENTS

1005A.1 VOICE COMMUNICATIONS. A TWO-WAY VOICE COMMUNICATION SYSTEM SHALL BE PROVIDED BETWEEN THE COMMON ENTRY DOOR AND ALL INTERIOR DWELLING UNITS. ALL SYSTEMS SHALL PROVIDE DIRECT COMMUNICATION.

1005A.2 LIGHTING. LIGHTING SHALL BE A MINIMUM OF 1/2 FOOT-CANDLE (5.38 LX) OF LIGHT ON THE GROUND SURFACE FROM THE STREET TO THE ENTRY DOOR. LIGHTING DEVICES SHALL BE PROTECTED BY WEATHER- AND VANDALISM-RESISTANT COVERS.

1005A.3 MASTER KEYING. EXTERIOR AND MAIN ENTRANCE DOOR LOCKS SHALL NOT BE ON ANY MASTER KEY SYSTEM.

1005A.4 ENTRY DOORS. ENTRY DOORS AND DOOR ASSEMBLIES SHALL COMPLY WITH THE FOLLOWING:
1005A.4.1 LOCKS SHALL BE COMBINATION 1/2-INCH (12.7 MM) THROW DEADLATCH WITH A MINIMUM 1-INCH (25.4 MM) THROW DEADBOLT, AND SO CONSTRUCTED THAT BOTH THE DEADLATCH AND DEADBOLT RETRACT SIMULTANEOUSLY BY KNOB OR LEVER. THE DEADBOLT SHALL HAVE THE ABILITY TO BE THROWN FROM THE EXTERIOR.
1005A.5 EXIT DOORS. ALL EXIT DOORS FROM CORRIDORS TO EXIT STAIRWAYS AND FROM INTERIOR STAIRWELLS AND INTERIOR FIRE ESCAPES SHALL MEET THE REQUIREMENTS OF GRADE 20 OF ANSI/ ASTM F476 AND BE CONTINUOUSLY LOCKED FROM THE OUTSIDE.
 LOCKING DEVICES SHALL BE SELF-LATCHING OR SELF-LOCKING AND SHALL BE OPENABLE FROM THE INTERIOR WITH NO SPECIAL EFFORT OR KNOWLEDGE OR KEY. [SEE SECTION 1008.1.9.]

1005A.6 GLAZED OPENINGS. GLAZED OPENINGS ACCESSIBLE FROM THE GROUND LEVEL, BY STAIRS, RAMP, PARKING LOTS OR GARAGE AREAS, SHALL BE WITH APPROVED SAFETY GLASS OR BURGLAR-RESISTANT GLAZING AS DEFINED IN SECTION 1002A. PROTECTIVE IRON GRILL WORK MAY ONLY BE INSTALLED WHERE IT DOES NOT INTERFERE WITH THE REQUIRED MEANS OF EGRESS.

1005A.7 ROOF OPENINGS. ALL SKYLIGHTS LEADING DIRECTLY TO INTERIOR CORRIDORS, STAIRWELLS, DWELLING UNITS AND UTILITY ROOMS SHALL BE PROVIDED WITH BURGLARY-RESISTANT GLAZING AS DEFINED IN SECTION 1002A.

1005A.8 GARAGE DOORS. ALL DOORS OF THE SECTIONAL OVERHEAD, ONE-PIECE OVERHEAD, SWING OR SLIDING TYPES USED ON THE EXTERIOR OF A BUILDING SHALL CONFORM TO THE FOLLOWING STANDARDS:
1005A.8.1 PANELS OF WOOD DOORS SHALL BE AT LEAST 5/16-INCH (7.94 MM) THICK, EXCEPT SECTIONAL OVERHEAD DOORS MAY HAVE PANELS 1/4-INCH (6.35 MM) THICK.
1005A.8.2 ALUMINUM DOORS SHALL BE CONSTRUCTED OF AT LEAST 0.025-INCH (0.635 MM) THICK SHEET ALUMINUM, RIVETED, WELDED OR BOLTED TO FRAMING MEMBERS AT LEAST 12 INCHES (305 MM) ON CENTER.
1005A.8.3 STEEL DOORS SHALL BE CONSTRUCTED OF AT LEAST 0.023-INCH (0.584 MM) THICK GALVANIZED STEEL, RIVETED, WELDED OR BOLTED TO FRAMING MEMBERS AT LEAST 12 INCHES (305 MM) ON CENTER.
1005A.8.4 FIBERGLASS SECTIONAL DOORS SHALL BE CONSTRUCTED OF FORMED FIBERGLASS PANELS OF DENSITY OF AT LEAST 5 1/2 OZ. PER SQUARE FOOT (1678 G/M²), PRESSURE SEALED TO ALUMINUM FRAMING MEMBERS.
1005A.8.5 OVERHEAD DOORS SHALL BE MADE LOCKABLE BY EITHER:
 FOR DOORS 16 FEET (4877 MM) WIDE OR LESS, A SLIDE BOLT – MINIMUM DIAMETER 3/8-INCH (9.5 MM) MINIMUM PROJECTION 1-1/2 INCHES (38 MM) – LOCKING INTO THE DOOR JAMB, CAPABLE OF UTILIZING A PADLOCK WITH A MINIMUM 9/32-INCH (7.14 MM) SHACKLE. FOR DOORS OVER 16 FEET (4877 MM) WIDE, EXCEPT SECTIONAL DOORS, TWO SLIDE BOLT LOCKS SHALL BE REQUIRED. SLIDE BOLT ASSEMBLIES SHALL BE ATTACHED TO THE DOOR WITH BOLTS WHICH ARE NONREMOVABLE FROM THE EXTERIOR.
 ELECTRICAL OPERATOR WITH AUTOMATIC LOCKING CAPABILITY, EITHER INHERENTLY IN THE MECHANISM OR AS AN ADDED FEATURE.
 BY AT LEAST ONE SINGLE-BAR LOCK MOUNTED IN THE END STILE, WITH LOCKING BAR OR BOLT EXTENDING INTO THE RECEIVING GUIDE A MINIMUM OF 1 INCH (25.4 MM), AND WITH MINIMUM FIVE-PIN TUMBLE OPERATION. FOR DOORS OVER 16 FEET (4877 MM) WIDE, EXCEPT SECTIONAL DOORS, TWO SINGLE-BAR LOCKS SHALL BE REQUIRED.
 CENTER LOCKING-HANDLE DEVICES WILL REQUIRE ACTUATING STRAPS TO BE ENCLOSED BY RIGID CONDUITS SECURELY FASTENED TO THE DOOR.
1005A.8.6 SWINGING GARAGE DOORS SHALL BE LOCKABLE BY A CYLINDER DEADBOLT.
1005A.8.7 DOORS OPERATED BY ELECTRICAL MEANS SHALL BE PROVIDED WITH MANUAL RELEASE CAPABILITY FROM THE INTERIOR, REQUIRING NO SPECIAL EFFORT OR KNOWLEDGE OR KEY.
1005A.8.8 MANUALLY OPERATED CHAIN-DRIVEN GARAGE DOORS SHALL REQUIRE APPROVAL OF THE AUTHORITY HAVING JURISDICTION.





#	date	issue
2	4.15.20	Project Revision 2
3	4.27.20	Plan Check Response 2
4	8.17.20	Plan Check Response 3

sheet count 48/49

Window Schedule Security Requirements

project:	16.15
drawn by:	mka
checked by:	jp
date:	01.21.19
scale:	

A-10.1

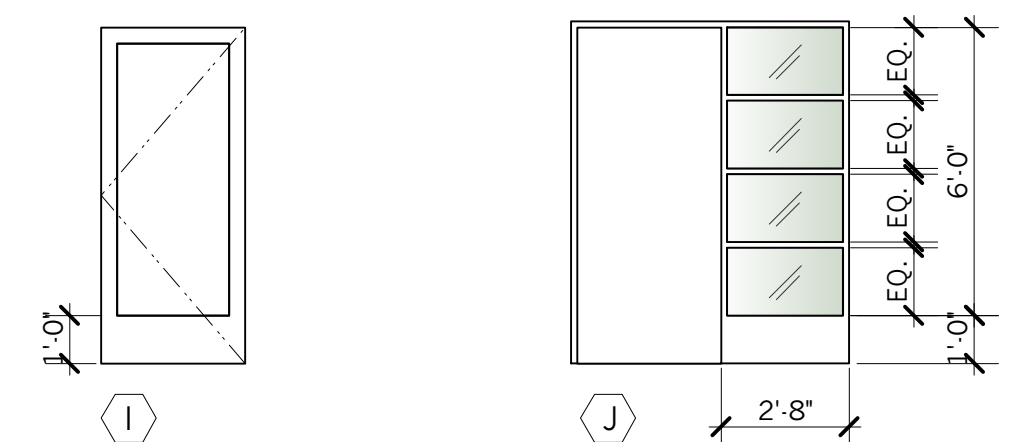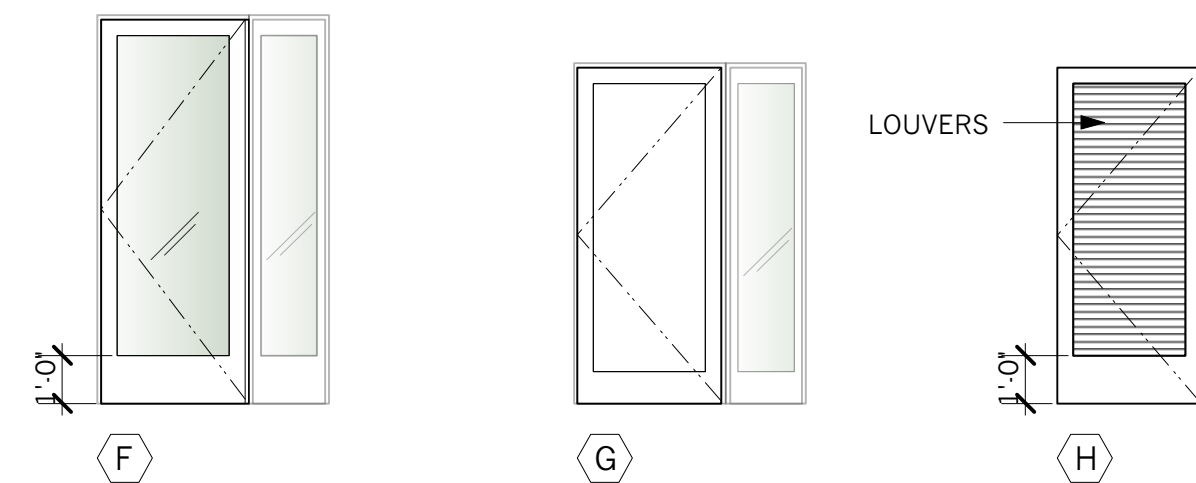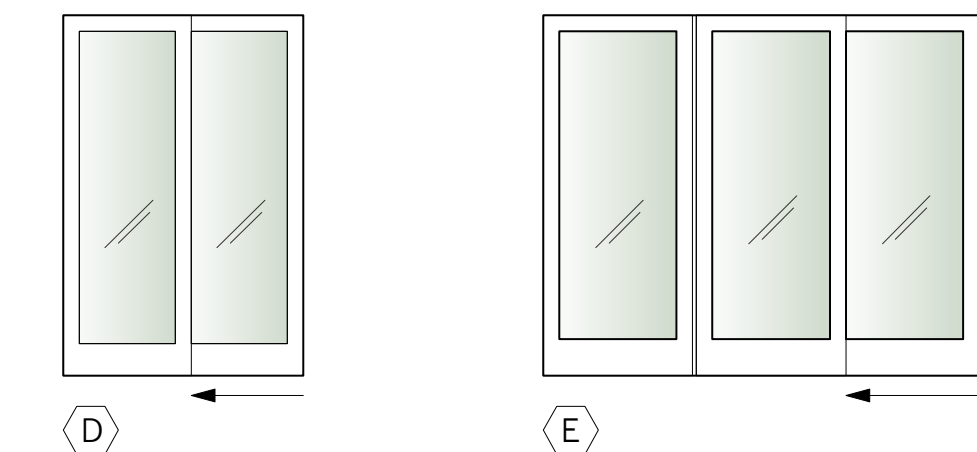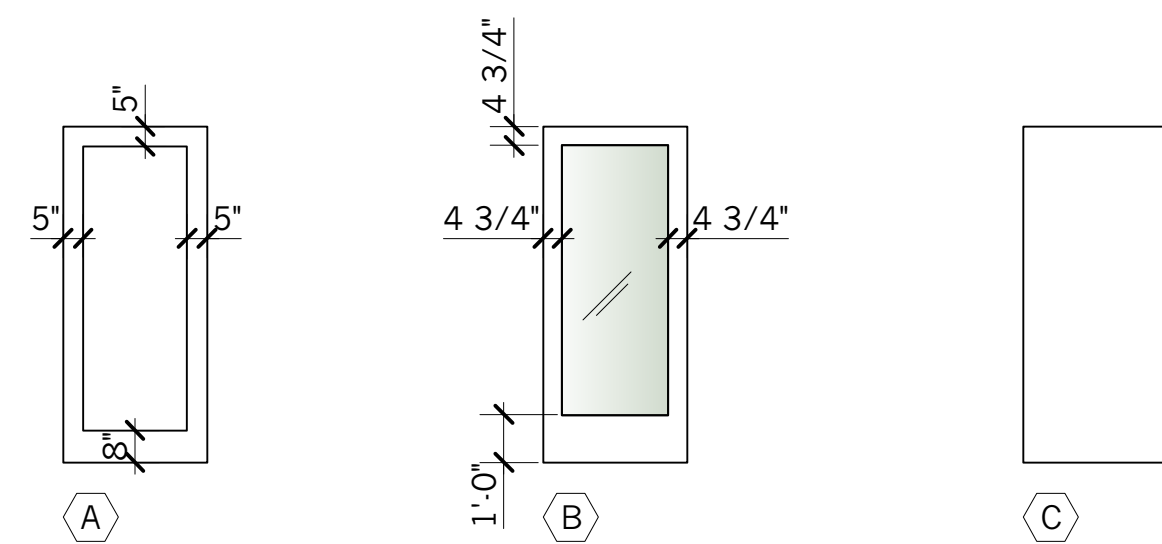

1 DOOR TYPES
Scale: 1/4" = 1'-0"

GENERAL NOTES:

- ALL DOORS TO BE UNDERCUT FOR FLOOR FINISH
- ALL DOORS TO BE PRIMED OR SEALED ALL EDGES PRIOR TO HANGING
- ALL DOOR GLASS TO BE CLEAR TEMPERED, U.O.N.
- REFER TO ELEVATION FOR PANEL & MULLION DESIGN
- HARDWARE TO BE: BALDWIN, OMNIA, EMTEK OR SIM.
- ALL EXTERIOR DOORS TO HAVE FULL PERIMETER WEATHERSTRIPPING AND INTERLOCKING THRESHOLDS
- ALL EXTERIOR DOORS TO HAVE FULL PERIMETER WEATHERSTRIPPING AND INTERLOCKING THRESHOLDS
- ALL RATED INTERIOR DOORS TO HAVE FULL PERIMETER SMOKE SEAL FOR GENERAL AND SPECIAL SECURITY REQUIREMENTS SEE A-10.1

DOOR SCHEDULE

Door		Type			Door	Frame	Rating	Rating	Hardware	Remarks		
ID	Location	Width	Height	Thk	Material	Glazing	Door	Frame	Set			
FIRST FLOOR												
100-01	ENTRY - RESIDENTIAL	3'0"	8'0"	1 3/4"	TYPE B: FRENCH - SWING	ALUM.	DBL. GLZD. LAM.	ALUM.	ENTRY	ADA THRESHOLD, CLOSER, SIDELIGHT		
100-02	STAIR #2	3'0"	7'0"	1 3/4"	TYPE A: SINGLE PANEL - SWING	H.M.	-	H.M.	PASSAGE	CLOSER		
100-03	ELEVATOR	3'6"	7'0"	-	-	-	-	-	-	-		
100-04	ELEVATOR SMOKE DOOR	3'6"	7'0"	1 3/4"	TYPE C: FLUSH PANEL - SWING	H.M.	-	H.M.	PASSAGE	MAGNETIC HOLD OPEN, SMOKE SEAL		
100-05	VESTIBULE	3'0"	7'0"	1 3/4"	TYPE A: SINGLE PANEL - SWING	H.M.	-	H.M.	PASSAGE	CLOSER		
100-06	ELEVATOR EQUIPMENT	3'0"	7'0"	1 3/4"	TYPE C: FLUSH PANEL - SWING	H.M.	-	H.M.	PASSAGE	CLOSER		
100-07	TRASH ROOM	3'0"	7'0"	1 3/4"	TYPE C: FLUSH PANEL - SWING	H.M.	-	H.M.	PASSAGE	CLOSER		
100-08	BICYCLE PARKING	3'0"	7'0"	1 3/4"	TYPE C: FLUSH PANEL - SWING	H.M.	-	H.M.	ENTRY	CLOSER		
100-09	COMMERCIAL/STAIR #1	3'0"	7'0"	1 3/4"	TYPE A: FLUSH PANEL - SWING	H.M.	-	H.M.	PASSAGE	CLOSER		
100-10	STAIR #1	3'0"	8'0"	1 3/4"	TYPE A: FLUSH PANEL - SWING	H.M.	-	H.M.	PASSAGE	ADA THRESHOLD, CLOSER		
100-11	ENTRY COMMERCIAL	3'0"	8'0"	1 3/4"	TYPE B: FRENCH - SWING	ALUM.	DBL. GLZD. LAM.	ALUM.	ENTRY	ADA THRESHOLD, CLOSER, STOREFRONT		
100-12	ELECTRICAL ROOM	3'0"	8'0"	1 3/4"	TYPE A: FLUSH PANEL - SWING	ALUM.	-	ALUM.	ENTRY	CLOSER		
100-13	STAIR #2/PATIO	3'0"	7'0"	1 3/4"	TYPE C: SINGLE PANEL - SWING	H.M.	-	H.M.	PASSAGE	CLOSER		
SECOND FLOOR												
200-01	STAIR #1	3'0"	7'0"	1 3/4"	TYPE A: SINGLE PANEL - SWING	MDF	-	H.M.	90 MIN.	90 MIN.	PASSAGE	CLOSER
200-02	STAIR #2	3'0"	7'0"	1 3/4"	TYPE A: SINGLE PANEL - SWING	MDF	-	H.M.	90 MIN.	90 MIN.	PASSAGE	CLOSER
200-03	ELEVATOR	3'6"	7'0"	-	-	-	-	-	-	-	-	
200-04	ELEVATOR SMOKE DOOR	3'6"	7'0"	1 3/4"	TYPE C: FLUSH PANEL - SWING	H.M.	-	H.M.	PASSAGE	MAGNETIC HOLD OPEN, SMOKE SEAL		
201-01	UNIT #201 - ENTRY	3'0"	7'0"	1 3/4"	TYPE A: SINGLE PANEL - SWING	MDF	-	H.M.	45 MIN.	45 MIN.	ENTRY	DEAD BOLT, CLOSER, VIEWER, 26 STC MIN.
201-02	UNIT #201 - BATH	3'0"	7'0"	1 3/8"	TYPE A: SINGLE PANEL - SWING	MDF	-	WOOD	45 MIN.	45 MIN.	PRIVACY	DEAD BOLT, CLOSER, VIEWER, 26 STC MIN.
202-01	UNIT #202 - ENTRY	3'0"	7'0"	1 3/4"	TYPE A: SINGLE PANEL - SWING	MDF	-	H.M.	45 MIN.	45 MIN.	ENTRY	DEAD BOLT, CLOSER, VIEWER, 26 STC MIN.
202-02	UNIT #202 - BATH	3'0"	7'0"	1 3/8"	TYPE A: SINGLE PANEL - SWING	MDF	-	WOOD	45 MIN.	45 MIN.	PRIVACY	DEAD BOLT, CLOSER, VIEWER, 26 STC MIN.
203-01	UNIT #203 - ENTRY	3'0"	7'0"	1 3/4"	TYPE A: SINGLE PANEL - SWING	MDF	-	H.M.	45 MIN.	45 MIN.	ENTRY	DEAD BOLT, CLOSER, VIEWER, 26 STC MIN.
203-02	UNIT #203 - BATH	3'0"	7'0"	1 3/8"	TYPE A: SINGLE PANEL - SWING	MDF	-	WOOD	45 MIN.	45 MIN.	PRIVACY	DEAD BOLT, CLOSER, VIEWER, 26 STC MIN.
204-01	UNIT #204 - ENTRY	3'0"	7'0"	1 3/4"	TYPE A: SINGLE PANEL - SWING	MDF	-	H.M.	45 MIN.	45 MIN.	ENTRY	DEAD BOLT, CLOSER, VIEWER, 26 STC MIN.
204-02	UNIT #204 - BATH	3'0"	7'0"	1 3/8"	TYPE A: SINGLE PANEL - SWING	MDF	-	WOOD	45 MIN.	45 MIN.	PRIVACY	DEAD BOLT, CLOSER, VIEWER, 26 STC MIN.
205-01	UNIT #205 - ENTRY	3'0"	7'0"	1 3/4"	TYPE A: SINGLE PANEL - SWING	MDF	-	H.M.	20 MIN.	20 MIN.	ENTRY	DEAD BOLT, CLOSER, VIEWER, 26 STC MIN.
205-02	UNIT #205 - BATH	3'0"	7'0"	1 3/8"	TYPE A: SINGLE PANEL - SWING	MDF	-	WOOD	-	-	PRIVACY	ADA THRESHOLD
205-03	UNIT #205 - PATIO	8'0"	8'0"	1 3/4"	TYPE D: FRENCH - SLIDING	ALUM.	DBL. GLZD. TEMP.	ALUM.	-	-	PRIVACY	ADA THRESHOLD
206-01	UNIT #206 - ENTRY	3'0"	7'0"	1 3/4"	TYPE A: SINGLE PANEL - SWING	MDF	-	H.M.	20 MIN.	20 MIN.	ENTRY	DEAD BOLT, CLOSER, VIEWER, 26 STC MIN.
206-02	UNIT #206 - BATH	3'0"	7'0"	1 3/8"	TYPE A: SINGLE PANEL - SWING	MDF	-	WOOD	-	-	PRIVACY	ADA THRESHOLD
206-03	UNIT #206 - PATIO	8'0"	8'0"	1 3/4"	TYPE D: FRENCH - SLIDING	ALUM.	DBL. GLZD. TEMP.	ALUM.	-	-	PRIVACY	ADA THRESHOLD
207-01	UNIT #207 - ENTRY	3'0"	7'0"	1 3/4"	TYPE A: SINGLE PANEL - SWING	MDF	-	H.M.	20 MIN.	20 MIN.	ENTRY	DEAD BOLT, CLOSER, VIEWER, 26 STC MIN.
207-02	UNIT #207 - BATH	3'0"	7'0"	1 3/8"	TYPE A: SINGLE PANEL - POCKET	MDF	-	WOOD	-	-	PRIVACY	-
206-03	UNIT #207 - PATIO	8'0"	8'0"	1 3/4"	TYPE D: FRENCH - SLIDING	ALUM.	DBL. GLZD. TEMP.	ALUM.	-	-	PRIVACY	ADA THRESHOLD
THIRD FLOOR												
300-01	STAIR #1	3'0"	7'0"	1 3/4"	TYPE A: SINGLE PANEL - SWING	MDF	-	H.M.	90 MIN.	90 MIN.	PASSAGE	CLOSER
300-02	STAIR #2	3'0"	7'0"	1 3/4"	TYPE A: SINGLE PANEL - SWING	MDF	-	H.M.	90 MIN.	90 MIN.	PASSAGE	CLOSER
300-03	ELEVATOR	3'6"	7'0"	-	-	-	-	-	-	-	-	
300-04	ELEVATOR SMOKE DOOR	3'6"	7'0"	1 3/4"	TYPE C: FLUSH PANEL - SWING	H.M.	-	H.M.	PASSAGE	MAGNETIC HOLD OPEN, SMOKE SEAL		
301-01	UNIT #301 - ENTRY	3'0"	7'0"	1 3/4"	TYPE A: SINGLE PANEL - SWING	MDF	-	H.M.	20 MIN.	20 MIN.	ENTRY	DEAD BOLT, CLOSER, VIEWER, 26 STC MIN.
301-02	UNIT #301 - BATH	3'0"	7'0"	1 3/8"	TYPE A: SINGLE PANEL - SWING	MDF	-	WOOD	-	-	PRIVACY	DEAD BOLT, CLOSER, VIEWER, 26 STC MIN.
302-01	UNIT #302 - ENTRY	3'0"	7'0"	1 3/4"	TYPE A: SINGLE PANEL - SWING	MDF	-	H.M.	20 MIN.	20 MIN.	ENTRY	DEAD BOLT, CLOSER, VIEWER, 26 STC MIN.
302-02	UNIT #302 - BATH	3'0"	7'0"	1 3/8"	TYPE A: SINGLE PANEL - SWING	MDF	-	WOOD	-	-	PRIVACY	DEAD BOLT, CLOSER, VIEWER, 26 STC MIN.
303-01	UNIT #303 - ENTRY	3'0"	7'0"	1 3/4"	TYPE A: SINGLE PANEL - SWING	MDF	-	H.M.	20 MIN.	20 MIN.	ENTRY	DEAD BOLT, CLOSER, VIEWER, 26 STC MIN.
303-02	UNIT #303 - BATH	3'0"	7'0"	1 3/8"	TYPE A: SINGLE PANEL - SWING	MDF	-	WOOD	-	-	PRIVACY	DEAD BOLT, CLOSER, VIEWER, 26 STC MIN.
304-01	UNIT #304 - ENTRY	3'0"	7'0"	1 3/4"	TYPE A: SINGLE PANEL - SWING	MDF	-	H.M.	20 MIN.	20 MIN.	ENTRY	DEAD BOLT, CLOSER, VIEWER, 26 STC MIN.
304-02	UNIT #304 - BATH	3'0"	7'0"	1 3/8"	TYPE A: SINGLE PANEL - SWING	MDF	-	WOOD	-	-	PRIVACY	DEAD BOLT, CLOSER, VIEWER, 26 STC MIN.
305-01	UNIT #305 - ENTRY	3'0"	7'0"	1 3/4"	TYPE A: SINGLE PANEL - SWING	MDF	-	H.M.	20 MIN.	20 MIN.	ENTRY	DEAD BOLT, CLOSER, VIEWER, 26 STC MIN.
305-02	UNIT #305 - BATH	3'0"	7'0"	1 3/8"	TYPE A: SINGLE PANEL - SWING	MDF	-	WOOD	-	-	PRIVACY	DEAD BOLT, CLOSER, VIEWER, 26 STC MIN.
306-01	UNIT #306 - ENTRY	3'0"	7'0"	1 3/4"	TYPE A: SINGLE PANEL - SWING	MDF	-	H.M.	20 MIN.	20 MIN.	ENTRY	DEAD BOLT, CLOSER, VIEWER, 26 STC MIN.
306-02	UNIT #306 - BATH	3'0"	7'0"	1 3/8"	TYPE A: SINGLE PANEL - SWING	MDF	-	WOOD	-	-	PRIVACY	DEAD BOLT, CLOSER, VIEWER, 26 STC MIN.
307-01	UNIT #307 - ENTRY	3'0"	7'0"	1 3/4"	TYPE A: SINGLE PANEL - SWING	MDF	-	H.M.	20 MIN.	20 MIN.	ENTRY	DEAD BOLT, CLOSER, VIEWER, 26 STC MIN.
307-01	UNIT #307 - BATH	3'0"	7'0"	1 3/8"	TYPE A: SINGLE PANEL - POCKET	MDF	-	WOOD	-	-	PRIVACY	-
FOURTH FLOOR												
400-01	STAIR #1	3'0"	7'0"	1 3/4"	TYPE A: SINGLE PANEL - SWING	MDF	-	H.M.	90 MIN.	90 MIN.	PASSAGE	CLOSER
400-02	STAIR #2	3'0"	7'0"	1 3/4"	TYPE A: SINGLE PANEL - SWING	MDF	-	H.M.	90 MIN.	90 MIN.	PASSAGE	CLOSER
400-03	ELEVATOR	3'6"	7'0"	-	-	-	-	-	-	-	-	
400-04	ELEVATOR SMOKE DOOR	3'6"	7'0"	1 3/4"	TYPE C: FLUSH PANEL - SWING	H.M.	-	H.M.	PASSAGE	MAGNETIC HOLD OPEN, SMOKE SEAL		
401-01	UNIT #401 - ENTRY	3'0"	7'0"	1 3/4"	TYPE A: SINGLE PANEL - SWING	MDF	-	H.M.	20 MIN.	20 MIN.	ENTRY	DEAD BOLT, CLOSER, VIEWER, 26 STC MIN.
401-02	UNIT #401 - BATH	3'0"	7'0"	1 3/8"	TYPE A: SINGLE PANEL - SWING	MDF	-	WOOD	-	-	PRIVACY	DEAD BOLT, CLOSER, VIEWER, 26 STC MIN.
402-01	UNIT #402 - ENTRY	3'0"	7'0"	1 3/4"	TYPE A: SINGLE PANEL - SWING	MDF	-	H.M.	20 MIN.	20 MIN.	ENTRY	DEAD BOLT, CLOSER, VIEWER, 26 STC MIN.
402-02	UNIT #402 - BATH	3'0"	7'0"	1 3/8"	TYPE A: SINGLE PANEL - SWING	MDF	-	WOOD	-	-	PRIVACY	DEAD BOLT, CLOSER, VIEWER, 26 STC MIN.
403-01	UNIT #403 - ENTRY	3'0"	7'0"	1 3/4"	TYPE A: SINGLE PANEL - SWING	MDF	-	H.M.	20 MIN.	20 MIN.	ENTRY	DEAD BOLT, CLOSER, VIEWER, 26 STC MIN.
403-02	UNIT #403 - BATH	3'0"	7'0"	1 3/8"	TYPE A: SINGLE PANEL - SWING	MDF	-	WOOD	-	-	PRIVACY	DEAD BOLT, CLOSER, VIEWER, 26 STC MIN.
404-01	UNIT #404 - ENTRY	3'0"	7'0"	1 3/4"	TYPE A: SINGLE PANEL - SWING	MDF	-	H.M.	20 MIN.	20 MIN.	ENTRY	DEAD BOLT, CLOSER, VIEWER, 26 STC MIN.
404-02	UNIT #404 - BATH	3'0"	7'0"	1 3/8"	TYPE A: SINGLE PANEL - SWING	MDF	-	WOOD	-	-	PRIVACY	DEAD BOLT, CLOSER, VIEWER, 26 STC MIN.
405-01	UNIT #405 - ENTRY	3'0"	7'0"	1 3/4"	TYPE A: SINGLE PANEL - SWING	MDF	-	H.M.	20 MIN.	20 MIN.	ENTRY	DEAD BOLT, CLOSER, VIEWER, 26 STC MIN.
405-02	UNIT #405 - BATH	3'0"	7'0"	1 3/8"	TYPE A: SINGLE PANEL - SWING	MDF	-	WOOD	-	-	PRIVACY	DEAD BOLT, CLOSER, VIEWER, 26 STC MIN.
406-01	UNIT #406 - ENTRY	3'0"	7'0"	1 3/4"	TYPE A: SINGLE PANEL - SWING	MDF	-	H.M.	20 MIN.	20 MIN.	ENTRY	DEAD BOLT, CLOSER, VIEWER, 26 STC MIN.
406-02	UNIT #406 - BATH	3'0"	7'0"	1 3/8"	TYPE A: SINGLE PANEL - SWING	MDF	-	WOOD	-	-	PRIVACY	DEAD BOLT, CLOSER, VIEWER, 26 STC MIN.
407-01	UNIT #407 - ENTRY	3'0"	7'0"	1 3/4"	TYPE A: SINGLE PANEL - SWING	MDF	-	H.M.	20 MIN.	20 MIN.	ENTRY	DEAD BOLT, CLOSER, VIEWER, 26 STC MIN.
407-01	UNIT #407 - BATH	3'0"	7'0"	1 3/8"	TYPE A: SINGLE PANEL - POCKET	MDF	-	WOOD	-	-	PRIVACY	-
FIFTH FLOOR												
500-01	STAIR #1	3'0"	7'0"	1 3/4"	TYPE A: SINGLE PANEL - SWING	MDF	-	H.M.	90 MIN.	90 MIN.	PASSAGE	CLOSER
500-02	STAIR #2	3'0"	7'0"	1 3/4"	TYPE A: SINGLE PANEL - SWING	MDF	-	H.M.	90 MIN.	90 MIN.	PASSAGE	CLOSER
500-03	ELEVATOR	3'6"	7'0"	-	-	-	-	-	-	-	-	
500-04	ELEVATOR SMOKE DOOR	3'6"	7'0"	1 3/4"	TYPE C: FLUSH PANEL - SWING	H.M.	-	H.M.	PASSAGE	MAGNETIC HOLD OPEN, SMOKE SEAL		
501-01	UNIT #501 - ENTRY	3'0"	7'0"	1 3/4"	TYPE A: SINGLE PANEL - SWING	MDF	-	H.M.	20 MIN.	20 MIN.	ENTRY	DEAD BOLT, CLOSER, VIEWER, 26 STC MIN.
501-02	UNIT #501 - BATH	3'0"	7'0"	1 3/8"	TYPE A: SINGLE PANEL - SWING	MDF	-	WOOD	-	-	PRIVACY	DEAD BOLT, CLOSER, VIEWER, 26 STC MIN.
502-01	UNIT #502 - ENTRY	3'0"	7'0"	1 3/4"	TYPE A: SINGLE PANEL - SWING	MDF	-	H.M.	20 MIN.	20 MIN.	ENTRY	DEAD BOLT, CLOSER, VIEWER, 26 STC MIN.
502-02	UNIT #502 - BATH	3'0"	7'0"	1 3/8"	TYPE A: SINGLE PANEL - SWING	MDF	-	WOOD	-	-	PRIVACY	DEAD BOLT, CLOSER, VIEWER, 26 STC MIN.
503-01	UNIT #503 - ENTRY	3'0"	7'0"	1 3/4"	TYPE A: SINGLE PANEL - SWING	MDF	-	H.M.	20 MIN.	20 MIN.	ENTRY	DEAD BOLT, CLOSER, VIEWER, 26 STC MIN.
503-02	UNIT #503 - BATH	3'0"	7'0"	1 3/8"	TYPE A: SINGLE PANEL - SWING	MDF	-	WOOD	-	-	PRIVACY	DEAD BOLT, CLOSER, VIEWER, 26 STC MIN.
504-01	UNIT #504 - ENTRY	3'0"	7'0"	1 3/4"	TYPE A: SINGLE PANEL - SWING	MDF	-	H.M.	20 MIN.	20 MIN.	ENTRY	DEAD BOLT, CLOSER, VIEWER, 26 STC MIN.
504-02	UNIT #504 - BATH	3'0"	7'0"	1 3/8"	TYPE A: SINGLE PANEL - SWING	MDF	-	WOOD	-	-	PRIVACY	DEAD BOLT, CLOSER, VIEWER, 26 STC MIN.
505-01	UNIT #505 - ENTRY	3'0"	7'0"	1 3/4"	TYPE A: SINGLE PANEL - SWING	MDF	-	H.M.	20 MIN.	20 MIN.	ENTRY	DEAD BOLT, CLOSER, VIEWER, 26 STC MIN.
505-02	UNIT #505 - BATH	3'0"	7'0"	1 3/8"	TYPE A: SINGLE PANEL - SWING	MDF	-	WOOD	-	-	PRIVACY	DEAD BOLT, CLOSER, VIEWER, 26 STC MIN.
506-01	UNIT #506 - ENTRY	3'0"	7'0"	1 3/4"	TYPE A: SINGLE PANEL - SWING	MDF	-	H.M.	20 MIN.	20 MIN.	ENTRY	DEAD BOLT, CLOSER, VIEWER, 26 STC MIN.
506-02	UNIT #506 - BATH	3'0"	7'0"	1 3/8"	TYPE A: SINGLE PANEL - SWING	MDF						

COMPLIANCE WITH THE INCLUSIONARY AFFORDABLE HOUSING PROGRAM



Date: October 24, 2018
To: Applicants subject to Planning Code Section 415 and 419: *Inclusionary Affordable Housing Program*
From: San Francisco Planning Department
Re: **Compliance with the Inclusionary Affordable Housing Program**

All projects that include 10 or more dwelling units must participate in the *Inclusionary Affordable Housing Program* contained in Planning Code Sections 415 and 419. Every project subject to the requirements of Planning Code Section 415 or 419 is required to pay the Affordable Housing Fee. A project may be eligible for an Alternative to the Affordable Housing Fee. All projects that can demonstrate that they are eligible for an Alternative to the Affordable Housing Fee must provide necessary documentation to the Planning Department and Mayor's Office of Housing and Community Development.

At least 30 days before the Planning Department and/or Planning Commission can act on the project, this Affidavit for Compliance with the Inclusionary Affordable Housing Program must be completed. Please note that this affidavit is required to be included in Planning Commission packets and therefore, must comply with packet submittal guidelines.

The inclusionary requirement for a project is determined by the date that the Environmental Evaluation Application (EEA) or Project Application (PRJ) was deemed complete by the Department ("EEA/PRJ accepted date"). There are different inclusionary requirements for smaller projects (10-24 units) and larger projects (25+ units). Please use the attached charts to determine the applicable requirement. Charts 1-3 include two sections. The first section is devoted to projects that are subject to Planning Code Section 415. The second section covers projects that are located in the Urban Mixed Use (UMU) Zoning District and certain projects within the Mission Neighborhood Commercial Transit District that are subject to Planning Code Section 419. Please use the applicable form and contact Planning staff with any questions.

For projects with complete EEA's/PRJ's accepted on or after January 12, 2016, the Inclusionary Affordable Housing Program requires the provision of on-site and off-site affordable units at a mix of income levels. The number of units provided at each income level depends on the project tenure, EEA/PRJ accepted date, and the applicable schedule of on-site rate increases. Income levels are defined as a percentage of the Area Median Income (AMI), for low-income, moderate-income, and middle-income units, as shown in Chart 5. Projects with a complete EEA accepted prior to January 12, 2016 must provide the all of the inclusionary units at the low income AMI. **Any project with 25 units or more and with a complete EEA accepted between January 1, 2013 and January 12, 2016 must obtain a site or building permit by December 7, 2018, or will be subject to higher Inclusionary Housing rates and requirements. Generally, rental projects with 25 units or more be subject to an 18% on-site rate and ownership projects with 25 units or more will be subject to a 20% on-site rate.**

Summary of requirements. Please determine what requirement is applicable for your project based on the size of the project, the zoning of the property, and the date that a complete Environmental Evaluation Application (EEA) or complete Project Application (PRJ) was submitted deemed complete by Planning Staff. Chart 1-A applies to all projects throughout San Francisco with EEA's accepted prior to January 12, 2016, whereas Chart 1-B specifically addresses UMU (Urban Mixed Use District) Zoning Districts. Charts 2-A and 2-B apply to rental projects and Charts 3-A and 3-B apply to ownership projects with a complete EEA/PRJ accepted on or after January 12, 2016. Charts 4-A and 4-B apply to three geographic areas with higher inclusionary requirements: the North of Market Residential SUD, SOMA NCT, and Mission Area Plan.

The applicable requirement for projects that received a first discretionary approval prior to January 12, 2016 are those listed in the "EEA accepted before 1/1/13" column on Chart 1-A.

CHART 1-A: Inclusionary Requirements for all projects with Complete EEA accepted before 1/12/2016

	<i>Complete EEA Accepted: →</i>	<i>Before 1/1/13</i>	<i>Before 1/1/14</i>	<i>Before 1/1/15</i>	<i>Before 1/12/16</i>
On-site					
10-24 unit projects		12.0%	12.0%	12.0%	12.0%
25+ unit projects		12.0%	13.0%	13.5%	14.5%
Fee or Off-site					
10-24 unit projects		20.0%	20.0%	20.0%	20.0%
25+ unit projects at or below 120'		20.0%	25.0%	27.5%	30.0%
25+ unit projects over 120' in height *		20.0%	30.0%	30.0%	30.0%

*except buildings up to 130 feet in height located both within a special use district and within a height and bulk district that allows a maximum building height of 130 feet, which are subject to the requirements of 25+ unit projects at or below 120 feet.

CHART 1-B: Requirements for all projects in UMU Districts with Complete EEA accepted before 1/12/2016

Please note that certain projects in the SOMA Youth and Family SUD and Western SOMA SUD also rely upon UMU requirements.

	<i>Complete EEA Accepted: →</i>	<i>Before 1/1/13</i>	<i>Before 1/1/14</i>	<i>Before 1/1/15</i>	<i>Before 1/12/16</i>
On-site UMU					
Tier A 10-24 unit projects		14.4%	14.4%	14.4%	14.4%
Tier A 25+ unit projects		14.4%	15.4%	15.9%	16.4%
Tier B 10-24 unit projects		16.0%	16.0%	16.0%	16.0%
Tier B 25+ unit projects		16.0%	17.0%	17.5%	18.0%
Tier C 10-24 unit projects		17.6%	17.6%	17.6%	17.6%
Tier C 25+ unit projects		17.6%	18.6%	19.1%	19.6%
Fee or Off-site UMU					
Tier A 10-24 unit projects		23.0%	23.0%	23.0%	23.0%
Tier A 25+ unit projects		23.0%	28.0%	30.0%	30.0%
Tier B 10-24 unit projects		25.0%	25.0%	25.0%	25.0%
Tier B 25+ unit projects		25.0%	30.0%	30.0%	30.0%
Tier C 10-24 unit projects		27.0%	27.0%	27.0%	27.0%
Tier C 25+ unit projects		30.0%	30.0%	30.0%	30.0%
Land Dedication in UMU or Mission NCT					
Tier A 10-24 unit < 30K		35.0%	35.0%	35.0%	35.0%
Tier A 10-24 unit > 30K		30.0%	30.0%	30.0%	30.0%
Tier A 25+ unit < 30K		35.0%	40.0%	42.5%	45.0%
Tier A 25+ unit > 30K		30.0%	35.0%	37.5%	40.0%
Tier B 10-24 unit < 30K		40.0%	40.0%	40.0%	40.0%
Tier B 10-24 unit > 30K		35.0%	35.0%	35.0%	35.0%
Tier B 25+ unit < 30K		40.0%	45.0%	47.5%	50.0%
Tier B 25+ unit > 30K		35.0%	40.0%	42.5%	45.0%
Tier C 10-24 unit < 30K		45.0%	45.0%	45.0%	45.0%
Tier C 10-24 unit > 30K		40.0%	40.0%	40.0%	40.0%
Tier C 25+ unit < 30K		45.0%	50.0%	52.5%	55.0%
Tier C 25+ unit > 30K		40.0%	45.0%	47.5%	50.0%

CHART 2-A: Inclusionary Requirements for Rental projects with Complete EEA/PRJ accepted on or after 1/12/16

Complete EEA/PRJ Accepted BEFORE: →	1/1/18	1/1/19	1/1/20	1/1/21	1/1/22	1/1/23	1/1/24	1/1/25	1/1/26	1/1/27	1/1/28
On-site											
10-24 unit projects	12.0%	12.5%	13.0%	13.5%	14.0%	14.5%	15.0%	15.0%	15.0%	15.0%	15.0%
25+ unit projects	18.0%	19.0%	20.0%	20.5%	21.0%	21.5%	22.0%	22.5%	23.0%	23.5%	24.0%
Fee or Off-site											
10-24 unit projects	20.0%	20.0%	20.0%	20.0%	20.0%	20.0%	20.0%	20.0%	20.0%	20.0%	20.0%
25+ unit projects	30.0%	30.0%	30.0%	30.0%	30.0%	30.0%	30.0%	30.0%	30.0%	30.0%	30.0%

CHART 2-B: Requirements for Rental Projects in UMU Districts with Complete EEA/PRJ accepted on or after 1/12/16

Please note that certain projects in the SOMA Youth and Family SUD and Western SOMA SUD also rely upon UMU requirements.

Complete EEA/PRJ Accepted BEFORE: →	1/1/18	1/1/19	1/1/20	1/1/21	1/1/22	1/1/23	1/1/24	1/1/25	1/1/26	1/1/27	1/1/28
On-site UMU											
Tier A 10-24 unit projects	14.4%	14.4%	14.4%	14.4%	14.4%	14.5%	15.0%	15.0%	15.0%	15.0%	15.0%
Tier A 25+ unit projects	18.0%	19.0%	20.0%	20.5%	21.0%	21.5%	22.0%	22.5%	23.0%	23.5%	24.0%
Tier B 10-24 unit projects	16.0%	16.0%	16.0%	16.0%	16.0%	16.0%	16.0%	16.0%	16.0%	16.0%	16.0%
Tier B 25+ unit projects	18.0%	19.0%	20.0%	20.5%	21.0%	21.5%	22.0%	22.5%	23.0%	23.5%	24.0%
Tier C 10-24 unit projects	17.6%	17.6%	17.6%	17.6%	17.6%	17.6%	17.6%	17.6%	17.6%	17.6%	17.6%
Tier C 25+ unit projects	19.6%	19.6%	20.0%	20.5%	21.0%	21.5%	22.0%	22.5%	23.0%	23.5%	24.0%
Fee or Off-site UMU											
Tier A 10-24 unit projects	23.0%	23.0%	23.0%	23.0%	23.0%	23.0%	23.0%	23.0%	23.0%	23.0%	23.0%
Tier A 25+ unit projects	30.0%	30.0%	30.0%	30.0%	30.0%	30.0%	30.0%	30.0%	30.0%	30.0%	30.0%
Tier B 10-24 unit projects	25.0%	25.0%	25.0%	25.0%	25.0%	25.0%	25.0%	25.0%	25.0%	25.0%	25.0%
Tier B 25+ unit projects	30.0%	30.0%	30.0%	30.0%	30.0%	30.0%	30.0%	30.0%	30.0%	30.0%	30.0%
Tier B 25+ unit > 30K	35.0%	35.0%	35.0%	35.0%	35.0%	35.0%	35.0%	35.0%	35.0%	35.0%	35.0%
Tier C 10-24 unit < 30K	45.0%	45.0%	45.0%	45.0%	45.0%	45.0%	45.0%	45.0%	45.0%	45.0%	45.0%
Tier C 10-24 unit > 30K	40.0%	40.0%	40.0%	40.0%	40.0%	40.0%	40.0%	40.0%	40.0%	40.0%	40.0%
Tier C 25+ unit < 30K	45.0%	45.0%	45.0%	45.0%	45.0%	45.0%	45.0%	45.0%	45.0%	45.0%	45.0%
Tier C 25+ unit > 30K	40.0%	40.0%	40.0%	40.0%	40.0%	40.0%	40.0%	40.0%	40.0%	40.0%	40.0%

CHART 3-A: Inclusionary Requirements for Owner projects with Complete EEA/PRJ accepted on or after 1/12/16

Complete EEA/PRJ Accepted BEFORE: →	1/1/18	1/1/19	1/1/20	1/1/21	1/1/22	1/1/23	1/1/24	1/1/25	1/1/26	1/1/27	1/1/28
On-site											
10-24 unit projects	12.0%	12.5%	13.0%	13.5%	14.0%	14.5%	15.0%	15.0%	15.0%	15.0%	15.0%
25+ unit projects	20.0%	21.0%	22.0%	22.5%	23.0%	23.5%	24.0%	24.5%	25.0%	25.5%	26.0%
Fee or Off-site											
10-24 unit projects	20.0%	20.0%	20.0%	20.0%	20.0%	20.0%	20.0%	20.0%	20.0%	20.0%	20.0%
25+ unit projects	33.0%	33.0%	33.0%	33.0%	33.0%	33.0%	33.0%	33.0%	33.0%	33.0%	33.0%

CHART 3-B: Requirements for Owner Projects UMU Districts with Complete EEA/PRJ accepted on or after 1/12/16

Please note that certain projects in the SOMA Youth and Family SUD and Western SOMA SUD also rely upon UMU requirements.

Complete EEA/PRJ Accepted BEFORE: →	1/1/18	1/1/19	1/1/20	1/1/21	1/1/22	1/1/23	1/1/24	1/1/25	1/1/26	1/1/27	1/1/28
On-site UMU											
Tier A 10-24 unit projects	14.4%	14.4%	14.4%	14.4%	14.4%	14.4%	15.0%	15.0%	15.0%	15.0%	15.0%
Tier A 25+ unit projects	20.0%	21.0%	22.0%	22.5%	23.0%	23.5%	24.0%	24.5%	25.0%	25.5%	26.0%
Tier B 10-24 unit projects	16.0%	16.0%	16.0%	16.0%	16.0%	16.0%	16.0%	16.0%	16.0%	16.0%	16.0%
Tier B 25+ unit projects	20.0%	21.0%	22.0%	22.5%	23.0%	23.5%	24.0%	24.5%	25.0%	25.5%	26.0%
Tier C 10-24 unit projects	17.6%	17.6%	17.6%	17.6%	17.6%	17.6%	17.6%	17.6%	17.6%	17.6%	17.6%
Tier C 25+ unit projects	20.0%	21.0%	22.0%	22.5%	23.0%	23.5%	24.0%	24.5%	25.0%	25.5%	26.0%
Fee or Off-site UMU											
Tier A 10-24 unit projects	23.0%	23.0%	23.0%	23.0%	23.0%	23.0%	23.0%	23.0%	23.0%	23.0%	23.0%
Tier A 25+ unit projects	33.0%	33.0%	33.0%	33.0%	33.0%	33.0%	33.0%	33.0%	33.0%	33.0%	33.0%
Tier B 10-24 unit projects	25.0%	25.0%	25.0%	25.0%	25.0%	25.0%	25.0%	25.0%	25.0%	25.0%	25.0%
Tier B 25+ unit projects	33.0%	33.0%	33.0%	33.0%	33.0%	33.0%	33.0%	33.0%	33.0%	33.0%	33.0%
Tier C 10-24 unit projects	27.0%	27.0%	27.0%	27.0%	27.0%	27.0%	27.0%	27.0%	27.0%	27.0%	27.0%
Tier C 25+ unit projects	33.0%	33.0%	33.0%	33.0%	33.0%	33.0%	33.0%	33.0%	33.0%	33.0%	33.0%
Tier C 10-24 unit > 30K	40.0%	40.0%	40.0%	40.0%	40.0%	40.0%	40.0%	40.0%	40.0%	40.0%	40.0%
Tier C 25+ unit < 30K	45.0%	45.0%	45.0%	45.0%	45.0%	45.0%	45.0%	45.0%	45.0%	45.0%	45.0%
Tier C 25+ unit > 30K	40.0%	40.0%	40.0%	40.0%	40.0%	40.0%	40.0%	40.0%	40.0%	40.0%	40.0%

CHART 4-A: Inclusionary Requirements for Rental projects with Complete EEA/PRJ accepted on or after 1/12/16 located in the North of Market Residential Special Use District, the Mission Area Plan, or the SOMA Neighborhood Commercial Transit District.

<i>Complete EEA/PRJ Accepted BEFORE: →</i>	1/1/18	1/1/19	1/1/20	1/1/21	1/1/22	1/1/23	1/1/24	1/1/25	1/1/26	1/1/27	1/1/28
On-site											
10-24 unit projects	12.0%	12.5%	13.0%	13.5%	14.0%	14.5%	15.0%	15.0%	15.0%	15.0%	15.0%
25+ unit projects*	25.0%	25.0%	25.0%	25.0%	25.0%	25.0%	25.0%	25.0%	25.0%	25.0%	25.0%
Fee or Off-site											
10-24 unit projects	20.0%	20.0%	20.0%	20.0%	20.0%	20.0%	20.0%	20.0%	20.0%	20.0%	20.0%
25+ unit projects	30.0%	30.0%	30.0%	30.0%	30.0%	30.0%	30.0%	30.0%	30.0%	30.0%	30.0%

<i>Complete EEA/PRJ Accepted BEFORE: →</i>	1/1/18	1/1/19	1/1/20	1/1/21	1/1/22	1/1/23	1/1/24	1/1/25	1/1/26	1/1/27	1/1/28
On-Site: Rental Projects - North of Market Residential SUD; Mission Plan Area; SOMA NCT with 25+ units											
INCLUSIONARY RATE	25.0%	25.0%	25.0%	25.0%	25.0%	25.0%	25.0%	25.0%	25.0%	25.0%	25.0%
Low Income (55% AMI)	15.0%	15.0%	15.0%	15.0%	15.0%	15.0%	15.0%	15.0%	15.0%	15.0%	15.0%
Moderate Income (80% AMI)	5.0%	5.0%	5.0%	5.0%	5.0%	5.0%	5.0%	5.0%	5.0%	5.0%	5.0%
Middle Income (110% AMI)	5.0%	5.0%	5.0%	5.0%	5.0%	5.0%	5.0%	5.0%	5.0%	5.0%	5.0%

CHART 4-B: Inclusionary Requirements for Owner projects with Complete EEA/PRJ accepted on or after 1/12/16 located in the North of Market Residential Special Use District, the Mission Area Plan, or the SOMA Neighborhood Commercial Transit District.

<i>Complete EEA/PRJ Accepted BEFORE: →</i>	1/1/18	1/1/19	1/1/20	1/1/21	1/1/22	1/1/23	1/1/24	1/1/25	1/1/26	1/1/27	1/1/28
On-site											
10-24 unit projects	12.0%	12.5%	13.0%	13.5%	14.0%	14.5%	15.0%	15.0%	15.0%	15.0%	15.0%
25+ unit projects*	27.0%	27.0%	27.0%	27.0%	27.0%	27.0%	27.0%	27.0%	27.0%	27.0%	27.0%
Fee or Off-site											
10-24 unit projects	20.0%	20.0%	20.0%	20.0%	20.0%	20.0%	20.0%	20.0%	20.0%	20.0%	20.0%
25+ unit projects	33.0%	33.0%	33.0%	33.0%	33.0%	33.0%	33.0%	33.0%	33.0%	33.0%	33.0%

<i>Complete EEA/PRJ Accepted BEFORE: →</i>	1/1/18	1/1/19	1/1/20	1/1/21	1/1/22	1/1/23	1/1/24	1/1/25	1/1/26	1/1/27	1/1/28
On-Site: Ownership Projects - North of Market Residential SUD; Mission Plan Area; SOMA NCT with 25+ units											
INCLUSIONARY RATE	27.0%	27.0%	27.0%	27.0%	27.0%	27.0%	27.0%	27.0%	27.0%	27.0%	27.0%
Low Income (80% AMI)	15.0%	15.0%	15.0%	15.0%	15.0%	15.0%	15.0%	15.0%	15.0%	15.0%	15.0%
Moderate Income (105% AMI)	6.0%	6.0%	6.0%	6.0%	6.0%	6.0%	6.0%	6.0%	6.0%	6.0%	6.0%
Middle Income (130% AMI)	6.0%	6.0%	6.0%	6.0%	6.0%	6.0%	6.0%	6.0%	6.0%	6.0%	6.0%

CHART 5: Income Levels for Projects with a complete EEA/PRJ on or after January 12, 2016

Projects with complete EEA Application on or after January 12, 2016 are subject to the Inclusionary rates identified in Charts 2 and 3. For projects that propose on-site or off-site Inclusionary units, the Inclusionary Affordable Housing Program requires that inclusionary units be provided at three income tiers, which are split into three tiers. Annual increases to the inclusionary rate will be allocated to specific tiers, as shown below. Projects in the UMU Zoning District are not subject to the affordability levels below. Rental projects with 10-24 units shall provide all of the required Inclusionary units with an affordable rent at 55% Area Median Income (AMI), and ownership projects with 10-24 units shall provide all of the required Inclusionary units at sales price set at 80% AMI.

Complete EEA/PRJ Accepted

BEFORE: →	1/1/18	1/1/19	1/1/20	1/1/21	1/1/22	1/1/23	1/1/24	1/1/25	1/1/26	1/1/27	1/1/28
On-Site: Rental Projects with 25+ units											
INCLUSIONARY RATE	18.0%	19.0%	20.0%	20.5%	21.0%	21.5%	22.0%	22.5%	23.0%	23.5%	24.0%
Low Income (55% AMI)	10.0%	11.0%	12.0%	12.0%	12.0%	12.0%	12.0%	12.0%	12.0%	12.0%	12.0%
Moderate Income (80% AMI)	4.0%	4.0%	4.0%	4.25%	4.5%	4.75%	5.0%	5.25%	5.5%	5.75%	6.0%
Middle Income (110% AMI)	4.0%	4.0%	4.0%	4.25%	4.5%	4.75%	5.0%	5.25%	5.5%	5.75%	6.0%

Complete EEA/PRJ Accepted

BEFORE: →	1/1/18	1/1/19	1/1/20	1/1/21	1/1/22	1/1/23	1/1/24	1/1/25	1/1/26	1/1/27	1/1/28
On-Site: Ownership Projects with 25+ units											
INCLUSIONARY RATE	20.0%	21.0%	22.0%	22.5%	23.0%	23.5%	24.0%	24.5%	25.0%	25.5%	26.0%
Low Income (80% AMI)	10.0%	11.0%	12.0%	12.0%	12.0%	12.0%	12.0%	12.0%	12.0%	12.0%	12.0%
Moderate Income (105% AMI)	5.0%	5.0%	5.0%	5.25%	5.5%	5.75%	6.0%	6.25%	6.5%	6.75%	7.0%
Middle Income (130% AMI)	5.0%	5.0%	5.0%	5.25%	5.5%	5.75%	6.0%	6.25%	6.5%	6.75%	7.0%

Complete EEA/PRJ Accepted

BEFORE: →	1/1/18	1/1/19	1/1/20	1/1/21	1/1/22	1/1/23	1/1/24	1/1/25	1/1/26	1/1/27	1/1/28
Off-Site: Rental Projects with 25+ units											
INCLUSIONARY RATE	30.0%	30.0%	30.0%	30.0%	30.0%	30.0%	30.0%	30.0%	30.0%	30.0%	30.0%
Low Income (55% AMI)	18.0%	18.0%	18.0%	18.0%	18.0%	18.0%	18.0%	18.0%	18.0%	18.0%	18.0%
Moderate Income (80% AMI)	6.0%	6.0%	6.0%	6.0%	6.0%	6.0%	6.0%	6.0%	6.0%	6.0%	6.0%
Middle Income (110% AMI)	6.0%	6.0%	6.0%	6.0%	6.0%	6.0%	6.0%	6.0%	6.0%	6.0%	6.0%

Complete EEA/PRJ Accepted

BEFORE: →	1/1/18	1/1/19	1/1/20	1/1/21	1/1/22	1/1/23	1/1/24	1/1/25	1/1/26	1/1/27	1/1/28
Off-Site: Ownership Projects with 25+ units											
INCLUSIONARY RATE	33.0%	33.0%	33.0%	33.0%	33.0%	33.0%	33.0%	33.0%	33.0%	33.0%	33.0%
Low Income (80% AMI)	18.0%	18.0%	18.0%	18.0%	18.0%	18.0%	18.0%	18.0%	18.0%	18.0%	18.0%
Moderate Income (105% AMI)	8.0%	8.0%	8.0%	8.0%	8.0%	8.0%	8.0%	8.0%	8.0%	8.0%	8.0%
Middle Income (130% AMI)	7.0%	7.0%	7.0%	7.0%	7.0%	7.0%	7.0%	7.0%	7.0%	7.0%	7.0%

AFFIDAVIT

COMPLIANCE WITH THE INCLUSIONARY AFFORDABLE HOUSING PROGRAM

PLANNING CODE SECTION 415, 417 & 419



San Francisco Planning

SAN FRANCISCO PLANNING DEPARTMENT
1650 MISSION STREET, SUITE 400
SAN FRANCISCO, CA 94103-2479
MAIN: (415) 558-6378 SFPLANNING.ORG

08/11/2020

Date

I, Yola Ozturk,
do hereby declare as follows:

A The subject property is located at (address and block/lot):

42 Otis street, San Francisco, CA 94103

Address

Block 3505/ Lot 020

Block / Lot

The subject property is located within the following Zoning District:

NCT-3

Zoning District

50-X Height and Bulk District

Height and Bulk District

Special Use District, if applicable

Is the subject property located in the SOMA NCT, North of Market Residential SUD, or Mission Area Plan?

Yes No

B The proposed project at the above address is subject to the *Inclusionary Affordable Housing Program*, Planning Code Section 415 and 419 et seq.

The Planning Case Number and/or Building Permit Number is:

2016-005406PRJ

Planning Case Number

201703302802

Building Permit Number

This project requires the following approval:

- Planning Commission approval (e.g. Conditional Use Authorization, Large Project Authorization)
- Zoning Administrator approval (e.g. Variance)
- This project is principally permitted.

The Current Planner assigned to my project within the Planning Department is:

Esmeralda Jardines

Planner Name

A complete Environmental Evaluation Application or Project Application was accepted on:

01/19/2017

Date

The project contains 24 total dwelling units and/or group housing rooms.

This project is exempt from the *Inclusionary Affordable Housing Program* because:

- This project is 100% affordable.
- This project is 100% student housing.

Is this project in an UMU Zoning District within the Eastern Neighborhoods Plan Area?

Yes No

(If yes, please indicate Affordable Housing Tier)

Is this project a HOME-SF Project?

Yes No

(If yes, please indicate HOME-SF Tier)

Is this project an Analyzed or Individually Requested State Density Bonus Project?

Yes No

C Please indicate the tenure of the project.

Ownership. If affordable housing units are provided on-site or off-site, all affordable units will be sold as ownership units and will remain as ownership units for the life of the project. The applicable fee rate is the ownership fee rate.

Rental. If affordable housing units are provided on-site or off-site, all affordable units will be rental units and will remain rental units for the life of the project. The applicable fee rate is the rental fee rate.

D This project will comply with the Inclusionary Affordable Housing Program by:

Payment of the Affordable Housing Fee ~~prior to the first construction document issuance~~ ^{What we are requesting} (Planning Code Section 415.5)

On-site Affordable Housing Alternative (Planning Code Sections 415.6)

Off-site Affordable Housing Alternative (Planning Code Sections 415.7)

Combination of payment of the Affordable Housing Fee and the construction of on-site or off-site units (Planning Code Section 415.5 - required for Individually Requested State Density Bonus Projects)

Eastern Neighborhoods Alternate Affordable Housing Fee (Planning Code Section 417)

Land Dedication (Planning Code Section 419)

What is currently planned

The applicable inclusionary rate is:

in lieu fee based on 20% of GFA

On-site, off-site or fee rate as a percentage

If the method of compliance is the payment of the Affordable Housing Fee pursuant to Planning Code Section 415.5, please indicate the total residential gross floor area in the project.

11,395 GSF

Residential Gross Floor Area

E The Project Sponsor acknowledges that any change which results in the reduction of the number of on-site affordable units following the project approval shall require public notice for a hearing and approval by the Planning Commission.

F The Project Sponsor acknowledges that failure to sell or rent the affordable units or to eliminate the on-site or off-site affordable units at any time will require the Project Sponsor to:

- (1) Inform the Planning Department and the Mayor's Office of Housing and Community Development and, if applicable, fill out a new affidavit;
- (2) Record a new Notice of Special Restrictions; and
- (3) Pay the Affordable Housing Fee plus applicable interest (using the fee schedule in place at the time that the units are converted from ownership to rental units) and any applicable penalties by law.

G The Project Sponsor acknowledges that in the event that one or more rental units in the principal project become ownership units, the Project Sponsor shall notify the Planning Department of the conversion, and shall either reimburse the City the proportional amount of the Inclusionary Affordable Housing Fee equivalent to the then-current requirement for ownership units, or provide additional on-site or off-site affordable units equivalent to the then-current requirements for ownership units.

I For projects with over 25 units and with EEA's accepted between January 1, 2013 and January 12 2016, in the event that the Project Sponsor does not procure a building or site permit for construction of the principal project before December 7, 2018, rental projects will be subject to the on-site rate in effect for the Zoning District in 2017, generally 18% or 20%.

J For projects with EEA's/PRJ's accepted on or after January 12 2016, in the event that the Project Sponsor does not procure a building or site permit for construction of the principal project within 30 months of the Project's approval, the Project shall comply with the Inclusionary Affordable Housing Requirements applicable thereafter at the time the Sponsor is issued a site or building permit.

K If a Project Sponsor elects to completely or partially satisfy their Inclusionary Housing requirement by paying the Affordable Housing Fee, the Sponsor must pay the fee in full sum to the Development Fee Collection Unit at the Department of Building Inspection for use by the Mayor's Office of Housing prior to the issuance of the first construction document.

UNIT MIX TABLES

Number of All Units in PRINCIPAL PROJECT:

TOTAL UNITS:	SRO / Group Housing:	Studios:	One-Bedroom Units:	Two-Bedroom Units:	Three (or more) Bedroom Units:
24	24				

If you selected the On-site, Off-Site, or Combination Alternative, please fill out the applicable section below. The On-Site Affordable Housing Alternative is required for HOME-SF Projects pursuant to Planning Code Section 206.4. State Density Bonus Projects that have submitted an Environmental Evaluation Application prior to January 12, 2016 must select the On-Site Affordable Housing Alternative. State Density Bonus Projects that have submitted an Environmental Evaluation Application on or after to January 12, 2016 must select the Combination Affordable Housing Alternative to record the required fee on the density bonus pursuant to Planning Code Section 415.3. If the Project includes the demolition, conversion, or removal of any qualifying affordable units, please complete the Affordable Unit Replacement Section.

N/A **On-site Affordable Housing Alternative** (Planning Code Section 415.6, 419.3, or 206.4): % of the unit total.

Number of Affordable Units to be Located ON-SITE:

TOTAL UNITS:	SRO / Group Housing:	Studios:	One-Bedroom Units:	Two-Bedroom Units:	Three (or more) Bedroom Units:

LOW-INCOME	Number of Affordable Units	% of Total Units	AMI Level
MODERATE-INCOME	Number of Affordable Units	% of Total Units	AMI Level
MIDDLE-INCOME	Number of Affordable Units	% of Total Units	AMI Level

N/A **Off-site Affordable Housing Alternative** (Planning Code Section 415.7 or 419.3): % of the unit total.

Number of Affordable Units to be Located OFF-SITE:

TOTAL UNITS:	SRO / Group Housing:	Studios:	One-Bedroom Units:	Two-Bedroom Units:	Three (or more) Bedroom Units:

Area of Dwellings in Principal Project (in sq. feet):	Off-Site Project Address:	
Area of Dwellings in Off-Site Project (in sq. feet):		
Off-Site Block/Lot(s):	Motion No. for Off-Site Project (if applicable):	Number of Market-Rate Units in the Off-site Project:

AMI LEVELS:	Number of Affordable Units	% of Total Units	AMI Level
	Number of Affordable Units	% of Total Units	AMI Level
	Number of Affordable Units	% of Total Units	AMI Level

UNIT MIX TABLES: CONTINUED

N/A **Combination** of payment of a **fee, on-site affordable units, or off-site affordable units** with the following distribution:
Indicate what percent of each option will be implemented (from 0% to 99%) and the number of on-site and/or off-site below market rate units for rent and/or for sale.

1. On-Site % of affordable housing requirement.

If the project is a State Density Bonus Project, please enter "100%" for the on-site requirement field and complete the Density Bonus section below.

Number of Affordable Units to be Located ON-SITE:					
TOTAL UNITS:	SRO / Group Housing:	Studios:	One-Bedroom Units:	Two-Bedroom Units:	Three (or more) Bedroom Units:

2. Off-Site % of affordable housing requirement.

Number of Affordable Units to be Located OFF-SITE:					
TOTAL UNITS:	SRO / Group Housing:	Studios:	One-Bedroom Units:	Two-Bedroom Units:	Three (or more) Bedroom Units:
Area of Dwellings in Principal Project (in sq. feet):		Off-Site Project Address:			
Area of Dwellings in Off-Site Project (in sq. feet):					
Off-Site Block/Lot(s):		Motion No. for Off-Site Project (if applicable):		Number of Market-Rate Units in the Off-site Project:	

Income Levels for On-Site or Off-Site Units in Combination Projects:			
AMI LEVELS:	Number of Affordable Units	% of Total Units	AMI Level
AMI LEVELS:	Number of Affordable Units	% of Total Units	AMI Level
AMI LEVELS:	Number of Affordable Units	% of Total Units	AMI Level

3. Fee % of affordable housing requirement.

Is this Project a State Density Bonus Project? Yes No

If yes, please indicate the bonus percentage, up to 35% _____, and the number of bonus units and the bonus amount of residential gross floor area (if applicable) _____

I acknowledge that Planning Code Section 415.4 requires that the Inclusionary Fee be charged on the bonus units or the bonus residential floor area.

Affordable Unit Replacement: Existing Number of Affordable Units to be Demolished, Converted, or Removed for the Project					
TOTAL UNITS:	SRO / Group Housing:	Studios:	One-Bedroom Units:	Two-Bedroom Units:	Three (or more) Bedroom Units:
3	3				

This project will replace the affordable units to be demolished, converted, or removed using the following method:

- On-site Affordable Housing Alternative
- Payment of the Affordable Housing Fee ~~prior to the first construction document issuance~~ **based on 20% of residential GSF**
- Off-site Affordable Housing Alternative (Section 415.7)
- Combination of payment of the Affordable Housing Fee and the construction of on-site or off-site units (Section 415.5)

Contact Information and Declaration of Sponsor of PRINCIPAL PROJECT

March Capital Management

Company Name

Yola Ozturk

Name (Print) of Contact Person

3456 Sacramento Street

San Francisco , CA 94118

Address

City, State, Zip

415-516-7138

Yola@marchcapitalfund.com

Phone / Fax

Email

I am a duly authorized agent or owner of the subject property. I declare under penalty of perjury under the laws of the State of California that the foregoing is true and correct. I hereby declare that the information herein is accurate to the best of my knowledge and that I intend to satisfy the requirements of Planning Code Section 415 as indicated above.

Sign Here

DocuSigned by:

Yola Ozturk

A5920F942CC5445...

Signature:

Name (Print), Title:

Yola Ozturk Manager

Executed on this day in:

Location:

San Francisco

Date:

10/15/2020

Contact Information and Declaration of Sponsor of OFF-SITE PROJECT (If Different)

Company Name

Name (Print) of Contact Person

Address

City, State, Zip

Phone / Fax

Email

I hereby declare that the information herein is accurate to the best of my knowledge and that I intend to satisfy the requirements of Planning Code Section 415 as indicated above.

Sign Here

Signature:

Name (Print), Title:

From: Parinas, Suzette (CPC)
Sent: Monday, March 08, 2021 9:22 AM
To: Jardines, Esmeralda (CPC)
Subject: FW: Notice of Public Hearing - 42 Otis Street - 2021-001410CRV

Suzette Parinas

Southern Team/Current Planning Division

San Francisco Planning
49 South Van Ness Avenue, Suite 1400, San Francisco, CA 94103
Direct: 628.652.7438 | sfplanning.org
[San Francisco Property Information Map](#)

Due to COVID-19, San Francisco Planning is operating remotely, and the City's Permit Center is open on a limited basis. Our staff are available by e-mail, and the Planning and Historic Preservation Commissions are convening remotely. The public is encouraged to participate. Find more information on our services here.

From: Marvis Phillips <marvisphillips@gmail.com>
Sent: Saturday, March 6, 2021 6:09 PM
To: Parinas, Suzette (CPC) <suzette.parinas@sfgov.org>
Subject: Re: Notice of Public Hearing - 42 Otis Street - 2021-001410CRV

This message is from outside the City email system. Do not open links or attachments from untrusted sources.

While I do not blame Planning, I am starting to get tired of developers telling the residents of a community that yes, they will have units in their project for those lower income residents in their neighborhoods, then later petition Planning to get out of that agreement, and pay a fee instead, that someday years later will be used to build that lower income housing, making sure the homeless stay homeless.

Other than that, thank you for the update, I have shared with my Board and Community Partners. I am not mad at you or Planning, just developers. Marvis-D6CP

On Fri, Mar 5, 2021 at 6:45 AM Parinas, Suzette (CPC) <suzette.parinas@sfgov.org> wrote:

Good Morning:

Please see the attached notice for an item scheduled to be heard by the Planning Commission. If you have any questions about this item, please contact the planner listed on the attached notice.

Thank you,

Suzette Parinas

Southern Team/Current Planning Division

San Francisco Planning
[49 South Van Ness Avenue, Suite 1400, San Francisco, CA 94103](#)

Direct: 628.652.7438 | sfplanning.org

[San Francisco Property Information Map](#)

Due to COVID-19, San Francisco Planning is operating remotely, and the City's Permit Center is open on a limited basis. Our staff are available by e-mail, and the Planning and Historic Preservation Commissions are convening remotely. The public is encouraged to participate. Find more information on our services here.

--

Marvis J. Phillips
Board Chair
District 6 Community Planners