

SAN FRANCISCO PLANNING DEPARTMENT

Planning Commission Project Summary and Motion No.

COMMUNITY BUSINESS PRIORITY PROCESSING PROGRAM

HEARING DATE: AUGUST 30, 2018

Date Prepared: Case No.:	August 23, 2018 2018-000751CUAVAR
Project Address:	1501 CALIFORNIA STREET
Zoning:	Polk Street NCD (Neighborhood Commercial) District
	65-A Height and Bulk District
Block/Lot:	0645/001
Project Sponsor:	Elmer Lin
	2120 18th Avenue
	San Francisco, CA 94116
Staff Contact:	Mathew Chandler – (415) 575-9048
	mathew.chandler@sfgov.org

1650 Mission St. Suite 400 San Francisco, CA 94103-2479

Reception: 415.558.6378

Fax: 415.558.6409

Planning Information: **415.558.6377**

PROJECT DESCRIPTION

The project would convert 695 square feet of vacant ground level commercial space to Restaurant Use (d.b.a Akiko's Restaurant). The project has qualified for review under the Planning Commission's Community Business Priority Processing Program ("CB3P").

REQUIRED COMMISSION ACTION

Pursuant to Planning Code Section 723, Conditional Use approval is required to establish a Restaurant Use at the ground floor for properties within the Polk Street NCD.

REQUIRED ZONING ADMINISTRATOR ACTION

The project also seeks a Variance from Planning Code Section 136, from the Zoning Administrator, to permit the installation of one exterior exhaust vent extending from the tenant space to the roof. This vent will project 2 feet over the adjacent sidewalk at Larkin Street.

DECISION

Based upon information set forth in application materials submitted by the project sponsor and available in the case file (which is incorporated herein by reference as though fully set forth) and based upon the CB3P Checklist and findings below, the Commission hereby **APPROVES Conditional Use Application** **No. 2018-000751CUA** subject to conditions contained in the attached "EXHIBIT A" and in general conformance with plans on file, dated June 29, 2018, and stamped "EXHIBIT B."

CB3P CHECKLIST	R	equired Crit	eria	
	Complete & adequate	Incomplete and / or inadequate	Not required and / or not applicable	Comments (if any)
Project Sponsor's application	Х			
CB3P eligibility checklist	X			
Planning Code §101.1 findings	X			
Planning Code §303(c) findings	Х			
Planning Code §303(o) findings for Eating and Drinking Uses	x			Concentration of Eating and Drinking Uses within the vicinity will increase from 11.33% to 15.28%. The concentration of eating and drinking uses in the Polk Street NCD shall not exceed 35% of the total commercial frontage within the vicinity.
Photographs of the site and/or context	Х			
Scaled and/or dimensioned plans	Х			
Clearance under California Environmental Quality Act ("CEQA")	Х			Categorically Exempt as Class 1 Exemption

	Additional Information									
Notification Period	8/10/2018 – 8/30/2018 (20 days mailing, newspaper, and posted)									
Number and nature of public comments received	No correspondence from public									
Number of days between filing and hearing	232 Days from filing of CU request, 99 days from complete application to hearing. The									
	additional variance request requires the item to be heard on the Regular Calendar, thus									
	increasing the timeline from date of filing to hearing.									

Generalized Basis for Approval (max. one paragraph)

The Commission finds that this Project is necessary, desirable for, and compatible with the surrounding neighborhood as follows, and as set forth in Section <u>101.1</u>, <u>303(c)</u>, <u>303(o)</u>, and findings submitted as part of the application. The proposed use and character is compatible with the surrounding area and is on balance with the General Plan and Use District. Conditional Use approval to establish the Restaurant Use would activate a vacant ground floor corner commercial space which is well served by transit and pedestrian circulation, thus enhancing neighborhood-serving retail options and employment opportunities. The concentration of Eating and Drinking Uses within the vicinity would remain significantly under the permitted amount of 35%. The project has considered and aims to mitigate potential noxious or offensive noises and odors with equipment compliant with the Health Department Noise Ordinance and other applicable code requirements. Staff recommends approval with conditions.

I hereby certify that the Planning Commission ADOPTED the foregoing Motion on August 30, 2018.

AYES: NAYS: ABSENT: ADOPTED: August 30, 2018

Jonas P. Ionin Commission Secretary APPEAL AND EFFECTIVE DATE OF MOTION: Any aggrieved person may appeal this Conditional Use Authorization to the Board of Supervisors within thirty (30) days after the date of this Motion. The effective date of this Motion shall be the date of this Motion if not appealed (after the 30-day per iod has expired) OR the date of the decision of the Board of Supervisors if appealed to the Board of Supervisors.

PROTEST OF FEE OR EXACTION: You may protest any fee or exaction subject to Government Code Section 66000 that is imposed as a condition of approval by following the procedures set forth in Government Code Section 66020. The protest must satisfy the requirements of Government Code Section 66020(a) and must be filed within 90 days of the date of the first approval or conditional approval of the development referencing the challenged fee or exaction. For purposes of Government Code Section 66020, the date of imposition of the fee shall be the date of the earliest discretionary approval by the City of the subject development. If the City has not previously given Notice of an earlier discretionary approval of the project, the Planning Commission's adoption of this Motion, Resolution, Discretionary Review Action or the Zoning Administrator's Variance Decision Letter constitutes the approval or conditional approval of the development and the City hereby gives NOTICE that the 90-day protest period under Government Code Section 66020 has begun. If the City has already given Notice that the 90-day approval period has begun for the subject development, then this document does not re-commence the 90-day approval period.

EXHIBIT A

AUTHORIZATION

This authorization is for a conditional use to allow a Restaurant Use (d.b.a. **Akiko's Restaurant**) located at 1501 California Street, Lot 001 of Assessors Block 0645, pursuant to Planning Code Sections 723 and 303 within the Polk Street NCD (Neighborhood Commercial) District and a 65-A Height and Bulk District; in general conformance with plans, dated **June 29, 2018**, and stamped "EXHIBIT B" included in the docket for Case No. **2018-000751CUA** and subject to conditions of approval reviewed and approved by the Commission on **August 30, 2018** under Motion No **XXXXXX**. This authorization and the conditions contained herein run with the property and not with a particular Project Sponsor, business, or operator.

RECORDATION OF CONDITIONS OF APPROVAL

Prior to the issuance of the building permit or commencement of use for the Project, the Zoning Administrator shall approve and order the recordation of a Notice in the Official Records of the Recorder of the City and County of San Francisco for the subject property. This Notice shall state that the Project is subject to the conditions of approval contained herein and reviewed and approved by the Planning Commission on **August 30, 2018** under Motion No. **XXXXX**.

PRINTING OF CONDITIONS OF APPROVAL ON PLANS

The conditions of approval under the 'Exhibit A' of this Planning Commission Motion No. **XXXXX** shall be reproduced on the Index Sheet of construction plans submitted with the site or Building Permit Application for the Project. The Index Sheet of the construction plans shall reference to the Conditional Use authorization and any subsequent amendments or modifications.

SEVERABILITY

The Project shall comply with all applicable City codes and requirements. If any clause, sentence, section or any part of these conditions of approval is for any reason held to be invalid, such invalidity shall not affect or impair other remaining clauses, sentences, or sections of these conditions. This decision conveys no right to construct, or to receive a Building Permit. "Project Sponsor" shall include any subsequent responsible party.

CHANGES AND MODIFICATIONS

Changes to the approved plans may be approved administratively by the Zoning Administrator. Significant changes and modifications of conditions shall require Planning Commission approval of a new Conditional Use Authorization.

Conditions of Approval, Compliance, Monitoring, and Reporting PERFORMANCE

1. **Validity.** The authorization and right vested by virtue of this action is valid for three (3) years from the effective date of the Motion. The Department of Building Inspection shall have issued a

Building Permit or Site Permit to construct the project and/or commence the approved use within this three-year period.

For information about compliance, contact Code Enforcement, Planning Department at 415-575-6863, <u>www.sf-planning.org</u>

2. **Expiration and Renewal.** Should a Building or Site Permit be sought after the three (3) year period has lapsed, the project sponsor must seek a renewal of this Authorization by filing an application for an amendment to the original Authorization or a new application for Authorization. Should the project sponsor decline to so file, and decline to withdraw the permit application, the Commission shall conduct a public hearing in order to consider the revocation of the Authorization. Should the Commission not revoke the Authorization following the closure of the public hearing, the Commission shall determine the extension of time for the continued validity of the Authorization.

For information about compliance, contact Code Enforcement, Planning Department at 415-575-6863, <u>www.sf-planning.org</u>

3. **Diligent pursuit.** Once a site or Building Permit has been issued, construction must commence within the timeframe required by the Department of Building Inspection and be continued diligently to completion. Failure to do so shall be grounds for the Commission to consider revoking the approval if more than three (3) years have passed since this Authorization was approved.

For information about compliance, contact Code Enforcement, Planning Department at 415-575-6863, <u>www.sf-planning.org</u>

4. **Extension.** All time limits in the preceding three paragraphs may be extended at the discretion of the Zoning Administrator where implementation of the project is delayed by a public agency, an appeal or a legal challenge and only by the length of time for which such public agency, appeal or challenge has caused delay.

For information about compliance, contact Code Enforcement, Planning Department at 415-575-6863, <u>www.sf-planning.org</u>

5. **Conformity with Current Law.** No application for Building Permit, Site Permit, or other entitlement shall be approved unless it complies with all applicable provisions of City Codes in effect at the time of such approval.

For information about compliance, contact Code Enforcement, Planning Department at 415-575-6863, <u>www.sf-planning.org</u>

DESIGN – COMPLIANCE AT PLAN STAGE

6. **Final Materials.** The Project Sponsor shall continue to work with Planning Department on the design, including signs and awnings. Final materials, glazing, color, texture, landscaping, and detailing shall be subject to Department staff review and approval.

For information about compliance, contact the Case Planner, Planning Department at 415-558-6378, <u>www.sf-planning.org</u>

7. **Garbage, composting and recycling storage.** Space for the collection and storage of garbage, composting, and recycling shall be provided within enclosed areas on the property and clearly labeled and illustrated on the Building Permit plans. Space for the collection and storage of recyclable and compostable materials that meets the size, location, accessibility and other standards specified by the San Francisco Recycling Program shall be provided at the ground level of the buildings.

For information about compliance, contact the Case Planner, Planning Department at 415-558-6378, <u>www.sf-planning.org</u>

8. **Signs and Awnings.** Any signs on the property must have a sign permit and shall comply with the requirements of Article 6 of the Planning Code. Any awnings or canopies must have a permit and shall comply with the requirements of Planning Code Section <u>136.1</u> and be reviewed by the Department's historic preservation staff for consistency with the <u>Secretary of the Interior's</u> <u>Standards for the Treatment of Historic Properties</u>.

For information about compliance, contact Code Enforcement, Planning Department at 415-575-6863, <u>www.sf-planning.org</u>

9. **Rooftop Mechanical Equipment.** Pursuant to Planning Code 141, the Project Sponsor shall submit a roof plan to the Planning Department prior to Planning approval of the Building Permit Application if any rooftop mechanical equipment is proposed as part of the Project. Any such equipment is required to be screened so as not to be visible from any point at or below the roof level of the subject building.

For information about compliance, contact the Case Planner, Planning Department at 415-558-6378, <u>www.sf-planning.org</u>

10. **Odor Control Unit.** In order to ensure any significant noxious or offensive odors are prevented from escaping the premises once the Project is operational, the Building Permit Application to implement the project shall include air cleaning or odor control equipment details and manufacturer specifications on the plans. Odor control ducting shall not be applied to the primary façade of the building.

For information about compliance, contact the Case Planner, Planning Department at 415-558-6378, <u>www.sf-planning.org</u>

MONITORING - AFTER ENTITLEMENT

- 11. **Enforcement.** Violation of any of the Planning Department conditions of approval contained in this Motion or of any other provisions of Planning Code applicable to this Project shall be subject to the enforcement procedures and administrative penalties set forth under Planning Code Section 176 or Section 176.1. The Planning Department may also refer the violation complaints to other city departments and agencies for appropriate enforcement action under their jurisdiction. *For information about compliance, contact Code Enforcement, Planning Department at 415-575-6863, www.sf-planning.org*
- 12. **Revocation due to Violation of Conditions.** Should implementation of this Project result in complaints from interested property owners, residents, or commercial lessees which are not resolved by the Project Sponsor and found to be in violation of the Planning Code and/or the specific conditions of approval for the Project as set forth in Exhibit A of this Motion, the Zoning Administrator shall refer such complaints to the Commission, after which it may hold a public hearing on the matter to consider revocation of this authorization.

For information about compliance, contact Code Enforcement, Planning Department at 415-575-6863, <u>www.sf-planning.org</u>

OPERATION

- 1. **Eating and Drinking Uses**. As defined in Planning Code Section 202.2, Eating and Drinking Uses, as defined in Section <u>102</u>, shall be subject to the following conditions:
 - A. The business operator shall maintain the main entrance to the building and all sidewalks abutting the subject property in a clean and sanitary condition in compliance with the Department of Public Works Street and Sidewalk Maintenance Standards. In addition, the operator shall be responsible for daily monitoring of the sidewalk within a one-block radius of the subject business to maintain the sidewalk free of paper or other litter associated with the business during business hours, in accordance with Article 1, Section <u>34</u> of the San Francisco Police Code.

For information about compliance, contact the Bureau of Street Use and Mapping, Department of Public Works at 415-554-.5810, <u>http://sfdpw.org</u>.

B. When located within an enclosed space, the premises shall be adequately soundproofed or insulated for noise and operated so that incidental noise shall not be audible beyond the premises or in other sections of the building, and fixed-source equipment noise shall not exceed the decibel levels specified in the San Francisco Noise Control Ordinance.

For information about compliance of fixed mechanical objects such as rooftop air conditioning, restaurant ventilation systems, and motors and compressors with acceptable noise levels, contact the Environmental Health Section, Department of Public Health at (415) 252-3800, <u>www.sfdph.org</u>.

For information about compliance with construction noise requirements, contact the Department of Building Inspection at 415-558-6570, <u>www.sfdbi.org</u>.

For information about compliance with the requirements for amplified sound, including music and television, contact the Police Department at 415-553-0123, <u>www.sf-police.org</u>.

C. While it is inevitable that some low level of odor may be detectable to nearby residents and passersby, appropriate odor control equipment shall be installed in conformance with the approved plans and maintained to prevent any significant noxious or offensive odors from escaping the premises.

For information about compliance with odor or other chemical air pollutants standards, contact the Bay Area Air Quality Management District, (BAAQMD), 1-800-334-ODOR (6367), <u>www.baaqmd.gov</u> and Code Enforcement, Planning Department at 415-575-6863, <u>www.sf-planning.org</u>

D. Garbage, recycling, and compost containers shall be kept within the premises and hidden from public view, and placed outside only when being serviced by the disposal company. Trash shall be contained and disposed of pursuant to garbage and recycling receptacles guidelines set forth by the Department of Public Works. *For information about compliance, contact the Bureau of Street Use and Mapping, Department of*

For information about compliance, contact the Bureau of Street Use and Mapping, Department of Public Works at 415-554-.5810, <u>http://sfdpw.org</u>.


13. **Community Liaison.** Prior to issuance of a building permit to construct the project and implement the approved use, the Project Sponsor shall appoint a community liaison officer to deal with the issues of concern to owners and occupants of nearby properties. The Project Sponsor shall provide the Zoning Administrator and all registered neighborhood groups for the area with written notice of the name, business address, and telephone number of the community liaison. Should the contact information change, the Zoning Administrator and registered neighborhood groups shall be made aware of such change. The community liaison shall report to the Zoning Administrator what issues, if any, are of concern to the community and what issues have not been resolved by the Project Sponsor.

For information about compliance, contact Code Enforcement, Planning Department at 415-575-6863, <u>www.sf-planning.org</u>

14. **Lighting.** All Project lighting shall be directed onto the Project site and immediately surrounding sidewalk area only, and designed and managed so as not to be a nuisance to adjacent residents. Nighttime lighting shall be the minimum necessary to ensure safety, but shall in no case be directed so as to constitute a nuisance to any surrounding property.

For information about compliance, contact Code Enforcement, Planning Department at 415-575-6863, <u>www.sf-planning.org</u>



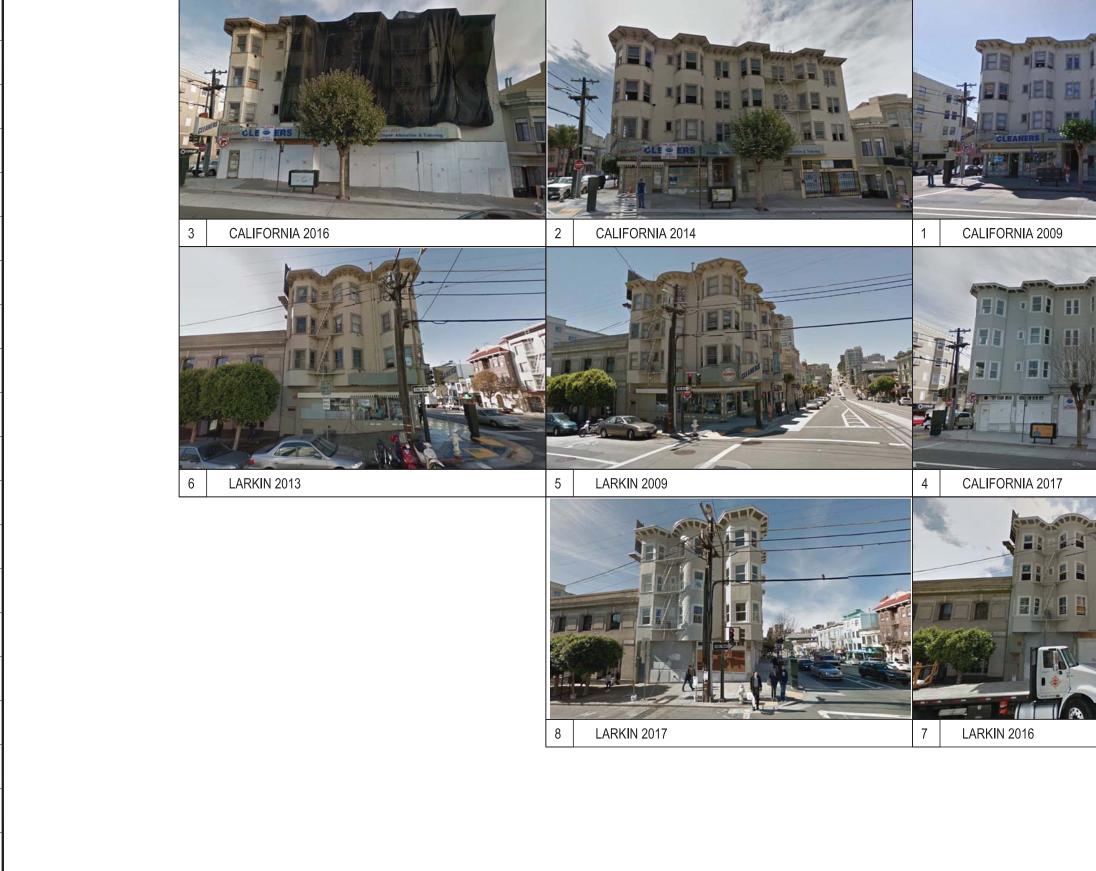

29 28 27 26 25 24 23 22 21 20 19 18 17 16 15 14 13 12 11 10 9 8 7 6 5

4 3 2 1			
		EXHIE	
		C O N S	U L T A N T
		C O N S 2120 San Fra t: 415/56;74 Info@ P	O R T I U M Elghteenth Avenue 12,515,566,1431 001500 C 484116 21,545,566,1431 001500 L 48410 R O J E C T 71 California Street ancisco, CA 94109
4 3 2 1	Sca	VARIANCE APPLICATION CU REVISION 1 CU APPLICATION Revision Code: 1501CAL le: storical Photos	05/18/18 02/23/18 12/21/17 Release


	29	28	27 26	25	24	23	22	21 20	19	18	17	16	15	14	13	12	11	10	9	8	7	6	5	
U	ABBREVIA	ATIONS					GENER	RAL NOTES							ГҮ МАР					PROJECT D		ION & CODE AI		_
		ND ESS THAN	GA. GAUGE GALV. GALVANIZED		S. SOUTH	CHITECTURAL DRAWINGS		CONSTRUCTION AND INSTA		OR CONFORM TO TH					X			ATREASURE		PROJECT DESCRIPTION		application involve aust ducting to the		






APPEC APPECA SECIEFATOR HOL	ALT. ALTERNATE HC. HCLOW CORE SPEC. SPEC. <td></td> <td></td> <td>HB.</td> <td>HOSE BIB</td> <td></td> <td></td> <td></td> <td></td> <td></td>			HB.	HOSE BIB					























MEDICINE CARINET UNF. UNF. UNF. C.M.L. CONGRETE MASONEY UNIT MCO. MEDIA MORSTRUCTION TELE UNF. UNF. UNF. UNF. C.T. CERANIC TILE MEDIA MEDIA MORSTRUCTION TILE UNF. UNF. UNF. UNF. C.T. COLUMATER MEDIA MAHOLD VET.									
















WELDED WIRE FABRIC ELE. ELEVATOR OPR. OPPOSITE WMM. WELDED WIRE FABRIC EQUP. ECOMPECTION OPP. PAD POSOTE EMERGENCY EQUP. ECOMMENT PER. PERPENDICULAR FAD. EA. SIDE EACH SIDE PER. PERPENDICULAR EA. SIDE EACH SIDE PER. PERPENDICULAR FA. FREALARM PLATE FAD. FAD. FA. FREALARM PLATE FAD. FAD. FB. FLATERAR PLWD. PLYNOOD FLYNOOD FD. FLOOR CLAN OUT PLS. PAIR FER. FEC. FRE EXTINGUISHER CABINET PRO. PROPERTY LINE <	(E)	EXISTING	NTS.	NOT TO SCALE					

























22	2	1	20	19	18	17	16	15	14	13	12	11	10		9		8		7	6	5	
7															5							
	GENERA	L NOTES							VICIN	NTY MAP					<pre></pre>			T DESCI	RIPTION &		s an applicati	
		ING AGENCIES. A				E LATEST EDITION O MENDMENTS & REC		D BY THE LOCAL TED BY GOVERNING	;				A TREASURE		È		DJECT SCRIPTI	ION			oof above an	
	SHALL IN	SPECT THE EXIS	TING PREMISES	S AND TAKE NOTE	OF EXISTING CON	IONS AND SITE CON DITIONS PRIOR TO S BLY BEEN INFERRED	UBMITTING PRICES	ERAL CONTRACTOR . NO CLAIM SHALL BI KAMINATION.	E	Musee MccWitzer 🖗	NIRMO		Terta I	Aurus Quis	(~~	<u> </u>	<u></u>	····	$\underline{}$
	3 MECHAN AND INST	ICAL, ELECTRICA	L, AND PLUMBIN	NG SYSTEMS ARE	SHOWN FOR SCHE	MATIC INTENT ONLY	7. FINAL DESIGN, DF	RAWINGS, LAYOUT,	TR		ORTH BEACH		0				SESSOF		0645-001			
	4 THE CON WORK W WHICH M	TRACTOR RECO HICH IS REQUIRI AY NOT BE SPEC	GNIZES THAT TI ED TO BE PERFO	HE PROJECT INV ORMED IN-ORDEF	OLVES ADDITIONS, AND TO PROPERLY PRO	ALTERATIONS, AND/ OVIDE A COMPLETE I SHALL BE PERFORM	OR REPAIRS TO EXI INSTALLATION OF T	ISTING FACILITIES. HE WORK, BUT		RUSSTAN HIL		RCADERQ Satisfallay	cisso - 9			AP	PLICABL DES		California Me	echanical C	e 2016 edition Code 2016 edi de 2016 editio	tion.
		D IN HIS BID.								use of Poine Ro Q	• •	Recorded							California El		de 2016 editio	
					I SIMILAR CONDITIO		N DOCUMENTS SH	ALL BE BROUGHT TO	Cutoma D. P.	Lafoyme Park	Latorna Stret	1 / L	1 1				DJECT E		EXISTING Retail:	659 SF		
	THE ATTE	ENTION OF THE F	ROJECT MANAG	GER AND THE OW	INER BEFORE PROC	EEDING WITH THE V	VORK.		Court Bird	The filmare granter	San Francisco Myseum Q of Modern Art u u Q SF Auto			\geq					RR: Total:	36 SF 695 SF	_	
	8 CONTRAG	CTOR SHALL NO	IFY GEOTECHN		FOR INSPECTION OF	FINISH FIXTURES W			irred Lades Q		SOUTH OF G	SOUTH PARK AtstPak Q							Total.	050 01		
						R TO MANUFACTURE	R FOR ACTUAL RO	UGH OPENING SIZES	S. Set 14 LOWER	HAIGHT	A.	MISSION BAY				ZO	NING		NCD-Polk St			
	10 PROVIDE	SAFETY GLAZIN	G AT ALL HAZAF	RDOUS LOCATION	NS, INCLUDING, BUT	NOTLI-AITED TO GL E IN ACCORDANCE \	AZING WITHIN 18" C	OF WALKING		Goodei	DESIGN DIST	nua -uronu					CUPANT		Retail (M-Oc			
					NENT LABEL PER CS		MITTODO SECTION	2400.3.	Theatro Q	Google	tain tr						CBC Ch le 1004.					
	12 OPENING		JR FIRE-RATED			LL BE PROTECTED V	VITH 1-OR 2-HOUR F	IRE-RATED		CEL MAP						TYP			V-B			
								HER INSTRUCTIONS.				INId			PROJEC SITE		. OF STO GHT LIN		4 / 65 - A			
	ALL PLAN	IS AND ELEVATION	INS.			E. DETAILED DRAW	INGS SHALL TAKE F	PRECEDENCE OVER	4	ен - 987		<i>øø/</i>	11 0 0717 Y	ł			E SPRIN CBC Ta	NKLERS able 4-1	Fully Sprinkle	əred		
				H, UNLESS OTHER		IG FINISH FIXTURES	WITH ARCHITECT I	IN THE FIELD					8 8 1791				0.150		TODY			
	17 INSTALL	ALL MATERIALS,	EQUIPMENT, AN			H MANUFACTURERS				1	96/42 06,		8 II 8					T DIREC	Akikos Resta	ouront		
	18 CONTRAC		E ALL NECESS		ACKING, AND FRAM	ING FOR LIGHTING F	TIXTURES, ELECTRI	CAL UNITS,	LARKIN	31/ 08%8/	* 52	81 71 81 81 A1 7 A1	EI ARVI	POLK		I IEI	NANT		431 Bush St San Franciso	reet co, Ca li forni	i a 94109	
	19 CONTRAG	CTOR SHALL BE	RESPONSIBLE F	OR PROTECTION	OF ALL EXISTING C	ONDITIONS IMMEDIA	ATELY ADJACENT TO	O PROJECT SITE AN		2 	e sum	9	<u>2</u> 1.409				ENCY		Contact: Ray City & Count		ancisco	
	20 CONTRAC	CTOR TO PROVID	E ANY NECESS	ARY TEMPORARY	SHORING OR NEW	STRUCTURE AS REG	QUIRED TO PROTEC	CT THE STABILITY		1	9 7 2 9 7 2	l l	abrea.			AG	ENGT		Dept. of Bui	ding Inspec		
	21 CONSTRI		IONS SHALL NO	T INVOLVE THE IN		EATING, WATER, OR	ELECTRICAL SERVI	ICES TO OTHER			. 8 	10000 1000 1000 1000 10	99/2a			L			1660 Missior San Francis		la 94103	
				PROTECTED FRO		INCLEMENT WEATH	IFR OR CONSTRUCT	TION		1	AINAC	CALIFO				AR	CHITEC	т	CONSORTIL 2120 18th A			
						SED BY OR RELATED			'										San Franciso Contact: Elr	co, Ca li forni		
														<u> </u>			ERGY NSULTA	ANT.	TITLE-24 DA 633 Montern P.O. Box 219 Frazier Park	ey Tr. 99		
									_													
	DRAWING	SYMBOL	6													DF	RAWING	g list				
	DRAV	VING TIT	LE Or	1 554	WING TITLE				7							rev.	dwg #	drawing	j name			
		1/4" =	1'-0" U	DRA	WING TITLE												A0.0	HISTOR	RICAL PHOTO	S		
																			CT INFORMAT		PI AN	
	A301	▶			DING SECTION ERIOR ELEVAT												A2.1	EXISTIN	NG FLOOR & F	Roof Plai		
																\vdash			SED FLOOR I SED EAST EL			
	A301			INTE	RIOR ELEVATI	DN											A4.2	PROPO	SED NORTH	ELEVATIO	Ν	
		1																				
	A301	1		DET	AIL											E						
	(C1)		GRIE	LINE																	
	D2			DOO	R NO.																	
	W2			WIN	DOW NO.											-						
	P2 L2			LIGH	MBING FIXTUR																	
	M2	1/2"			CHANDISING N											F						
	◆+18'-4 B.O. (E		-		ENSION POINT	BENCHMARK																
		-			ISION NOTE																	
				FINIS	SH TYPE																	
	ROOM NA	WE		R00	M NAME / ROO	M NUMBER																
	0-	_		DRA	WING NOTE																	
	A A			WAL	L ASSEMBLY	YPE																
	· ·																					


29 28 27 26 25 24 23 22 21 20 19 18 17 16 15 14 13 12 11 10 9 8 7 6 5

DE ANALYSIS - INTERIO		~~~~~~~~~~~~~~~~~~~~~~~~~~~~~~~~~~~~~~~	$\sim\sim\sim\sim$		AGENC`
DE ANALYSIS - INTERIC nvolves an application for a v o the roof above an existing s	arlance in Planning Sec		xterlor		HBIT B
g Code 2016 edition. nical Code 2016 edition. ing Code 2016 edition. al Code 2016 edition. 59 SF 6 SF 95 SF	California Fire Co California Energy NFPA Fire Protec San Fracnsico M. PROPOSED Kitchen + Dish: RR + Waiter: Dining + Entry: Total:	Code, 2016 editio			
incy)	No Change	cupancy)			
nt	No Change T: (415) 397-3218 W: ray@akikosre				
alifornia 94109 3 San Francisco Inspections eet alifornia 94103 eelifornia 94116	T: (415) 558-608 F: (415) 558-608 W: www.sfgov.org T: (415) 566-744 F: (415) 566-744 F: (415) 566-143 E: elmert@conso	l g/site/dbi_index.as 2 1	p	C ·	O N S U L T A N 1
in, RA, NCARB CORP. ifornia 93225	T: (800) 237-8824 F: (661) 245-6374 E: tilte24@frazm	ļ			ARCHITECT
IOOD PLAN	CU Application O O O	Planning Intake Submittal	Revised Addition		
F PLAN IS TION /ATION					ONSORTIUM 2120 Elghteenth Avenue San Francisco CA 94116 5.566.7442 (7.45.566,143) Info@consortlum-sf.com PROJECT Commercial Alterations to:
					San Francisco, CA 94109
				VARIANCE APPLICATIO	05/16/18 02/23/18 12/21/17
				No. Revision Job Code: 1501CAL Scale:	Release
				Project Information	A0.1

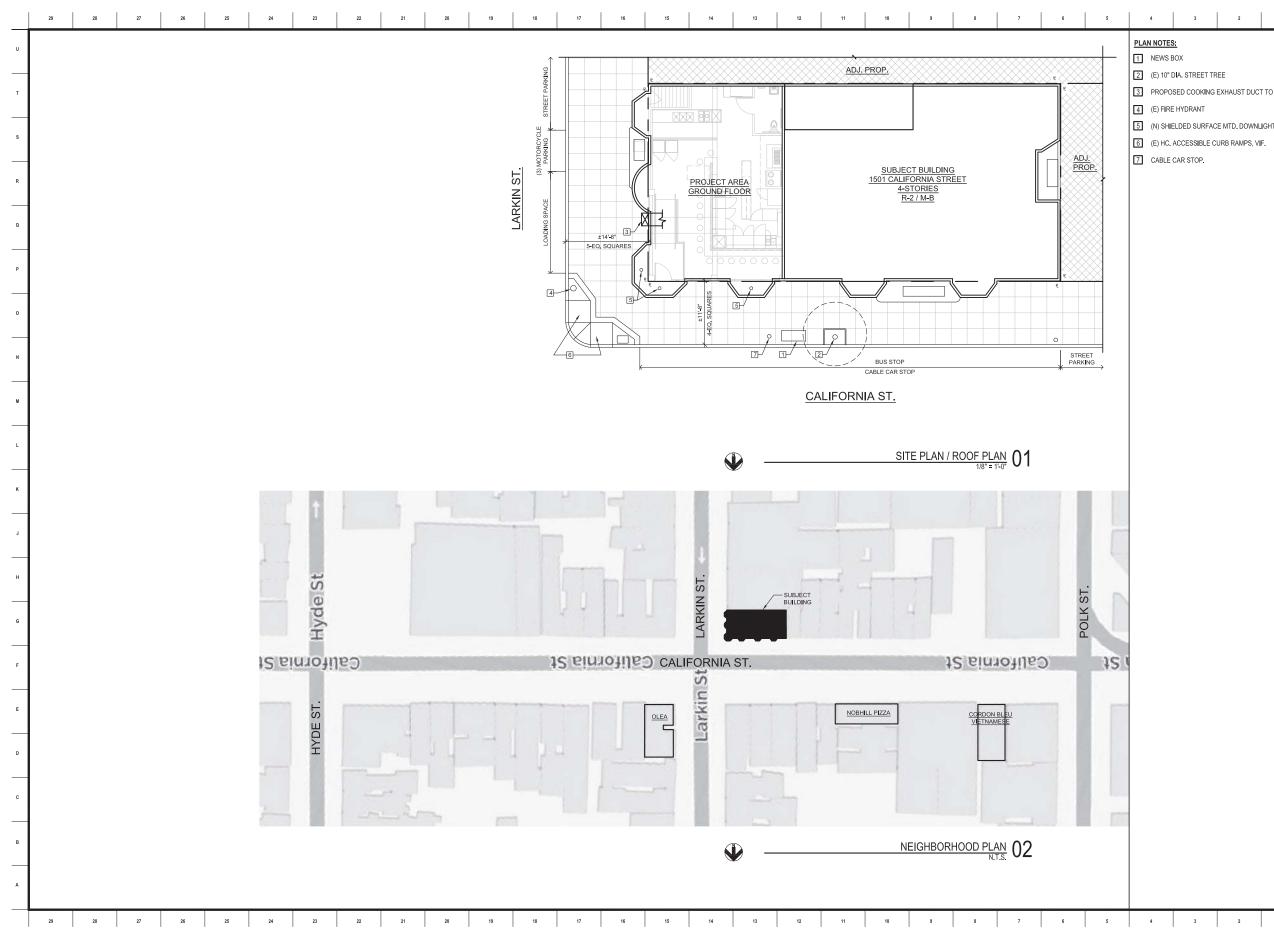


	4	3	2	1			
PLA		S:					AGENCY
	NEWS I					EXHIB	ат
		DIA. STREET TR	REE				11
						D	
-		SED COOKING	LANAUST DUC	IURUUF		B	
		E HYDRANT					
5	(N) SH	ELDED SURFAC	E MTD. DOWNL	IGHT.			
6	(E) HC.	ACCESSIBLE C	URB RAMPS, V	F.			
7	CABLE	CAR STOP.					
					-	CONS	ULTANT
						ARC	HITECT
					_	CONS	ORTIUM
						2120.6	Inhteenth Avenue
8						San Fra t. 415.566.744	ncisco CA 94116 I2 f 415.566.1431 consortlum-sf.com
					-		ROJECT
						Comme	erclal Alterations to:
						San Fr	01 California Street ancisco, CA 94109
					-		
					-		
					A	CU REVISION 1	02/23/18
						CU APPLICATION	12/21/17
					No. Job	Revision Code: 1501CAL	Release
					Sca		
					Sit	e Plan / Neighborhood Plan	A1.1
1	4	3	2	1			


. .

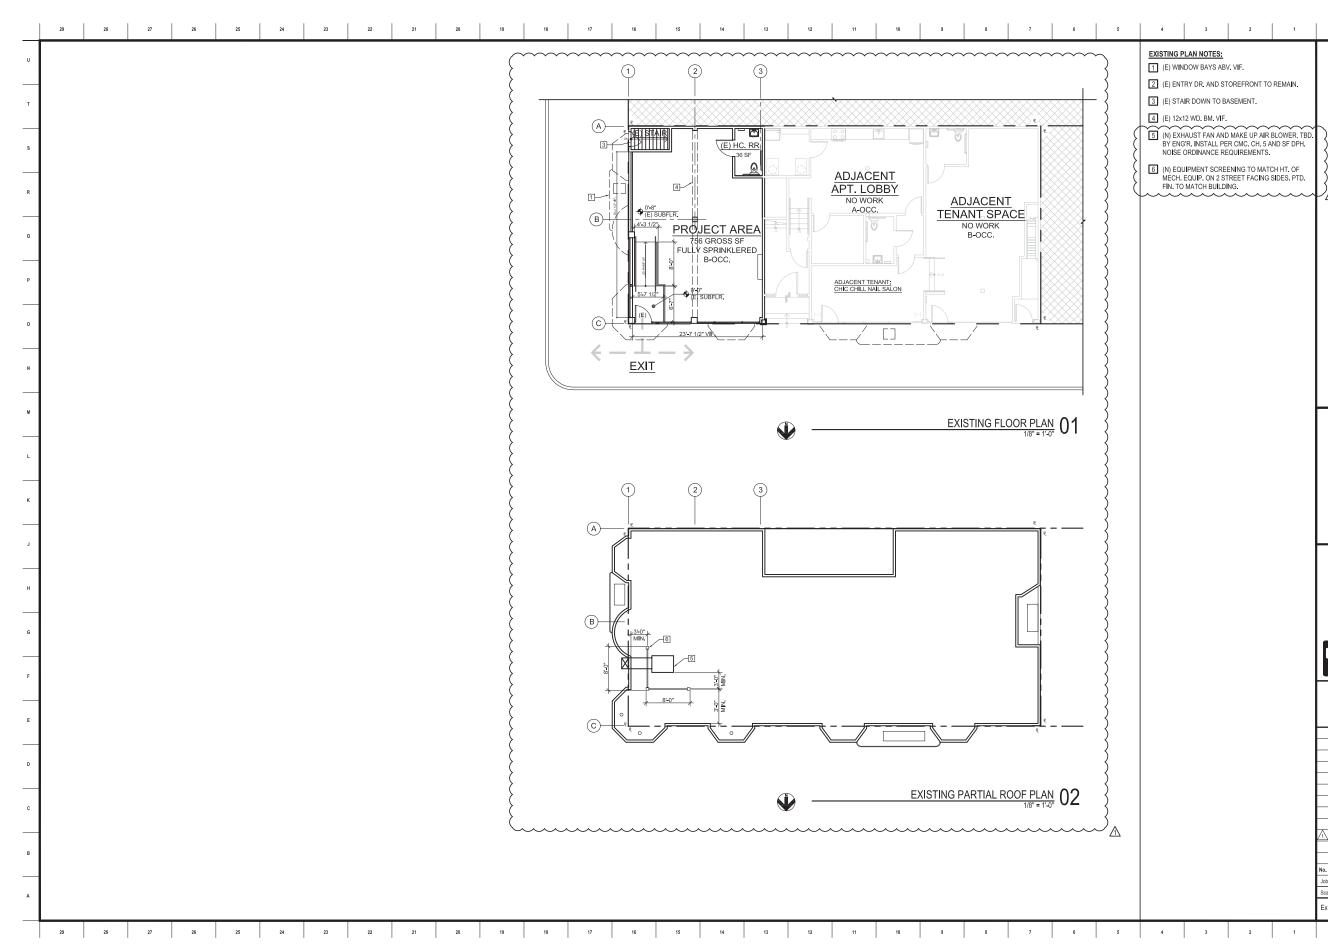

_	4	3	2		_		
	EXISTING F	LAN NOTES:					AGENCY
	1 (E) WIN	DOW BAYS AB	V. VIF.			EXHIB	IT 🗍
	2 (E) ENT	TRY DR. AND ST	OREFRONT TO	REMAIN.			
	3 (E) STA	R DOWN TO B	ASEMENT.			B	
	4 (E) 12x	12 WD. BM. VIF.					
\$	\sim	HAUST FAN ANE	\sim	BLOWER, TBD.	Þ.		
\$	BY ENG	G'R. INSTALL PE ORDINANCE RE	R CMC. CH. 5 A				
Ś		UIPMENT SCRE		CH HT. OF	{		
$\langle $	MECH.	EQUIP. ON 2 ST MATCH BUILD	FREET FACING		ΙÝ		
4			·····	~~~~	\mathcal{P}_{2}	1	
						CONS	ULTANT
						ARC	НІТЕСТ
							ORTIUM
						San Fra t: 415.566.744	Ighteenth Avenue ncisco CA 94116 2 f. 415 566 1431
							ROJECT
						Comme	rclal Alterations to:
						150	1 California Street ancisco, CA 94109
					\vdash		
					\vdash		
					\square		
					\vdash		
						CU REVISION 1 CU APPLICATION	02/23/18
					No.	Revision	Release
					Job Sca	Code: 1501CAL e:	
						sting Floor & Roof Plan	A2.1
_							/ \
	4	3	2	1			

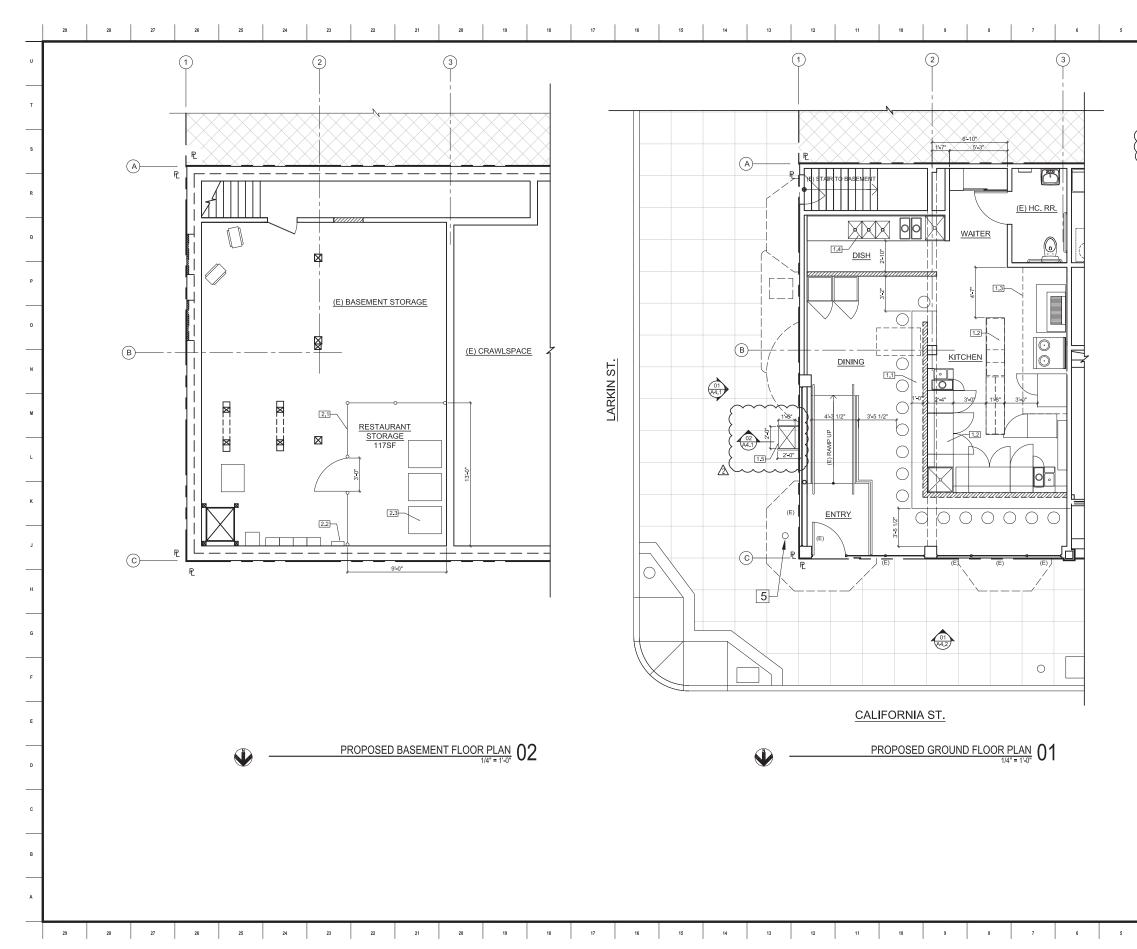


4	3	2	1			
GROUND FL	OOR SHEET N	OTES:				AGENCY
-	DINING COUNT			[EVUID	
	OOD PREP CO				EXHIB	
	EXHAUST HOC				П	
	P. SCULLERY S				В	
	\sim	\sim	~~~~~	Ь		
1.5 (N) TYP	'E-1 EXHAUST L	DUCT TO ROOF.		Ŋ		
\dots			~~~~	\mathcal{V}_{i}	▲	
2.1 GALV. (LOCKIN SLAB. 2.2 (E) ELE 2.3 MIN. (3) FOR RE	IG GATE FASTE CT. PANEL, VIF) 96 GAL. TOTE!	- CING W/ VINYL :NEN POSTS IN R 2-WHEEL TRA USE, AND COMI	TO (E) CONC. SH CARTS			ULTANT
					C O N S 2120 San Fr L: 41556,74 Intel P Common	H I T E C T O R T I U M Eighteenth Avenue naisco CA 94116 21 / 415.566.1431 consortium-sf.com R O J E C T Tradia Alterations to: 11 California Street ancisco, CA 94109
GENERAL N	OTES:			\vdash		
A: PROJECT	TO CONFIRM T	O ARTICLE 6 RE	EGARDING			
TRANSPA	RENCY REQUIR	145.1(C)(6) FOR REMENTS OF TH		$\sqrt{2}$		06/07/49
		TERIOR SIGNA		<u> </u>	VARIANCE APPLICATION	06/27/18 05/16/18
		DOORS SHALL		\mathbb{A}	CU REVISION 1	02/23/18
W/ TRANS	PARENT GLAZ	ING NOT LESS T	HAN 60%	\square	CU APPLICATION	12/21/17
		GE AT THE GR		No.	Revision	Release
	SNAGE SHALL F	REFLECT OPERA	ATING HOURS		Code: 1501CAL	
LUNCH:	MONDAY-F	RIDAY 11:30A-2		Sca	le:	
DINNER:	MUNDAY-S	SATURDAY 5:30	9:30P	Pro	posed Floor Plans	A2.2
4	3	2	1			

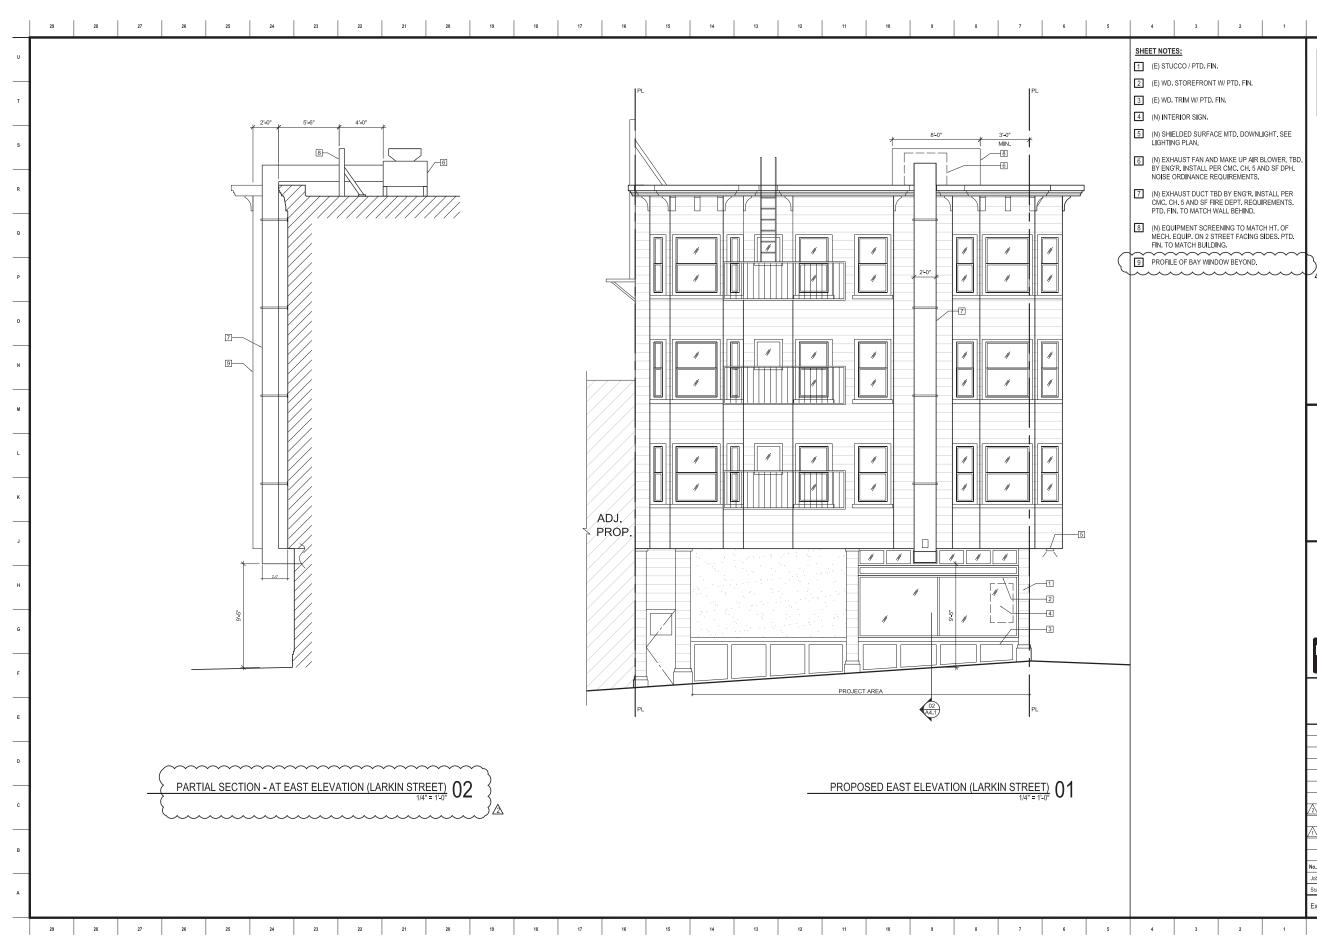

	4	3	2	1			
SH	EET NOTE	ES:			ſ		AGENCY
		ICCO / PTD. FIN				EXHIB	SIT 📋
2	(E) WD.	STOREFRONT	W/ PTD. FIN.				
3	(E) WD.	TRIM W/ PTD. F	=IN.			B	
4		ERIOR SIGN.					
			E MTD. DOWNL				
5		NG PLAN.	E MID. DOWNL	IGHT. SEE			
6	BY ENG		MAKE UP AIR E R CMC. CH. 5 A				
	(N) EX⊢ CMC. C	AUST DUCT TB	D BY ENG'R. IN RE DEPT. REQU				
8	(N) EQU MECH.	EQUIP. ON 2 ST	ENING TO MATO				
	\sim	MATCH BUILDI	\sim	~~~~~	L		
			DOW BEYOND.		Ľ)	λ	
					6	2	
						CONS	ULTANT
						ARC	нітест
						CONS	ORTIUM
						• 2120 San Fra	Elghteenth Avenue ancisco CA 94116 42 f.415.566.1431
1						t: 415.566.74 Info@	42 f. 415.566.1431 consortlum-sf.com
							ROJECT
						15	ercial Alterations to: 01 California Street rancisco, CA 94109
					L		
					$ \mid$		
					\vdash		
					\vdash		
					2	CUA COMMENTS	06/27/18
						CU REVISION 1	05/16/18 02/23/18
						CU APPLICATION	12/21/17
					N-	Baudal	Dala
					No. Job	Revision Code: 1501CAL	Release
					Sca		
					Ext	erior Elevation	A4.1
	4		_				
1	4	3	2	1			




		4	3	2	1	
	SHEE 1 2 3 4	(E) WD (E) WD	ES: JCCO / PTD. FIN . STOREFRONT . TRIM W/ PTD. CAL SIGN ON EI	W/ PTD. FIN. FIN.		EXHIBIT B
	5	(N) SH			LIGHT. SEE	
	Ğ	BY ENG	G'R. INSTALL PE	D MAKE UP AIR ER CMC. CH. 5 A EQUIREMENTS.	ND SF DPA.	
	7	CMC. C	H. 5 AND SF FI	BD BY ENG'R. IN RE DEPT. REQU	JIREMENTS.	
/	8					3
						C O N S U L T A N T
						A R C H I T E C T
						C O N S O R T I U M 2120 Elghteenth Avenue San Frandsoc CA 94116 1: 415,566,7442 (:1415,566,1431 Info@consortium=sf.com P R O J E C T Commercial Alterations to: 1501 California Street San Francisco, CA 94109
						CU REVISION 1 02/23/18 CU APPLICATION 12/21/17
						No. Revision Release
						Job Code: 1501CAL
						Exterior Elevation A4.2
		4	3	2	1	,,,,2

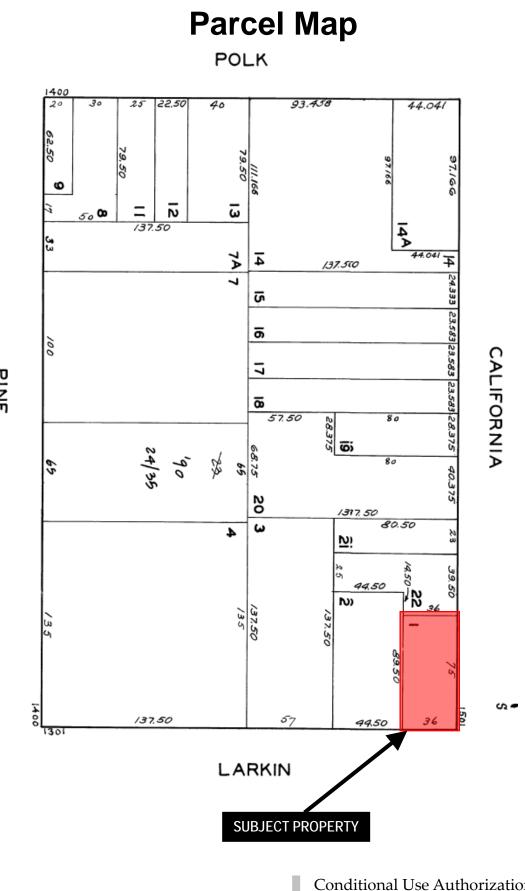

PINE



Sanborn Map*

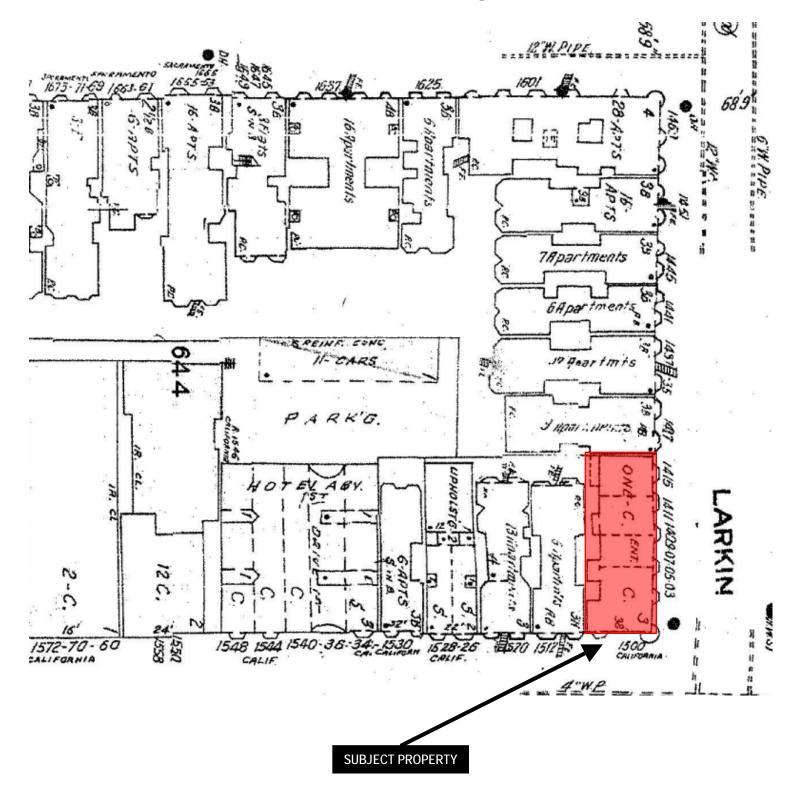

*The Sanborn Maps in San Francisco have not been updated since 1998, and this map may not accurately reflect existing conditions.



Aerial Photo



SUBJECT PROPERTY



Zoning Map





Site Photo



Same as Above

APPLICATION FOR Conditional Use Authorization

1. Owner/Applicant Information

2120 18th Ave. SF, CA 94116

Elmer Lin

APPLICANT'S ADDRESS:

PROPERTY OWNER'S ADDRESS:	TELEPHONE:
750 Battery Street, 5th Floor San Francisco, CA 94111	(415) 722-7061
	EMAIL
	Mark.Mason@marcusmillichap.com

TELEPHONE:

(415)566-7442

EMAIL: elmerl@consortium-sf.com

CONTACT FOR PROJECT INFORMATION:

 Applicant
 Same as Above

 ADDRESS:
 TELEPHONE:

 ()
 EMAIL:

COMMUNITY LIAISON FOR PROJECT (PLEASE REPORT CHANGES TO THE Z	ONING ADMINISTRATOR): Same as Above
ADDRESS:	TELEPHONE:
	EMAIL:

2. Location and Classification

STREET ADDRESS OF PROJECT: 1501 California St.				ZIP CODE: 94109
CROSS STREETS: Larkin St.				
ASSESSORS BLOCK/LOT: 0645 / 001	LOT DIMENSIONS: 36x75	LOT AREA (SQ FT): 2700	ZONING DISTRICT: NCD-Polk St,	HEIGHT/BULK DISTRICT: 65-A

3. Project Description

(Please check all that apply) Change of Use	ADDITIONS TO BUILDING:	PRESENT OR PREVIOUS USE: RETAIL - vacant and unoccu	pied	
 Change of Hours New Construction Alterations 	 Front Height Side Yard 	PROPOSED USE: RESTAURANT		
Demolition Other Please clarify:		BUILDING APPLICATION PERMIT NO.:	DATE FILED: 12/05/17	

4. Project Summary Table

If you are not sure of the eventual size of the project, provide the maximum estimates.

	EXISTING USES:	EXISTING USES TO BE RETAINED:	NET NEW CONSTRUCTION AND/OR ADDITION	PROJECT TOTALS:
		PROJECT FEATURES		
Dwelling Units	42 units	42 units	0	
Hotel Rooms	N/A			
Parking Spaces	0	0	0	1990 - Constant States
Loading Spaces	1	1	0	ninnin
Number of Buildings	1	1	0	<
Height of Building(s)	Approx. 80 feet	Approx. 80 feet	0	
Number of Stories	4 w/ 1 basement	4 w/ 1 basement	0	
Bicycle Spaces	0	0	0	
	GROS	SS SQUARE FOOTAGE (GSI	F)	= = <u></u>
Residential	7802	7802	0	
Retail	1998	1303	-695	-695
Office	0	0		
Industrial/PDR Production, Distribution, & Repair	0	0		
Parking	0	0		
Other (Specify Use)		Restaurant: 695	0	695
TOTAL GSF	9800	9800	0	0

Please describe any additional project features that are not included in this table: (Attach a separate sheet if more space is needed)

Approval for restaurant use with a Type 41 ABC license requiring a bona fide eating place.

CASE NUMBER:

5. Action(s) Requested (Include Planning Code Section which authorizes action)

Section 723: Polk St. NCD Zoning Controls, Restaurants, Condition Use on first floor (3) POLK STREET LIQUOR LICENSES FOR RESTAURANTS:

Conditional Use Findings

Pursuant to Planning Code Section 303(c), before approving a conditional use authorization, the Planning Commission needs to find that the facts presented are such to establish the findings stated below. In the space below and on separate paper, if necessary, please present facts sufficient to establish each finding.

- 1. That the proposed use or feature, at the size and intensity contemplated and at the proposed location, will provide a development that is necessary or desirable for, and compatible with, the neighborhood or the community; and
- That such use or feature as proposed will not be detrimental to the health, safety, convenience or general welfare of persons residing or working in the vicinity, or injurious to property, improvements or potential development in the vicinity, with respect to aspects including but not limited to the following:
 - (a) The nature of the proposed site, including its size and shape, and the proposed size, shape and arrangement of structures;
 - (b) The accessibility and traffic patterns for persons and vehicles, the type and volume of such traffic, and the adequacy of proposed off-street parking and loading;
 - (c) The safeguards afforded to prevent noxious or offensive emissions such as noise, glare, dust and odor;
 - (d) Treatment given, as appropriate, to such aspects as landscaping, screening, open spaces, parking and loading areas, service areas, lighting and signs; and
- 3. That such use or feature as proposed will comply with the applicable provisions of this Code and will not adversely affect the Master Plan.

 The proposed restaurant will be a small neighborhood eating place of no more than 49 persons similar to other small scale businesses typical for the area. New restaurants are desirable for activating neighborhoods providing places for interaction during day and evening times.

-2a. The proposed restaurant utilizes an existing retail tenant space and will not include any construction of new buildings. Thereby reinforcing small-scale, fine grain storefronts typical for the area.

2b. The proposed restaurant will be entered near the corner of the building and will have business signage on two street frontages thus activating the corner of the street where no other business currently operate out of the building. No additional traffic will be added with this proposed business. Delivery truck will utilize loading space on Larkin St. and metered parking on California St. in front of adjacent property.

2c. No additional noise will be produced by the business. The rooftop exhaust blower will be designed to comply with the Health Dept Noise Ordinance and sufficiently separated from any operable windows by a minimum of 10 feet as required by the Mechanical Code.

2d. Exterior lighting at the Entrance to the restaurant will be discretely installed and be shielded to prevent excessive glare to residents in and adjacent to the building.

The proposed use will comply with applicable provisions of the Planning Code and will not adversely affect the Master Plan.

Priority General Plan Policies Findings

Proposition M was adopted by the voters on November 4, 1986. It requires that the City shall find that proposed projects and demolitions are consistent with eight priority policies set forth in Section 101.1 of the City Planning Code. These eight policies are listed below. Please state how the project is consistent or inconsistent with each policy. Each statement should refer to specific circumstances or conditions applicable to the property. Each policy must have a response. IF A GIVEN POLICY DOES NOT APPLY TO YOUR PROJECT, EXPLAIN WHY IT DOES NOT.

1. That existing neighborhood-serving retail uses be preserved and enhanced and future opportunities for resident employment in and ownership of such businesses enhanced;

The proposed restaurant will not adversely affect existing neighborhood serving retail uses as the subject location is a currently vacant storefront. The restaurant will enhance future opportunities for resident employment.

 That existing housing and neighborhood character be conserved and protected in order to preserve the cultural and economic diversity of our neighborhoods;

The proposed restaurant will occupy existing ground floor tenant space without displacing residents or sacrificing existing housing. The character of the existing storefront will remain typically small-scale, and fine grain, thus protecting the cultural and economic diversity of the neighborhood.

3. That the City's supply of affordable housing be preserved and enhanced;

No housing units will be displaced or removed. See finding 2 above.

4. That commuter traffic not impede Muni transit service or overburden our streets or neighborhood parking;

The proposed restaurant of less than 49 occupants will not impede the existing bus stop on the California St side or overburden the streets or adversely affect neighborhood parking. An existing loading zone on the Larkin St. side will be maintained. Existing quantity of street parking on Larkin St. and metered parking on California St. will be maintained. That a diverse economic base be maintained by protecting our industrial and service sectors from displacement due to commercial office development, and that future opportunities for resident employment and ownership in these sectors be enhanced;

The proposed restaurant will not adversely affect existing service sectors but contribute additional services to the neighborhood.

- That the City achieve the greatest possible preparedness to protect against injury and loss of life in an earthquake;
- The proposed restaurant will be housed in a building with recent structural strengthening and is fully fire sprinklered, thereby protecting it's inhabitants from loss of life in an earthquake and fire.

- 7. That landmarks and historic buildings be preserved; and
- The character of the existing storefront will remain and be preserved, thus protecting the integrity of the 1907 apartment building and economic diversity of the neighborhood.

8. That our parks and open space and their access to sunlight and vistas be protected from development.

The proposed restaurant will not adversely affect parks and open space and their access to sunlight.

Estimated Construction Costs

TYPE OF APPLICATION:		
Conditional Use Authorization		
OCCUPANCY CLASSIFICATION:		
A-2 < 49 occupants = B		
BUILDING TYPE:		
V-B, Fully Sprinklered		
TOTAL GROSS SQUARE FEET OF CONSTRUCTION:	BY PROPOSED USES:	
695	Restaurant	
ESTIMATED CONSTRUCTION COST:		
\$100,000		
ESTIMATE PREPARED BY:		
Architect		
FEE ESTABLISHED:		
FEE ESTABLISHED:		

Applicant's Affidavit

Under penalty of perjury the following declarations are made:

- a: The undersigned is the owner or authorized agent of the owner of this property.
- b: The information presented is true and correct to the best of my knowledge.
- c: The other information or applications may be required.

Signature:

12/05/17 Date:

Print name, and indicate whether owner, or authorized agent: Elmer Lin, RA

Owner / Authorized Agen (circle one)

CASE NUMBER:

Application Submittal Checklist

Applications listed below submitted to the Planning Department must be accompanied by this checklist and all required materials. The checklist is to be completed and **signed by the applicant or authorized agent and a department staff person.**

APPLICATION MATERIALS	CHECKLIST
Application, with all blanks completed	
300-foot radius map, if applicable	■ y4 *
Address labels (original), if applicable	• • • •
Address labels (copy of the above), if applicable	
Site Plan	• *
Floor Plan	• X) -
Elevations	• xx •
Section 303 Requirements	for formula retail, not req'd. $303(0)$ 50
Prop. M Findings	- ex •
Historic photographs (if possible), and current photographs	NOTES:
Check payable to Planning Dept.	Required Material. Write "N/A" if you believe the item is not applicable, (e.g. letter of authorization is not required if application is
Original Application signed by owner or agent	signed by property owner.)
Letter of authorization for agent	Typically would not apply. Nevertheless, in a specific case, staff may require the item.
Other: Section Plan, Detail drawings (ie. windows, door entries, trim), Specifications (for cleaning, repair, etc.) and/or Product cut sheets for new elements (ie. windows, doors)	Two sets of original labels and one copy of addresses of adjacent property owners and owners of property across street.

After your case is assigned to a planner, you will be contacted and asked to provide an electronic version of this application including associated photos and drawings.

Some applications will require additional materials not listed above. The above checklist does not include material needed for Planning review of a building permit. The "Application Packet" for Building Permit Applications lists those materials.

No application will be accepted by the Department unless the appropriate column on this form is completed. Receipt of this checklist, the accompanying application, and required materials by the Department serves to open a Planning file for the proposed project. After the file is established it will be assigned to a planner. At that time, the planner assigned will review the application to determine whether it is complete or whether additional information is required in order for the Department to make a decision on the proposal.

For Department reived by Planning Department: Application By:

Date: 110 2017



SAN FRANCISCO PLANNING DEPARTMENT



Community Business Priority Processing Program Checklist for Eligibility

The Community Business Priority Processing Program ("CB3P") was adopted by the San Francisco Planning Commission on February 12, 2015 under Resolution Number 19323. The CB3P streamlines the Conditional Use process for certain small and mid-sized businesses applications. It is the successor program to the Planning Commission's Small Business Priority Processing Pilot Program ("SB4P").

Projects that qualify for, and enroll in, the CB3P are guaranteed (1) a hearing date within 90 days of filing and (2) placement on the Planning Commission's consent calendar. The analysis of CB3P-projects is documented through a two-page Project Summary and Motion ("PS&M") rather than the lengthier Executive Summary and Draft Motion documents prepared in connection with conventional applications.

Applicants for the CB3P must (1) complete this checklist documenting eligibility for participation, (2) complete the Conditional Use application and provide associated materials and (3) conduct a Pre-Application Meeting, as discussed below. Planning Department Staff are available to assist you at the Planning Information Center ("PIC"), located on the ground floor of 1660 Mission Street, during regular business hours. You can also call the PIC at (415) 558.6377

Information about Pre-Application Meetings can be found at sfplanning.org > Permits & Zoning > Permit Forms > "Neighborhood Notification - Pre-Application Meeting Packet". A Pre-Application Meeting is a mandatory form of community outreach conducted by a project sponsor in order to receive initial feedback prior to the submittal of an application to the Planning Department. A Pre-Application Meeting is hosted by a project sponsor to discuss a project and review associated plans; it is typically held at or near the project site. A project sponsor is required to send notice of the meeting to abutting property owners and occupants, property owners and occupants directly across the street, and all neighborhood associations (available at www.sfplanning.org).

Project Information

ase complete all fields. IOPERTY ADDRESS:		RECORD NUMBE	R AND/OR BUILDING PERM	NT NUMBER:
1501 California St. ME OF BUSINESS (IF KNOWN):				
Akikos Restaurant				
RIEF DESCRIPTION OF PROJECT: 40 seat restaurant serving seasonal	Jananese cuisine co	nsisting of raw and o	ooked foods along wit	h offering beer, wine,
and sake beverages. Tenant improvi handicapped accessible restroom.	ements include a co	oking area, dining cou	unter, dish room, and i	reuse of an existing

Checklist for CB3P Eligibility

The following checklist is to be completed by applicants and reviewed by Planning Department Staff.

	CONFIRM COMPLIANCE W	ITH EACH CRITERION BY CHECKING BOXES
V	Pre-Application Meeting	The applicant has conducted a Pre-Application Meeting as set forth on the reverse side of this page.
	Application Type	The application is for Conditional Use Authorization.
	Formula Retail	The application does not seek to establish a new Formula Retail use, excepting one with fewer than 20 other establishments.
	Hours of Operation	The application does not seek to establish or expand hours of operation beyond those permitted on an as-of-right basis in the subject zoning district.
	Storefront Consolidation	The application does not seek to consolidate multiple tenant spaces (e.g. storefronts), regardless of any vacancy, into a lesser number of tenant spaces.
	Loss of Dwellings	The application does not seek to remove any dwelling units.
Alcoholic Beverages The application does not seek to sell any alcoholic beverages excepting beer ar operation of a Bona Fide Eating Place.		The application does not seek to sell any alcoholic beverages excepting beer and/or wine sold on or off-site in conjunction with the operation of a Bona Fide Eating Place.
	Nature of Work	The proposed work involves only a change of use, tenant improvement or similar interior or store-front work. No building expansion or new construction is involved.
	Nature of Use	The application involves only non-residential uses and does not seek to establish or expand any of the following: ✓ Massage Establishment ✓ Tobacco Paraphernalia Establishment ✓ Adult Entertainment Establishment ✓ Medical Cannabis Dispensary ✓ Fringe Financial Service ✓ Drive-up Facility ✓ Wireless Telecommunications Site ("WTS") ✓ Outdoor Activity Area ✓ Bar ✓ Nightime Entertainment / Place of Entertainment (e.g. nightclubs, music venues) ✓ Liquor Store ✓ Off-Street parking in excess of that allowed on an as-of-right basis ✓ Office closed to the public located on the ground story

Applicant's Declaration

I hereby attest under penalty of perjury that the information I have provided is true and correct to the best of my knowledge, that I intend to complete the project described herein in compliance with the eligibility requirements of the CB3P Program, that I have read and understood this form, and that I am (a) the property owner or authorized agent of the property owner, (b) familiar with the property, and (c) able to provide accurate and complete information. I understand that knowingly or negligently providing false or misleading information may lead to denial or rescission of my permit and/ or other authorization and may constitute a violation of the San Francisco Municipal Code, which can lead to criminal and/or civil legal action along with the <u>i</u>mposition of administrative fines.

Amtan	12/14/17	elmerl@consortium-sf.com	
Signature	Date	Email Address	
Elmer Lin, Architect		415-566-7442	
Print Name and check one: OWNER	or AUTHORIZED AGENT	Phone Number	

	Ý	CHECKLIST REVIEWED AND FOUND TO BE ACCURATE AND REFLECTIVE OF PROJECT
	1	PRE-APPLICATION MEETING COMPLETE; DOCUMENTATION RECEIVED
	\checkmark	
STATE REASON		$\sim \alpha$
	<i>L</i> 1	All with I PROVIDE A COPY OF THIS FORM
izabeth Wa	$\Pi \Lambda$. (111 MUM 12/28/17 TO THE DIRECTOR'S OFFICE

AFFIDAVIT FOR Formula Retail Uses

1. Location and Classification

STREET ADDRESS OF PROJECT: 1501 California St.	· · · · · · · · · · · · · · · · · · ·	
ASSESSORS BLOCK/LOT:	ZONING DISTRICT:	HEIGHT/BULK DISTRICT:
0645/001 /	NCD - POLK ST.	65-A

2. Proposed Use Description

PROPOSED USE (USE CATEGORY PER ARTICLE 7 OR 8): EATING & DRINKING USE	
PROPOSED BUSINESS NAME:	
AKIKOS	
DESCRIPTION OF BUSINESS, INCLUDING PRODUCTS AND/OR SERVICES:	
40 seat restaurant serving seasonal Japanese cuisi beer, wine, and sake beverages in an intimate atmo	ne consisting of raw and cooked foods along with offering sphere

3. Quantity of Retail Locations

		TOTAL
3.a	How many retail locations of this business are there worldwide?	1
J.a	Please include any property for which a land use permit or entitlement has been granted.	
3.b	How many of the above total locations are in San Francisco?	1

If the number entered on Line 3.a above is 11 or more, then the proposed use *may* be a Formula Retail Use. *Continue to section 4 below*.

If the number entered on Line 3.a above is 10 or fewer, no additional information is required. Proceed to section 5 on the next page and complete the Applicant's Affidavit.

4. Standardized Features

Will the proposed business use any of the following Standardized Features?

	FEATURES	YES	NO
Α	Array of Merchandise		
В	Trademark		
С	Servicemark		
D	Décor		
Е	Color Scheme		
F	Façade		
G	Uniform Apparel		
H	Signage		
	TOTAL		

Enter the total number of Yes/No answers above.

If the total YES responses are two (2) or more, then the proposed use is a Formula Retail Use.

5. Applicant's Affidavit

NAME:		
ELMER LIN, ARCHITECT	Property Owner Authorized Agent	
MAILING ADDRESS: (STREET ADDRESS, CITY, STATE, ZIP)	v	
2120 18th Avenue, San Francisco, CA 94116		
PHONE:	EMAIL:	
(415 254-9681	ELMERL@CONSORTIUM-SF.COM	

- Under penalty of perjury the following declarations are made:a: The undersigned is the owner or authorized agent of the owner of this property.b: The information presented is true and correct to the best of my knowledge.
- c: Other information or applications may be required.

Applicant's Signature:

02/14/18 Date:

PLANNING DEPARTMENT USE ONLY
PLANNING CODE SECTION(S) APPLICABLE:
10W IS THE PROPOSED USE REGULATED AT THIS LOCATION?
Principally Permitted
Principally Permitted, Neighborhood Notice Required (Section 311/312)
Not Permitted
Conditional Use Authorization Required
COMMENTS:
/ERIFIED BY:
Signature: Date:
Printed Name: Phone:



tan Futuni Roat Crack

FOR KOSE NEOGAANION Call or wait the Sam Antonics on Attending Department

Central Reception 1650 Mission Street, Suite 400 San Francisco CA 94103-2479

TEL: 415.558.6378 FAX: 415 558-6409 WEB: http://www.sfplanning.org Planning Information Center (PIC) 1660 Mission Street, First Floor San Francisco CA 94103-2479

TEL: 415.558.6377 Planning staff are available by phone and at the PIC counter. No appointment is necessary.



SAN FRANCISCO PLANNING DEPARTMENT

CEQA Categorical Exemption Determination

PROPERTY INFORMATION/PROJECT DESCRIPTION

Project Address		Block/Lot(s)	
1501 CALIFORNIA ST		0645001	
Case No.		Permit No.	
2018-000751PRJ			
Addition/ Alteration	Demolition (requires HRE for Category B Building)	New Construction	
Project description for	Planning Department approval.	·	
Change of use to establish a 695 sf Restaurant Use (d.b.a Akiko's Restaurant) at an existing ground floor corner commercial tenant space within the Polk Street NCD.			

STEP 1: EXEMPTION CLASS

*Note	*Note: If neither class applies, an Environmental Evaluation Application is required.*		
	Class 1 - Existing Facilities. Interior and exterior alterations; additions under 10,000 sq. ft.		
	Class 3 - New Construction. Up to three new single-family residences or six dwelling units in one building; commercial/office structures; utility extensions; change of use under 10,000 sq. ft. if principally permitted or with a CU.		
	 Class 32 - In-Fill Development. New Construction of seven or more units or additions greater than 10,000 sq. ft. and meets the conditions described below: (a) The project is consistent with the applicable general plan designation and all applicable general plan policies as well as with applicable zoning designation and regulations. (b) The proposed development occurs within city limits on a project site of no more than 5 acres substantially surrounded by urban uses. (c) The project site has no value as habitat for endangered rare or threatened species. (d) Approval of the project would not result in any significant effects relating to traffic, noise, air quality, or water quality. (e) The site can be adequately served by all required utilities and public services. 		
	Class		

STEP 2: CEQA IMPACTS TO BE COMPLETED BY PROJECT PLANNER

If any b	If any box is checked below, an Environmental Evaluation Application is required.		
	Air Quality: Would the project add new sensitive receptors (specifically, schools, day care facilities, hospitals, residential dwellings, and senior-care facilities within an Air Pollution Exposure Zone? Does the project have the potential to emit substantial pollutant concentrations (e.g., backup diesel generators, heavy industry, diesel trucks, etc.)? (<i>refer to EP_ArcMap > CEQA Catex Determination Layers > Air Pollution Exposure Zone</i>)		
	Hazardous Materials: If the project site is located on the Maher map or is suspected of containing hazardous materials (based on a previous use such as gas station, auto repair, dry cleaners, or heavy manufacturing, or a site with underground storage tanks): Would the project involve 50 cubic yards or more of soil disturbance - or a change of use from industrial to residential? If yes, this box must be checked and the project applicant must submit an Environmental Application with a Phase I Environmental Site Assessment. <i>Exceptions: do not check box if the applicant presents documentation of enrollment in the San Francisco Department of Public Health (DPH) Maher program, a DPH waiver from the Maher program, or other documentation from Environmental Planning staff that hazardous material effects would be less than significant (refer to EP_ArcMap > Maher layer).</i>		
	Transportation: Does the project create six (6) or more net new parking spaces or residential units? Does the project have the potential to adversely affect transit, pedestrian and/or bicycle safety (hazards) or the adequacy of nearby transit, pedestrian and/or bicycle facilities?		
	Archeological Resources: Would the project result in soil disturbance/modification greater than two (2) feet below grade in an archeological sensitive area or eight (8) feet in a non-archeological sensitive area? (<i>refer to EP_ArcMap > CEQA Catex Determination Layers > Archeological Sensitive Area</i>)		
	Subdivision/Lot Line Adjustment: Does the project site involve a subdivision or lot line adjustment on a lot with a slope average of 20% or more? (<i>refer to EP_ArcMap > CEQA Catex Determination Layers ></i> <i>Topography</i>)		
	Slope = or > 20%: Does the project involve any of the following: (1) square footage expansion greater than 1,000 sq. ft. outside of the existing building footprint, (2) excavation of 50 cubic yards or more of soil, (3) new construction? (<i>refer to EP_ArcMap > CEQA Catex Determination Layers > Topography</i>) If box is checked, a geotechnical report is required.		
	Seismic: Landslide Zone: Does the project involve any of the following: (1) square footage expansion greater than 1,000 sq. ft. outside of the existing building footprint, (2) excavation of 50 cubic yards or more of soil, (3) new construction? (<i>refer to EP_ArcMap > CEQA Catex Determination Layers > Seismic Hazard Zones</i>) If box is checked, a geotechnical report is required.		
	Seismic: Liquefaction Zone: Does the project involve any of the following: (1) square footage expansion greater than 1,000 sq. ft. outside of the existing building footprint, (2) excavation of 50 cubic yards or more of soil, (3) new construction? <i>(refer to EP_ArcMap > CEQA Catex Determination Layers > Seismic Hazard Zones)</i> If box is checked, a geotechnical report will likely be required.		
	If no boxes are checked above, GO TO STEP 3. If one or more boxes are checked above, an <i>Environmental Evaluation Application</i> is required, unless reviewed by an Environmental Planner.		
Com	Comments and Planner Signature (optional): Mathew Chandler		

STEP 3: PROPERTY STATUS - HISTORIC RESOURCE TO BE COMPLETED BY PROJECT PLANNER

PROP	PROPERTY IS ONE OF THE FOLLOWING: (refer to Parcel Information Map)	
	Category A: Known Historical Resource. GO TO STEP 5.	
	Category B: Potential Historical Resource (over 45 years of age). GO TO STEP 4.	
	Category C: Not a Historical Resource or Not Age Eligible (under 45 years of age). GO TO STEP 6.	

STEP 4: PROPOSED WORK CHECKLIST

TO BE COMPLETED BY PROJECT PLANNER

Check	all that apply to the project.	
	1. Change of use and new construction. Tenant improvements not included.	
	2. Regular maintenance or repair to correct or repair deterioration, decay, or damage to building.	
	3. Window replacement that meets the Department's Window Replacement Standards. Does not include storefront window alterations.	
	4. Garage work. A new opening that meets the <i>Guidelines for Adding Garages and Curb Cuts</i> , and/or replacement of a garage door in an existing opening that meets the Residential Design Guidelines.	
	5. Deck, terrace construction, or fences not visible from any immediately adjacent public right-of-way.	
	 Mechanical equipment installation that is not visible from any immediately adjacent public right-of-way. 	
	7. Dormer installation that meets the requirements for exemption from public notification under <i>Zoning</i> Administrator Bulletin No. 3: Dormer Windows.	
	8. Addition(s) that are not visible from any immediately adjacent public right-of-way for 150 feet in each direction; does not extend vertically beyond the floor level of the top story of the structure or is only a single story in height; does not have a footprint that is more than 50% larger than that of the original building; and does not cause the removal of architectural significant roofing features.	
Note: Project Planner must check box below before proceeding.		
	Project is not listed. GO TO STEP 5.	
	Project does not conform to the scopes of work. GO TO STEP 5.	
	Project involves four or more work descriptions. GO TO STEP 5.	
	Project involves less than four work descriptions. GO TO STEP 6.	

STEP 5: CEQA IMPACTS - ADVANCED HISTORICAL REVIEW

TO BE COMPLETED BY PROJECT PLANNER

Chec	k all that apply to the project.
	1. Project involves a known historical resource (CEQA Category A) as determined by Step 3 and conforms entirely to proposed work checklist in Step 4.
	2. Interior alterations to publicly accessible spaces.
	3. Window replacement of original/historic windows that are not "in-kind" but are consistent with existing historic character.
	4. Façade/storefront alterations that do not remove, alter, or obscure character-defining features.
	5. Raising the building in a manner that does not remove, alter, or obscure character-defining features.
	6. Restoration based upon documented evidence of a building's historic condition, such as historic photographs, plans, physical evidence, or similar buildings.

	7. Addition(s), including mechanical equipment that are mininand meet the Secretary of the Interior's Standards for Rehability					
	8. Other work consistent with the Secretary of the Interior Secretar	andards for the Treatment of Historic				
	9. Other work that would not materially impair a historic district (specify or add comments):					
	Exterior mechanical vent is minimal in size, to be painted to match the building and will be installed with minimal penetrations. Vent is temporary and removable, and will not obscure or remove any character-defining features.					
	(Requires approval by Senior Preservation Planner/Preservation Coordinator)					
	10. Reclassification of property status. (Requires approval by Senior Preservation Planner/Preservation					
	Reclassify to Category A Rec	lassify to Category C				
	a. Per HRER dated (attach l	IRER)				
	b. Other <i>(specify</i>):					
	Note: If ANY box in STEP 5 above is checked, a Preservation Planner MUST check one box below.					
	Further environmental review required. Based on the information provided, the project requires an <i>Environmental Evaluation Application</i> to be submitted. GO TO STEP 6.					
	Project can proceed with categorical exemption review . The project has been reviewed by the Preservation Planner and can proceed with categorical exemption review. GO TO STEP 6.					
	ents (optional):					
Presei	vation Planner Signature: Marcelle Boudreaux					
	P 6: CATEGORICAL EXEMPTION DETERMINATIO BE COMPLETED BY PROJECT PLANNER	Ν				
	Further environmental review required. Proposed project does not meet scopes of work in either (check all that apply): Step 2 - CEQA Impacts Step 5 - Advanced Historical Review STOP! Must file an Environmental Evaluation Application.					
	No further environmental review is required. The project is categorically exempt under CEQA. There are no unusual circumstances that would result in a reasonable possibility of a significant effect.					
	Project Approval Action:	Signature:				
	Commission Hearing If Discretionary Review before the Planning Commission is requested,	Mathew Chandler				
	the Discretionary Review hearing is the Approval Action for the project.	08/17/2018				
	Once signed or stamped and dated, this document constitutes a categorical 31of the Administrative Code.	exemption pursuant to CEQA Guidelines and Chapter				

In accordance with Chapter 31 of the San Francisco Administrative Code, an appeal of an exemption determination can only be filed within 30 days of the project receiving the first approval action.

Please note that other approval actions may be required for the project. Please contact the assigned planner for these approvals.

STEP 7: MODIFICATION OF A CEQA EXEMPT PROJECT

TO BE COMPLETED BY PROJECT PLANNER

In accordance with Chapter 31 of the San Francisco Administrative Code, when a California Environmental Quality Act (CEQA) exempt project changes after the Approval Action and requires a subsequent approval, the Environmental Review Officer (or his or her designee) must determine whether the proposed change constitutes a substantial modification of that project. This checklist shall be used to determine whether the proposed changes to the approved project would constitute a "substantial modification" and, therefore, be subject to additional environmental review pursuant to CEQA.

PROPERTY INFORMATION/PROJECT DESCRIPTION

Project Address (If different than fror	Block/Lot(s) (If different than front page)	
1501 CALIFORNIA ST	0645/001	
Case No.	Previous Building Permit No.	New Building Permit No.
2018-000751PRJ		
Plans Dated	Previous Approval Action	New Approval Action
	Commission Hearing	
Modified Project Description:		

DETERMINATION IF PROJECT CONSTITUTES SUBSTANTIAL MODIFICATION

Com	pared to the approved project, would the modified project:	
	Result in expansion of the building envelope, as defined in the Planning Code;	
	Result in the change of use that would require public notice under Planning Code Sections 311 or 312;	
	Result in demolition as defined under Planning Code Section 317 or 19005(f)?	
	Is any information being presented that was not known and could not have been known at the time of the original determination, that shows the originally approved project may no longer qualify for the exemption?	
If at least one of the above boxes is checked, further environmental review is required.		

DETERMINATION OF NO SUBSTANTIAL MODIFICATION

	The proposed modification wo	uld not result in any of the above changes.				
If this box is checked, the proposed modifications are categorically exempt under CEQA, in accordance with prior project approval and no additional environmental review is required. This determination shall be posted on the Planning Department website and office and mailed to the applicant, City approving entities, and anyone requesting written notice.						
Plan	ner Name:	Signature or Stamp:				